



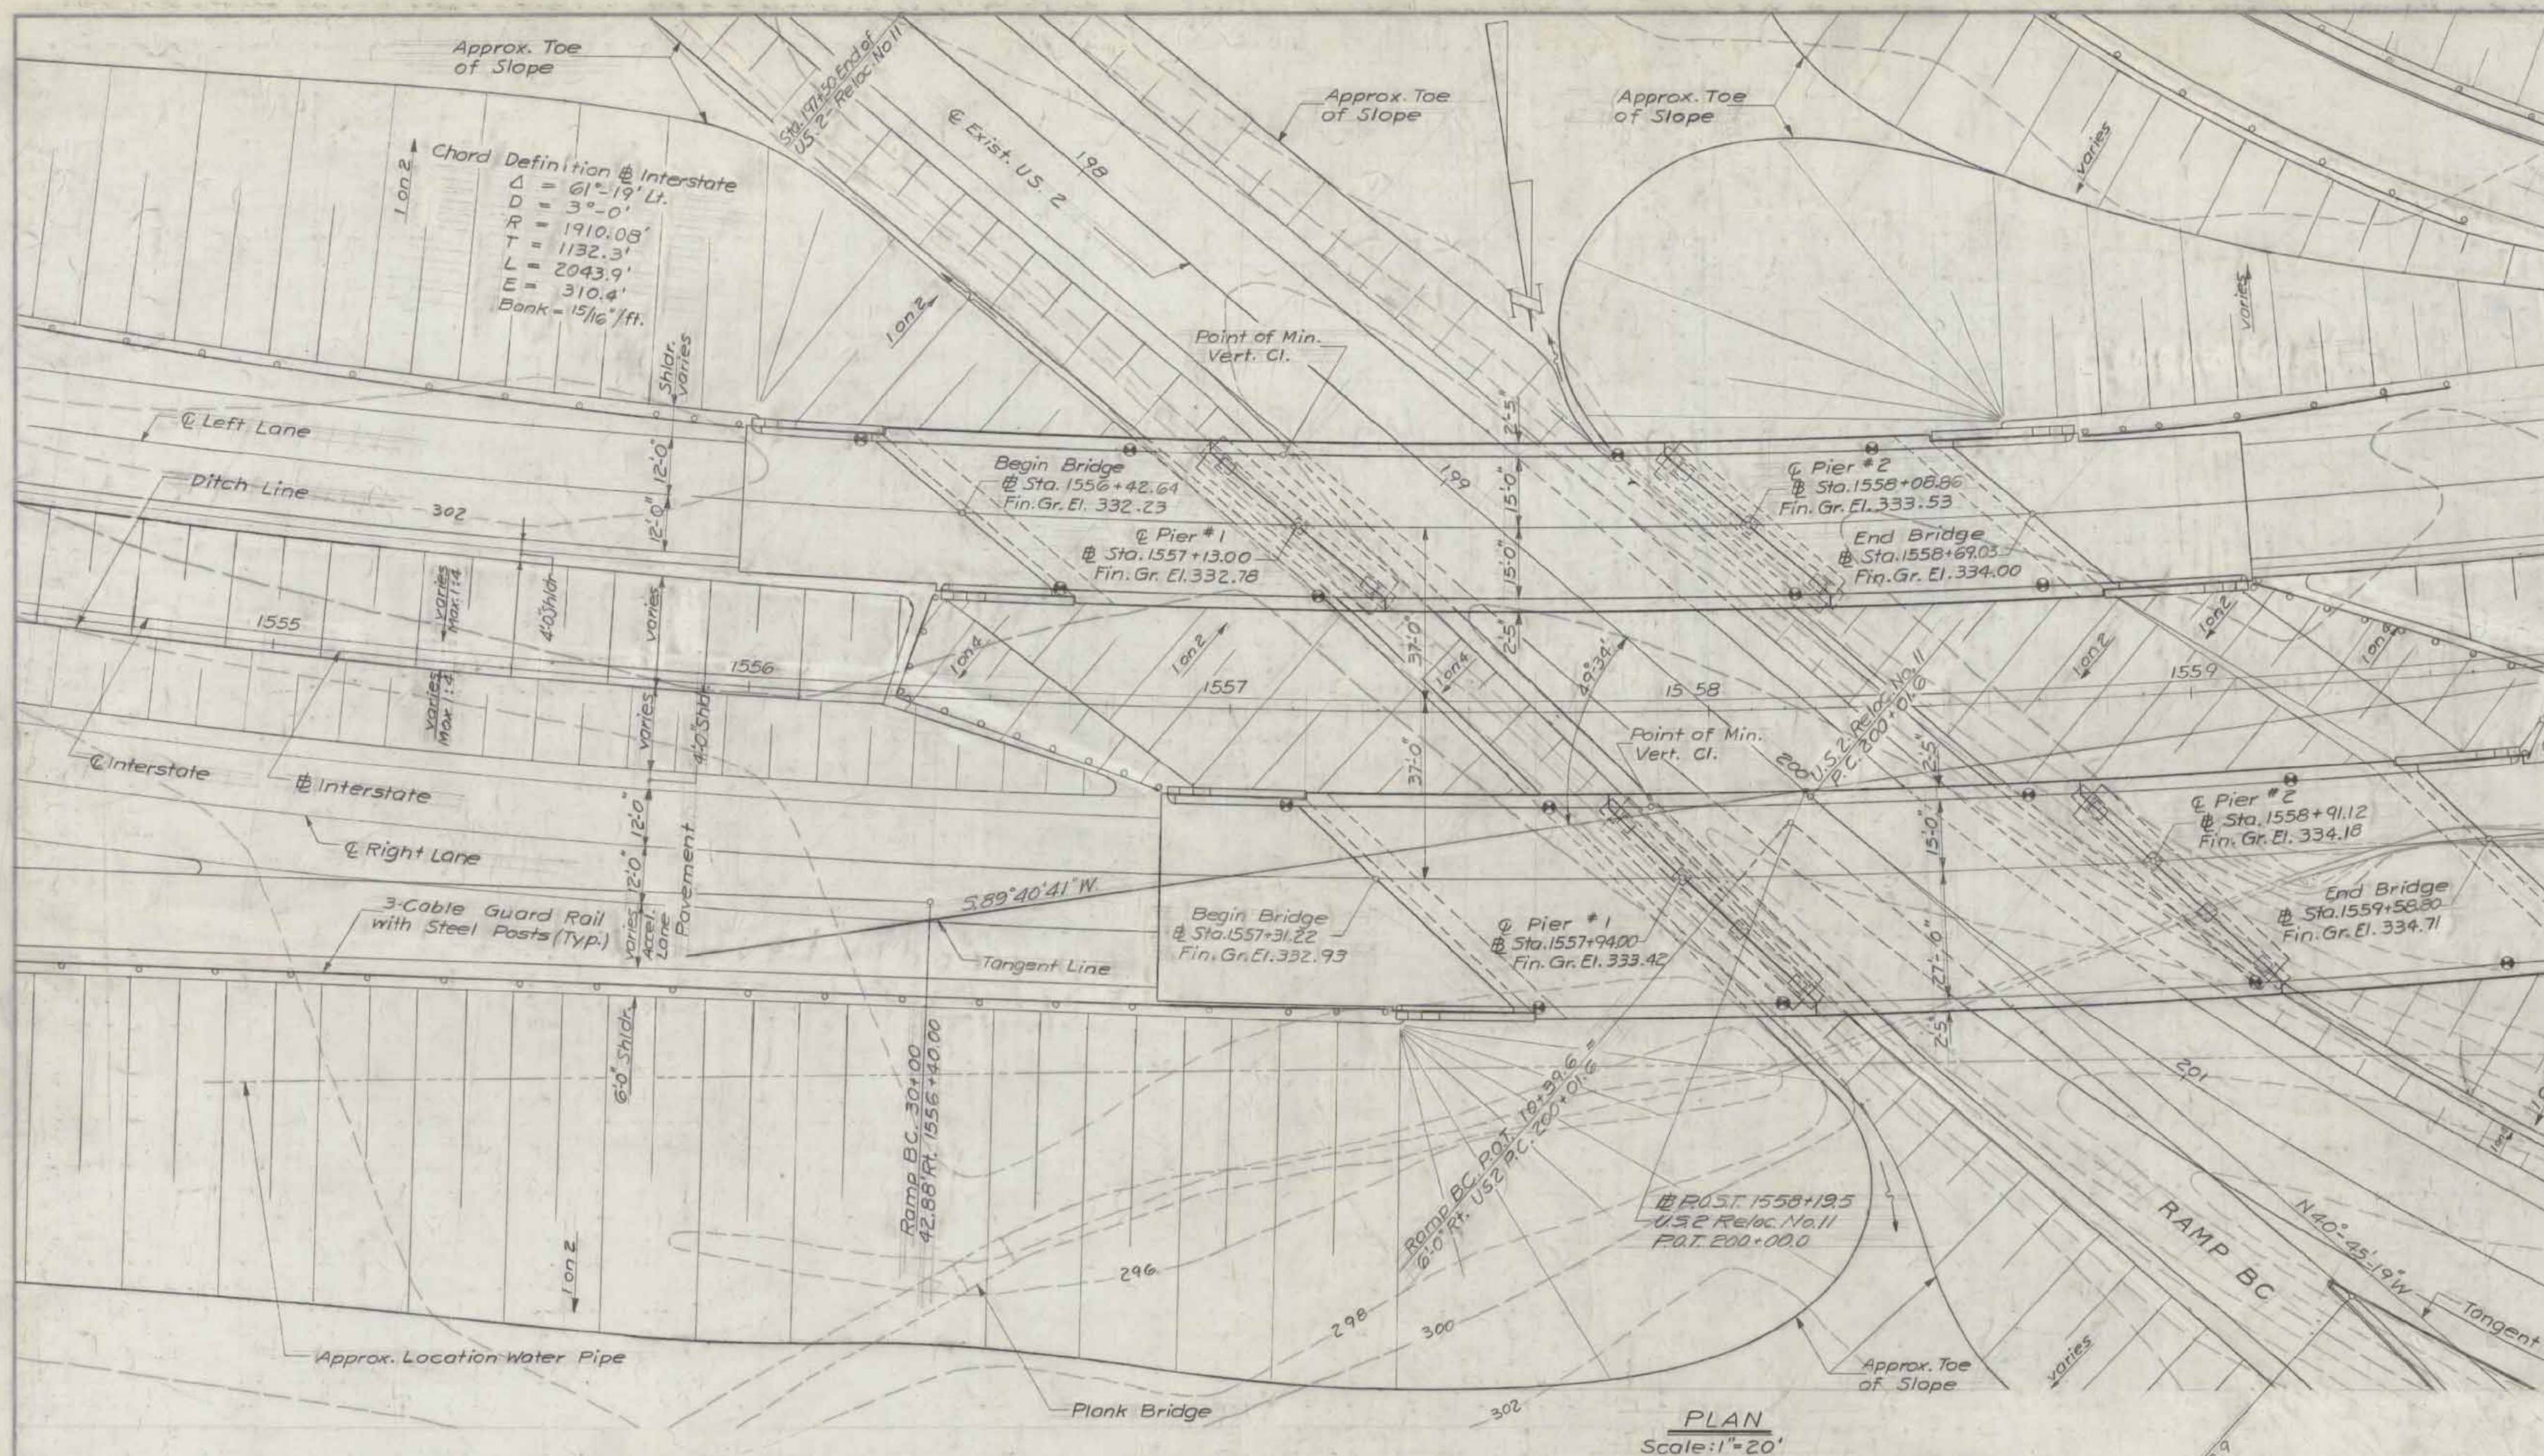

PLAN
Scale: 1" = 20'

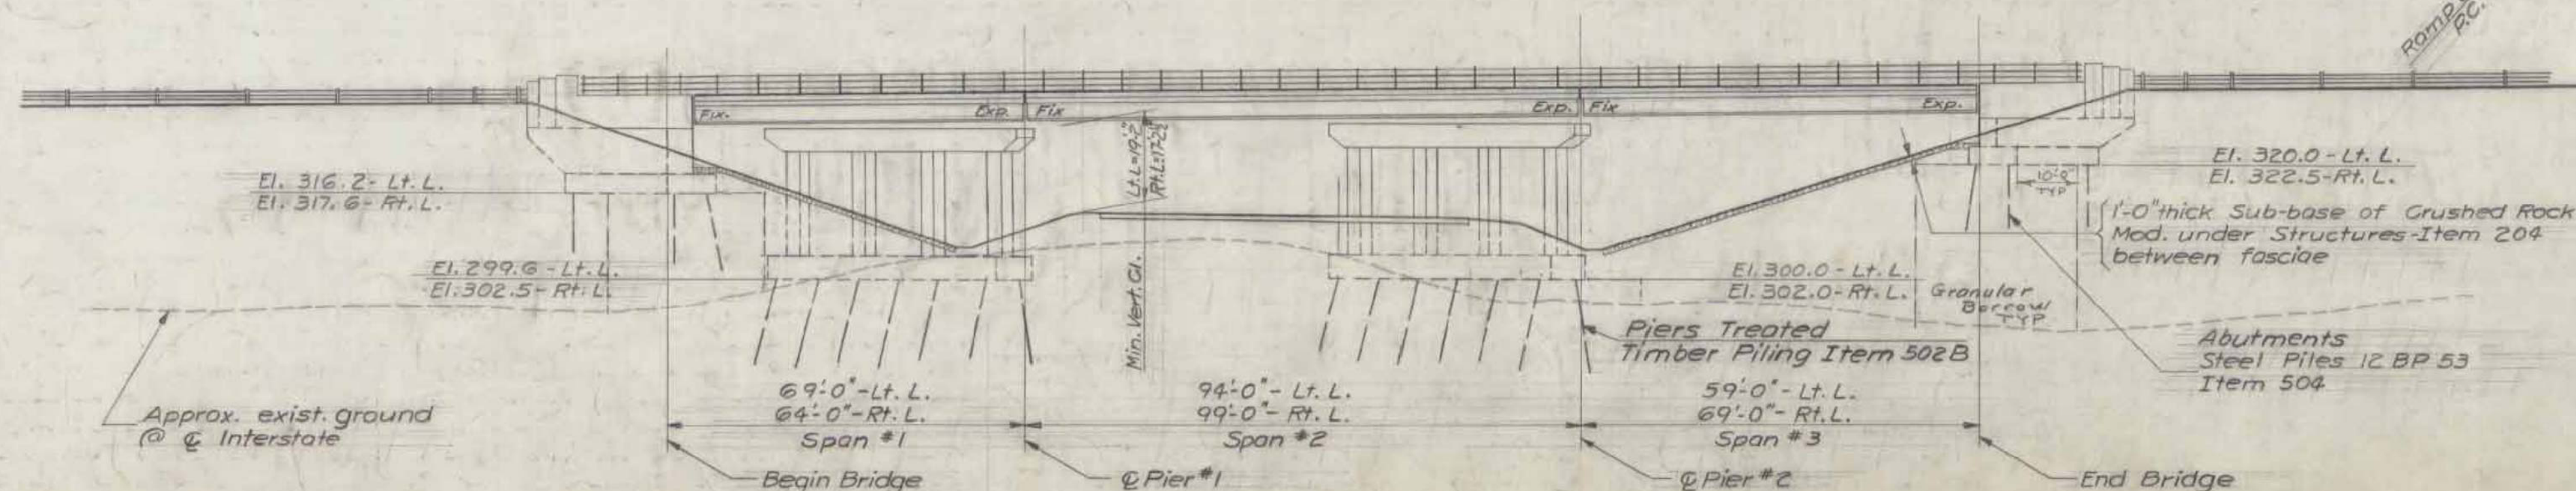

ELEVATION
Scale: 1" = 20'

RICH
IM BR
SHEET
BRID
FOR REF