
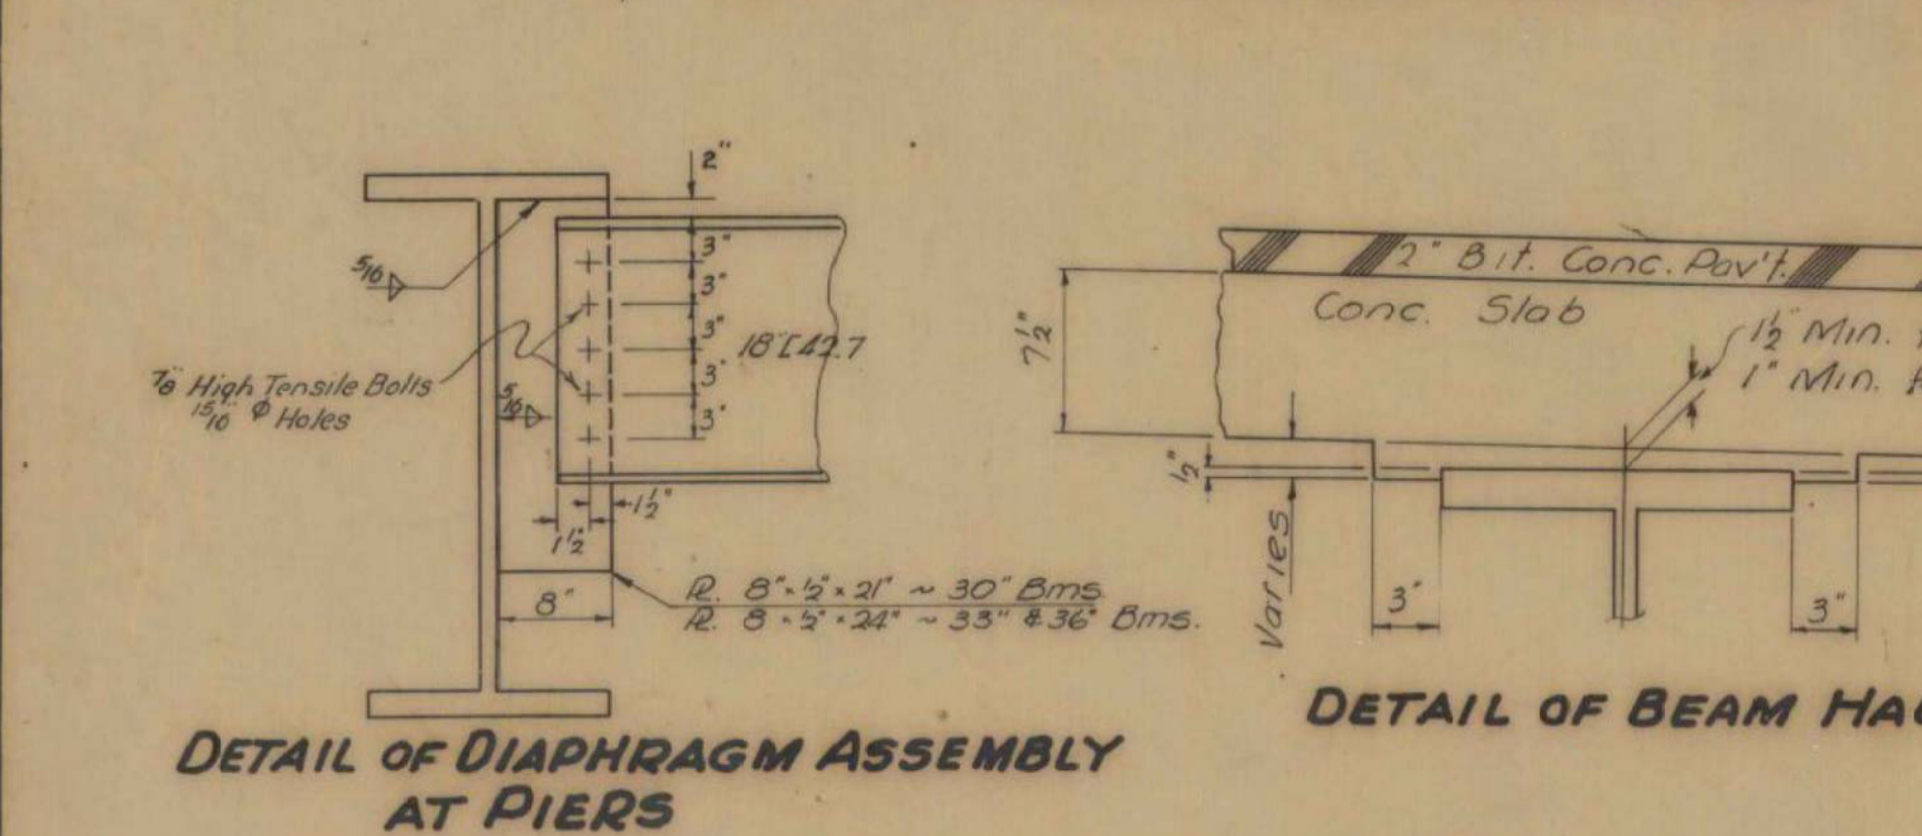
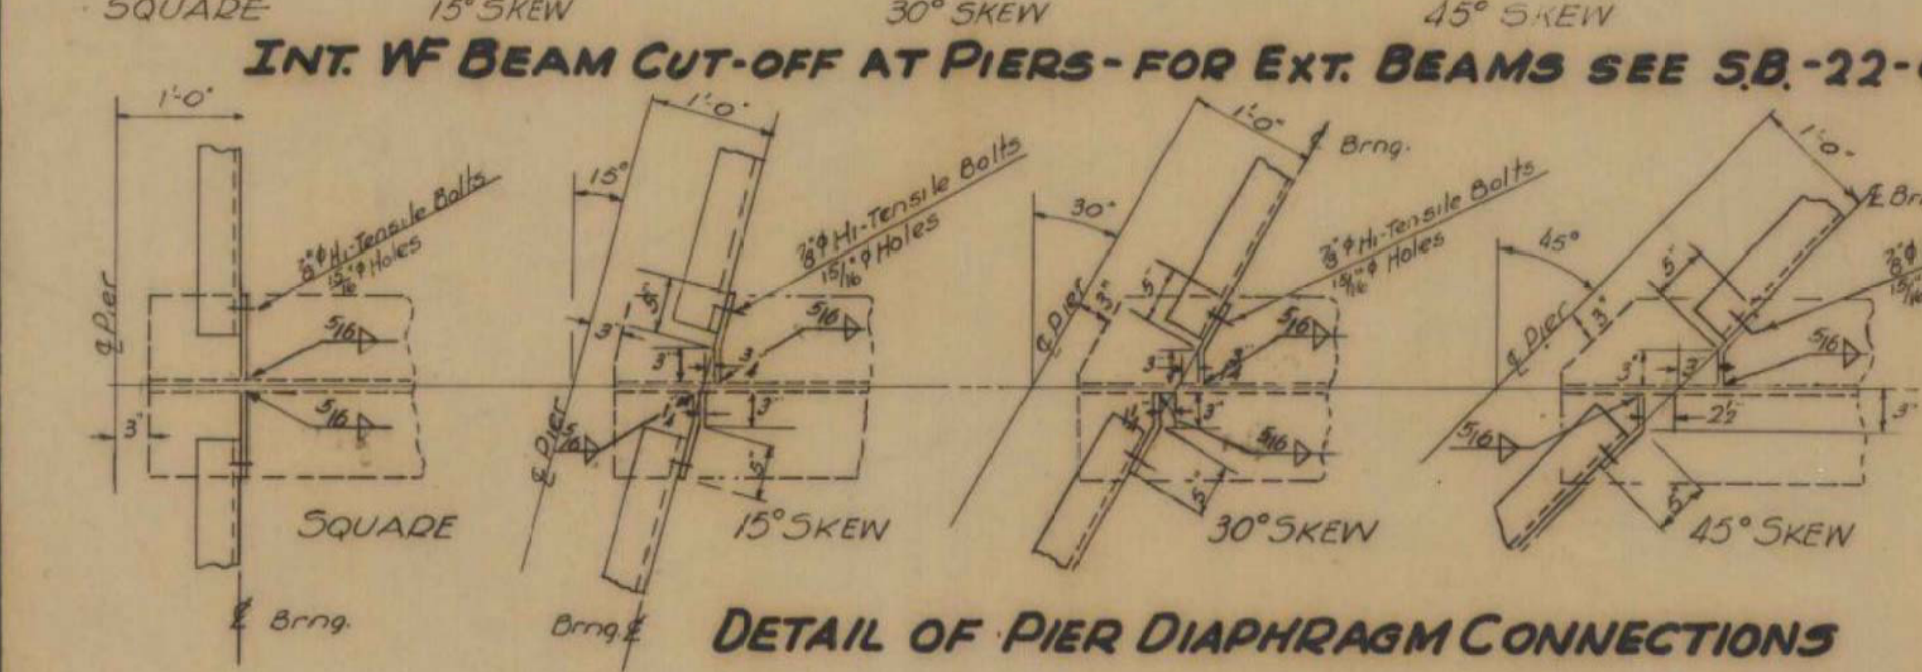
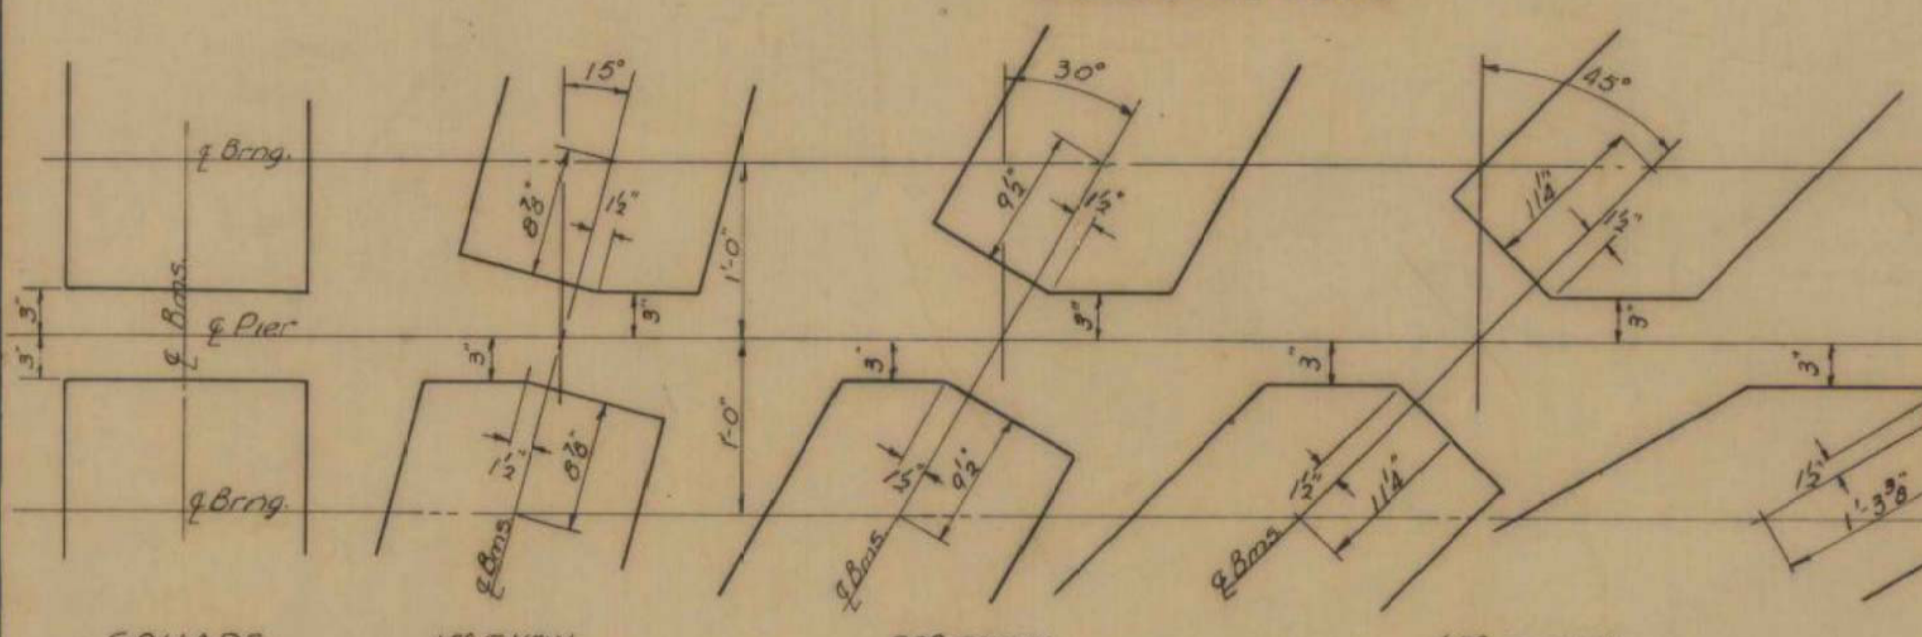


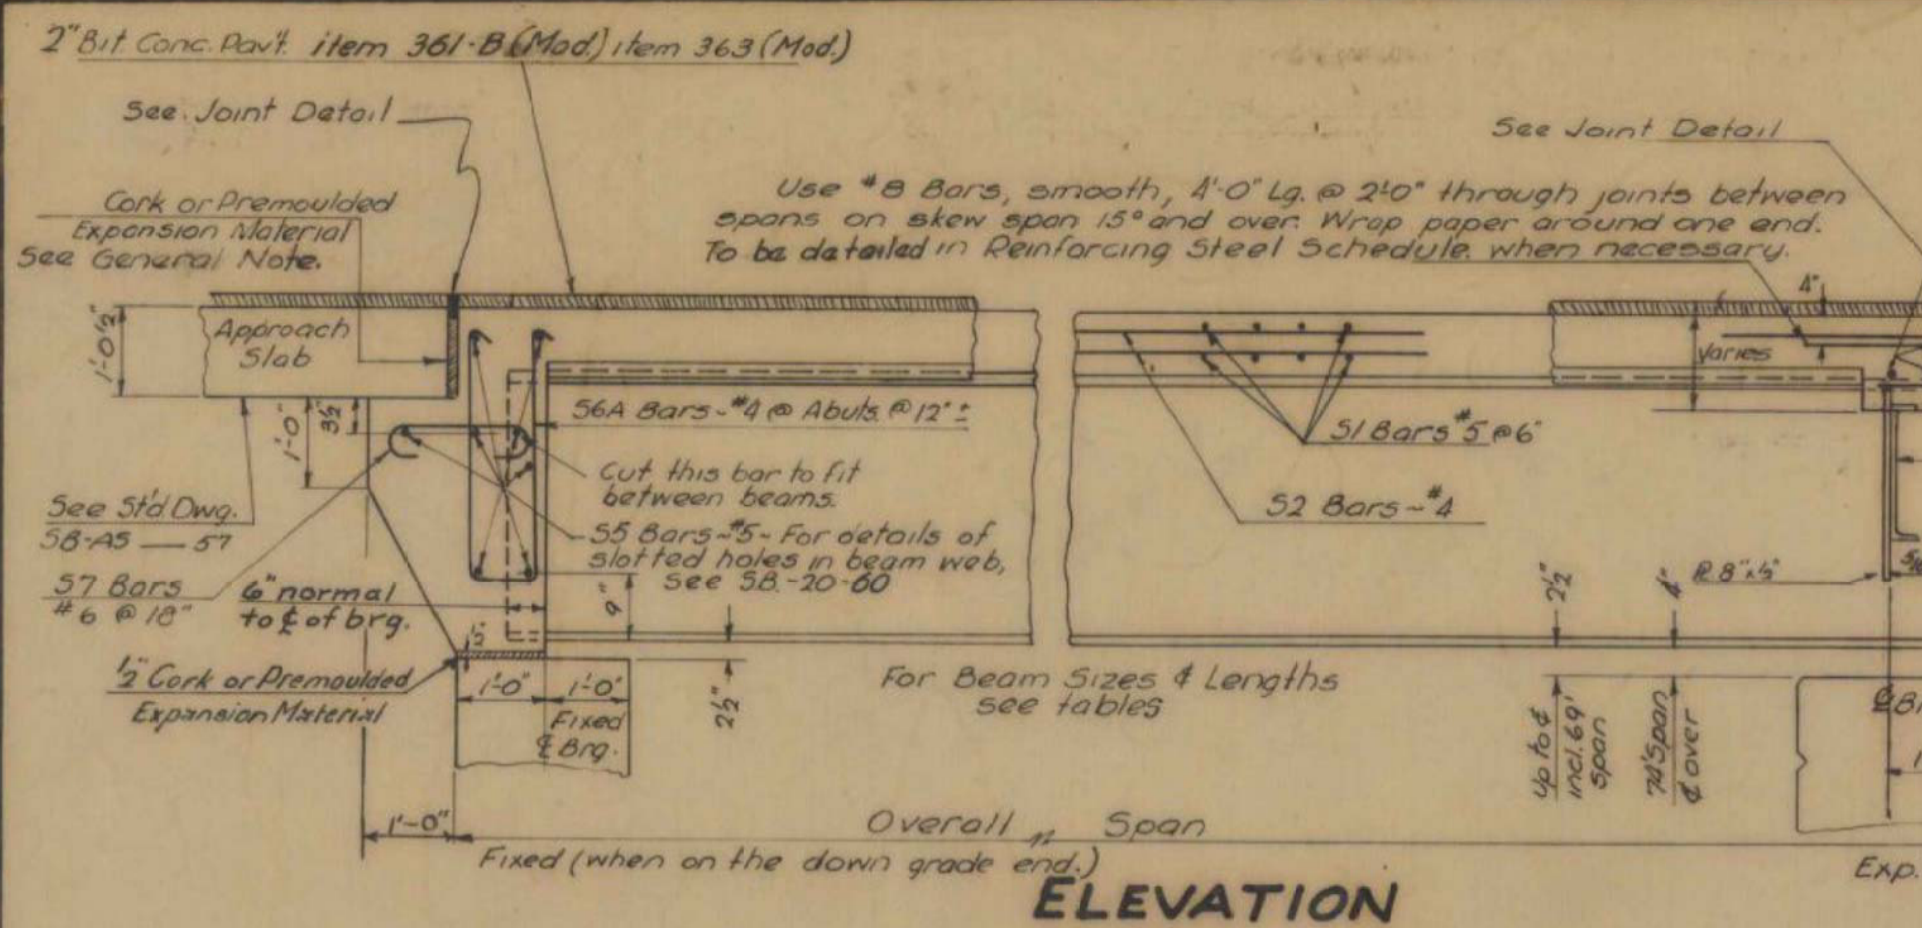

Revisions & Corrections

Changed To 12" curb 9/7/60

Corrected Elev View 9/24/60

Added Joint Detail & Exp. Mat. Note 12/3/60

Corrected Joint Filler to item 372 3/2/61

Changed General Notes 6-23-61

Drawn By: H.W.S. June 1960

Traced By: H.W.S. June 1960

Checked By: R.T.B. & R.S.H. June 1960

Correct: 13 July 1960

Approved: 13 July 1960