


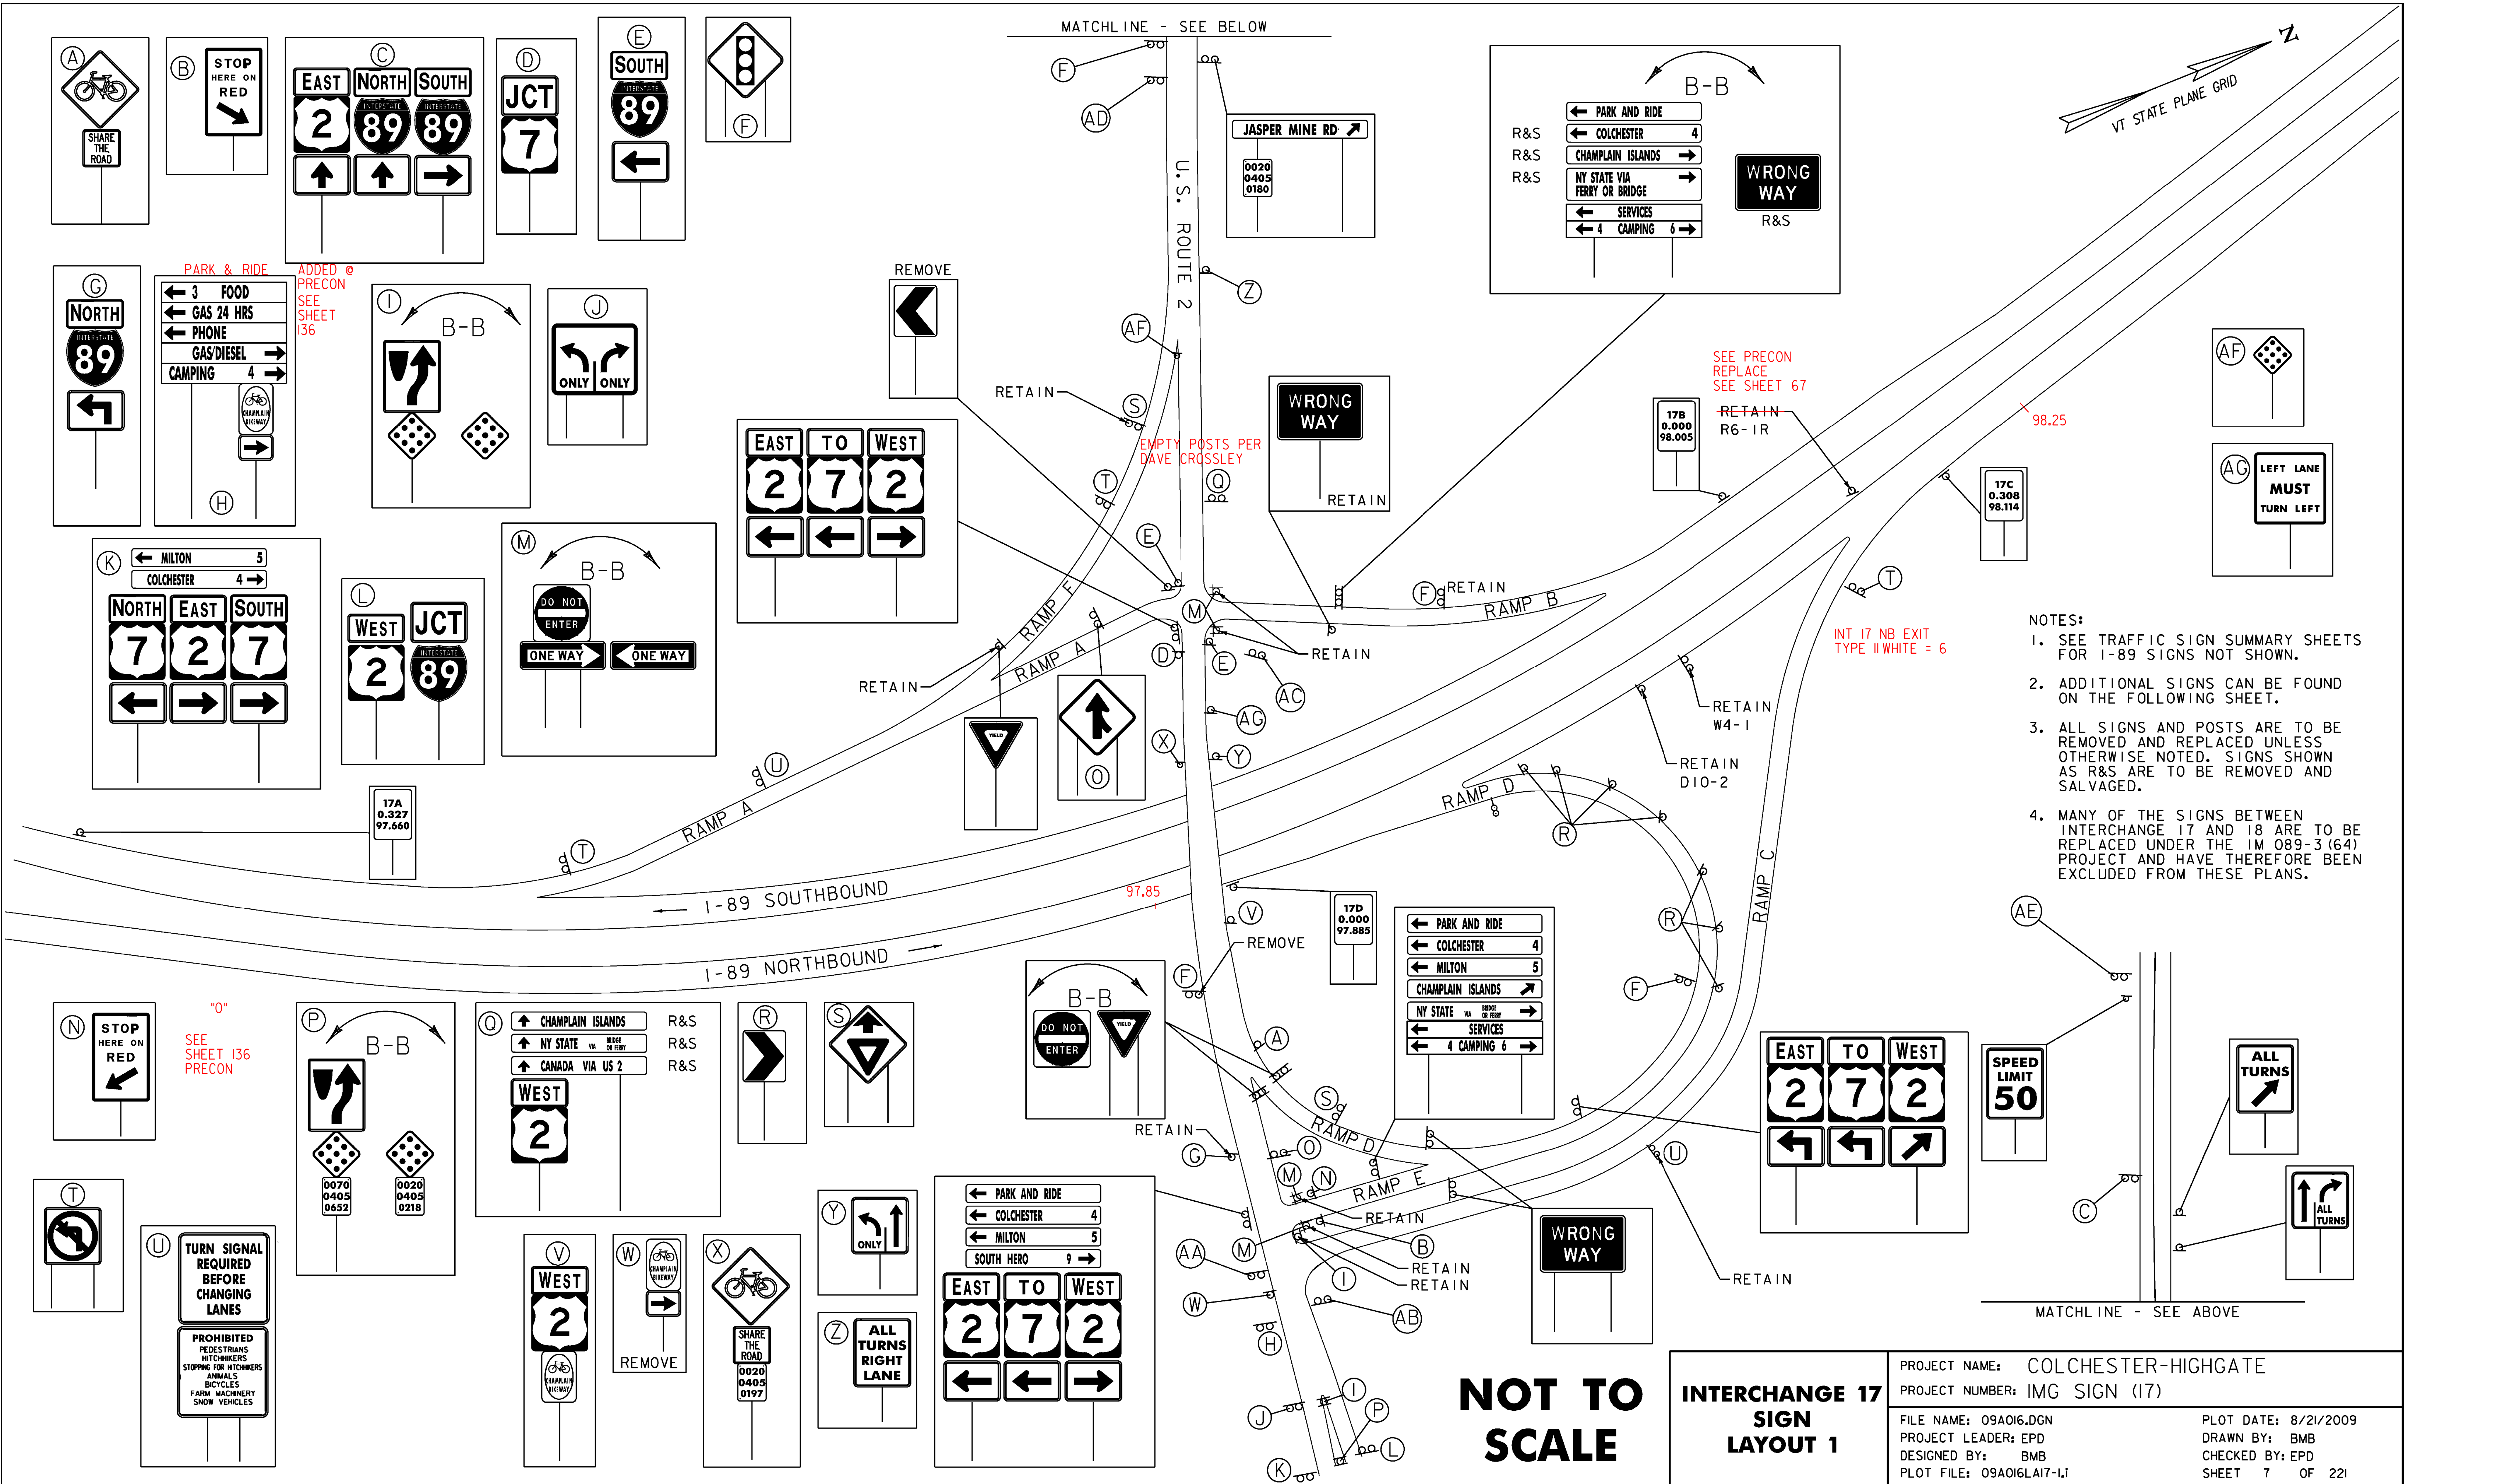

- NOTES:
- 1. SEE TRAFFIC SIGN SUMMARY SHEETS FOR I-89 SIGNS NOT SHOWN.
 - 2. ADDITIONAL SIGNS CAN BE FOUND ON THE FOLLOWING SHEET.
 - 3. ALL SIGNS AND POSTS ARE TO BE REMOVED AND REPLACED UNLESS OTHERWISE NOTED. SIGNS SHOWN AS R&S ARE TO BE REMOVED AND SALVAGED.
 - 4. MANY OF THE SIGNS BETWEEN INTERCHANGE 17 AND 18 ARE TO BE REPLACED UNDER THE 1M 089-3 (64) PROJECT AND HAVE THEREFORE BEEN EXCLUDED FROM THESE PLANS.

NOT TO SCALE

INTERCHANGE 17 SIGN LAYOUT 1	PROJECT NAME: COLCHESTER-HIGHGATE	
	PROJECT NUMBER: IMG SIGN (17)	
	FILE NAME: 09A016.DGN	PLOT DATE: 8/21/2009
	PROJECT LEADER: EPD	DRAWN BY: BMB
	DESIGNED BY: BMB	CHECKED BY: EPD
	PLOT FILE: 09A016LA17-1.I	SHEET 7 OF 221