


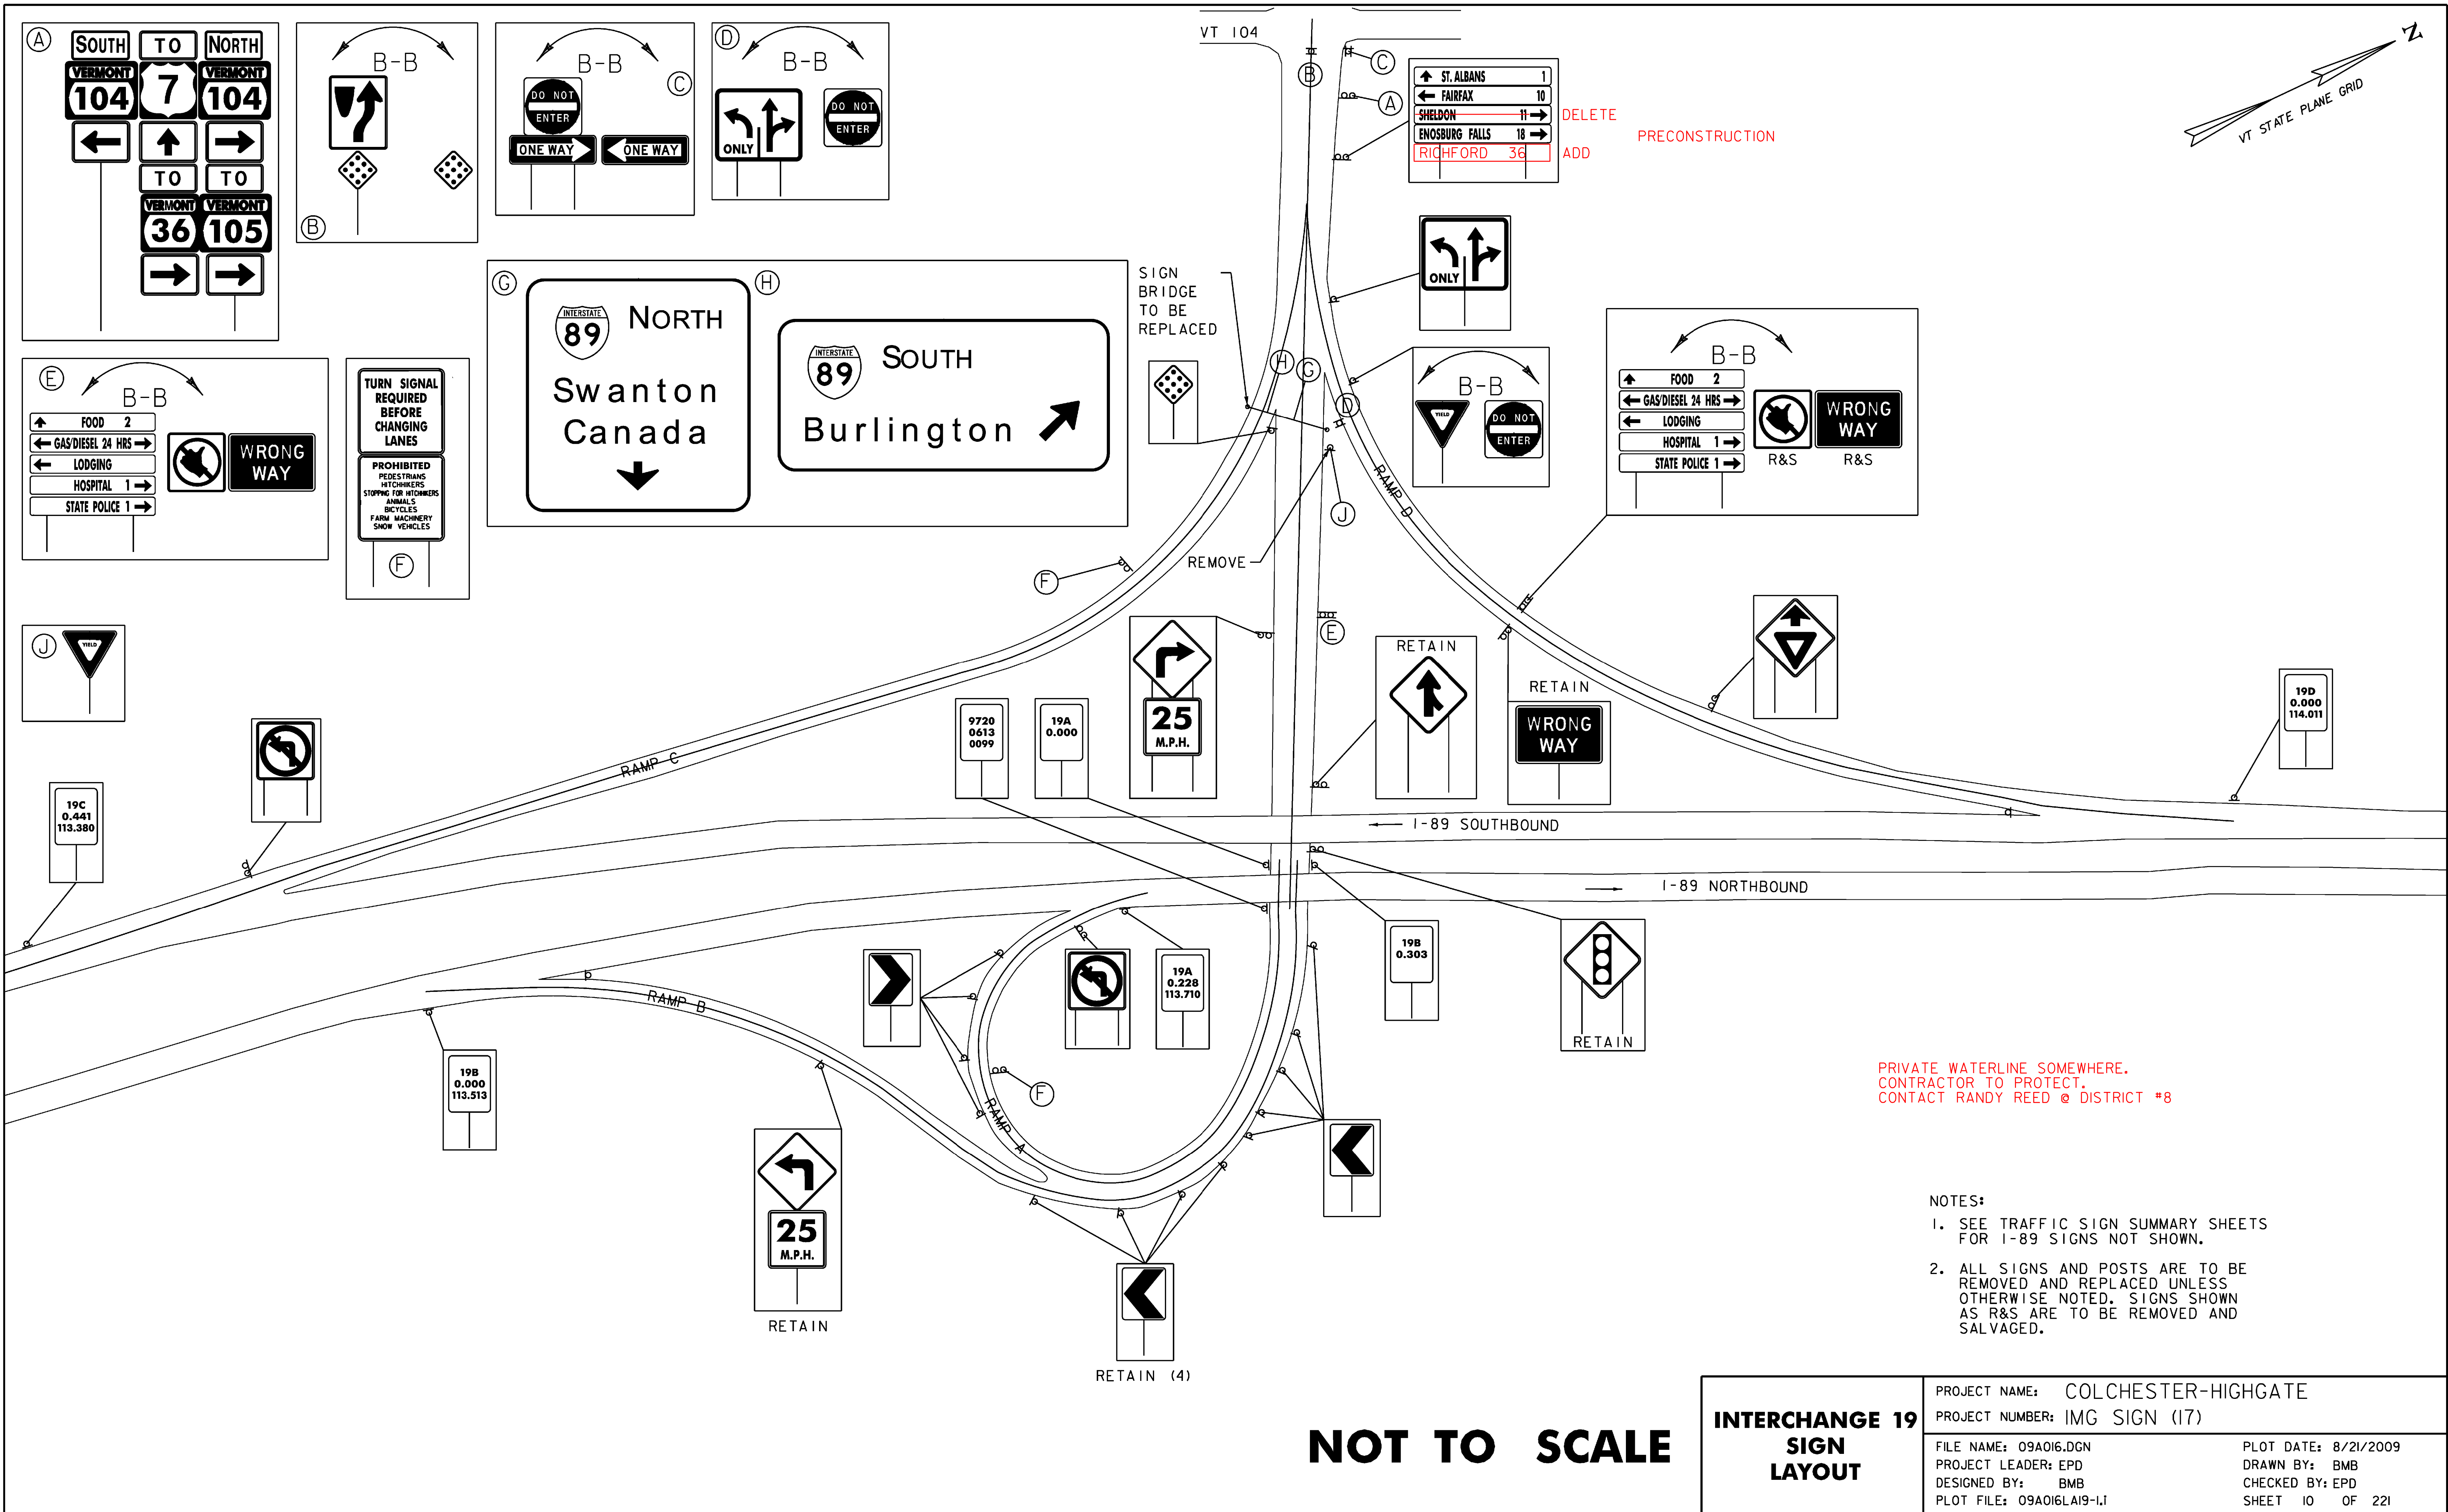

(A)

SOUTH

VERMONT 104

←

TO

7

↑

NORTH

VERMONT 104

→

TO

VERMONT 36

→

TO

VERMONT 105

→

(B)

B-B

↶

↷

(C)

B-B

DO NOT ENTER

ONE WAY

DO NOT ENTER

ONE WAY

(D)

B-B

ONLY

↶

↷

DO NOT ENTER

(E)

B-B

FOOD 2

← GAS/DIESEL 24 HRS →

← LODGING →

HOSPITAL 1 →

STATE POLICE 1 →

↶

WRONG WAY

(F)

TURN SIGNAL REQUIRED BEFORE CHANGING LANES

PROHIBITED
PEDESTRIANS
HITCHHIKERS
STOPPING FOR HITCHHIKERS
ANIMALS
BICYCLES
FARM MACHINERY
SNOW VEHICLES

(J)

YIELD

(K)

↶

WRONG WAY

(G)

INTERSTATE 89 NORTH

Swanton
Canada

↓

(H)

INTERSTATE 89 SOUTH

Burlington

↗

SIGN BRIDGE TO BE REPLACED

(I)

REMOVE

(L)

↶

25 M.P.H.

(M)

ST. ALBANS 1

FAIRFAX 10

~~SHELDON 11~~

ENOSBURG FALLS 18

RICHFORD 36

DELETE PRECONSTRUCTION
ADD

(N)

ONLY

(O)

B-B

YIELD

DO NOT ENTER

(P)

B-B

FOOD 2

← GAS/DIESEL 24 HRS →

← LODGING →

HOSPITAL 1 →

STATE POLICE 1 →

↶


WRONG WAY

R&S R&S

(Q)

↶

WRONG WAY

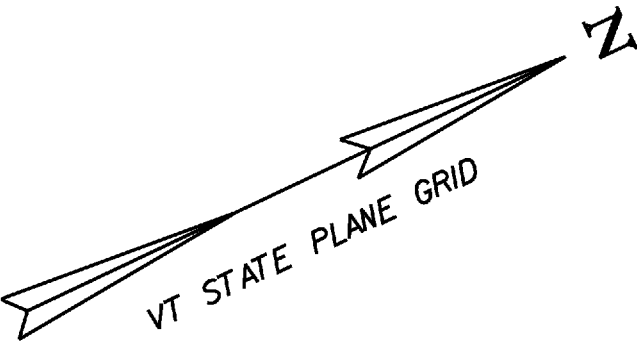

PRIVATE WATERLINE SOMEWHERE.
CONTRACTOR TO PROTECT.
CONTACT RANDY REED @ DISTRICT #8

- NOTES:
- 1. SEE TRAFFIC SIGN SUMMARY SHEETS FOR I-89 SIGNS NOT SHOWN.
 - 2. ALL SIGNS AND POSTS ARE TO BE REMOVED AND REPLACED UNLESS OTHERWISE NOTED. SIGNS SHOWN AS R&S ARE TO BE REMOVED AND SALVAGED.

NOT TO SCALE

INTERCHANGE 19
SIGN
LAYOUT

PROJECT NAME: COLCHESTER-HIGHGATE	
PROJECT NUMBER: IMG SIGN (17)	
FILE NAME: 09A016.DGN	PLOT DATE: 8/21/2009
PROJECT LEADER: EPD	DRAWN BY: BMB
DESIGNED BY: BMB	CHECKED BY: EPD
PLOT FILE: 09A016LA19-I.I	SHEET 10 OF 221