
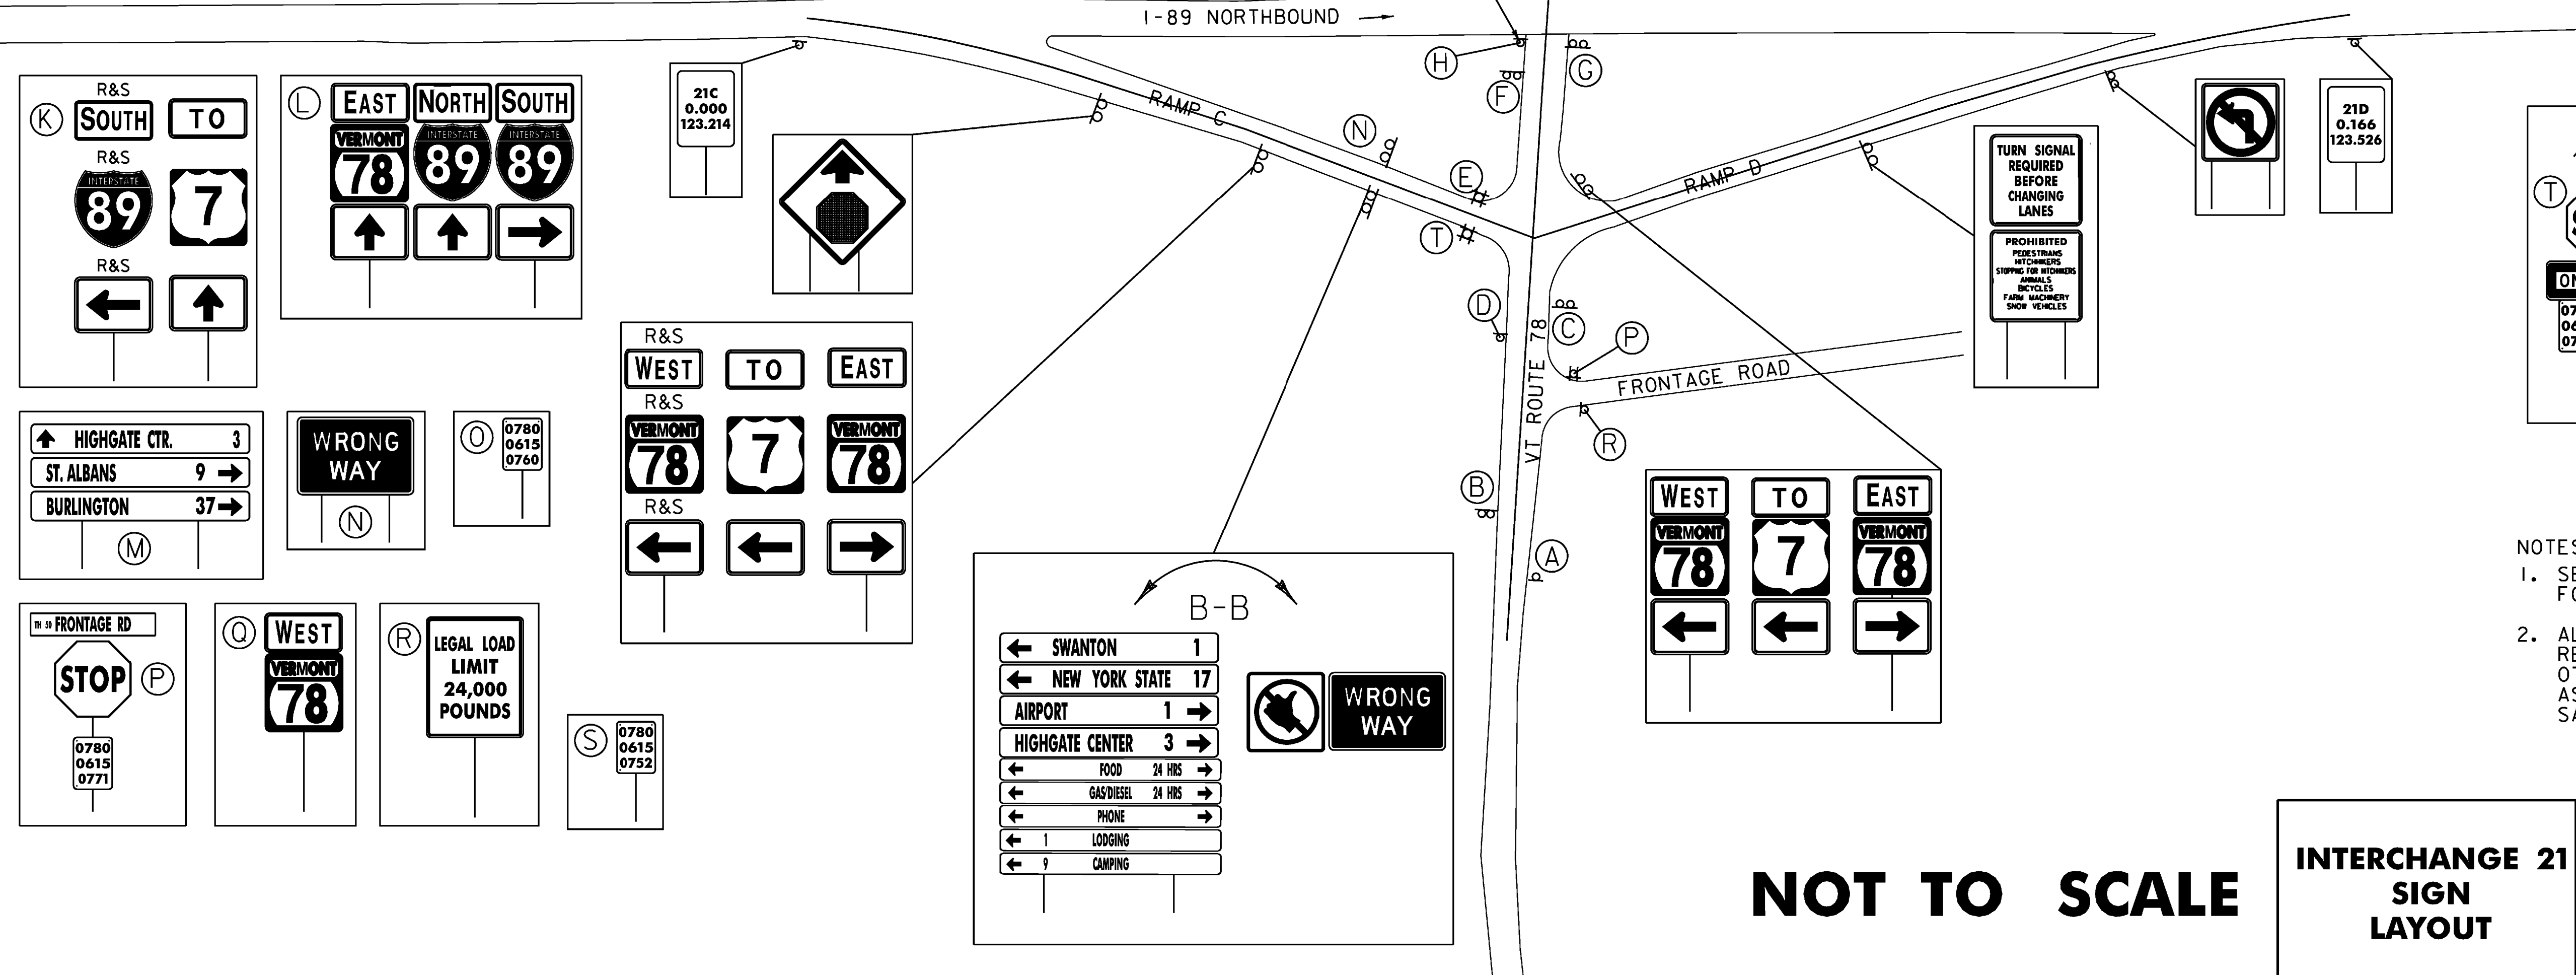
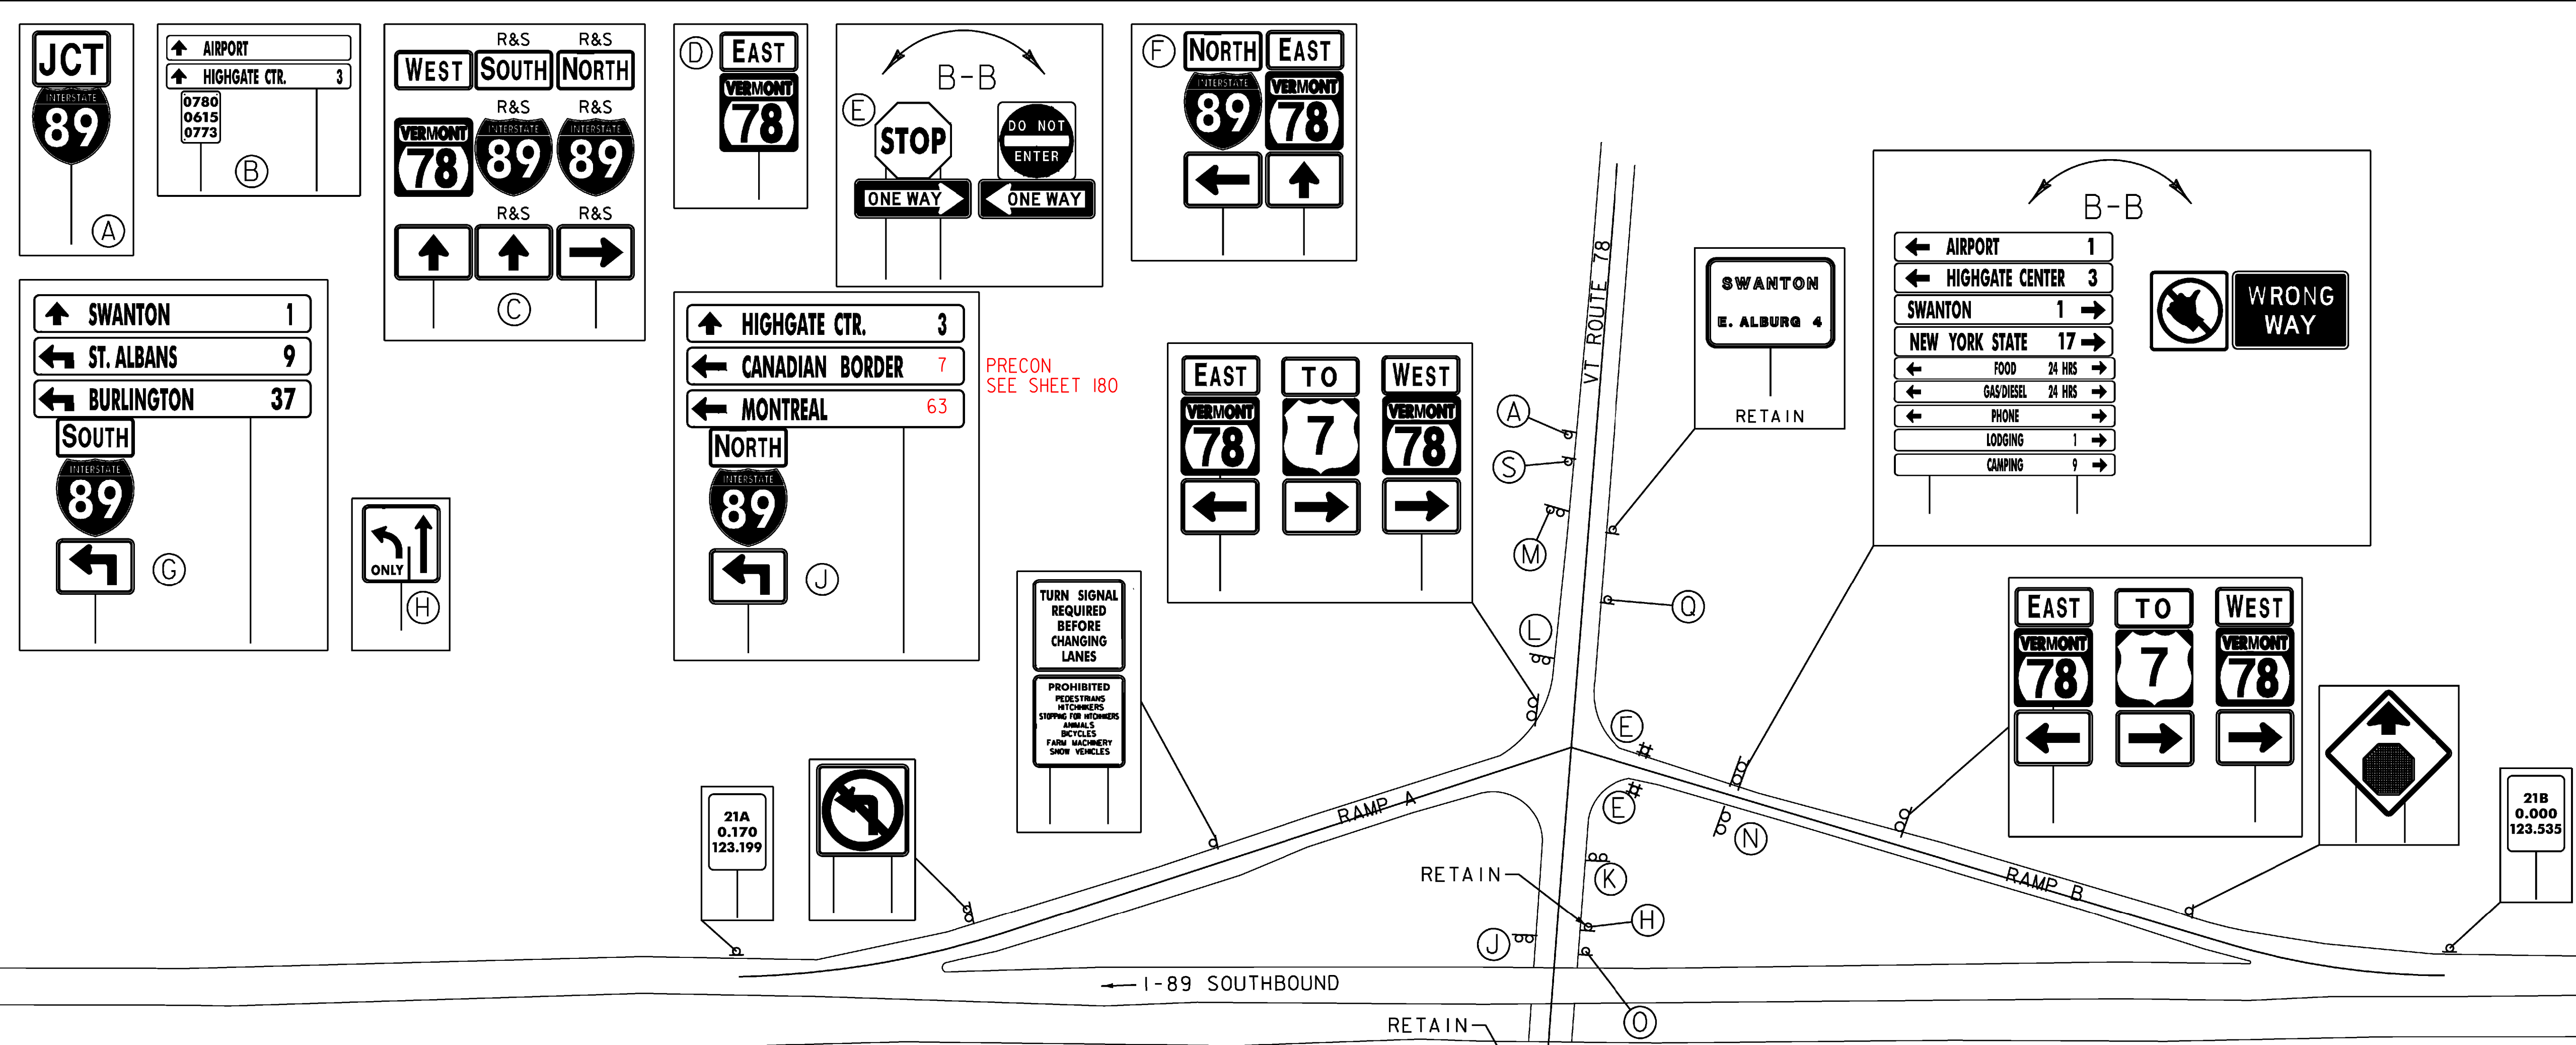


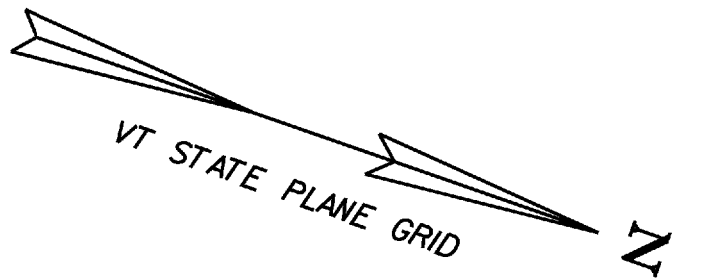

- NOTES:
1. SEE TRAFFIC SIGN SUMMARY SHEETS FOR I-89 SIGNS NOT SHOWN.
 2. ALL SIGNS AND POSTS ARE TO BE REMOVED AND REPLACED UNLESS OTHERWISE NOTED. SIGNS SHOWN AS R&S ARE TO BE REMOVED AND SALVAGED.

NOT TO SCALE

INTERCHANGE 21
SIGN
LAYOUT

PROJECT NAME: COLCHESTER-HIGHGATE	
PROJECT NUMBER: IMG SIGN (I7)	
FILE NAME: 09A016.DGN	PLOT DATE: 8/21/2009
PROJECT LEADER: EPD	DRAWN BY: BMB
DESIGNED BY: BMB	CHECKED BY: EPD
PLOT FILE: 09A016LA21-I7	SHEET 12 OF 221