


SB RAMP D TYPE II WHITE 6
TYPE I YELLOW 5
TYPE III WHITE/ R BACK 3
TYPE III YELLOW/ R BACK 3

SB RAMP C TYPE I YELLOW 8
TYPE II WHITE 6

NB RAMP A TYPE II WHITE 6
TYPE I YELLOW 3
TYPE III WHITE/ R BACK 4
TYPE III YELLOW/ R BACK 4

NB RAMP B TYPE I WHITE 6
TYPE I YELLOW 8
TYPE II WHITE 10

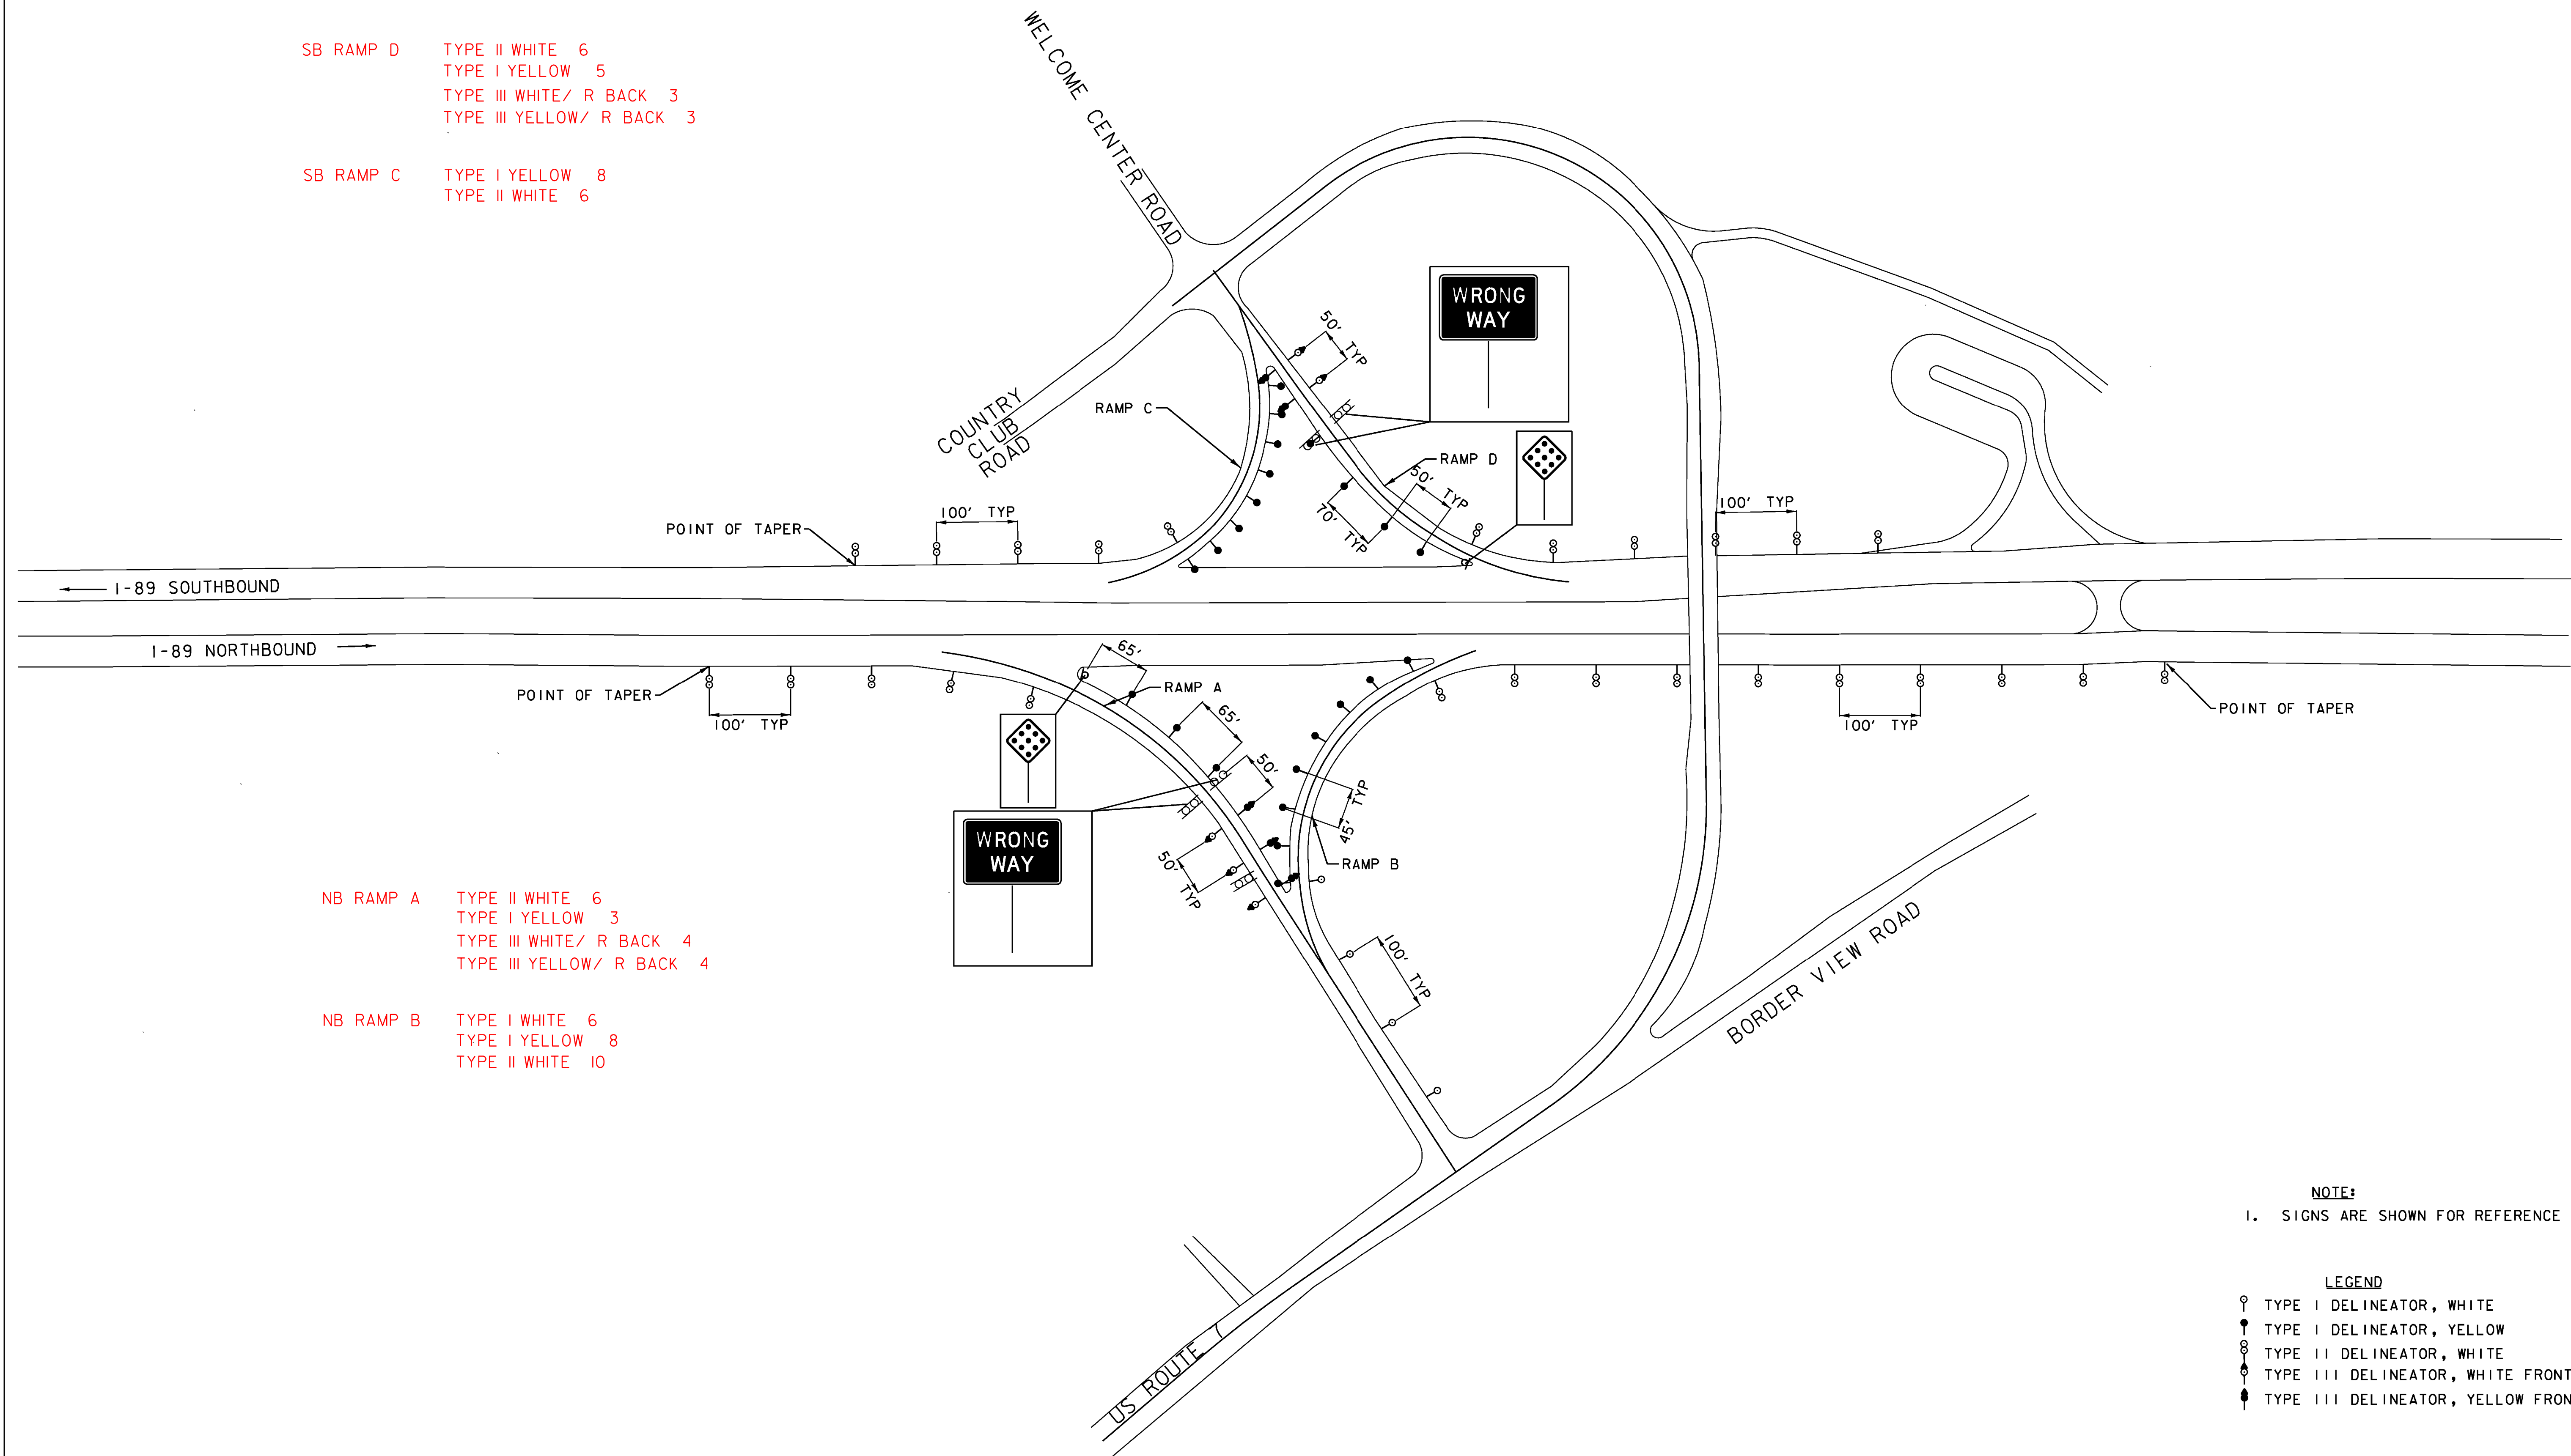

NOTE:
1. SIGNS ARE SHOWN FOR REFERENCE ONLY.

LEGEND
○ TYPE I DELINEATOR, WHITE
● TYPE I DELINEATOR, YELLOW
○ TYPE II DELINEATOR, WHITE
○ TYPE III DELINEATOR, WHITE FRONT / RED BACK
● TYPE III DELINEATOR, YELLOW FRONT / RED BACK

**INTERCHANGE 22
DELINEATOR
LAYOUT**

PROJECT NAME: COLCHESTER-HIGHGATE
PROJECT NUMBER: IMG SIGN (17)

FILE NAME: 09A016.DGN
PROJECT LEADER: EPD
DESIGNED BY: BMB
PLOT FILE: 09A016I22DL.I

PLOT DATE: 8/21/2009
DRAWN BY: BMB
CHECKED BY: EPD
SHEET 22 OF 221