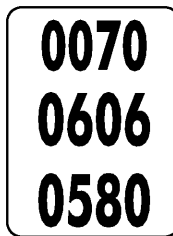
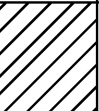


STATE OF VERMONT AGENCY OF TRANSPORTATION																																								TRAFFIC SIGN SUMMARY SHEET															
MILEMARKER, STATION, OR SIGN NUMBER	SIGN LEGEND	SIGN DIMENSIONS			NEW & SALVAGED SIGNS				EXIST POST		NEW SIGN POSTS																		REMARKS				SIGN DETAIL																						
					“A”	“B”	SALV SIGN	SALV TIS	RETAIN	SALVAGE	NO. OF POSTS	FLANGED CHANNEL			SQUARE STEEL (in)			TUBULAR ALUMINUM Ø (in)			TUBULAR STEEL Ø (in)				W-SHAPE STEEL								DETAIL ON SHEET NUMBER	STD. SHEET NUMBER																					
		lb/ft	1.75	2.0								2.5	ANCHOR	SLEEVE	3.0	4.0	4.0 MOD	FOUND- ATION	3.0	3.5	4.0	5.0	FTG. SIZE		WEIGHT	POST SIZE																													
																							1.12	2.0			3.0	1.88	2.42	3.35	1.3	1.7			1.7	7.6	9.0	10.8	14.6	24"	30"														
OPTION ITEMS																																																							
EXIT 22 US ROUTE 7 MM. 5.745 RT		I	21	15	2.19						I					X			X																M2-I	WHITE ON BLUE		SHS																	
		I	24	24	4.00																														MI-I		SHS																		
EXIT 22 US ROUTE 7 MM. 5.770 LT		I	30	24	5.00						I					X			X																D4-I		SHS																		
EXIT 22 US ROUTE 7 MM. 5.775 RT		I	72	12	6.00						2					X			X																DI-I		E-I23																		
																																																							
																																																							
EXIT 22 US ROUTE 7 MM. 5.795 LT		I	30	30	6.25						I					X			X																VW-290		E-I50																		
		I	24	18	3.00																														W7-3A		SHS																		
EXIT 22 US ROUTE 7 MM. 5.800 RT		I	6	10	0.42						I					X			X																VD-700		E-I38																		
FINAL POST LENGTHS ARE TO BE DETERMINED IN THE FIELD. POST SIZES ARE COMPUTED BASED ON INFORMATION FURNISHED ON THE VTRANS STANDARD SHEETS AND "SIGN POST DESIGN GUIDELINE".												FT	FT	FT	FT 8	FT 75	FT		EA	LB	LB	LB		LB	LB	LB	LB																												
												FT			FT			LB			EA	LB			EA	EA	INTERCHANGE 22 TRAFFIC SIGN SUMMARY SHEET 6		PROJECT NAME: COLCHESTER-HIGHGATE PROJECT NUMBER: IMG SIGN (17)																										
																													FILE NAME: 09A016.DGN PROJECT LEADER: EPD DESIGNED BY: BMB PLOT FILE: 09A016TSSS22-6.1				PLOT DATE: 8/21/2009 DRAWN BY: BMB CHECKED BY: EPD SHEET 191 OF 221																						