


NOTE:

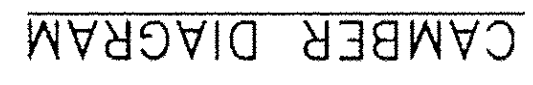

১০৫৮৭৮

REVISIONS

AISC CERTIFIED FABRICATOR

