


```

NB- TYPE A: 15
    TYPE B: 9
    BRIDGE PLAQUE: 1
SB- TYPE A: 14
    TYPE B: 5
    BRIDGE PLAQUE: 0

```

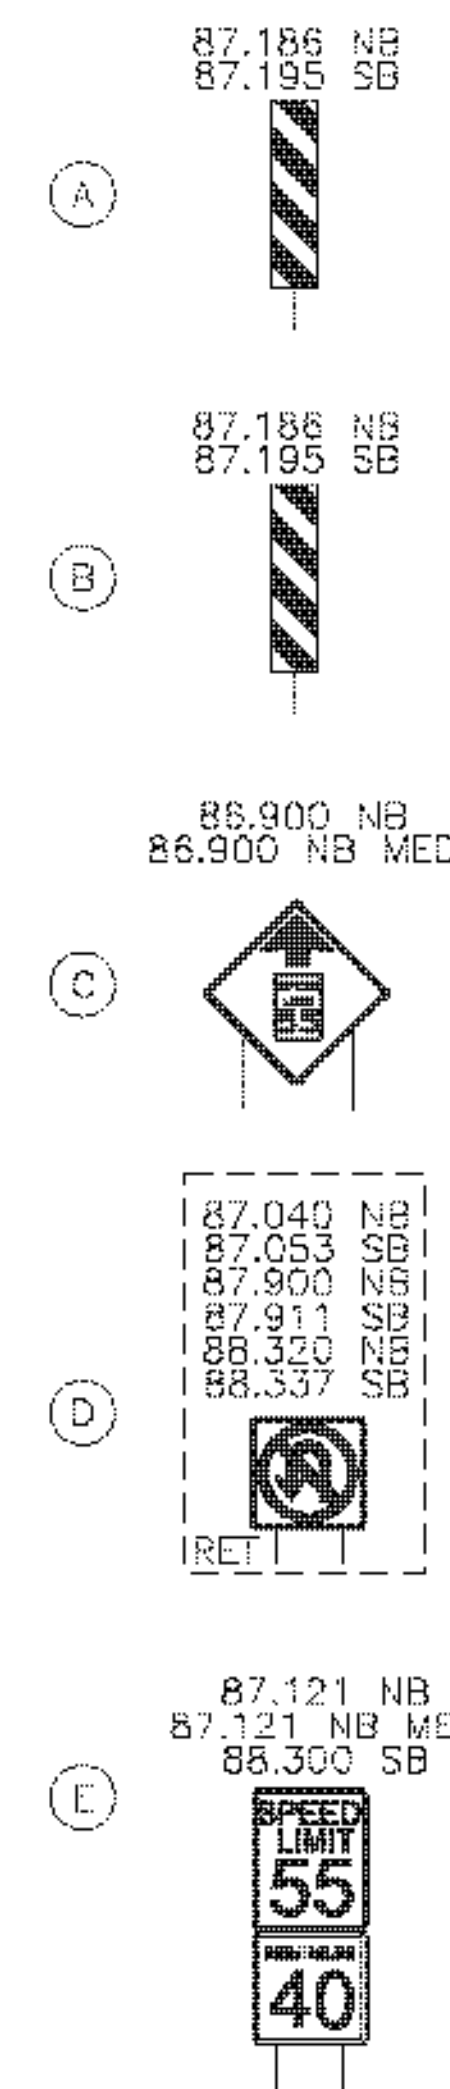

[RET] - RETAIN
[R&S] - REMOVE AND SALVAGE

**EXISTING SIGNS
MAINLINE (7)
86.600 - 88.930**

SHEET 13 OF 174