


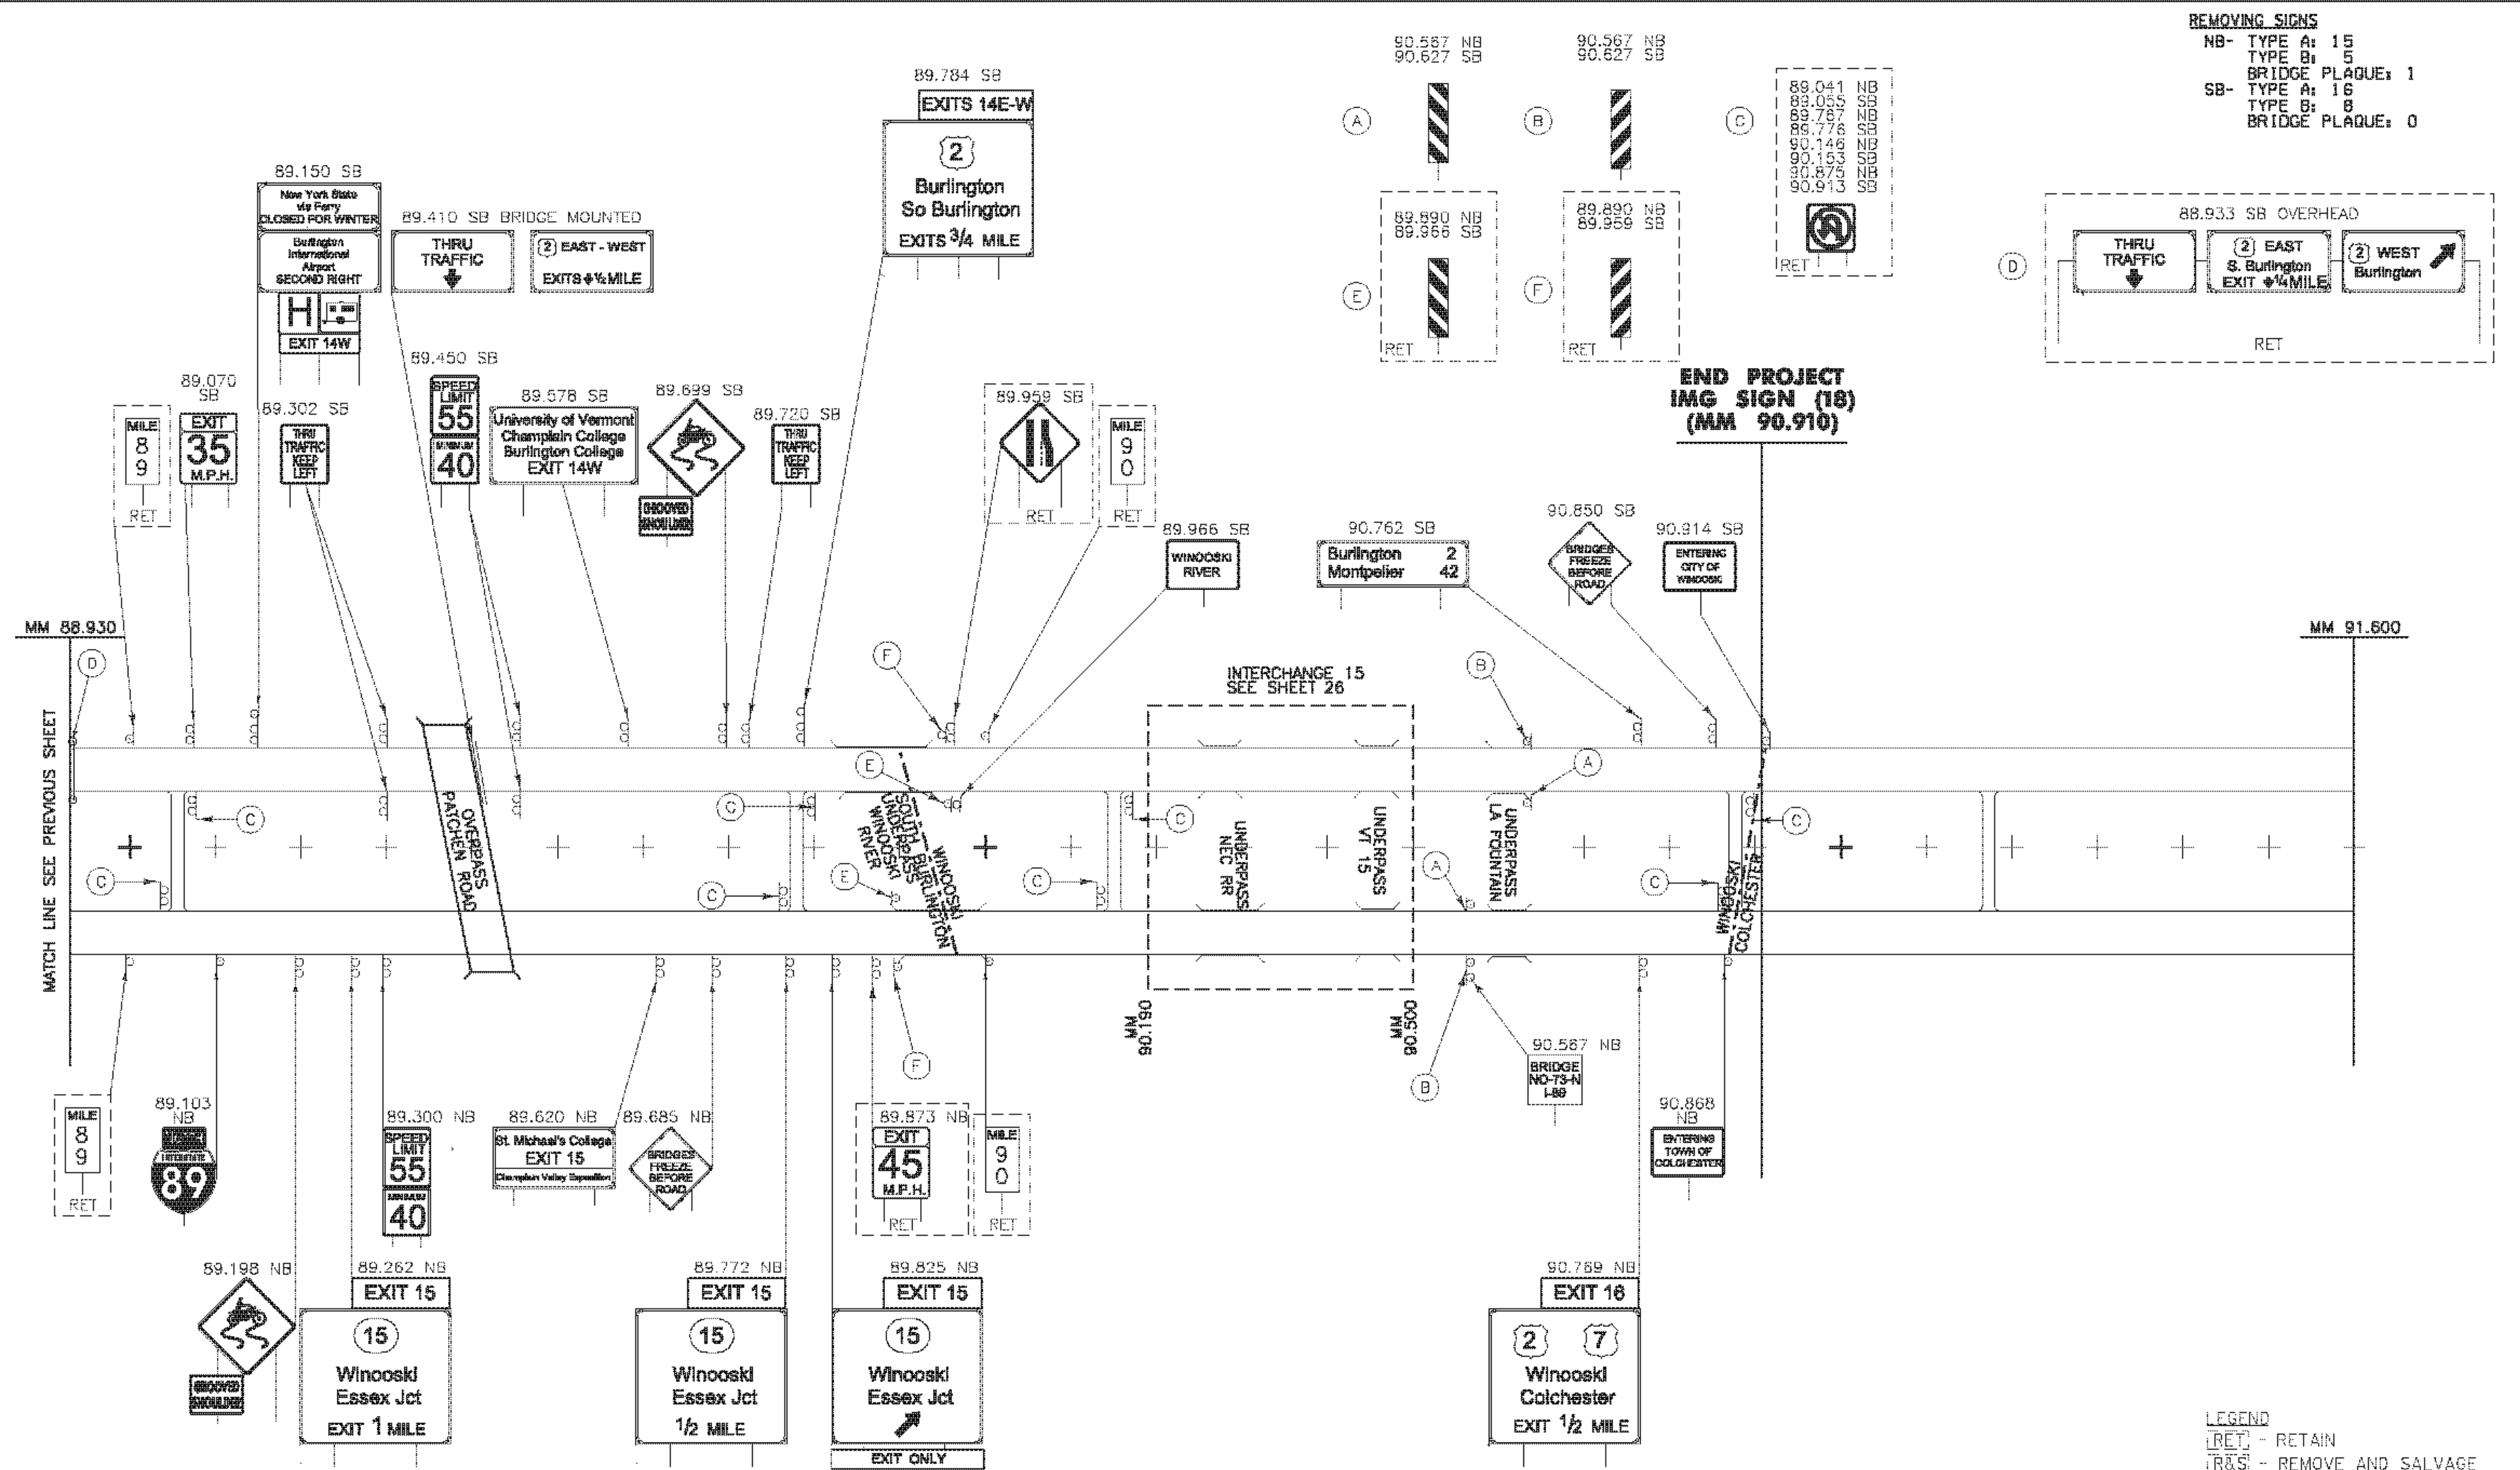

ALL SIGNS AND POSTS WILL BE REMOVED UNLESS OTHERWISE NOTED

**EXISTING SIGNS
MAINLINE (8)
88.930 - 91.600**

PROJECT NAME:	WATERBURY - WINOOSKI
PROJECT NUMBER:	IMG SIGN(18)
FILE NAME:	z09a018mainline.dgn
PROJECT LEADER:	CRB
DESIGNED BY:	BDB
CLD REF. NO.:	09-0124
PLOT DATE:	10/27/2009
DRAWN BY:	JBZ
CHECKED BY:	DAM
SHEET	14 OF 174