


REMOVING SIGNS
TYPE A: 181
TYPE B: 2
BRIDGE PLAQUE: 6

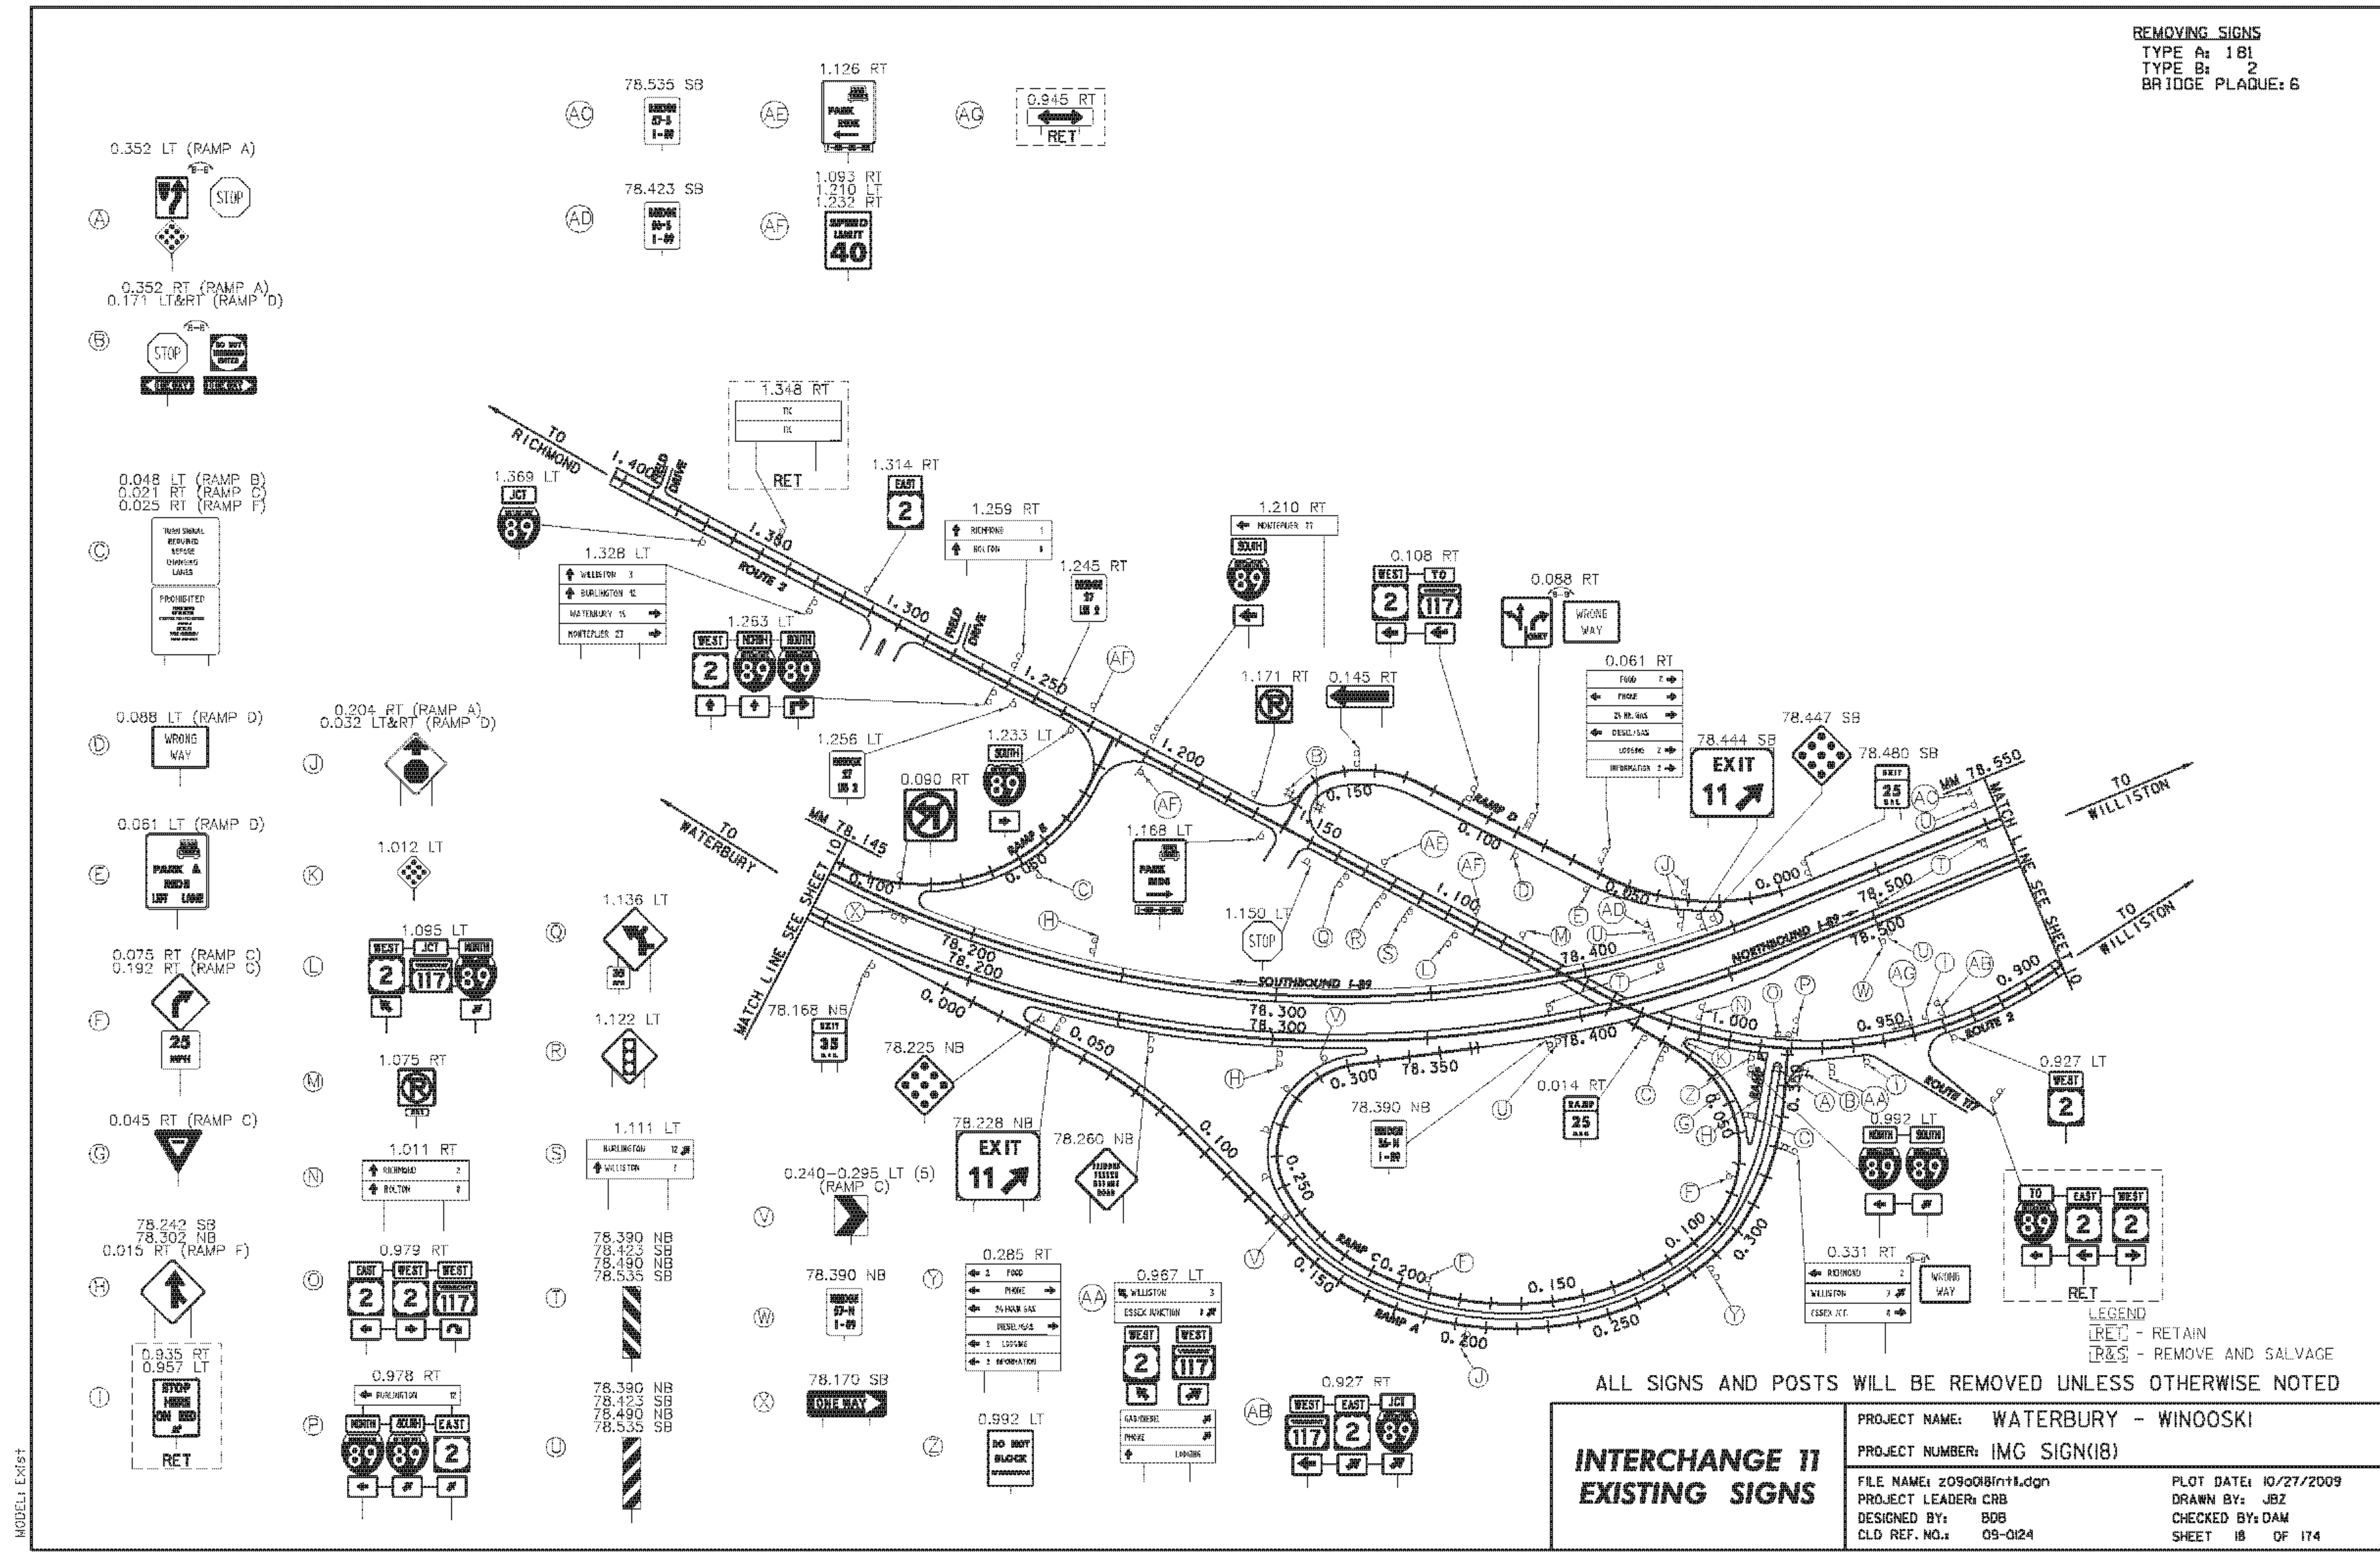

0.352 LT (RAMP A)
0.352 RT (RAMP A)
0.171 LT&RT (RAMP D)

0.048 LT (RAMP B)
0.021 RT (RAMP C)
0.025 RT (RAMP F)

0.088 LT (RAMP D)
WRONG WAY

0.061 LT (RAMP D)
PARK & RIDE LOT

0.075 RT (RAMP C)
0.192 RT (RAMP C)
25 MPH

0.045 RT (RAMP C)
YIELD

78.242 SB
78.302 NB
0.015 RT (RAMP F)
0.935 RT
0.957 LT
STOP HERE ON RED
RET

0.204 RT (RAMP A)
0.032 LT&RT (RAMP D)
1.012 LT

1.095 LT
WEST 2
JCT 117
NORTH 89

1.075 RT
1.011 RT
RICHMOND 2
WATERBURY 1

0.979 RT
0.978 RT
NORTH 89
ACORN 89
EAST 2

78.535 SB
78.423 SB
1.126 RT
1.093 RT
1.210 LT
1.232 RT
PARK SIDE
SUPERIOR LIGHT 40

1.348 RT
1.369 LT
1.328 LT
WATERBURY 3
BURLINGTON 12
MONTPELIER 15
MONTPELIER 23

1.136 LT
1.122 LT
1.111 LT
BURLINGTON 12
WATERBURY 1

78.390 NB
78.423 SB
78.490 NB
78.535 SB
78.390 NB
78.423 SB
78.490 NB
78.535 SB
78.170 SB
ONE WAY

1.259 RT
1.245 RT
1.171 RT
1.150 LT
1.168 LT
1.233 LT
0.090 RT
0.050 RT
0.050 RT

1.256 LT
1.233 LT
1.233 LT
0.090 RT
0.050 RT
0.050 RT
0.050 RT

0.285 RT
0.967 LT
0.927 RT
0.927 LT
0.927 RT
0.927 LT
0.927 RT
0.927 LT

1.210 RT
0.108 RT
0.088 RT
0.061 RT
0.061 RT
0.061 RT
0.061 RT

0.150 RT
0.145 RT
0.145 RT
0.927 RT
0.927 LT
0.927 RT
0.927 LT
0.927 RT
0.927 LT
0.927 RT
0.927 LT

0.061 RT
0.061 RT
0.014 RT
0.014 RT
0.331 RT
0.331 RT
78.447 SB
78.444 SB
78.480 SB
78.500 SB
78.500 SB
78.500 SB
78.500 SB

0.927 LT
0.927 LT
ALL SIGNS AND POSTS WILL BE REMOVED UNLESS OTHERWISE NOTED

INTERCHANGE 11
EXISTING SIGNS

PROJECT NAME:	WATERBURY - WINOOSKI
PROJECT NUMBER:	IMG SIGN(18)
FILE NAME:	209a018Int1.dgn
PROJECT LEADER:	CRB
DESIGNED BY:	BDG
CLD REF. NO.:	09-0124
PLOT DATE:	10/27/2009
DRAWN BY:	JBZ
CHECKED BY:	DAM
SHEET	18 OF 174

LEGEND
RET - RETAIN
R&S - REMOVE AND SALVAGE