


REMOVING SIGNS
TYPE A: 63
TYPE B: 3
BRIDGE PLAQUE: 0

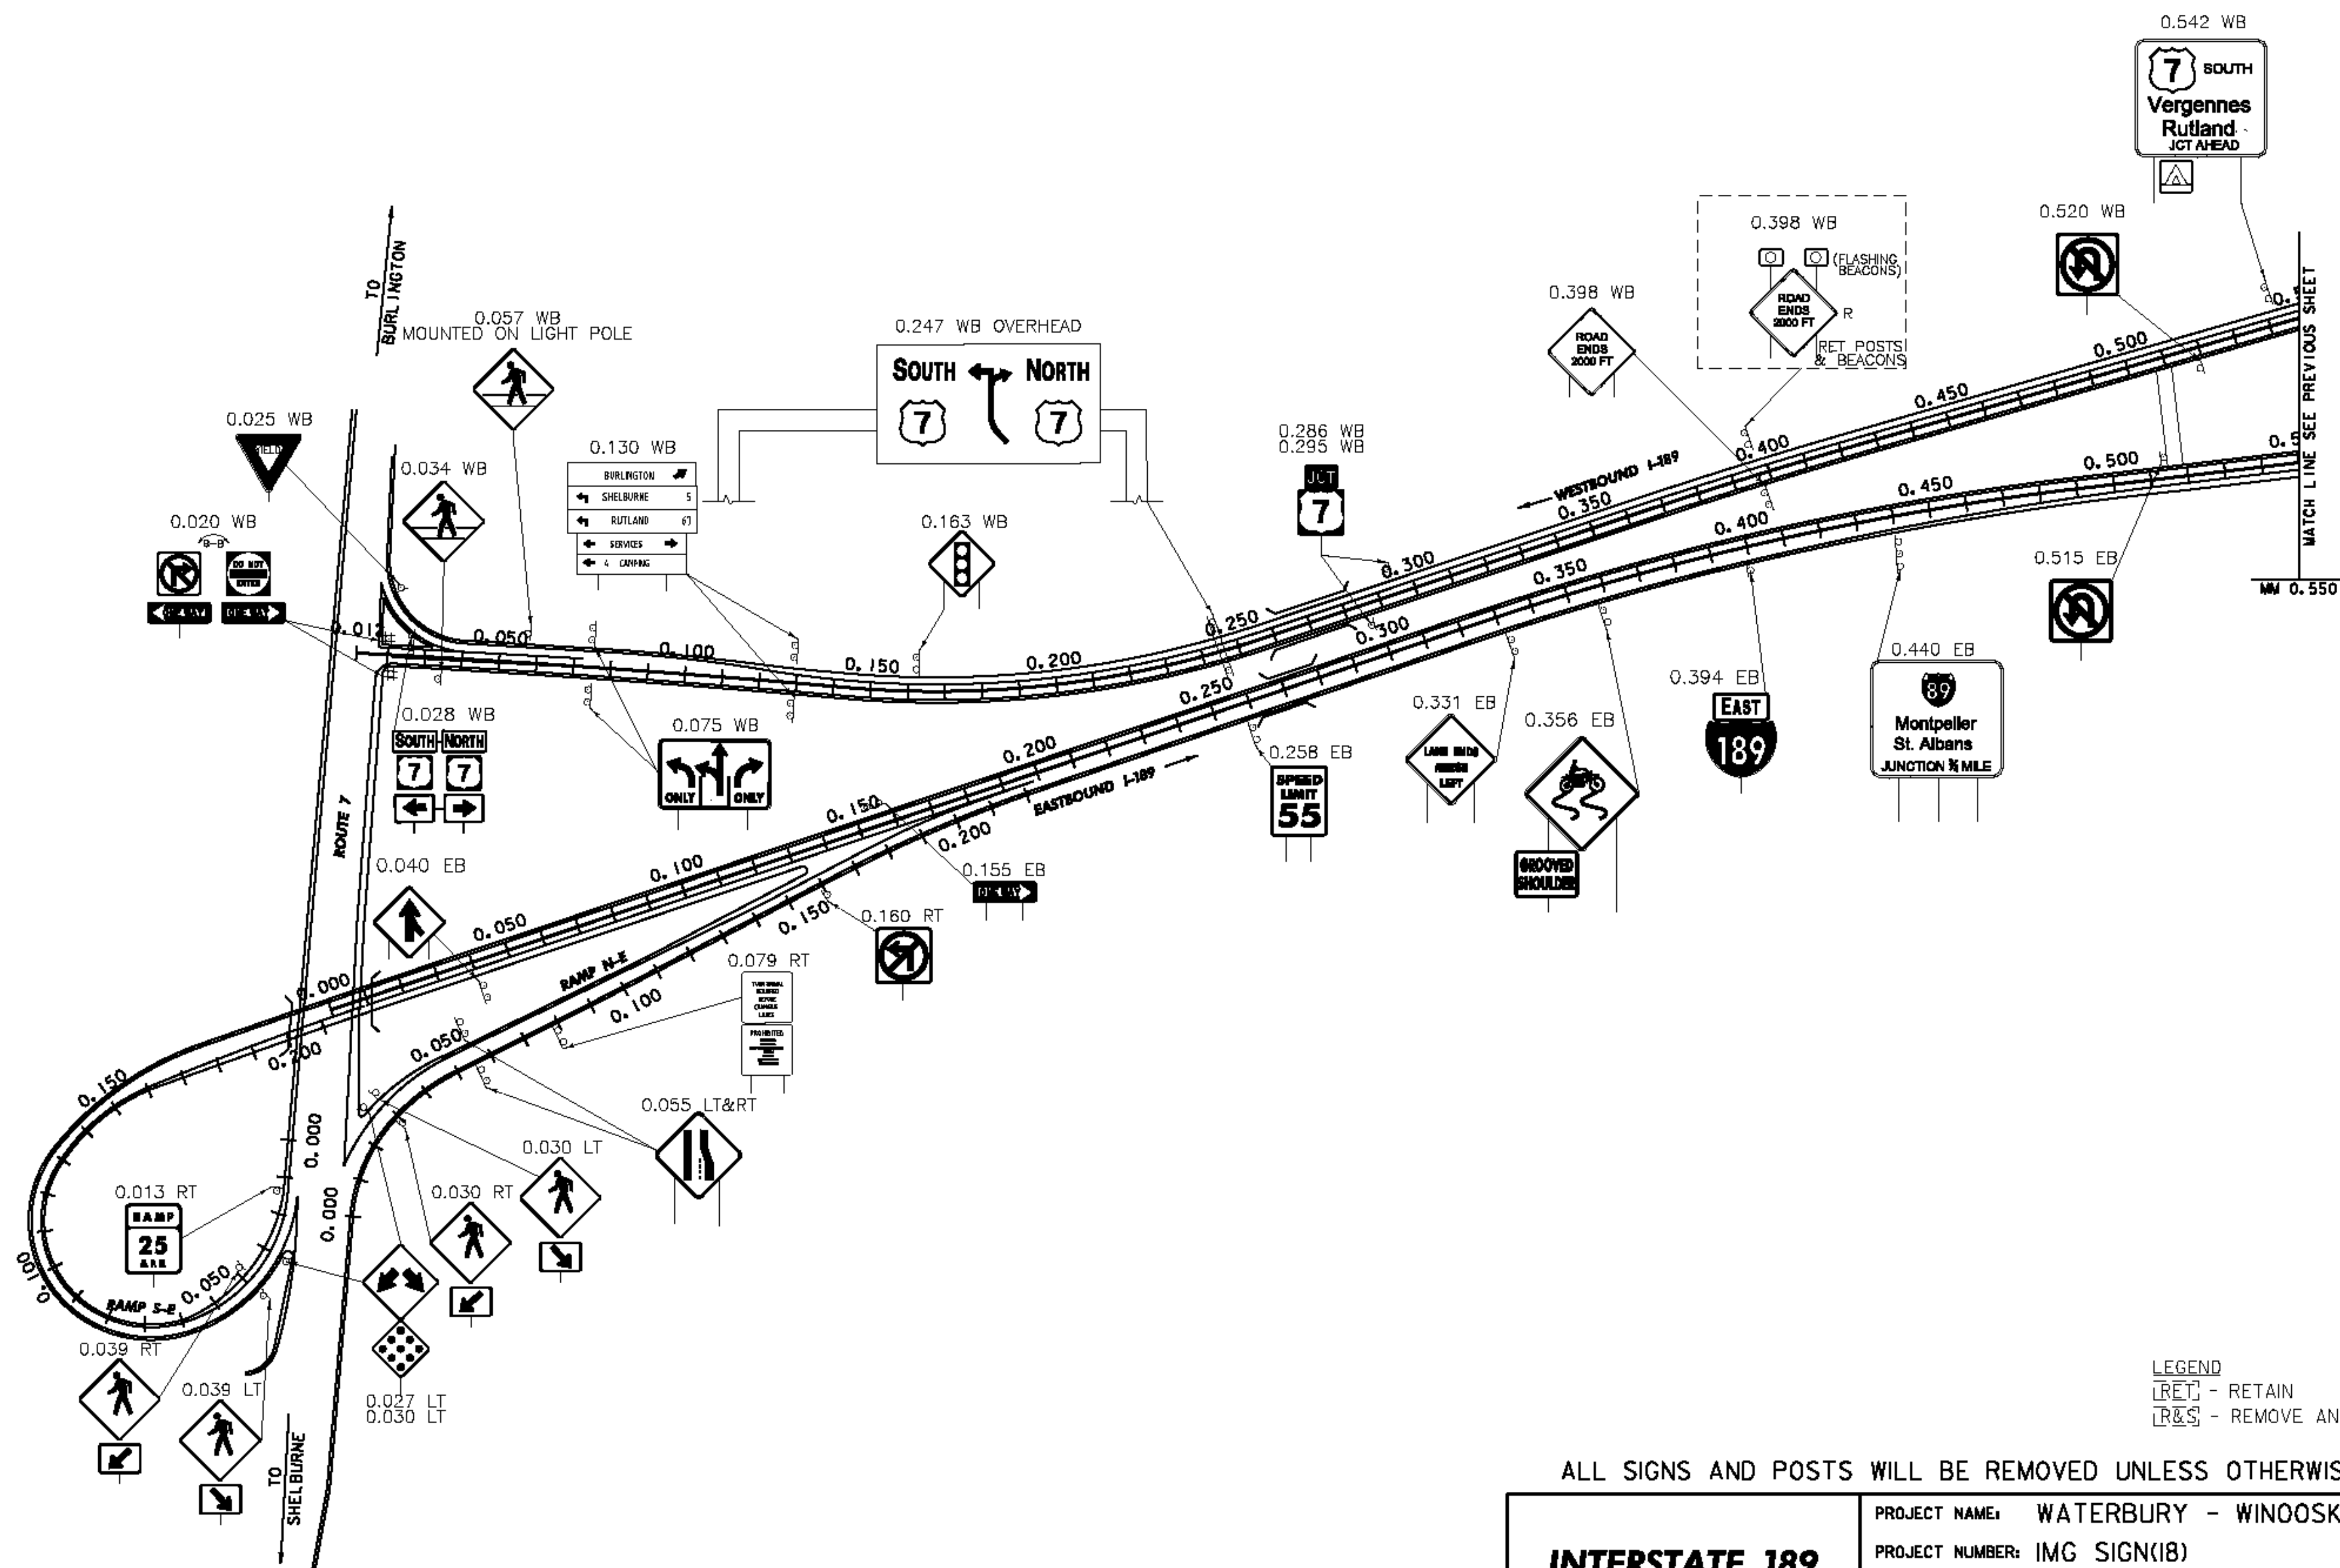

LEGEND
~~[RET]~~ - RETAIN
~~[R&S]~~ - REMOVE AND SALVAGE

ALL SIGNS AND POSTS WILL BE REMOVED UNLESS OTHERWISE NOTED

INTERSTATE 189 EXISTING SIGNS

PROJECT NAME:	WATERBURY - WINOOSKI
---------------	----------------------

PROJECT NUMBER: IMG SIGN(18)

FILE NAME: z09a018Int+13.dgn

PROJECT LEADER: CRB

DESIGNED BY: BDB
CLD REF. NO.: 09-0124

PLOT DATE: 10/27/2009

DRAWN BY: J B Z

CHECKED BY: DAM

SHEET 24 OF 174