

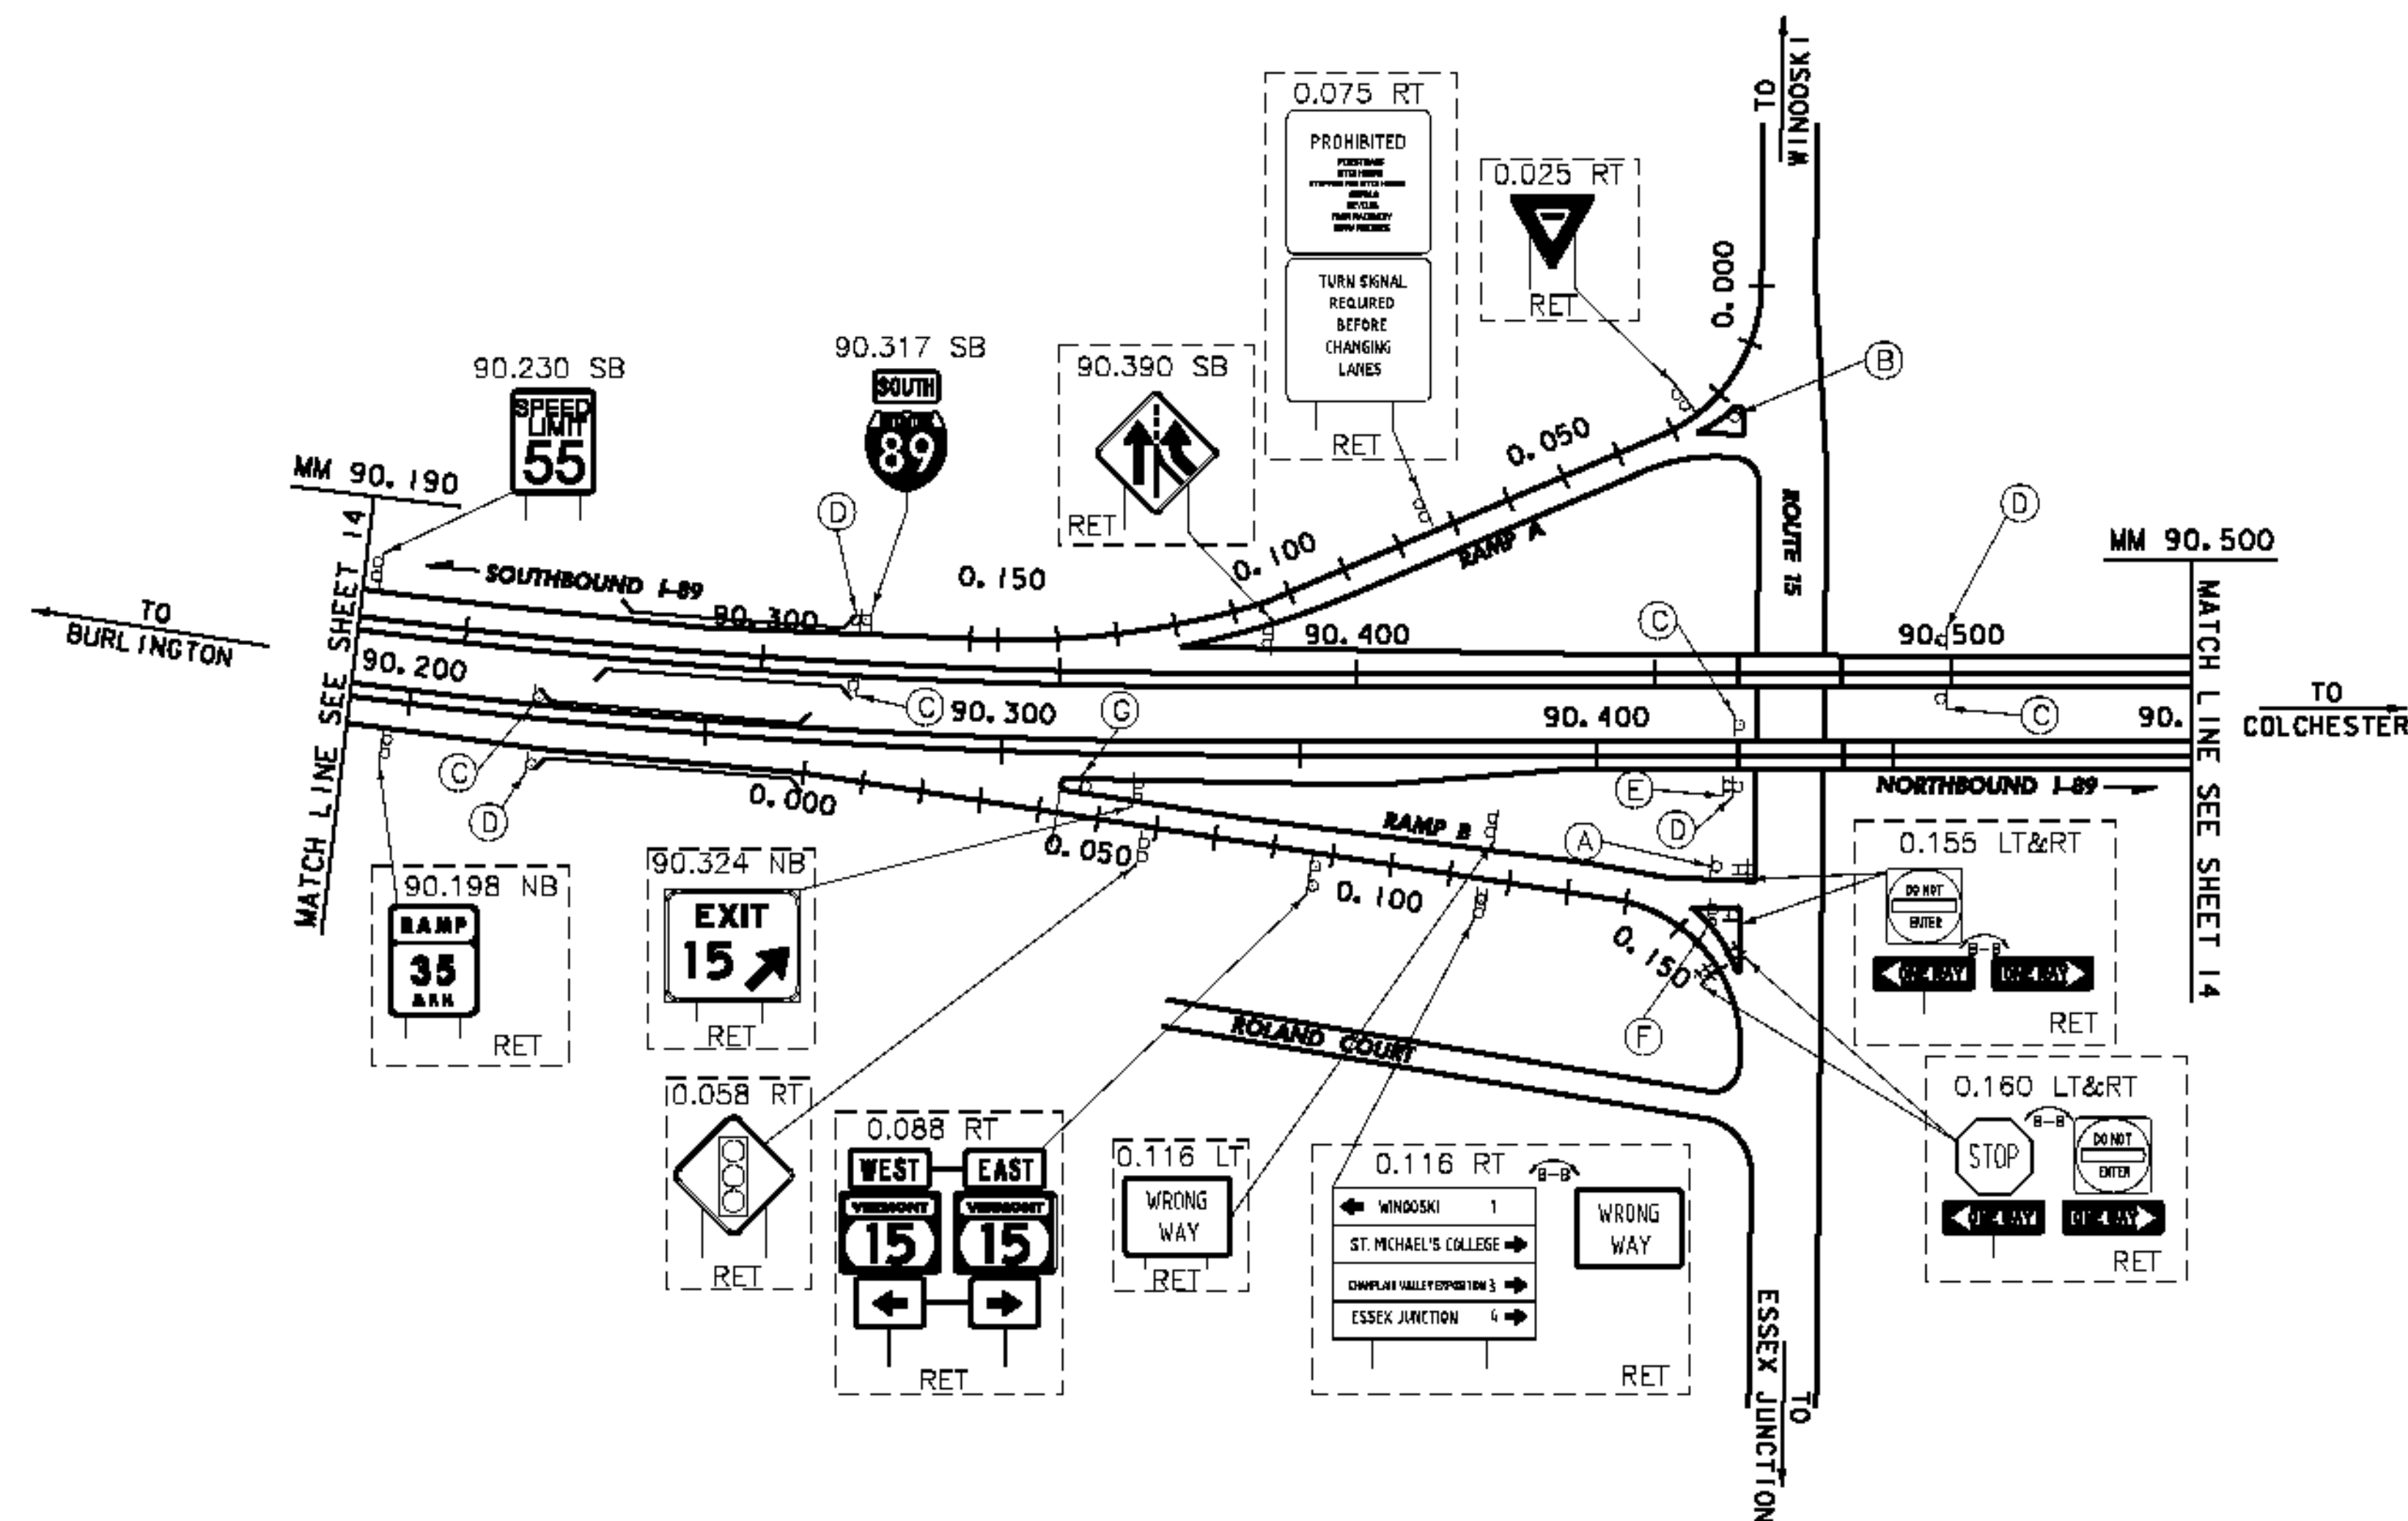
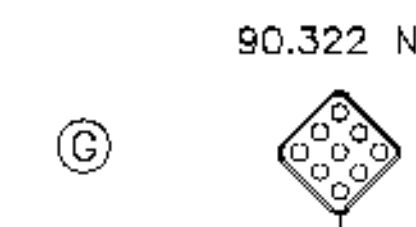
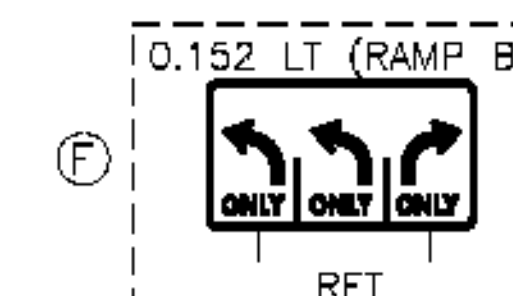
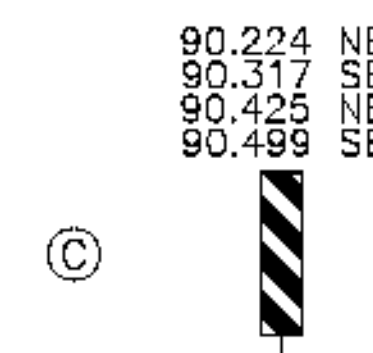
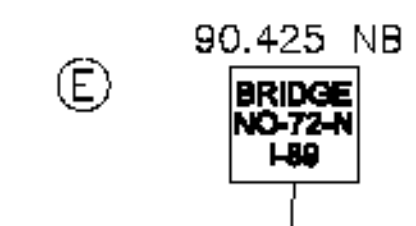
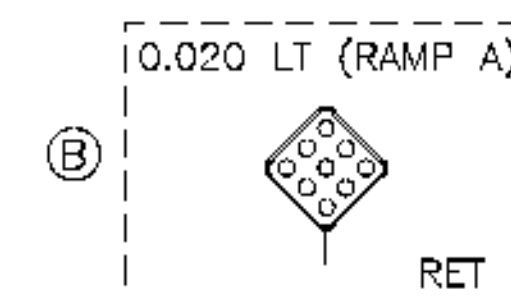


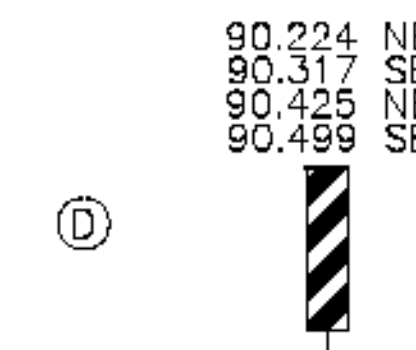

REMOVING SIGNS
TYPE A: 12
TYPE B: 0
BRIDGE PLAQUE: 1

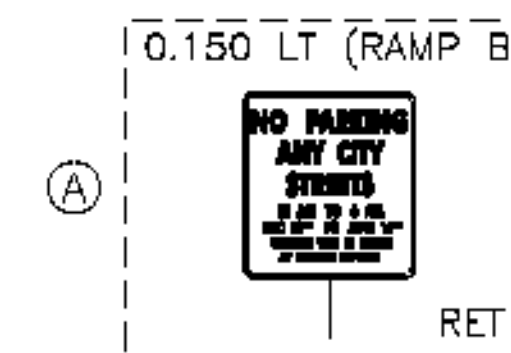

LEGEND
[RET] - RETAIN
[R&S] - REMOVE AND SALVAGE

ALL SIGNS AND POSTS WILL BE REMOVED UNLESS OTHERWISE NOTED
RAMP B TO BE ADDRESSED WITH PROJECT NH 089-3(65)

INTERCHANGE 15 EXISTING SIGNS

PROJECT NAME: WATERBURY - WINOOSKI

PROJECT NUMBER: IMG SIGN(18)

FILE NAME: z09a018Int15.dgn

PROJECT LEADER: CRB

DESIGNED BY: BDB

CLD REF. NO.: 09-0124

PLOT DATE: 10/27/2009

DRAWN BY: JBZ

CHECKED BY: DAM

SHEET 26 OF 174