


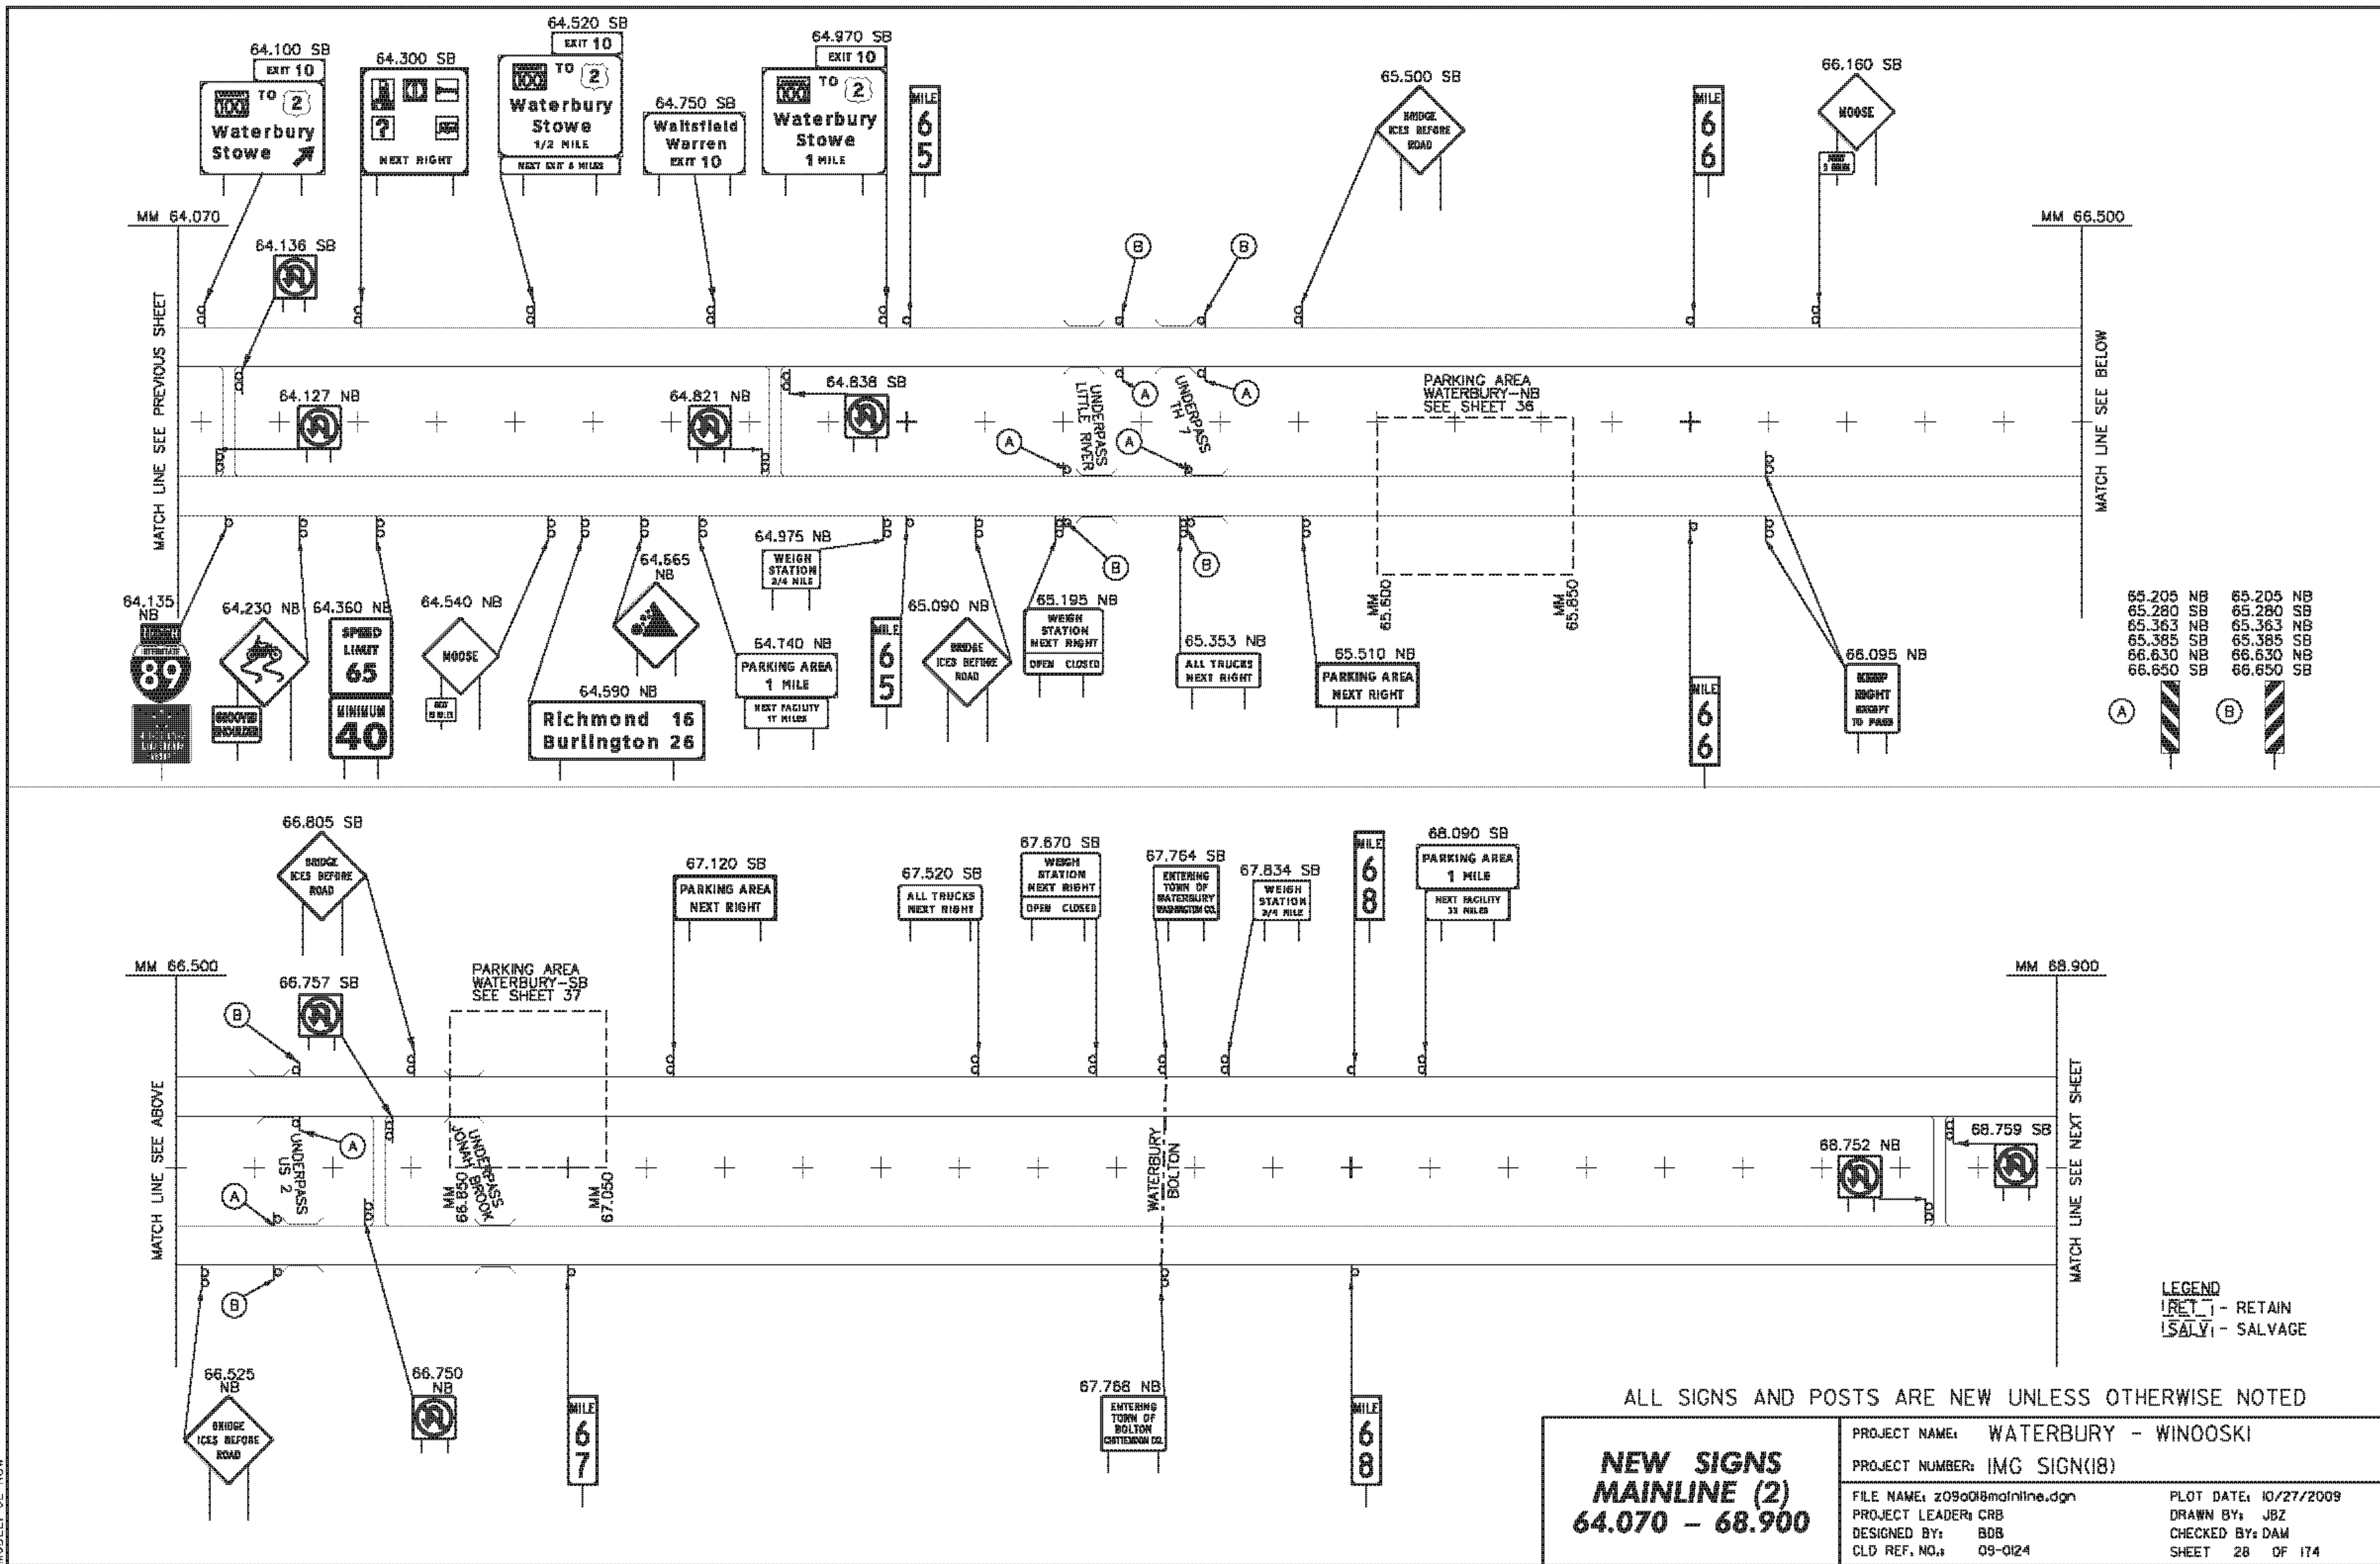

**NEW SIGNS  
MAINLINE (2)  
64.070 – 68.900**