
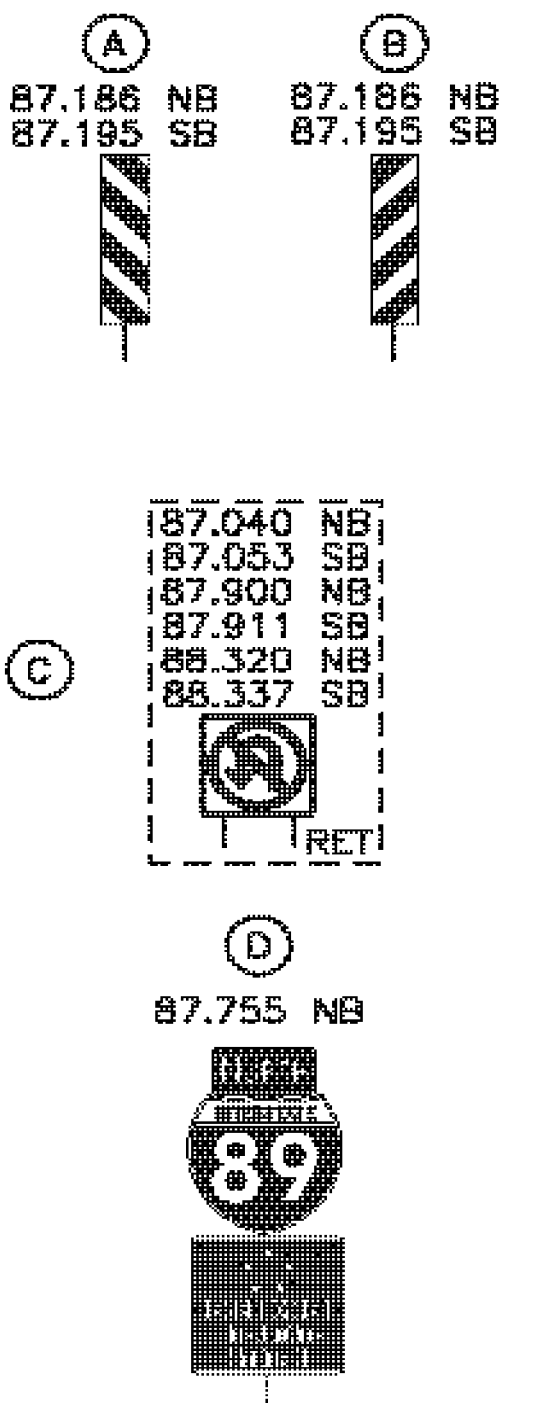


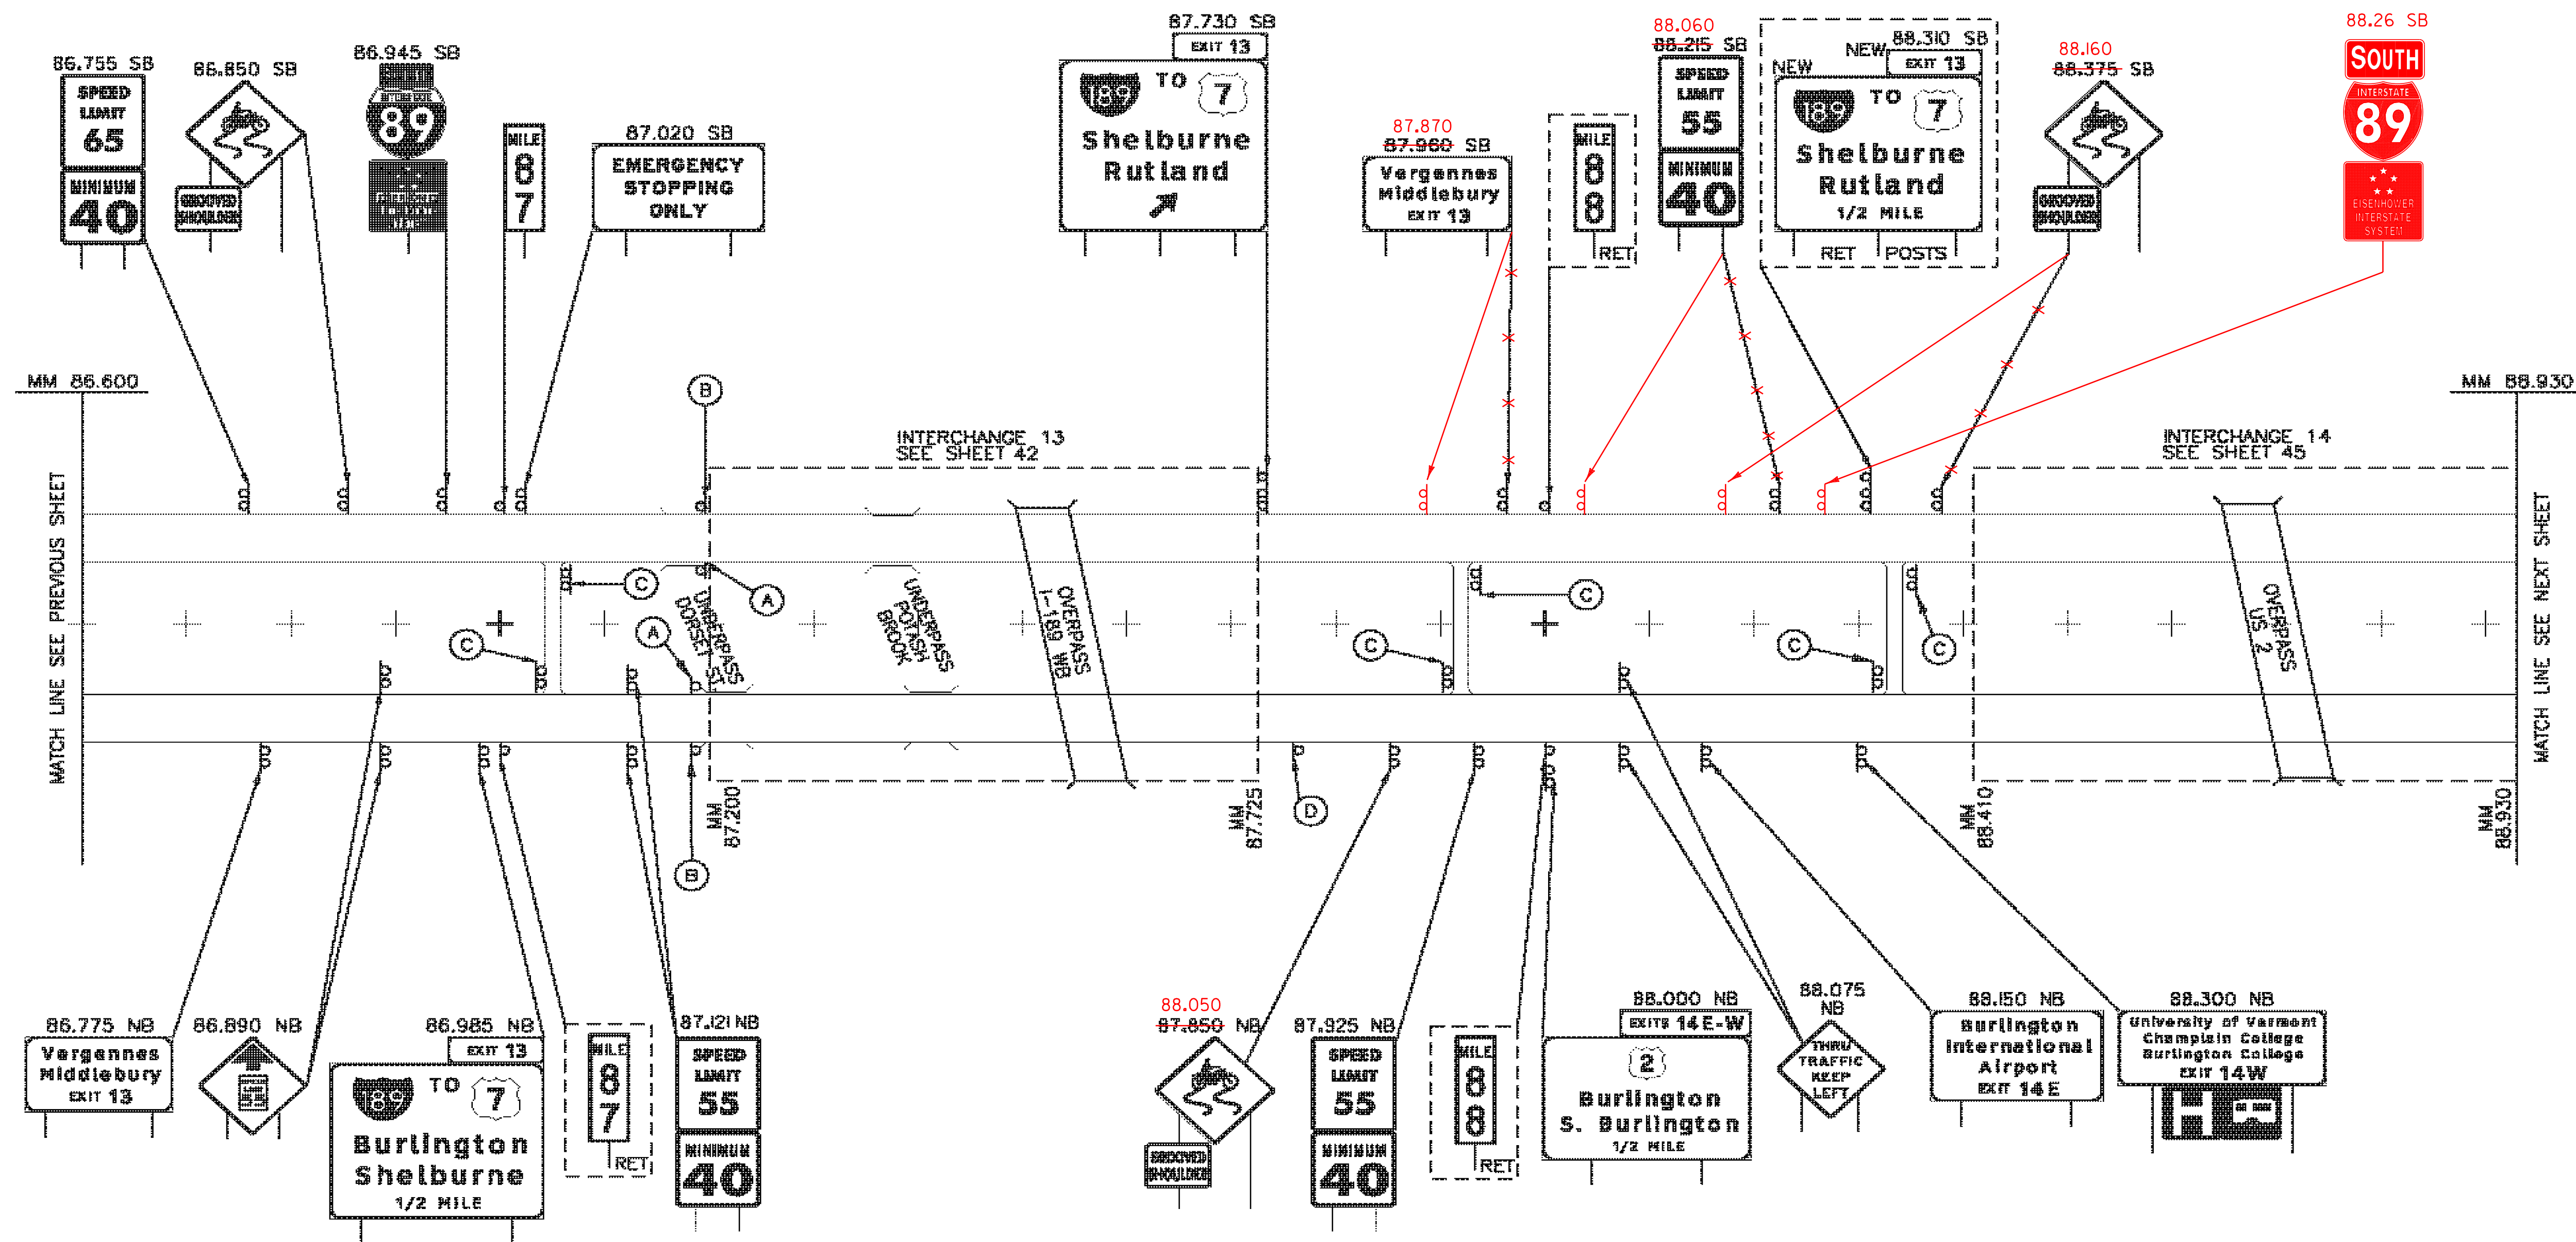

ALL SIGNS AND POSTS ARE NEW UNLESS OTHERWISE NOTED

**NEW SIGNS
MAINLINE (7)
86.600 - 88.930**

PROJECT NAME: WATERBURY - WINOOSKI
PROJECT NUMBER: IMG SIGN(18)

FILE NAME: z09o08mainline.dgn
PROJECT LEADER: CRB
DESIGNED BY: BDB
CLD REF. NO.: 09-0124

PLOT DATE: 10/27/2009
DRAWN BY: JBZ
CHECKED BY: DAM
SHEET 33 OF 174