


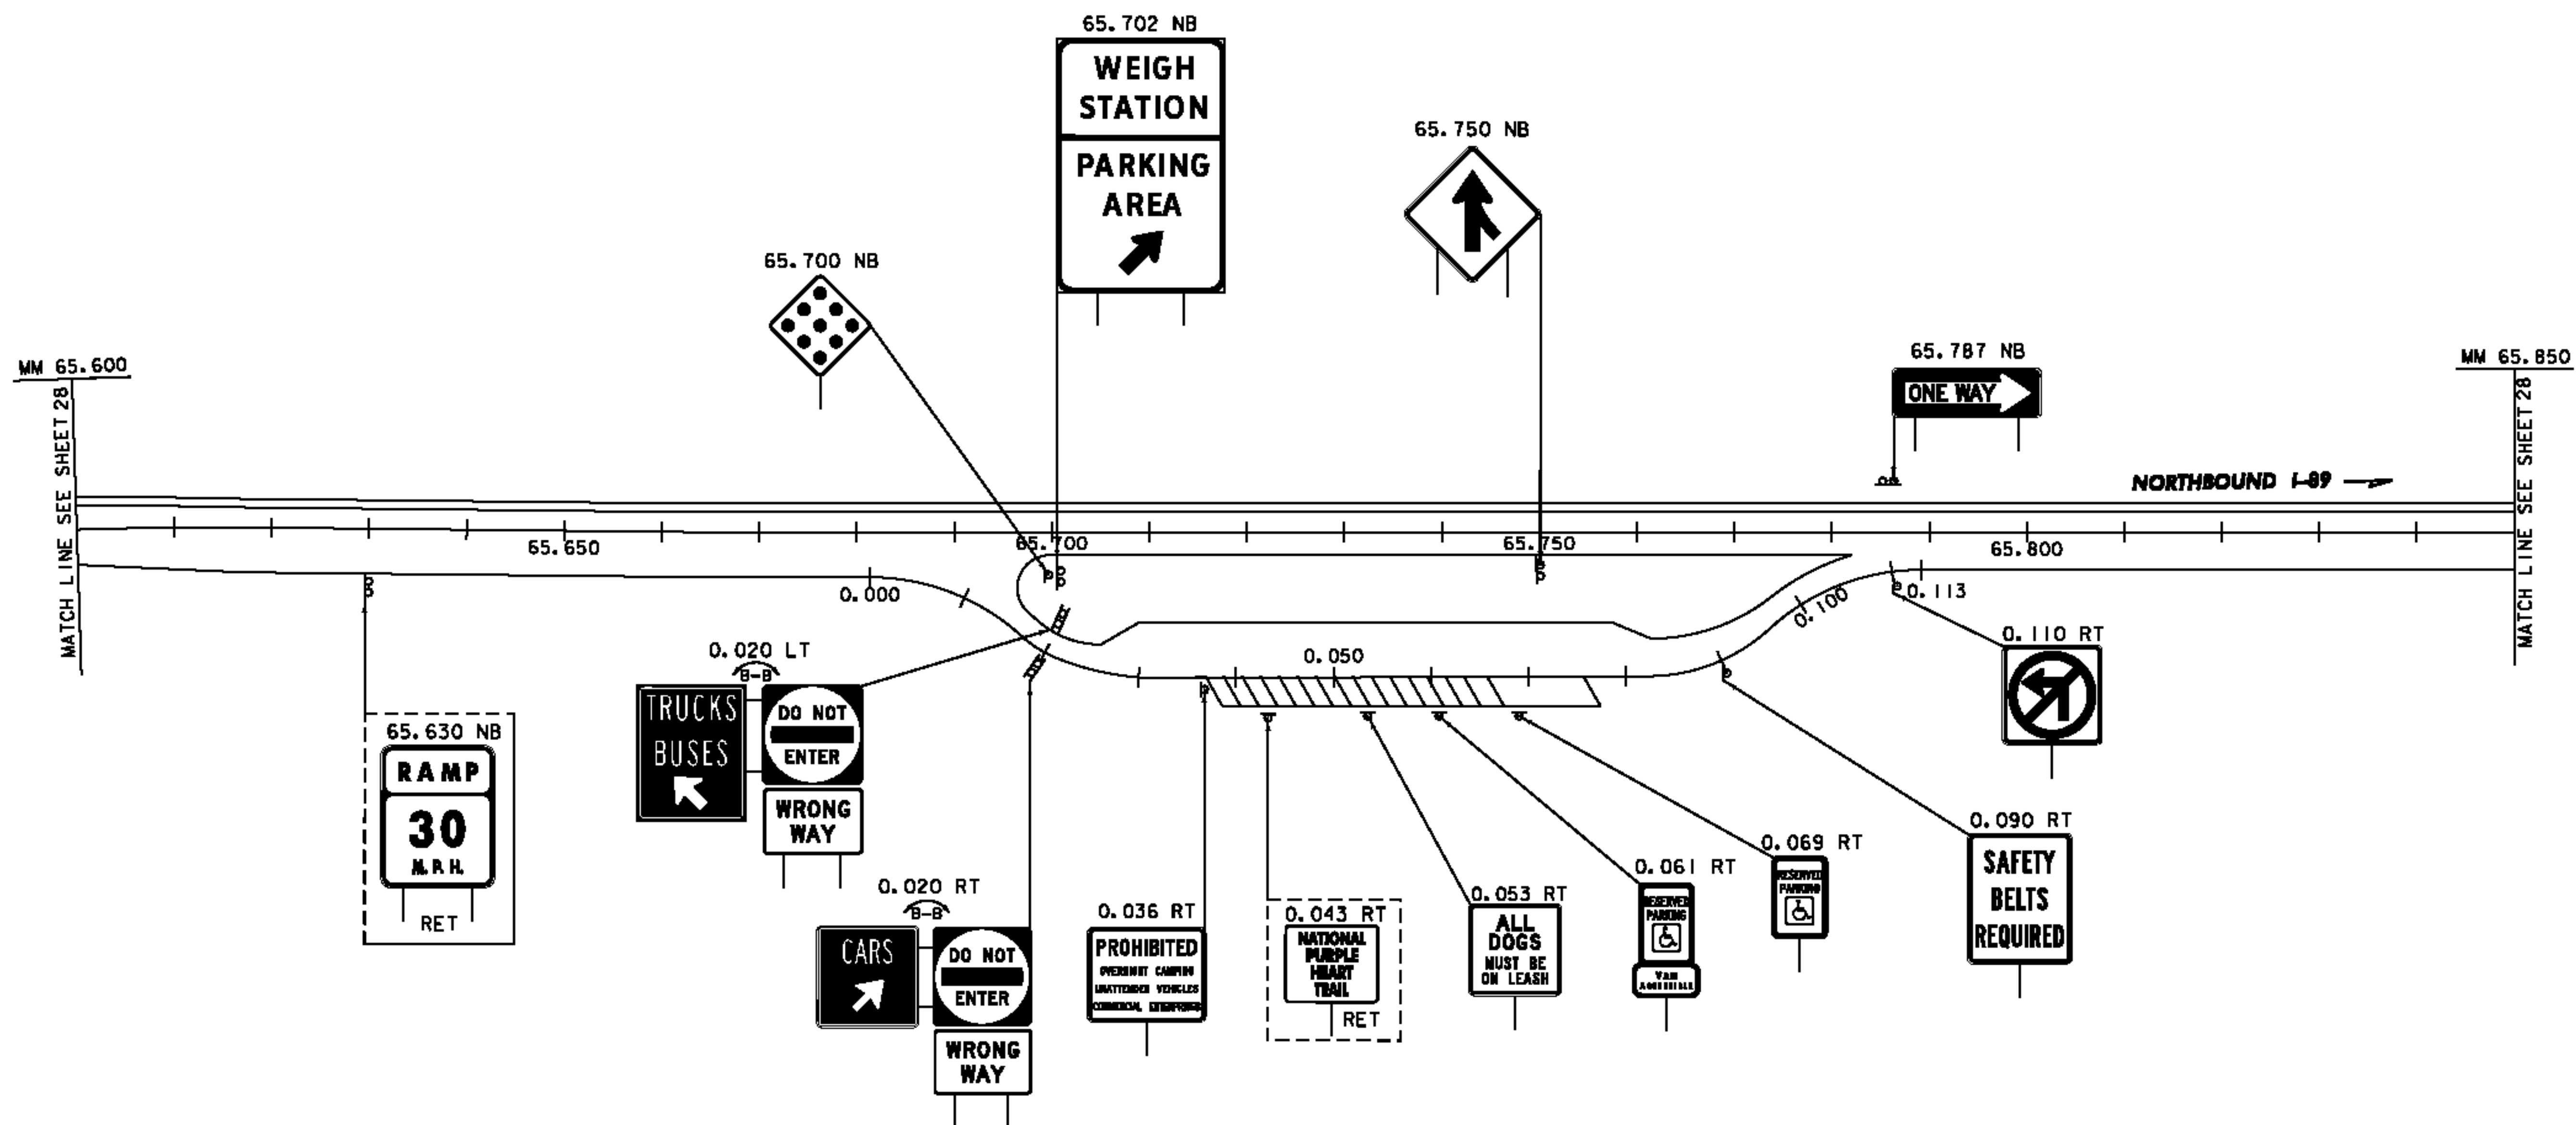

LEGEND
[RET] - RETAIN
[SALV] - SALVAGE

ALL SIGNS AND POSTS ARE NEW UNLESS OTHERWISE NOTED

**PARKING AREA
WATERBURY NB
NEW SIGNS
MM 65.735**

PROJECT NAME: WATERBURY - WINOOSKI

PROJECT NUMBER: IMG SIGN(18)

FILE NAME: z09a018rest-NB(65).dgn

PROJECT LEADER: CRB

DESIGNED BY: BDB

CLD REF. NO.: 09-0124

PLOT DATE: 10/27/2009

DRAWN BY: JBZ

CHECKED BY: DAM

SHEET 36 OF 174