


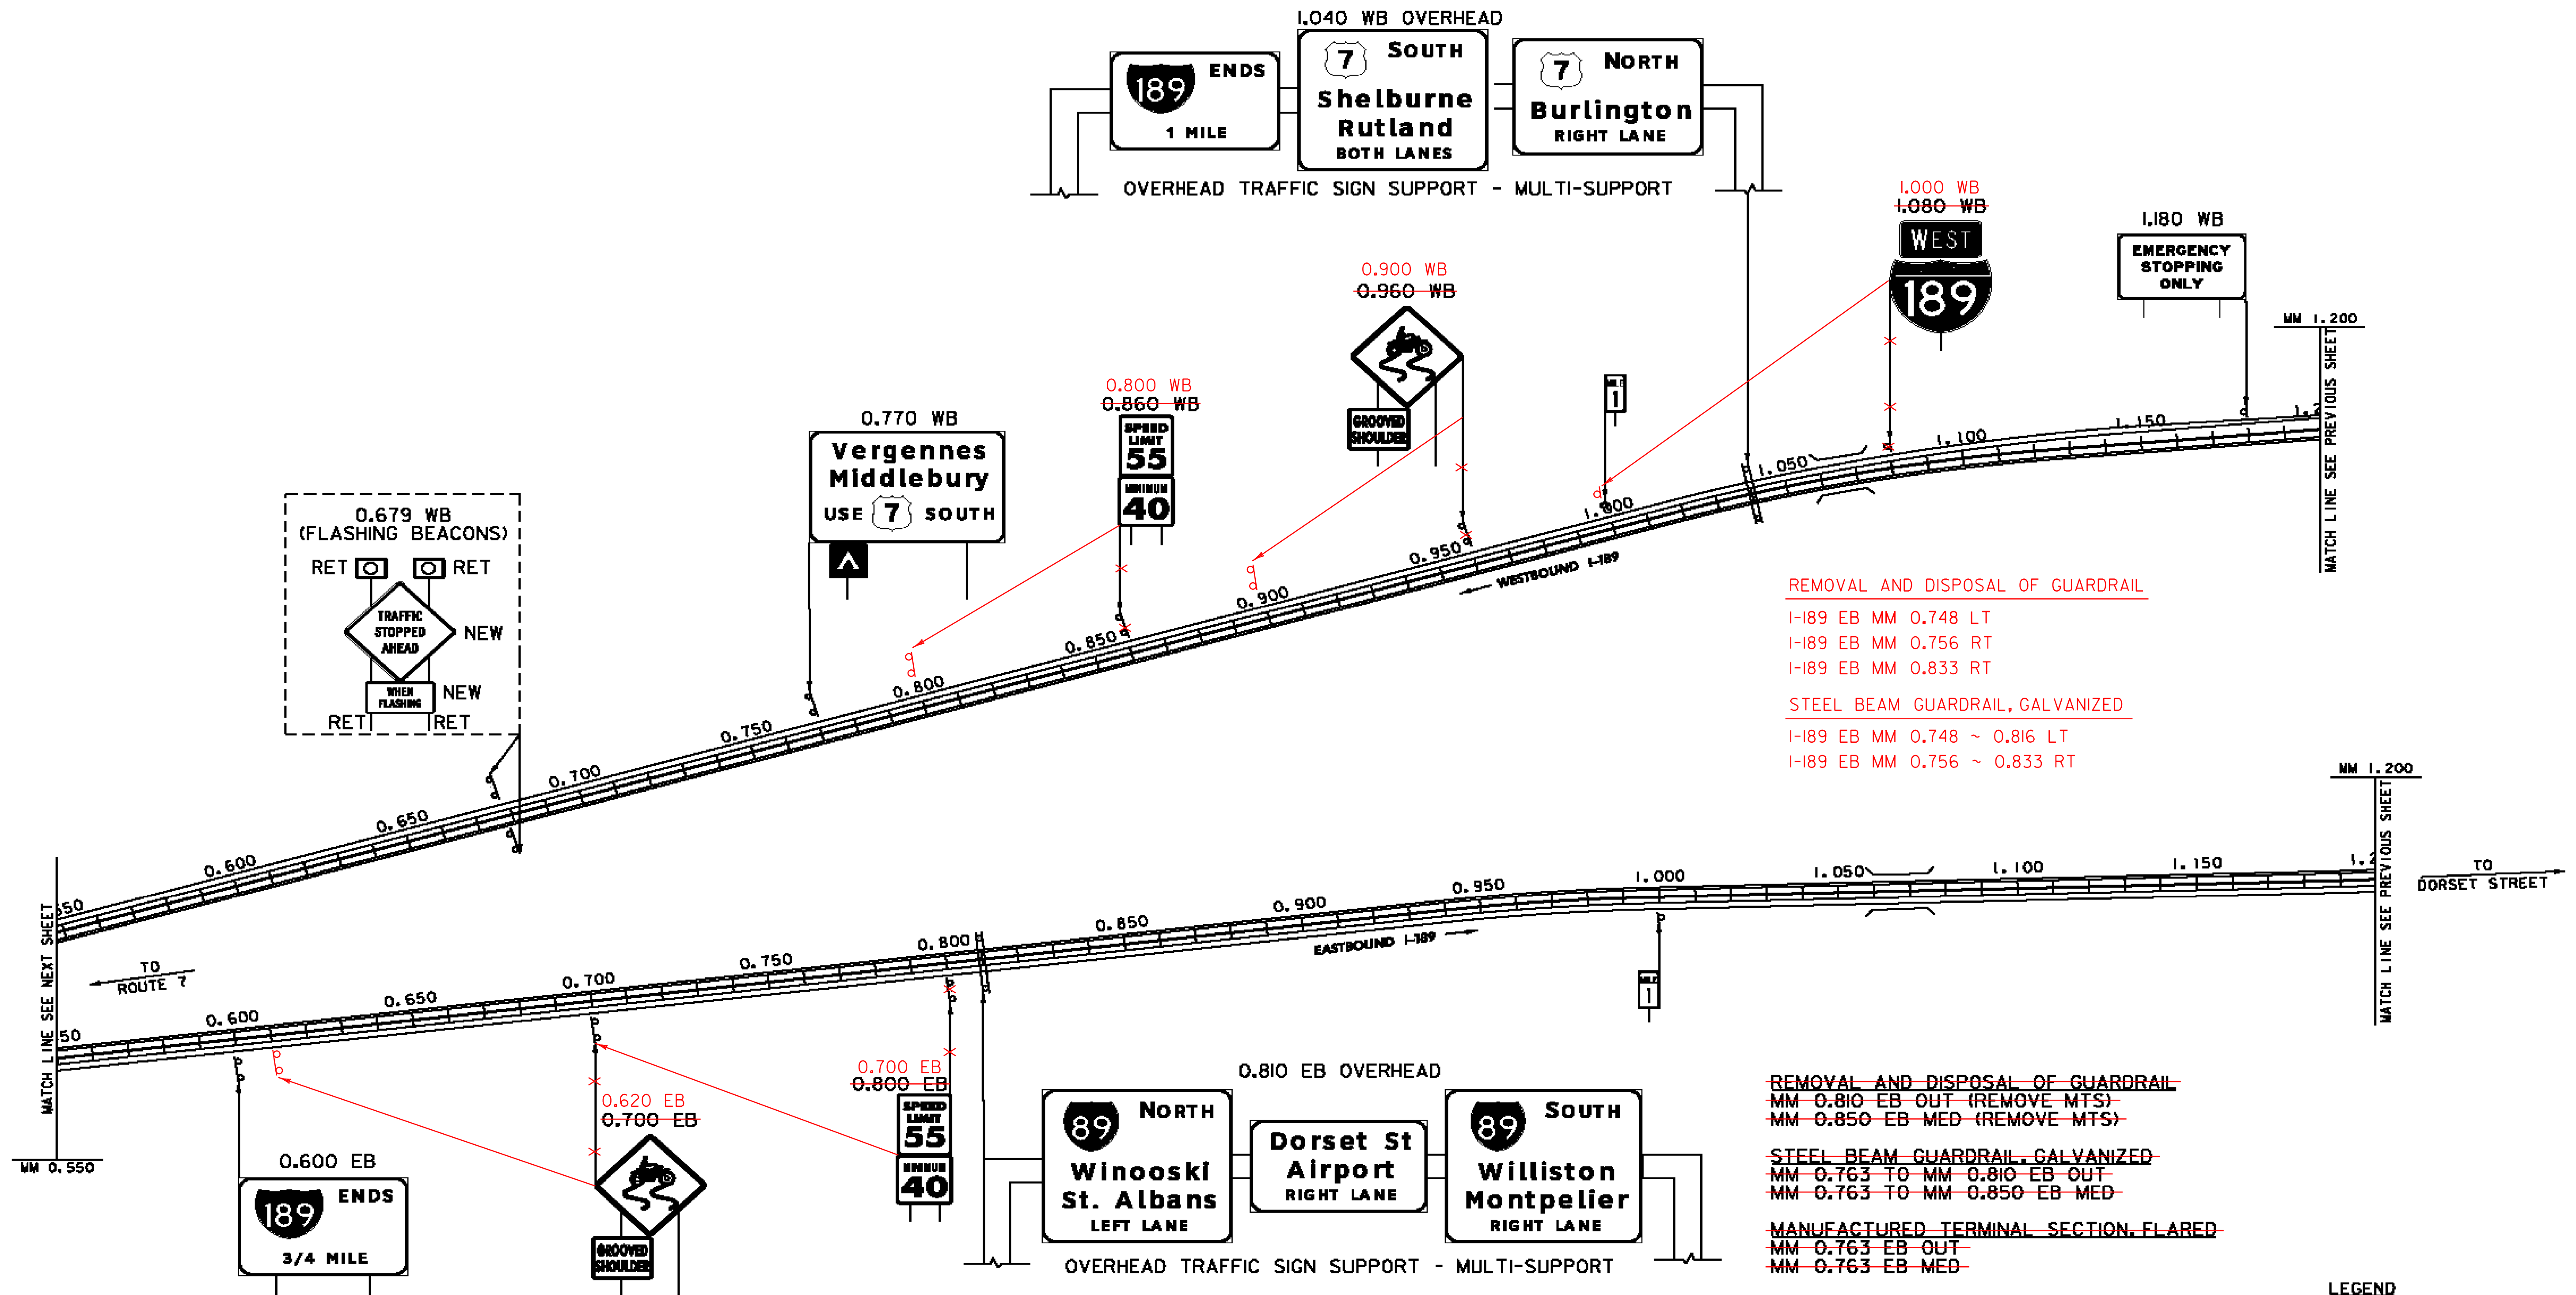

REMOVAL AND DISPOSAL OF GUARDRAIL
I-189 EB MM 0.748 LT
I-189 EB MM 0.756 RT
I-189 EB MM 0.833 RT

STEEL BEAM GUARDRAIL, GALVANIZED
I-189 EB MM 0.748 ~ 0.816 LT
I-189 EB MM 0.756 ~ 0.833 RT

REMOVAL AND DISPOSAL OF GUARDRAIL
~~MM 0.810 EB OUT (REMOVE MTS)~~
~~MM 0.850 EB MED (REMOVE MTS)~~

STEEL BEAM GUARDRAIL, GALVANIZED
~~MM 0.763 TO MM 0.810 EB OUT~~
~~MM 0.763 TO MM 0.850 EB MED~~

MANUFACTURED TERMINAL SECTION, FLARED
~~MM 0.763 EB OUT~~
~~MM 0.763 EB MED~~

LEGEND
RET - RETAIN
SALV - SALVAGE

ALL SIGNS AND POSTS ARE NEW UNLESS OTHERWISE NOTED

INTERSTATE 189 NEW SIGNS	PROJECT NAME: WATERBURY - WINOOSKI	
	PROJECT NUMBER: IMG SIGN(18)	
	FILE NAME: z09a018n13.dgn	PLOT DATE: 10/27/2009
	PROJECT LEADER: CRB	DRAWN BY: JBZ
	DESIGNED BY: BDB	CHECKED BY: DAM
	CLD REF. NO.: 09-0124	SHEET 43 OF 174