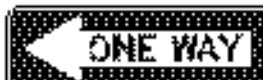
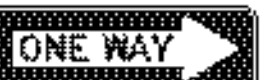
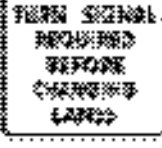
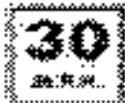


TRAFFIC SIGN SUMMARY SHEET 35

MILE MARKER, STATION OR SIGN NUMBER	SIGN LEGEND	SIGN DIMENSIONS			NEW & SALVAGED SIGNS				EXISTING POST RETAI NAGE	NO. OF POST S	NEW SIGN POSTS																						REMARKS	SIGN DETAIL	
											FLANGED CHANNEL				SQUARE STEEL (in)				ANCHOR HOLE	SLEEVE	TUBULAR ALUMINUM DIA (in)			TUBULAR STEEL DIA (in)				W-SHAPE STEEL		FRAME SIGN		DETAIL ON SHEET NUMBER	STD. SHEET NUMBER		
		E	A	WIDTH (in)	HEIGHT (in)	"A"	"B"	SALV SIGN	SALV TIS			lb/ft			lb/ft						3.0 4.0 4.0 Mod			FIND- ATION	3.0 3.5 4.0 5.0				FTG. SIZE						
									1.12		2.0	3.0	1.88	2.42	3.35	1.3	1.7	1.7		lb/ft				24"	30"	WEIGHT	POST SIZE								
0.280 RAMP A LT	 	1	36	36	9.00																											R1-1 BACK TO BACK			
	 	1	36	12	3.00					2					X		2															R6-1L BACK TO BACK			
0.284 RAMP A RT	 	1	36	36	9.00																											R1-1 BACK TO BACK			
	 	1	36	12	3.00					2					X		2															R6-1L BACK TO BACK			
INT #10 0.030 RAMP C RT		1	36	36	9.00																											VR-046		E-142	
		1	36	36	9.00					2													2	X								VR-002		E-142	
0.050 RAMP C LT		1	36	36	9.00																											W1-11			
		1	24	24	4.00					2					X		2															W13-1			
0.070 - 0.130 LT RAMP C		5	18	24	15.00					5					X		5															W1-8 FLUORESCENT-YELLOW TYPE IX SHEETING			
0.155 RAMP C RT		1	30	30	6.25					1					X		1															R3-2			
INT #10 0.030 RAMP D RT		1	36	36	9.00																											VR-046		E-142	
		1	36	36	9.00					2										X												VR-002		E-142	
0.040 - 0.120 LT RAMP D		5	18	24	15.00					5					X		5															W1-8 YELLOW COLORED TYPE IX SHEETING			
0.050 RAMP D LT		1	36	36	9.00																											W1-11			
		1	24	24	4.00					2					X		2															W13-1			
											FT	FT	FT	FT	FT	FT	EA	LB	LB	LB		LB	LB	LB	LB										
															268.7		EA	45.4				191.6													