



INTERSTATE 189
MM 1.288 EB OVERHEAD

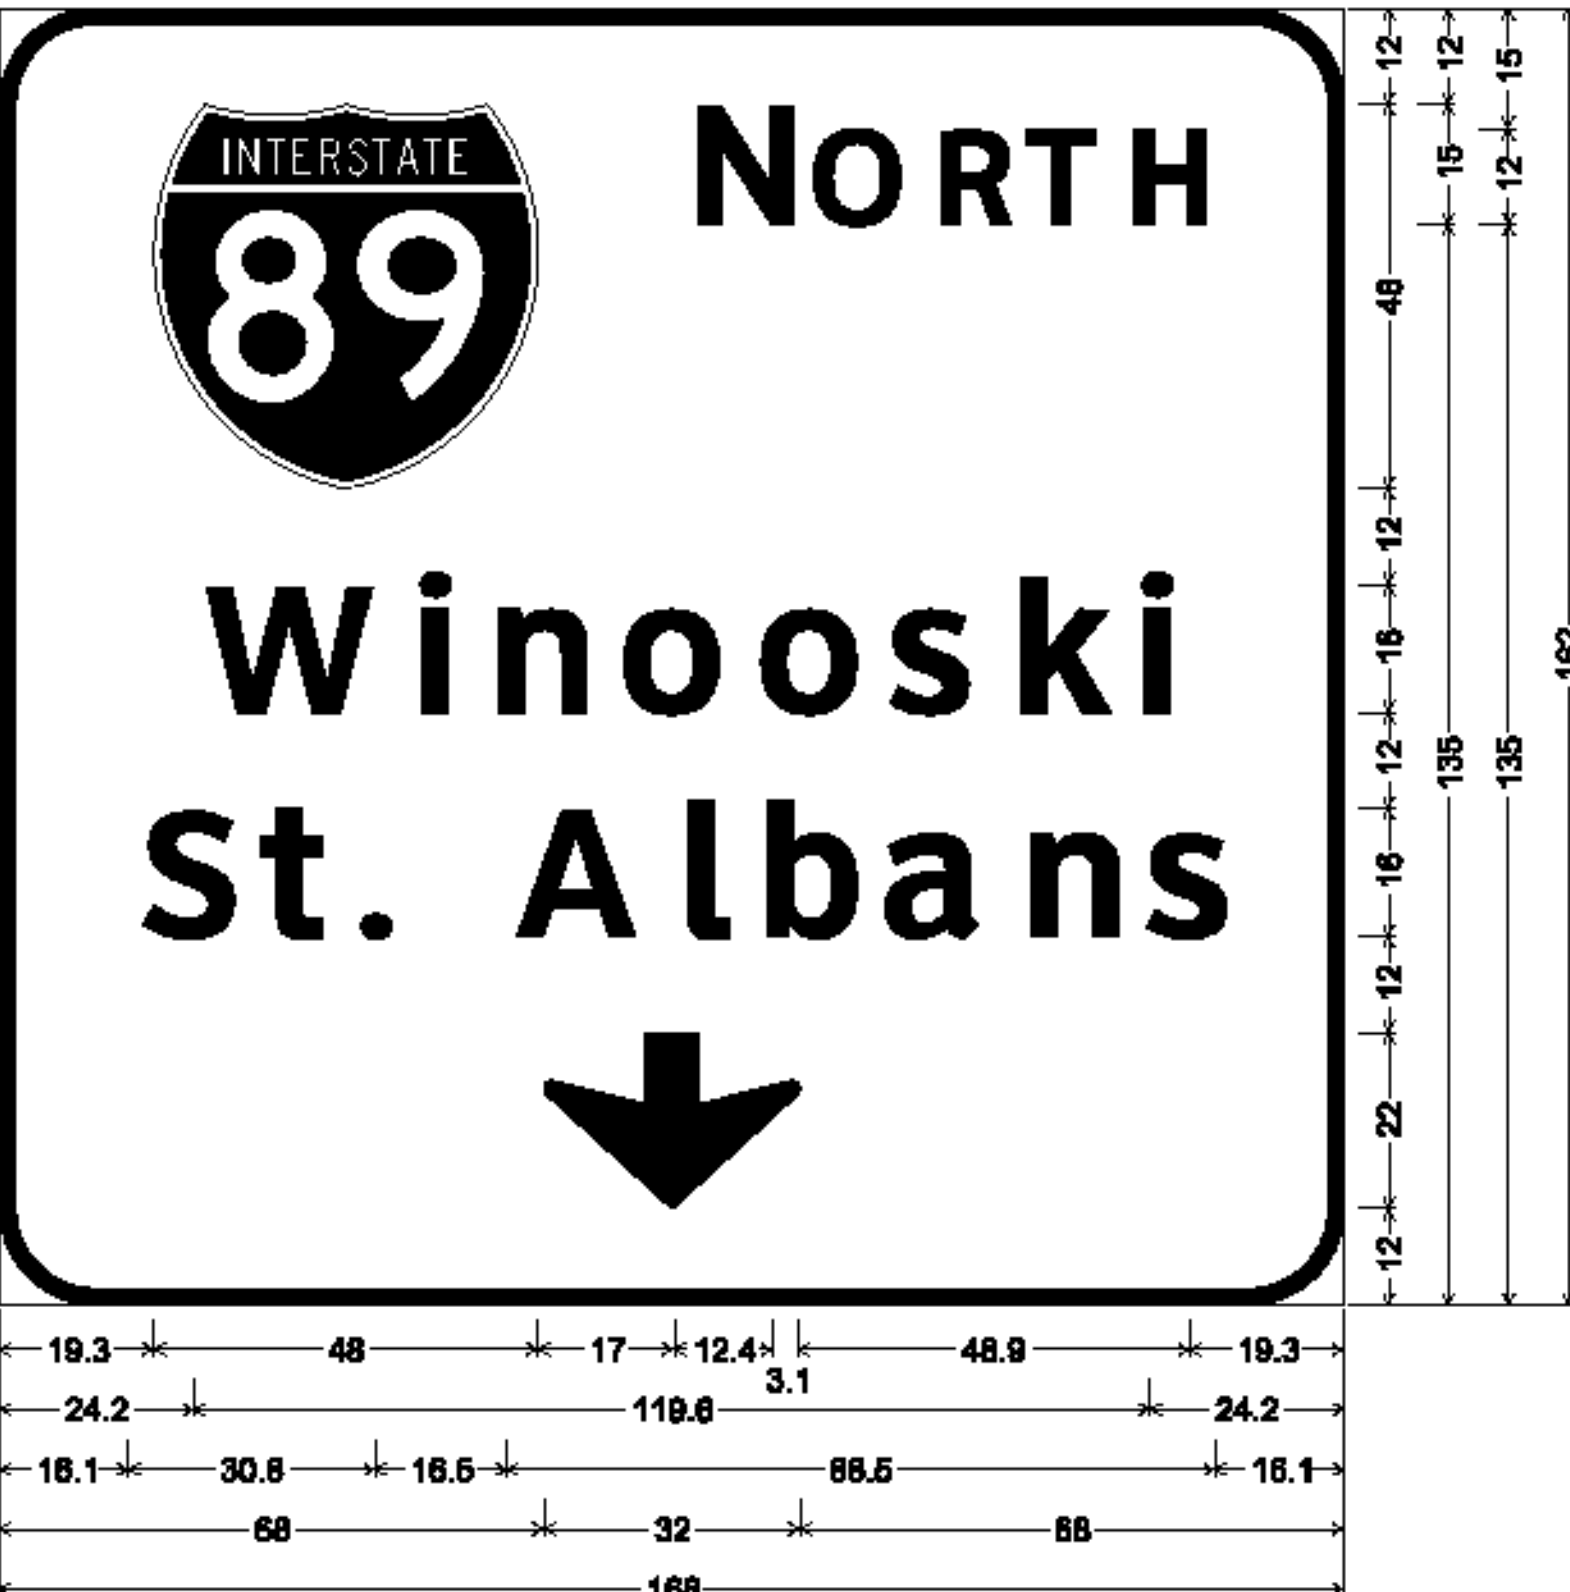

12.0" Radius, 2.0" Border, White on Green;
[N ORTH] ClearviewHwy-5-W; [Winooski] ClearviewHwy-5-W;
[St. Albans] ClearviewHwy-5-W; Down Arrow 22.0" 270°;
OVERHEAD SIGNS TO USE WHITE ASTM TYPE IX RETROREFLECTIVE LEGEND AND BORDER ON GREEN ASTM TYPE IX RETROREFLECTIVE BACKGROUND SHOP DRAWINGS REQUIRED FOR ALL OVERHEAD AND BRIDGE MOUNTED SIGN COMPONENTS. REFER TO SHEET 160, NOTE #10.

INTERSTATE 189
MM 1.438 EB BRIDGE MOUNTED

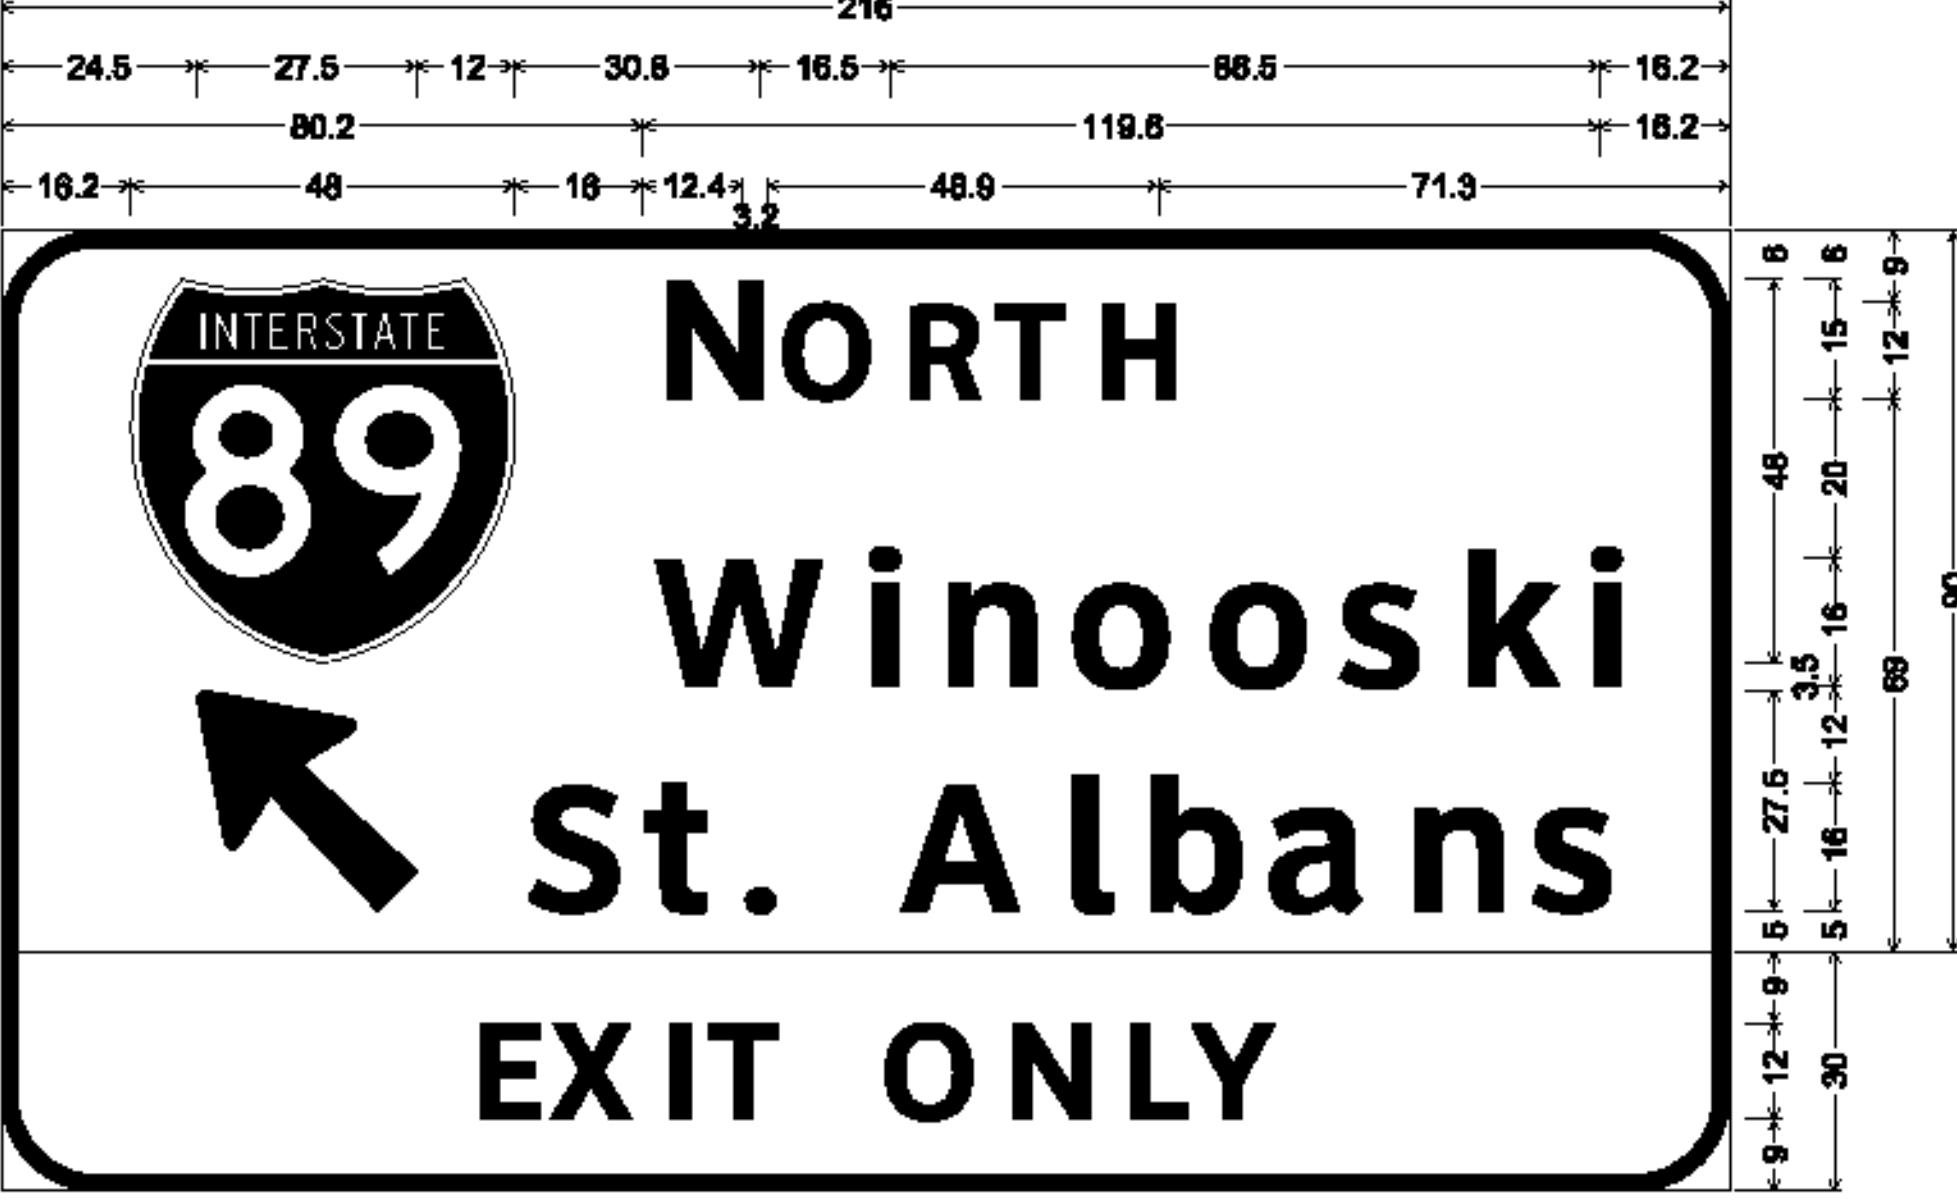

12.0" Radius, 2.0" Border, White on Green;
[N ORTH] ClearviewHwy-5-W; [Winooski] ClearviewHwy-5-W; Arrow 180 - 35.0° 135°;
[St. Albans] ClearviewHwy-5-W;
12.0" Radius, 2.0" Border, White on Yellow;
[EXIT ONLY] Black ClearviewHwy-5-W;
OVERHEAD SIGNS TO USE WHITE ASTM TYPE IX RETROREFLECTIVE LEGEND AND BORDER ON GREEN ASTM TYPE IX RETROREFLECTIVE BACKGROUND SHOP DRAWINGS REQUIRED FOR ALL OVERHEAD AND BRIDGE MOUNTED SIGN COMPONENTS. REFER TO SHEET 160, NOTE #10.

INTERSTATE 189
MM 1.288 EB OVERHEAD




12.0" Radius, 2.0" Border, White on Green;
[Dorset St] ClearviewHwy-5-W; [Airport] ClearviewHwy-5-W;
12.0" Radius, 2.0" Border, White on Yellow;
[EXIT] Black ClearviewHwy-5-W; Down Arrow 22.0" 270° Black;
[ONLY] Black ClearviewHwy-5-W;
OVERHEAD SIGNS TO USE WHITE ASTM TYPE IX RETROREFLECTIVE LEGEND AND BORDER ON GREEN ASTM TYPE IX RETROREFLECTIVE BACKGROUND SHOP DRAWINGS REQUIRED FOR ALL OVERHEAD AND BRIDGE MOUNTED SIGN COMPONENTS. REFER TO SHEET 160, NOTE #10.

INTERSTATE 189
MM 1.438 EB BRIDGE MOUNTED



12.0" Radius, 2.0" Border, White on Green;
[Dorset St] ClearviewHwy-5-W; [Airport] ClearviewHwy-5-W;
12.0" Radius, 2.0" Border, White on Yellow;
[EXIT] Black ClearviewHwy-5-W; Down Arrow 22.0" 270° Black;
[ONLY] Black ClearviewHwy-5-W;
OVERHEAD SIGNS TO USE WHITE ASTM TYPE IX RETROREFLECTIVE LEGEND AND BORDER ON GREEN ASTM TYPE IX RETROREFLECTIVE BACKGROUND SHOP DRAWINGS REQUIRED FOR ALL OVERHEAD AND BRIDGE MOUNTED SIGN COMPONENTS. REFER TO SHEET 160, NOTE #10.

INTERSTATE 189
MM 1.288 EB OVERHEAD

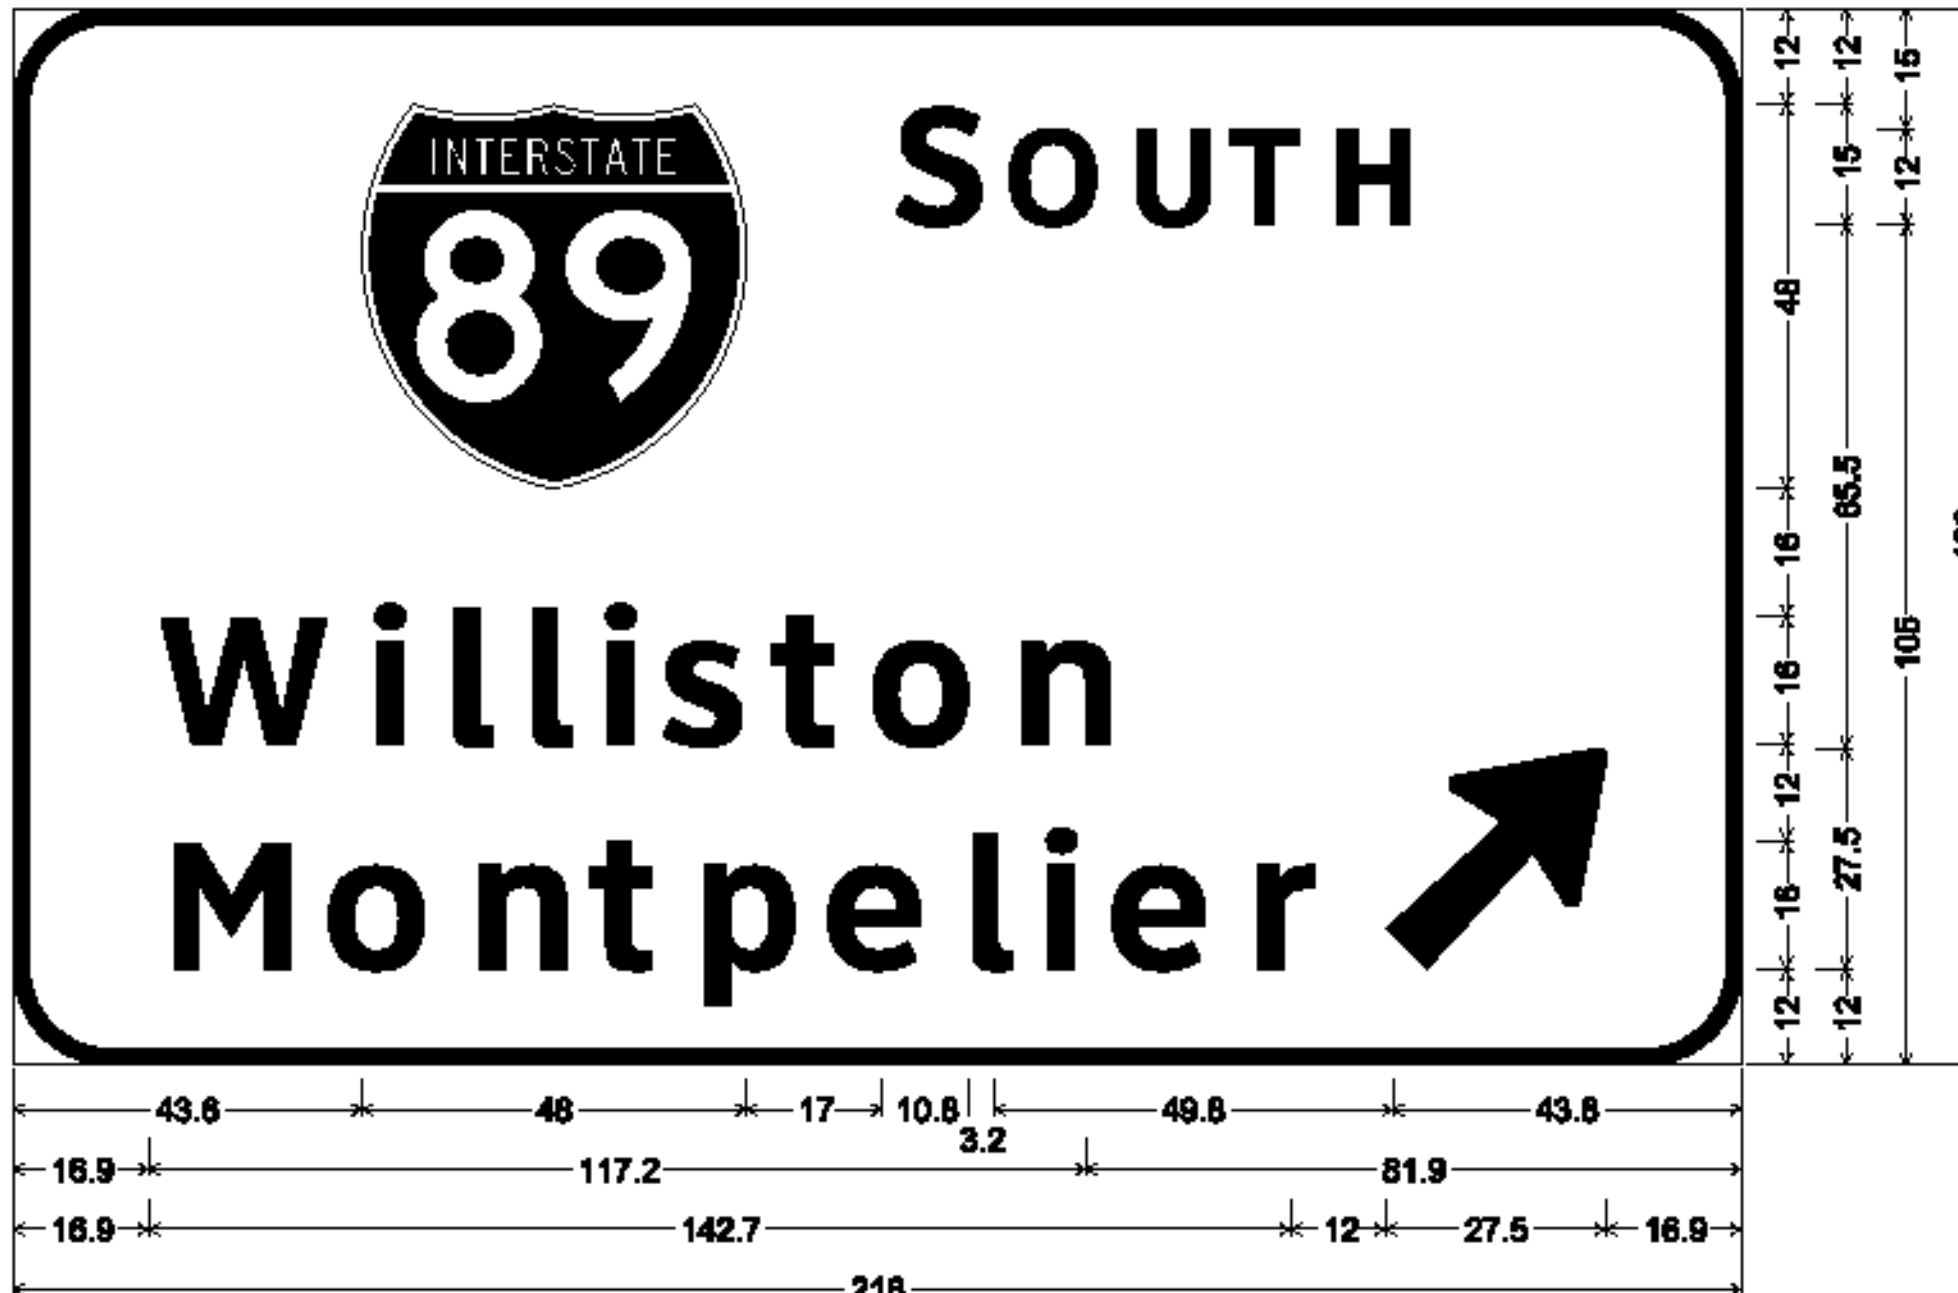

12.0" Radius, 2.0" Border, White on Green;
[S OUTH] ClearviewHwy-5-W; [Williston] ClearviewHwy-5-W; [Montpelier] ClearviewHwy-5-W;
Arrow 160 - 35.0° 45°;
OVERHEAD SIGNS TO USE WHITE ASTM TYPE IX RETROREFLECTIVE LEGEND AND BORDER ON GREEN ASTM TYPE IX RETROREFLECTIVE BACKGROUND SHOP DRAWINGS REQUIRED FOR ALL OVERHEAD AND BRIDGE MOUNTED SIGN COMPONENTS. REFER TO SHEET 160, NOTE #10.

SIGN DETAIL
SHEET 14

PROJECT NAME:	WATERBURY - WINOOSKI
PROJECT NUMBER:	IMG SIGN(18)
FILE NAME:	z09a018signdet.dgn
PLOT DATE:	10/27/2009
PROJECT LEADER:	CRB
DRAWN BY:	JBZ
DESIGNED BY:	JBZ
CHECKED BY:	BDB
CLD REF. NO.:	09-0124
SHEET	149 OF 174