


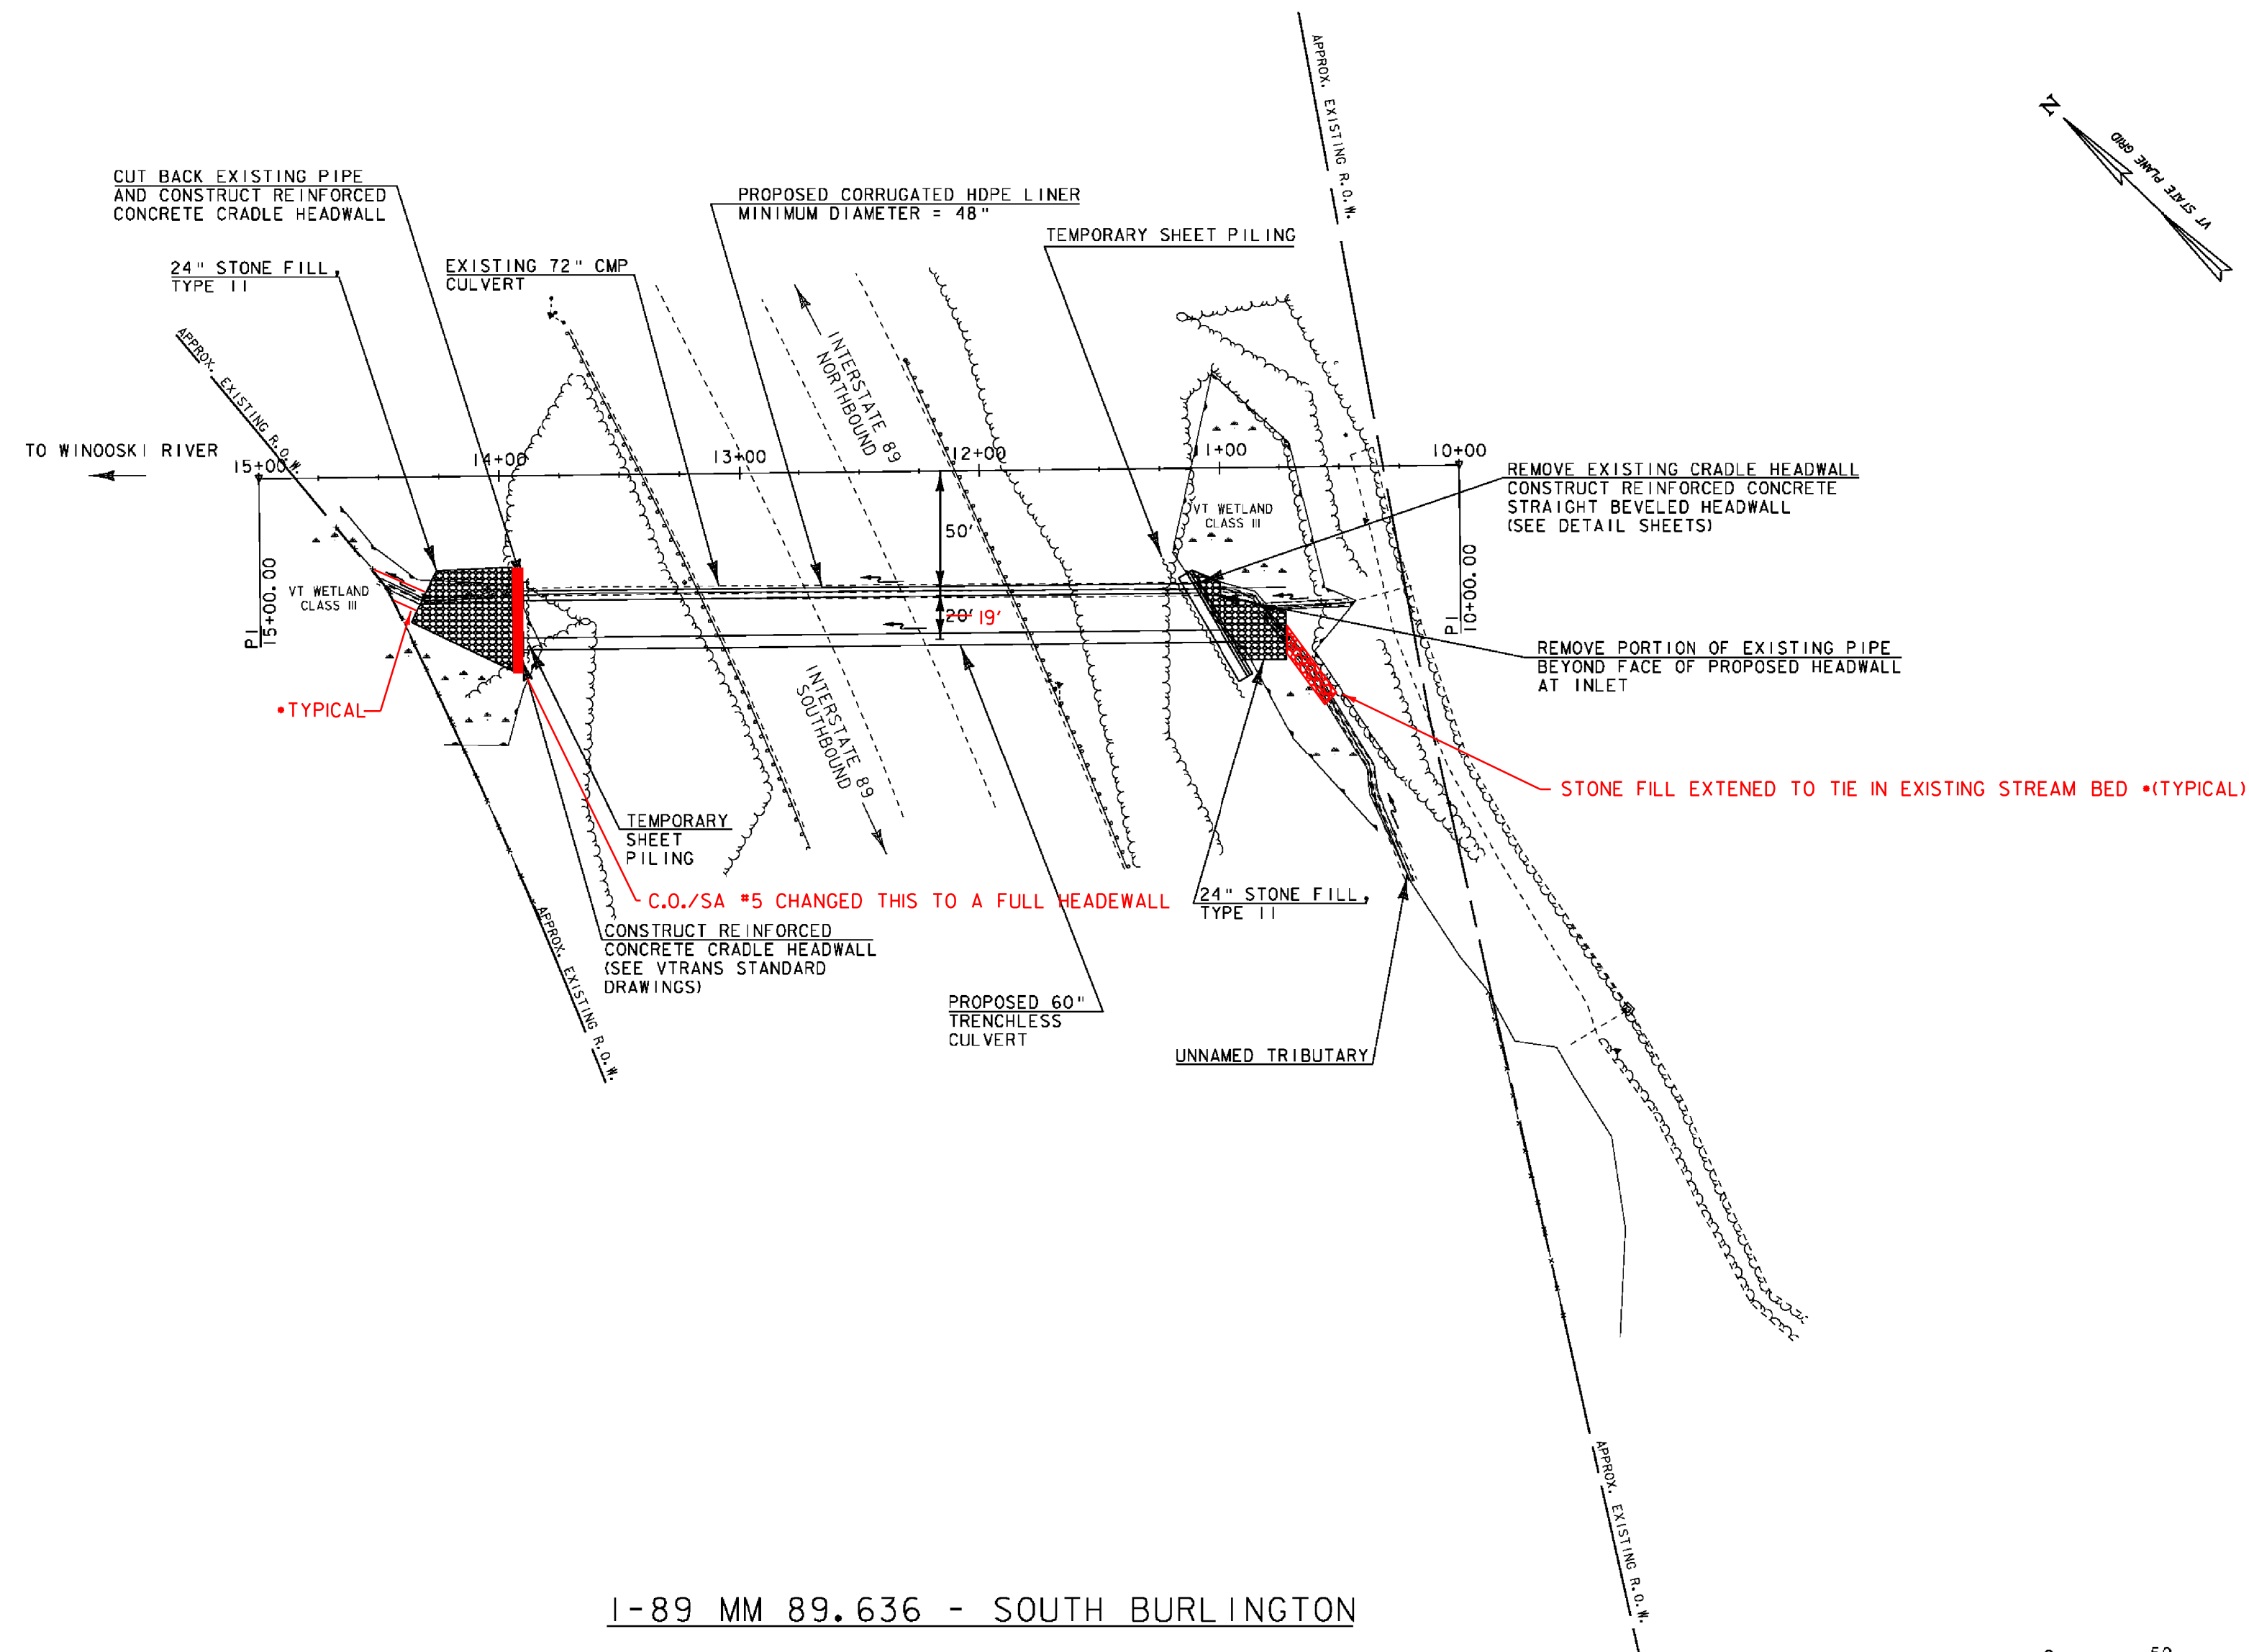

I-89 MM 89.636 - SOUTH BURLINGTON

GENERAL NOTE:

1. THE CONTRACTOR WILL BE RESPONSIBLE FOR PROVIDING TEMPORARY ACCESS TO THE CULVERT ENDS. ALL RESULTING DISTURBED EARTH SHALL BE STABILIZED AND RESTORED UPON COMPLETION OF CONSTRUCTION. PAYMENT SHALL BE MADE UNDER CONTRACT ITEM 900.645 - SPECIAL PROVISION (TEMPORARY ACCESS ROAD AND STAGING AREAS, CULVERT). ANY REMOVAL OF TREES AND STUMPS NECESSARY FOR CONSTRUCTION OF THE TEMPORARY ACCESS ROAD SHALL BE PAID UNDER ITEM 201.10 - CLEARING AND GRUBBING, INCLUDING INDIVIDUAL TREES AND STUMPS.



PROJECT NAME: SO. BURLINGTON - COLCHESTER	
PROJECT NUMBER: IM CULV (23)	
FILE NAME: z09a046i002.dgn	PLOT DATE: 08-FEB-2011
PROJECT LEADER: D. BENOIT	DRAWN BY: M. LOVETT
DESIGNED BY: B. COLBURN	CHECKED BY: D. BENOIT
LAYOUT SHEET - SOUTH BURLINGTON 69-1	SHEET 7 OF 36