




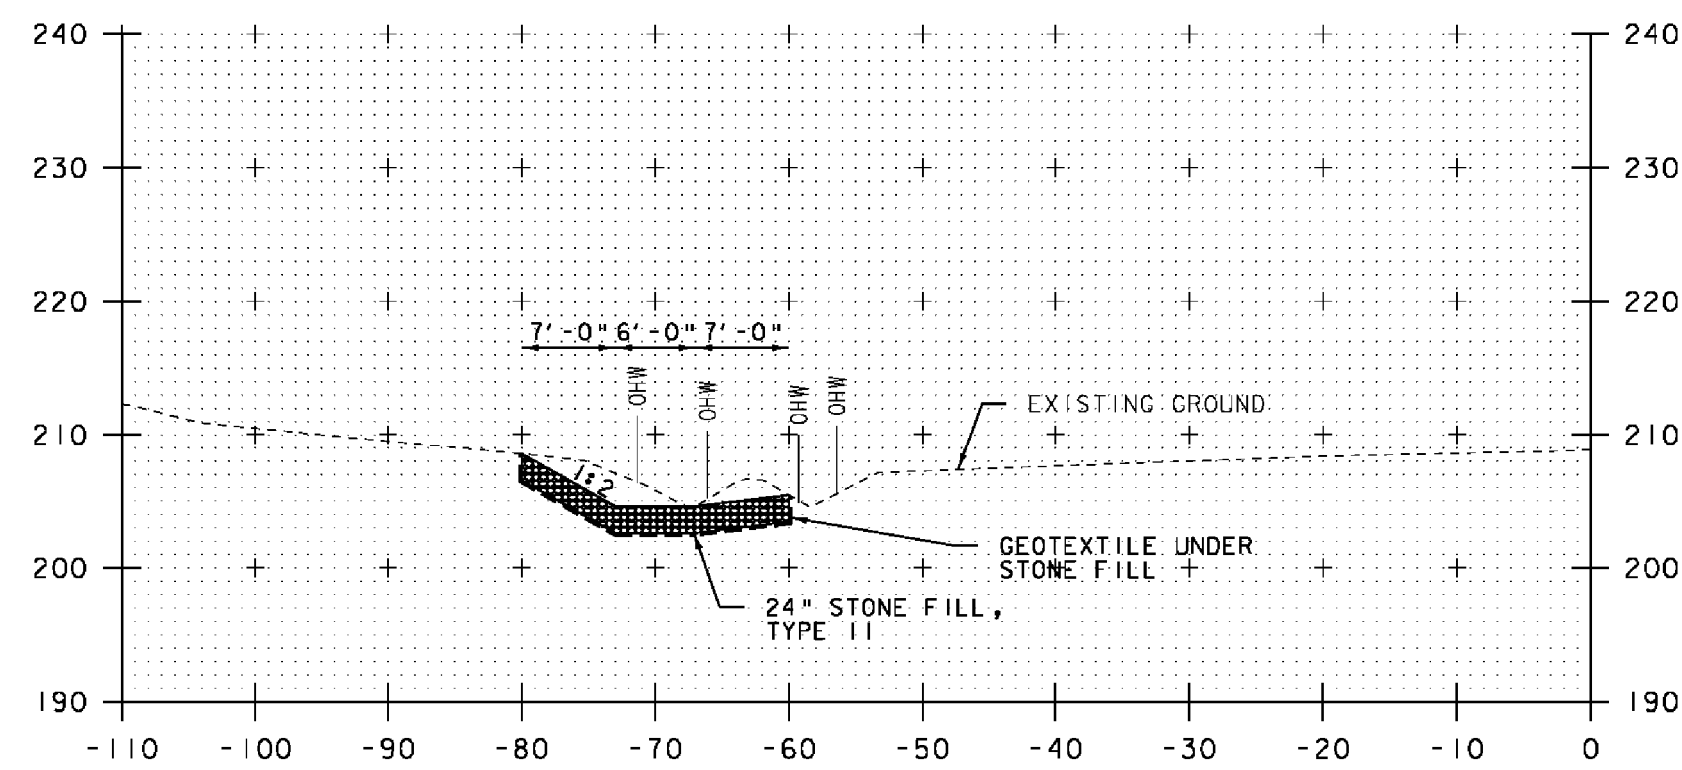


10+75

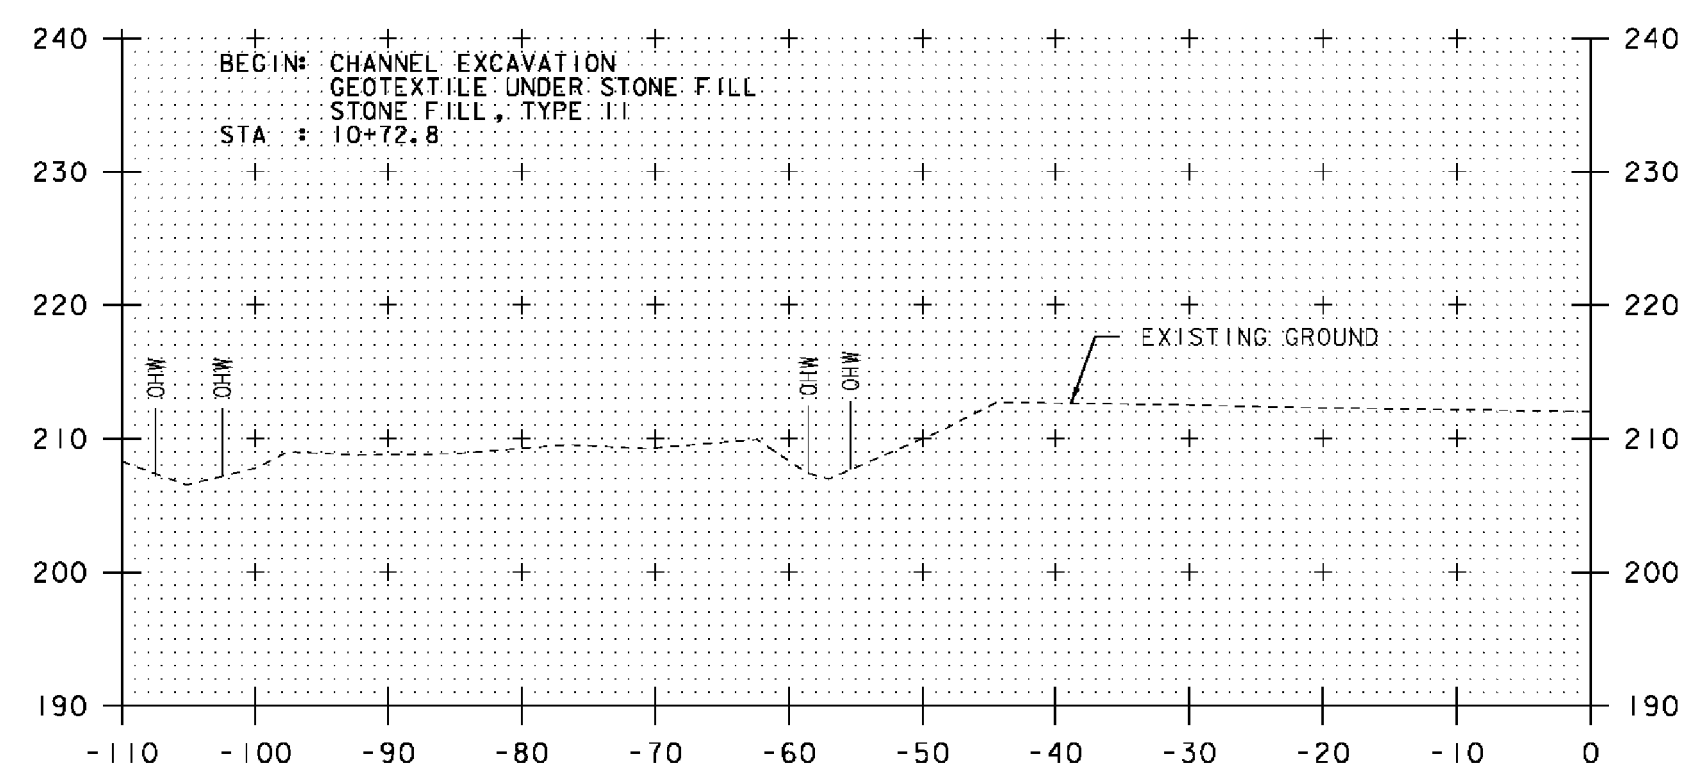


10+50

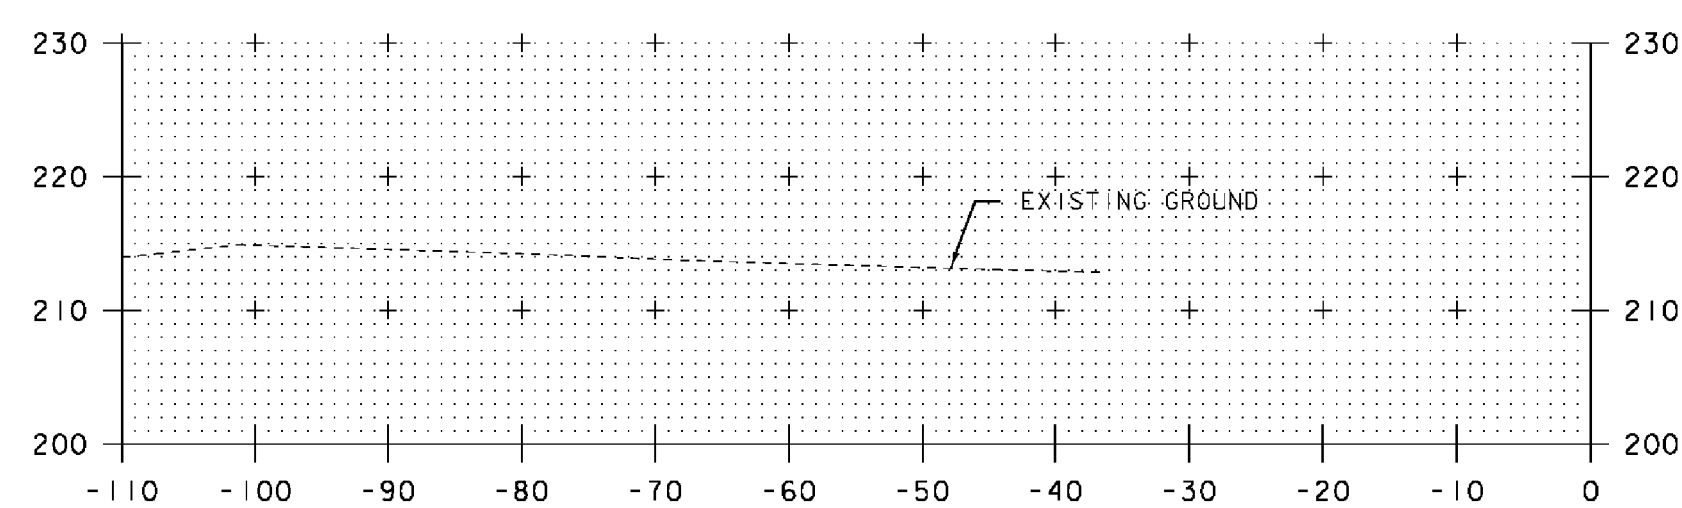

10+25

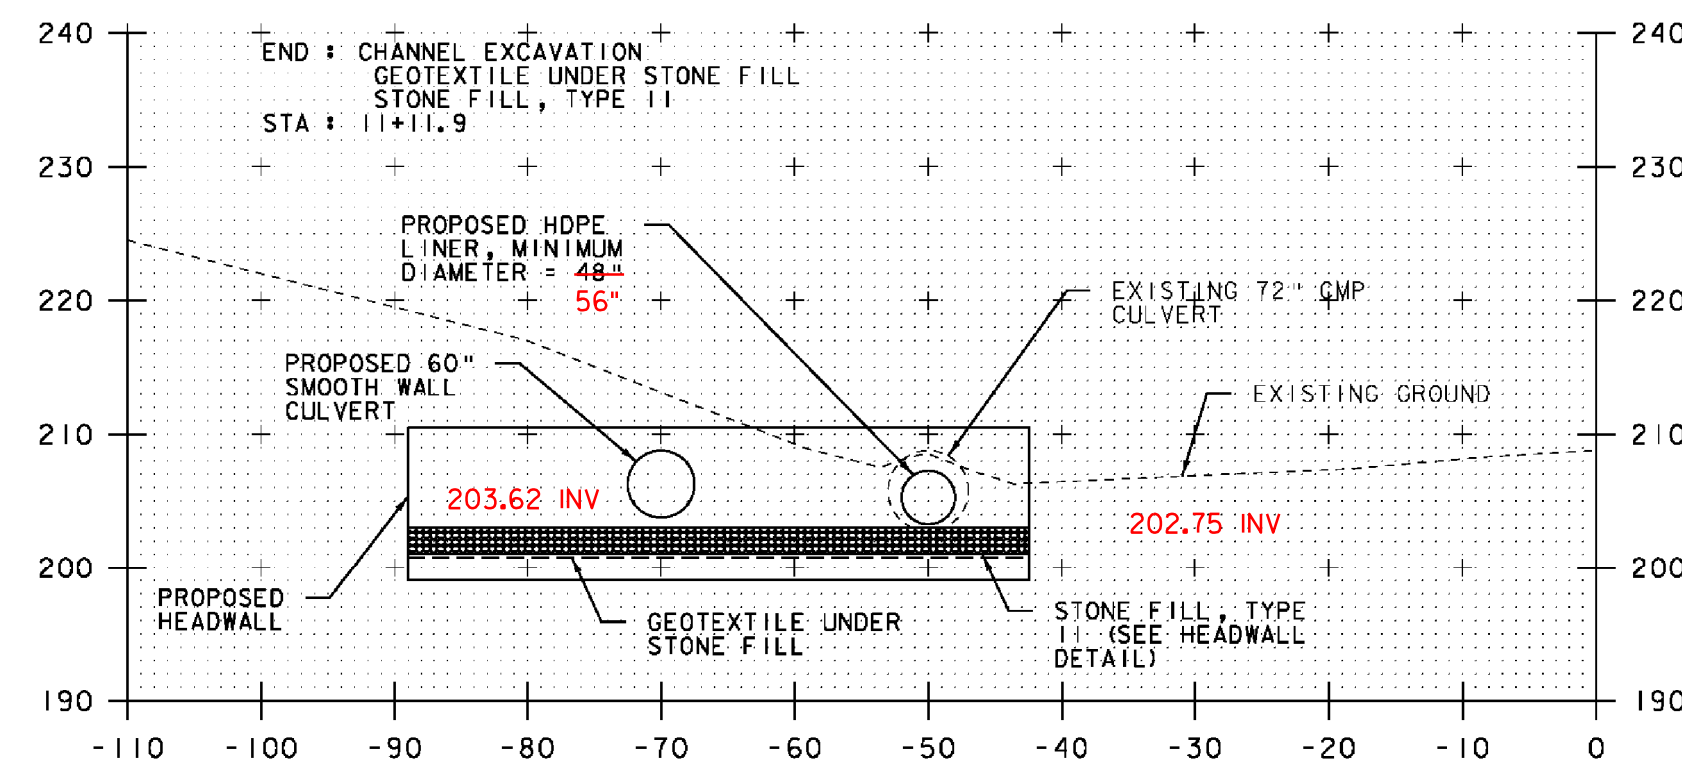

11+09

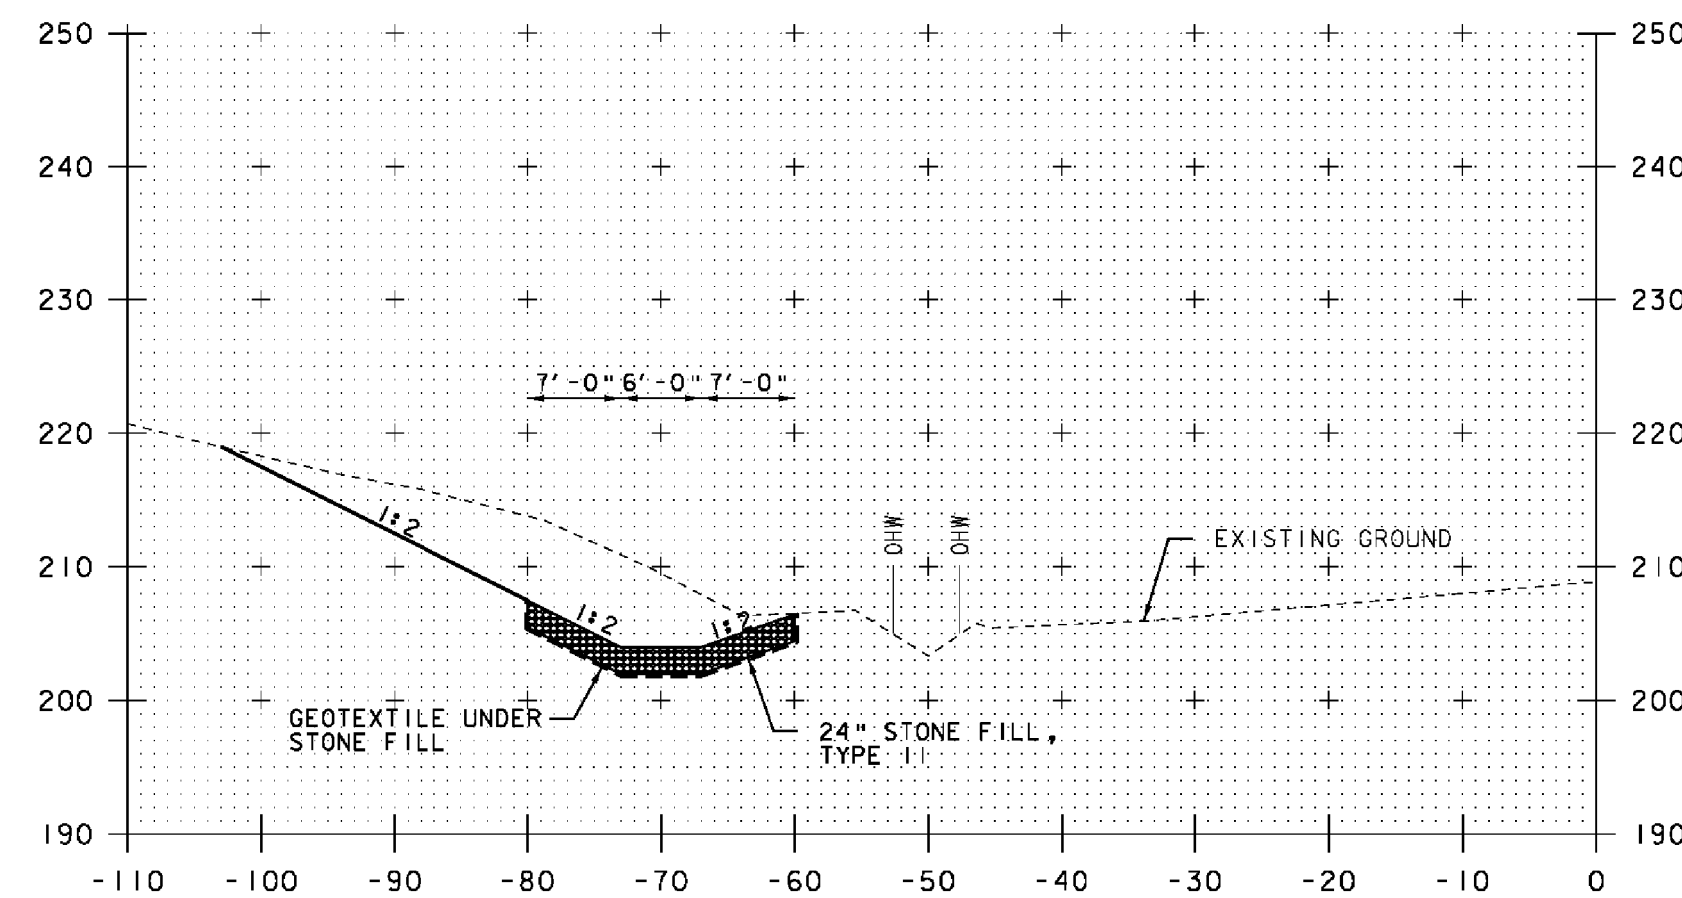

11+00

STA. 10+25 TO STA. 11+09