
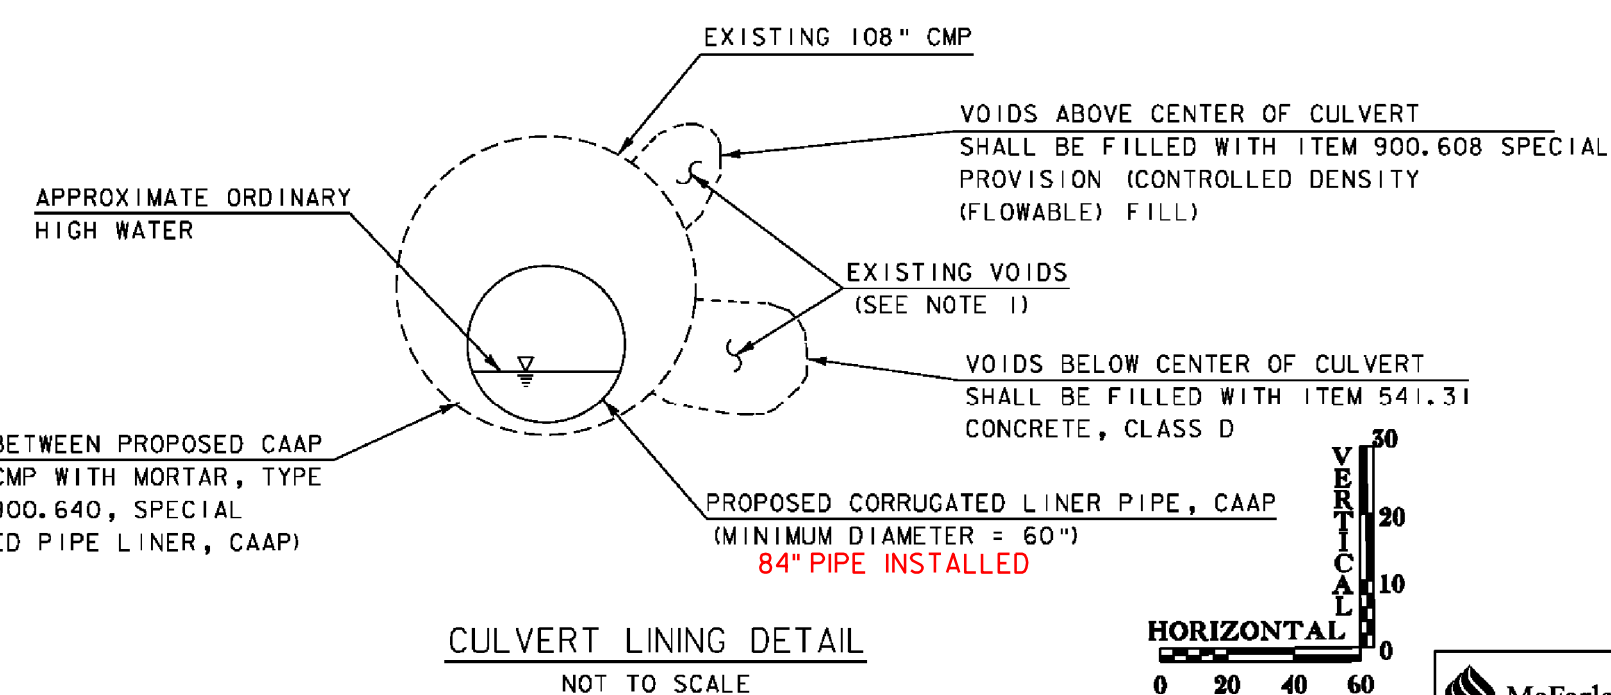
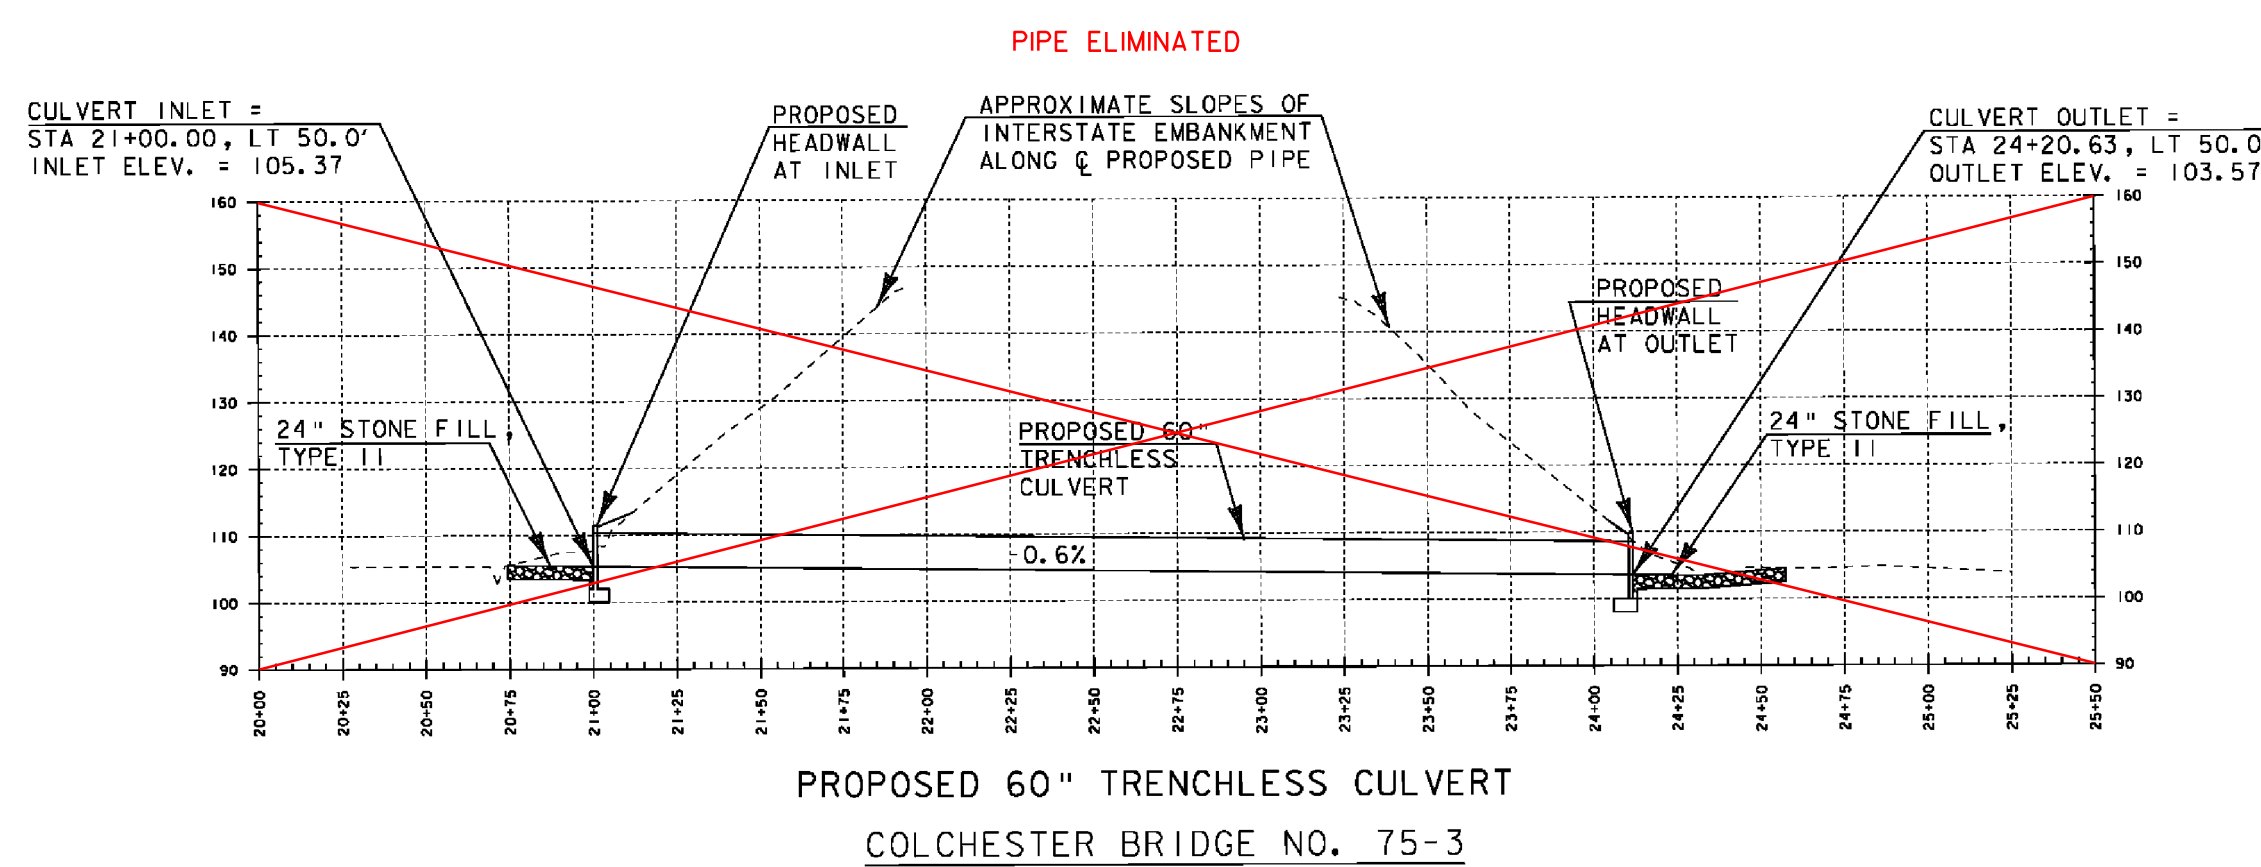


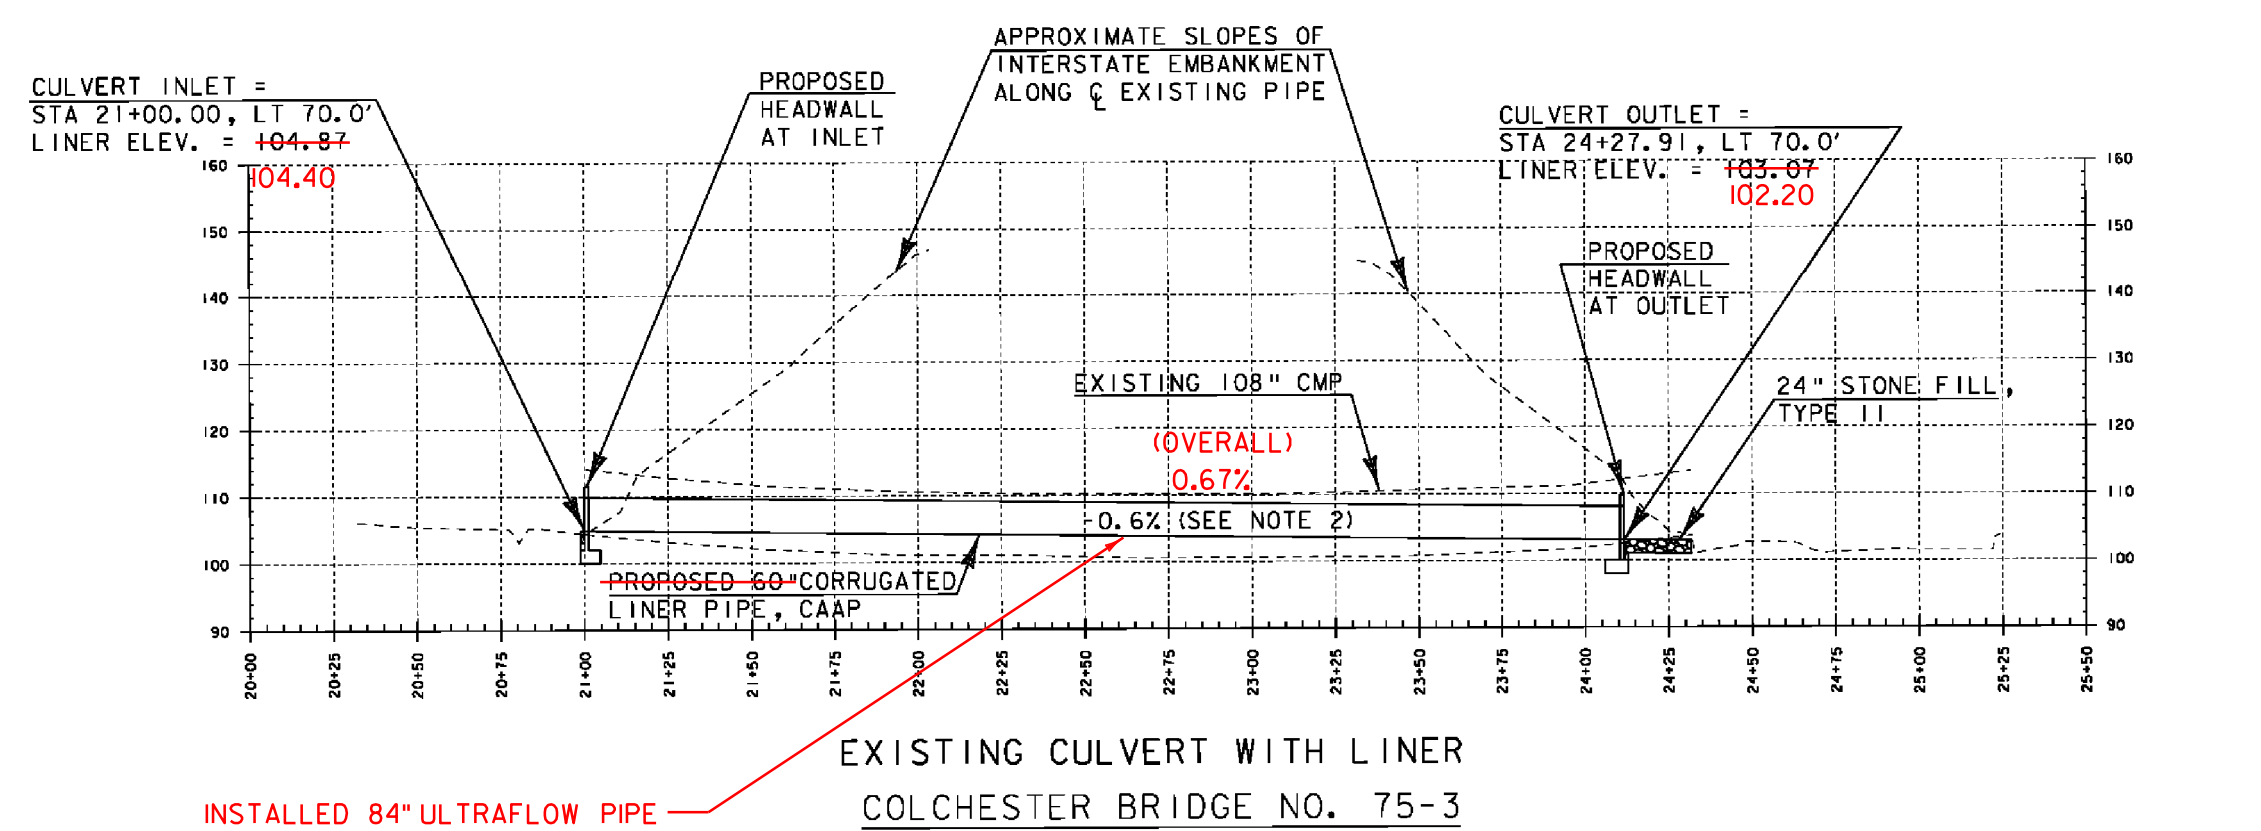

PROJECT NOTES

- POTENTIAL VOID LOCATIONS SHOWN FOR EXPLANATION PURPOSES ONLY.
- CULVERT LINER SHALL BE CONSTRUCTED AT A CONSTANT SLOPE TO ELIMINATE THE SAG IN THE EXISTING CULVERT.

FILL ANNULAR SPACE BETWEEN PROPOSED CAAP LINER AND EXISTING CMP WITH MORTAR, TYPE IV PAID UNDER ITEM 900.640, SPECIAL PROVISION (CORRUGATED PIPE LINER, CAAP)

HORIZONTAL
0 20 40 60
SCALE IN FEET



PROJECT NAME:	SO. BURLINGTON - COLCHESTER
PROJECT NUMBER:	IM CULV (23)
FILE NAME:	z09a046pr00l.dgn
PROJECT LEADER:	D. BENOIT
DESIGNED BY:	B. COLBURN
PROFILE SHEET - COLCHESTER 75-3	
PLOT DATE:	08-FEB-2011
DRAWN BY:	M. LOVETT
CHECKED BY:	D. BENOIT
SHEET	18 OF 36