




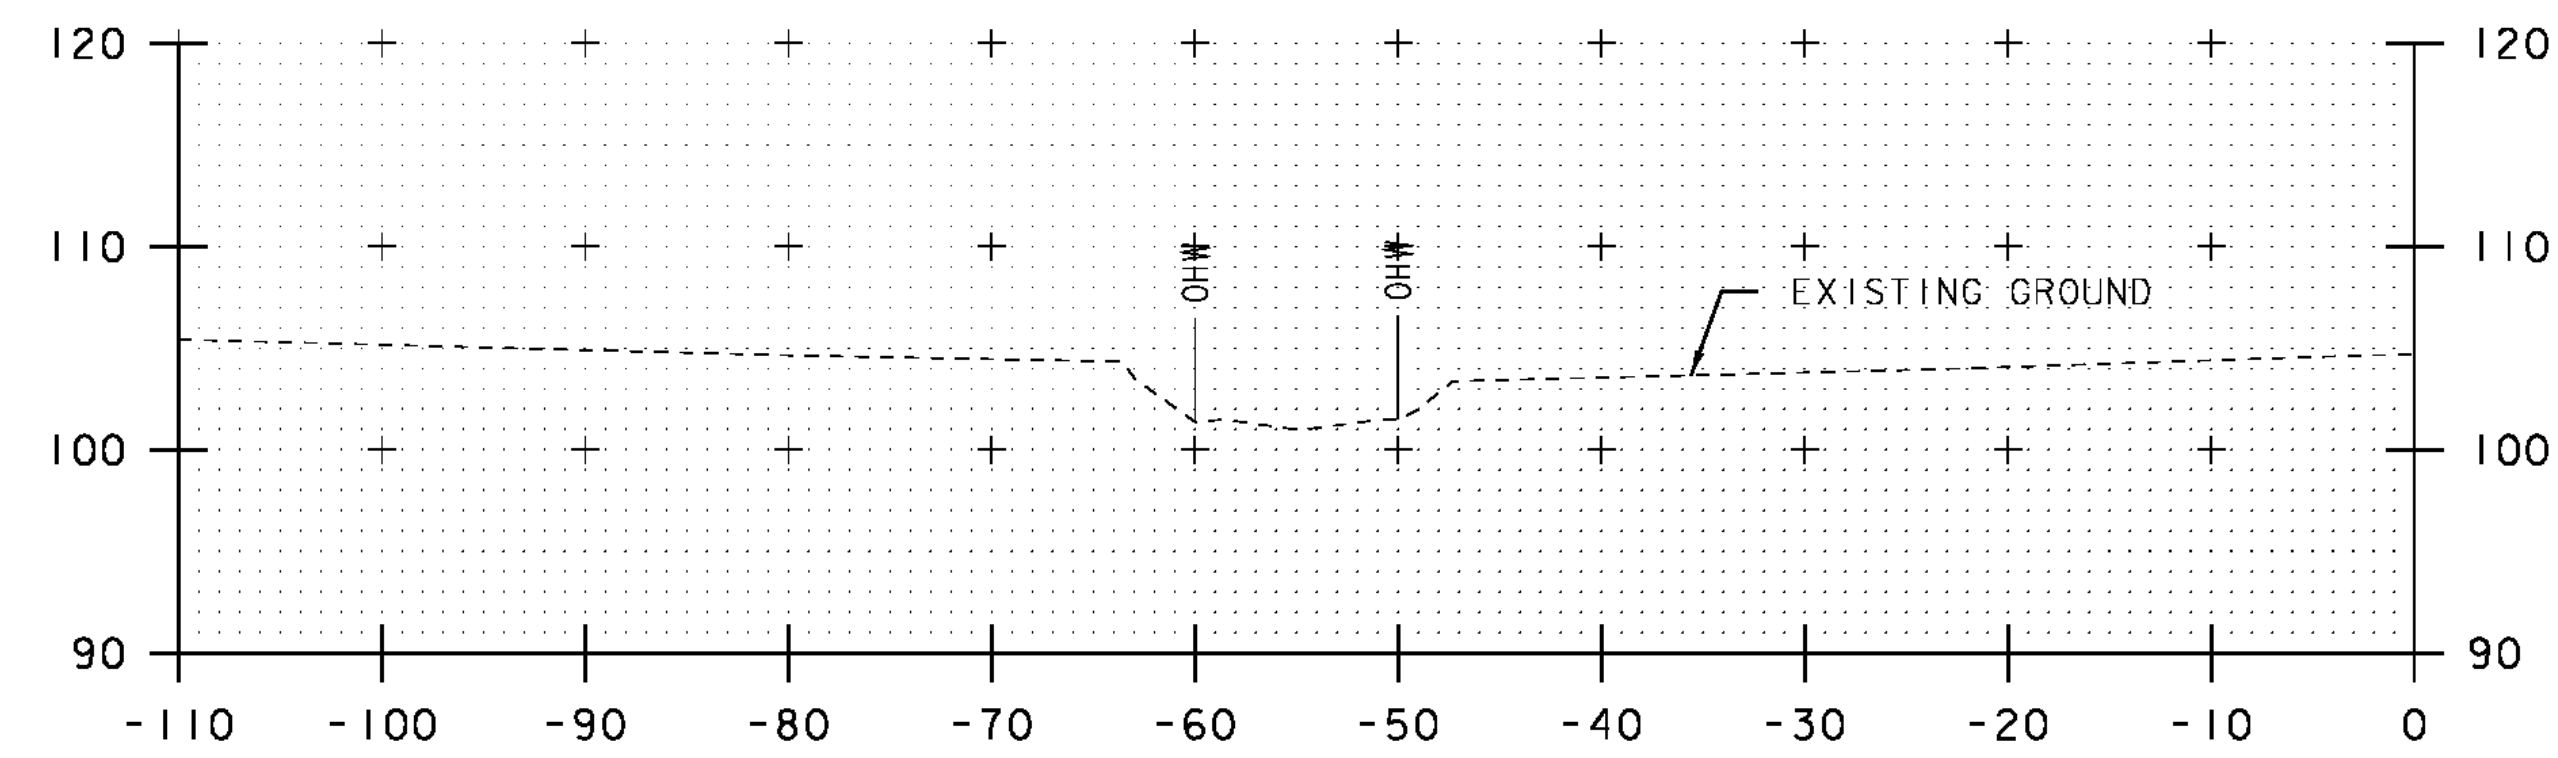


25+00

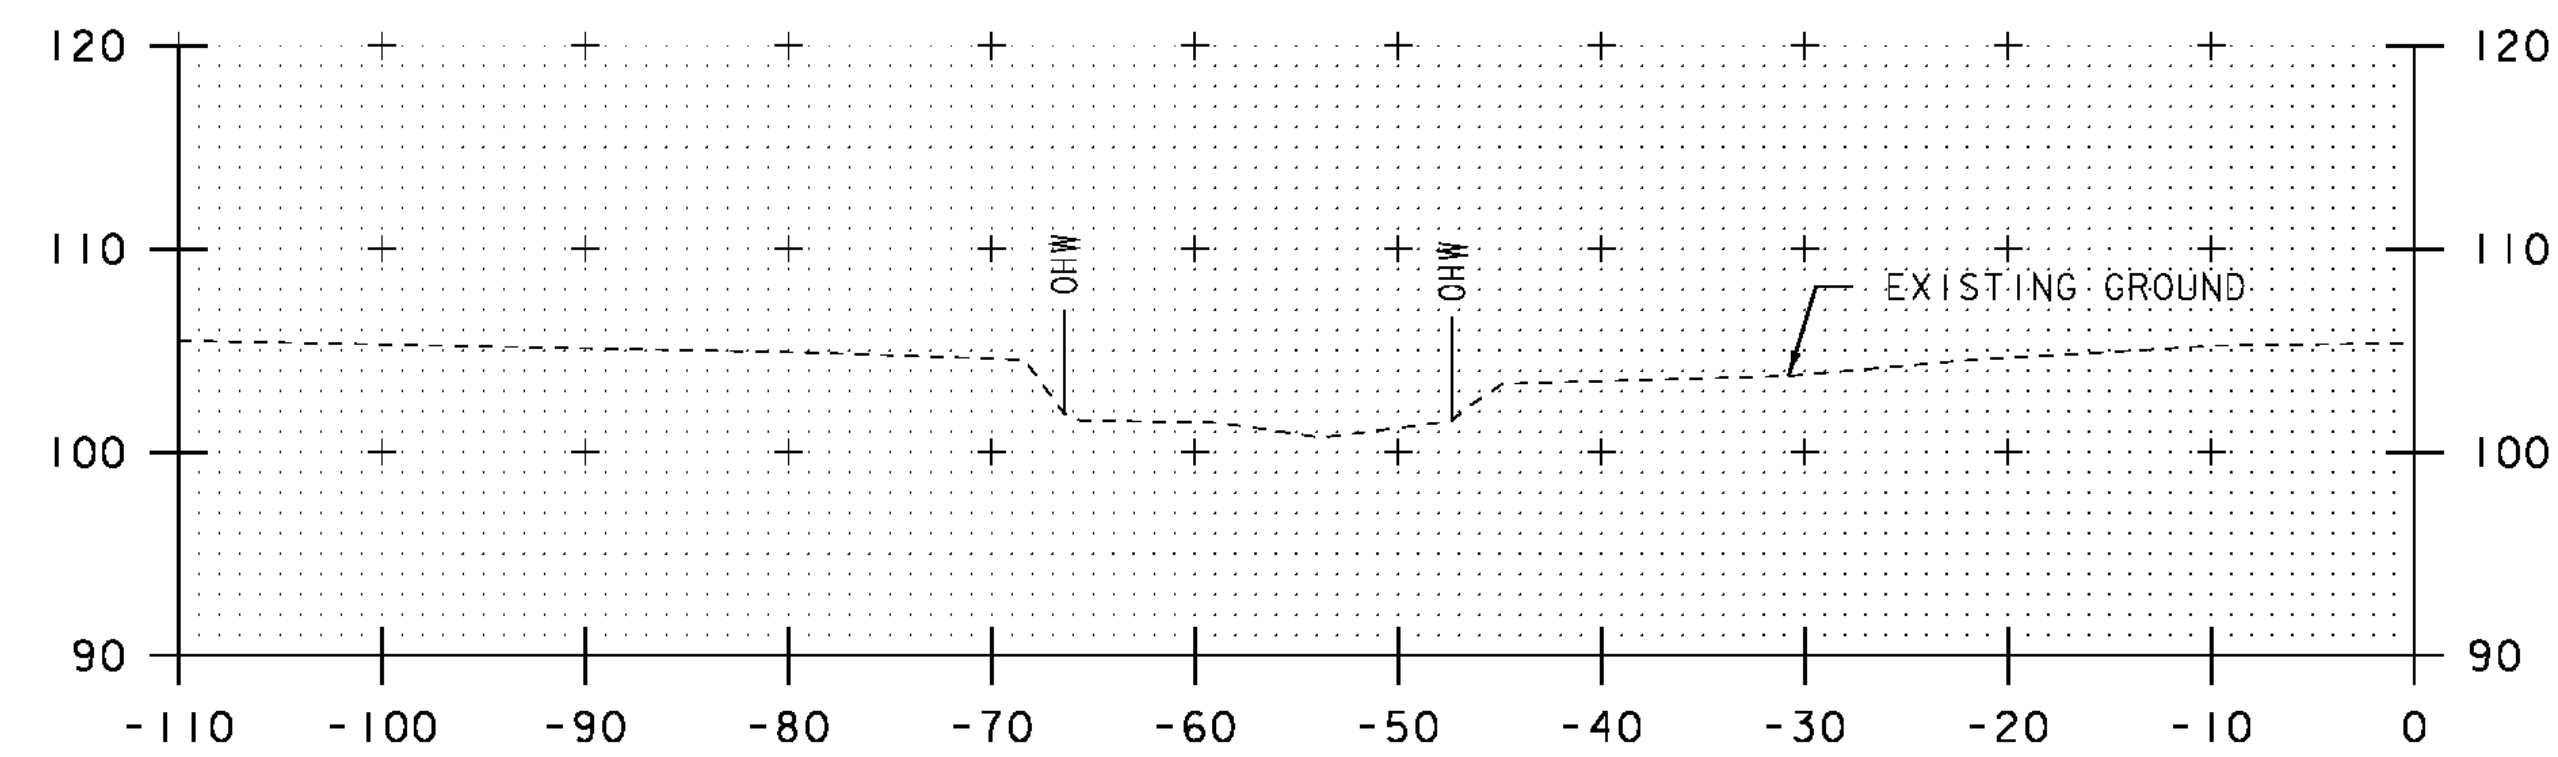

24+75

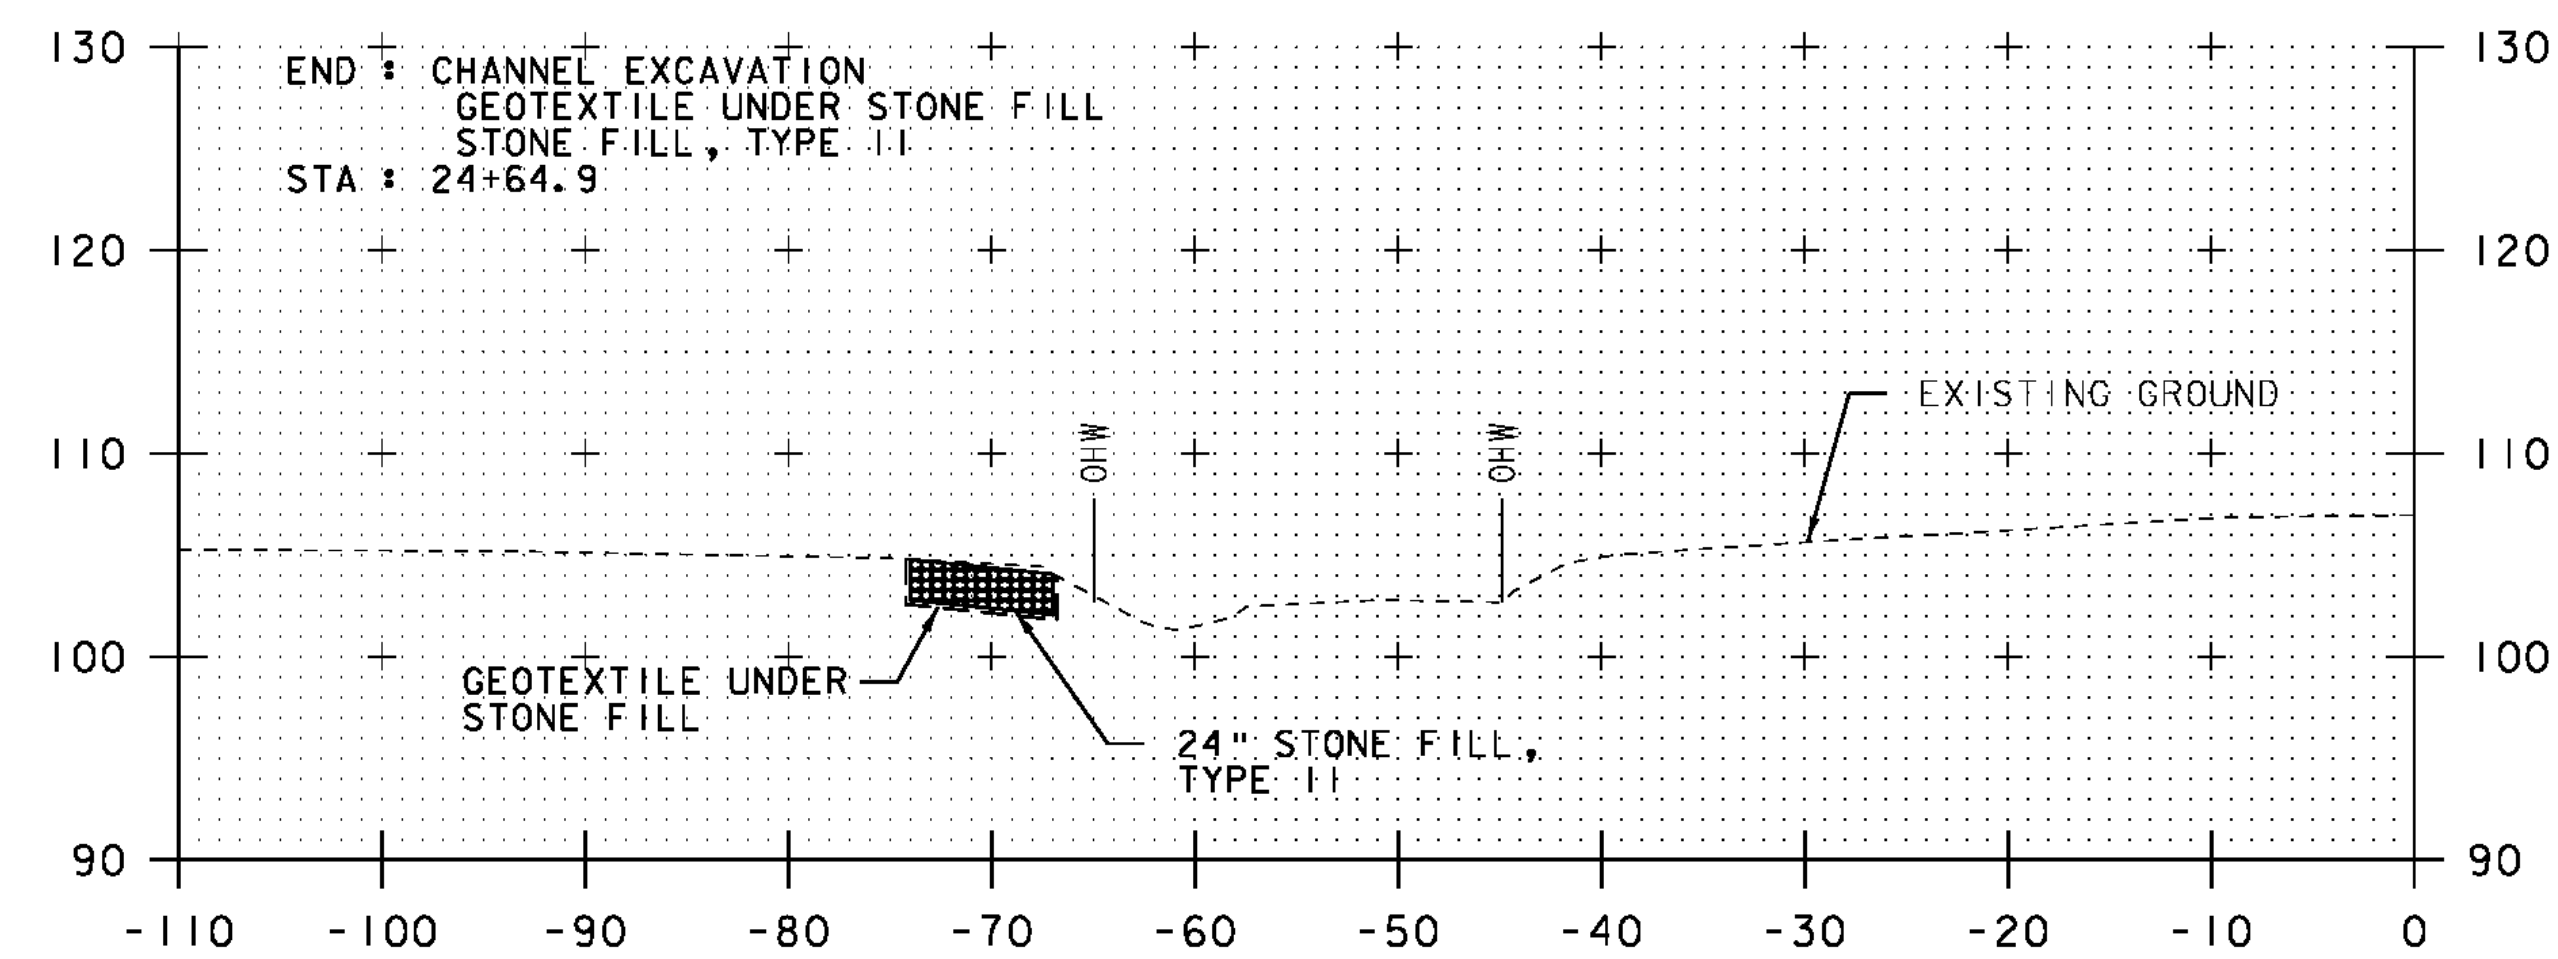

24+50

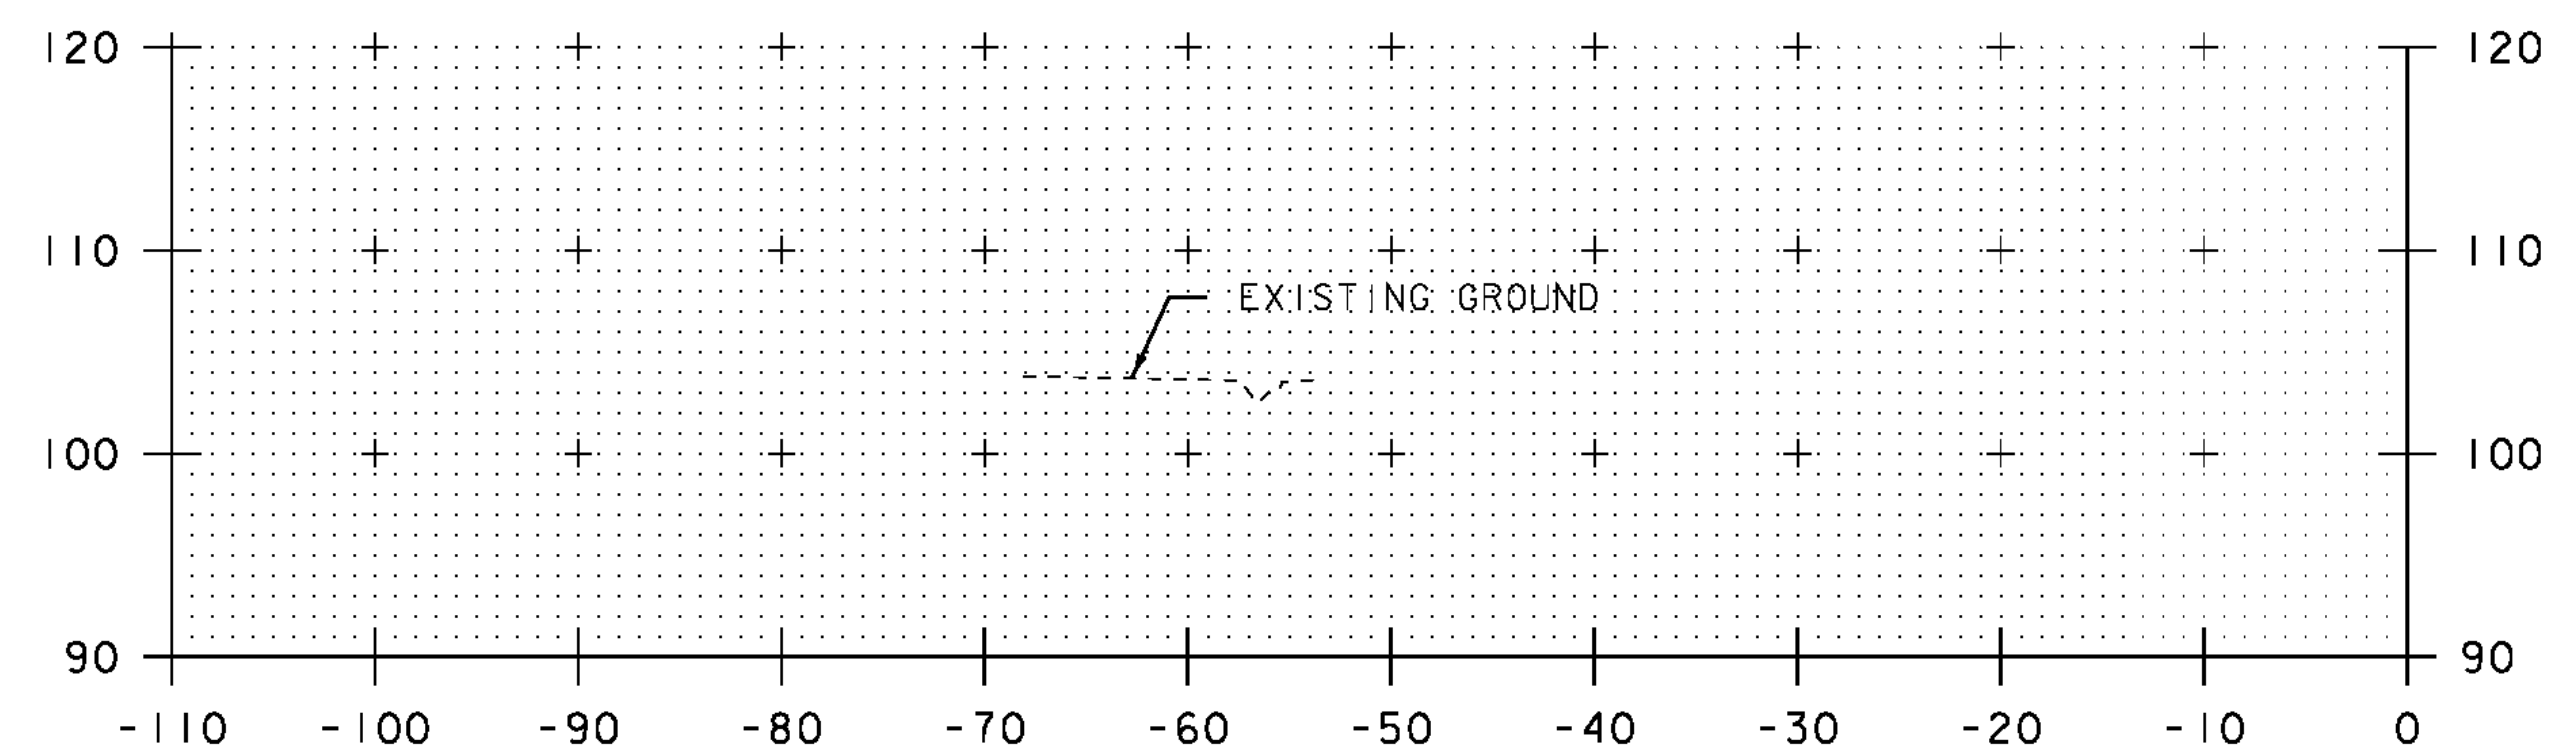

25+25

STA. 24+50 TO STA. 25+25



|                                           |                        |
|-------------------------------------------|------------------------|
| PROJECT NAME: SO. BURLINGTON - COLCHESTER |                        |
| PROJECT NUMBER: IM CULV (23)              |                        |
| FILE NAME: z09a046xs.dgn                  | PLOT DATE: 08-FEB-2011 |
| PROJECT LEADER: D. BENOIT                 | DRAWN BY: R. HALEY     |
| DESIGNED BY: R. HALEY                     | CHECKED BY: D. BENOIT  |
| CROSS SECTIONS - COLCHESTER 75-3          | SHEET 24 OF 36         |