




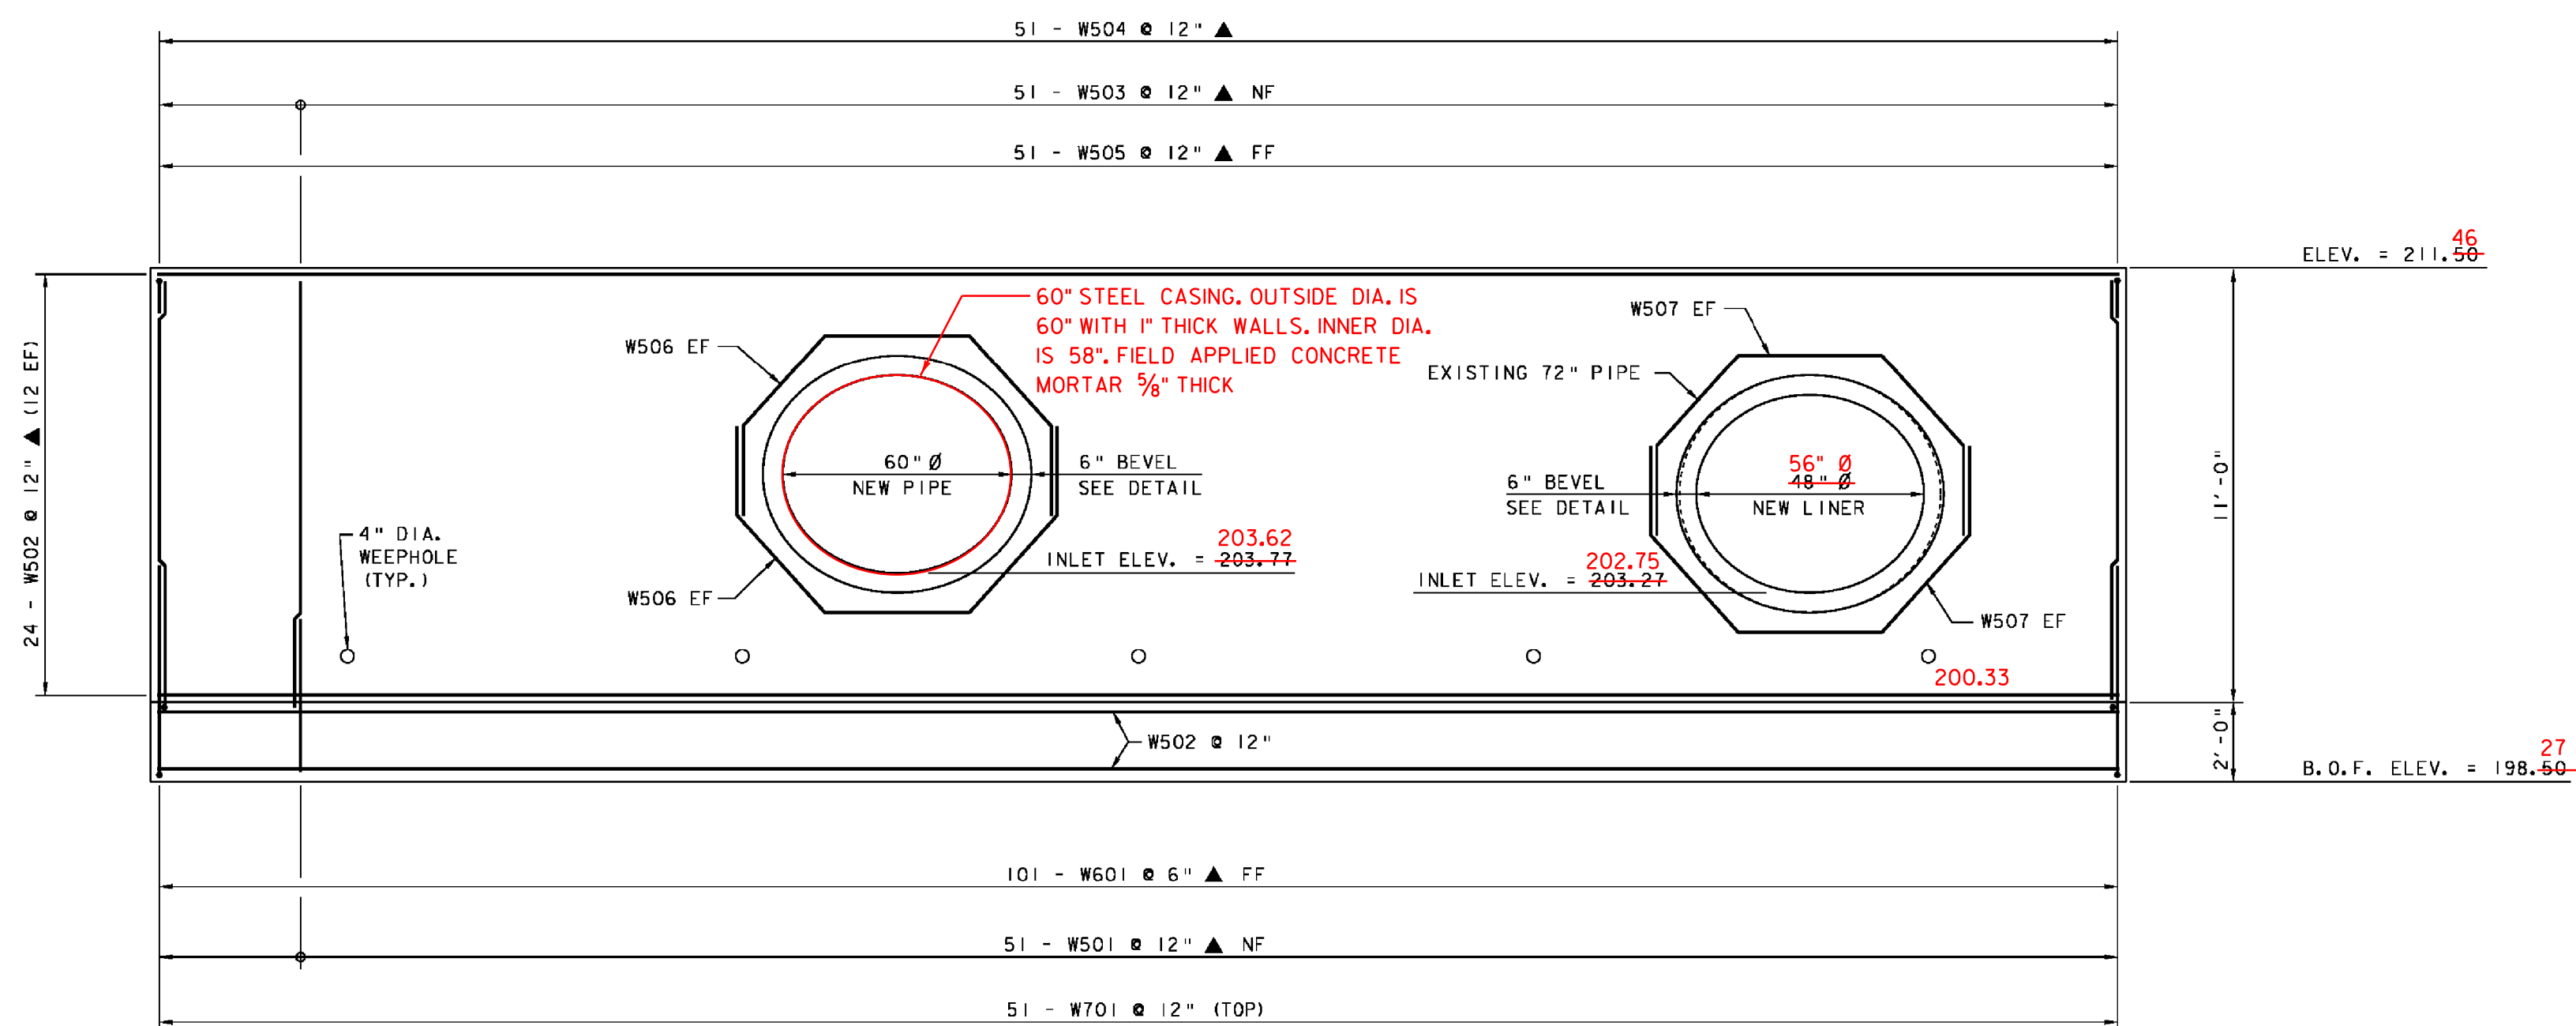


HEADWALL ELEVATION - INLET

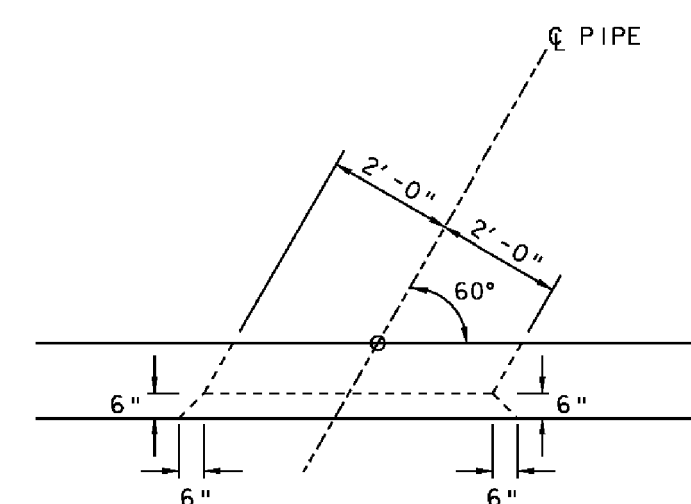

BEVEL DETAIL

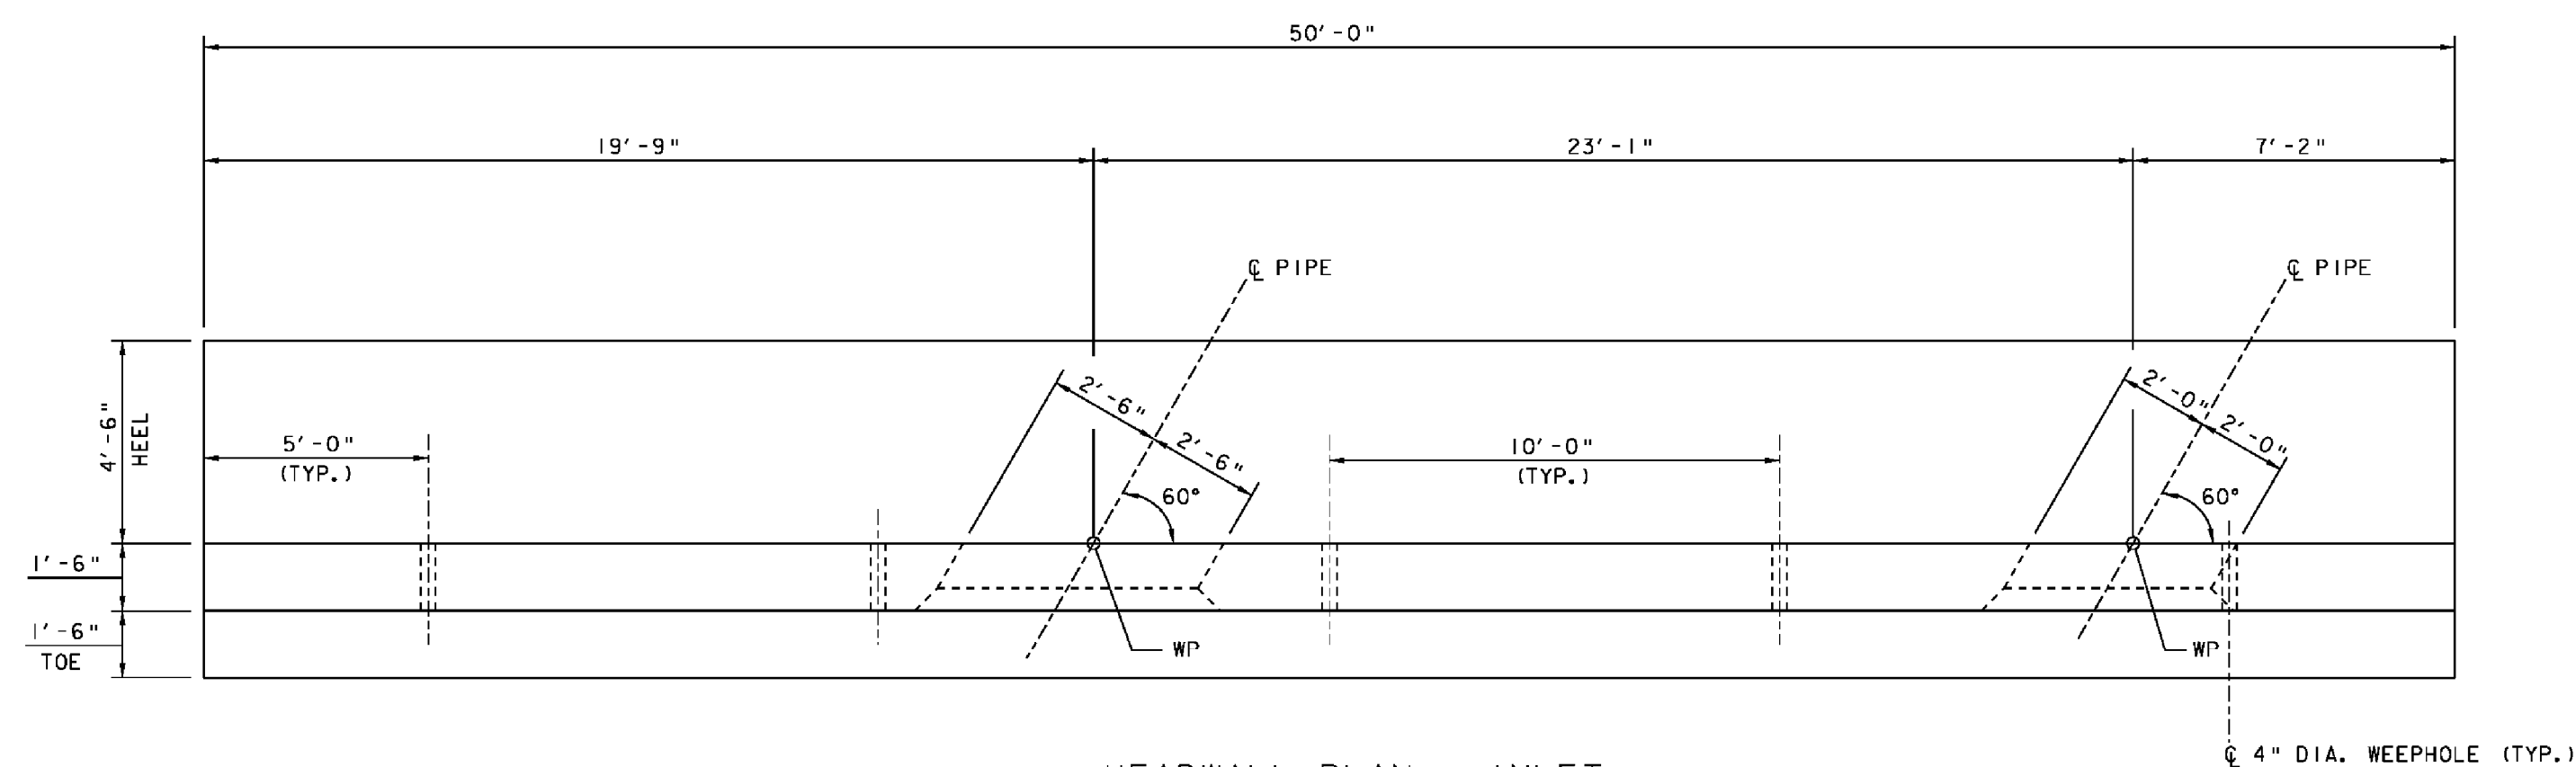

HEADWALL PLAN - INLET

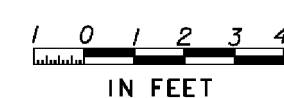

NOTE:
 NF - NEAR FACE
 FF - FAR FACE
 EF - EACH FACE
 ▲ - CUT TO FIT IN FIELD
 3" CLR. UNLESS OTHERWISE
 SPECIFIED ON THE PLANS.

PROJECT NAME:	SO. BURLINGTON - COLCHESTER
PROJECT NUMBER:	IM CULV (23)
FILE NAME:	Headwall S Burlington.dgn
PROJECT LEADER:	D. BENOIT
DESIGNED BY:	W. DURACK
HEADWALL DETAILS SHEET 1 - SO. BURL. 69-1	SHEET 30 OF 36
PLOT DATE:	08-FEB-2011
DRAWN BY:	S. MERKMAN
CHECKED BY:	D. BENOIT