

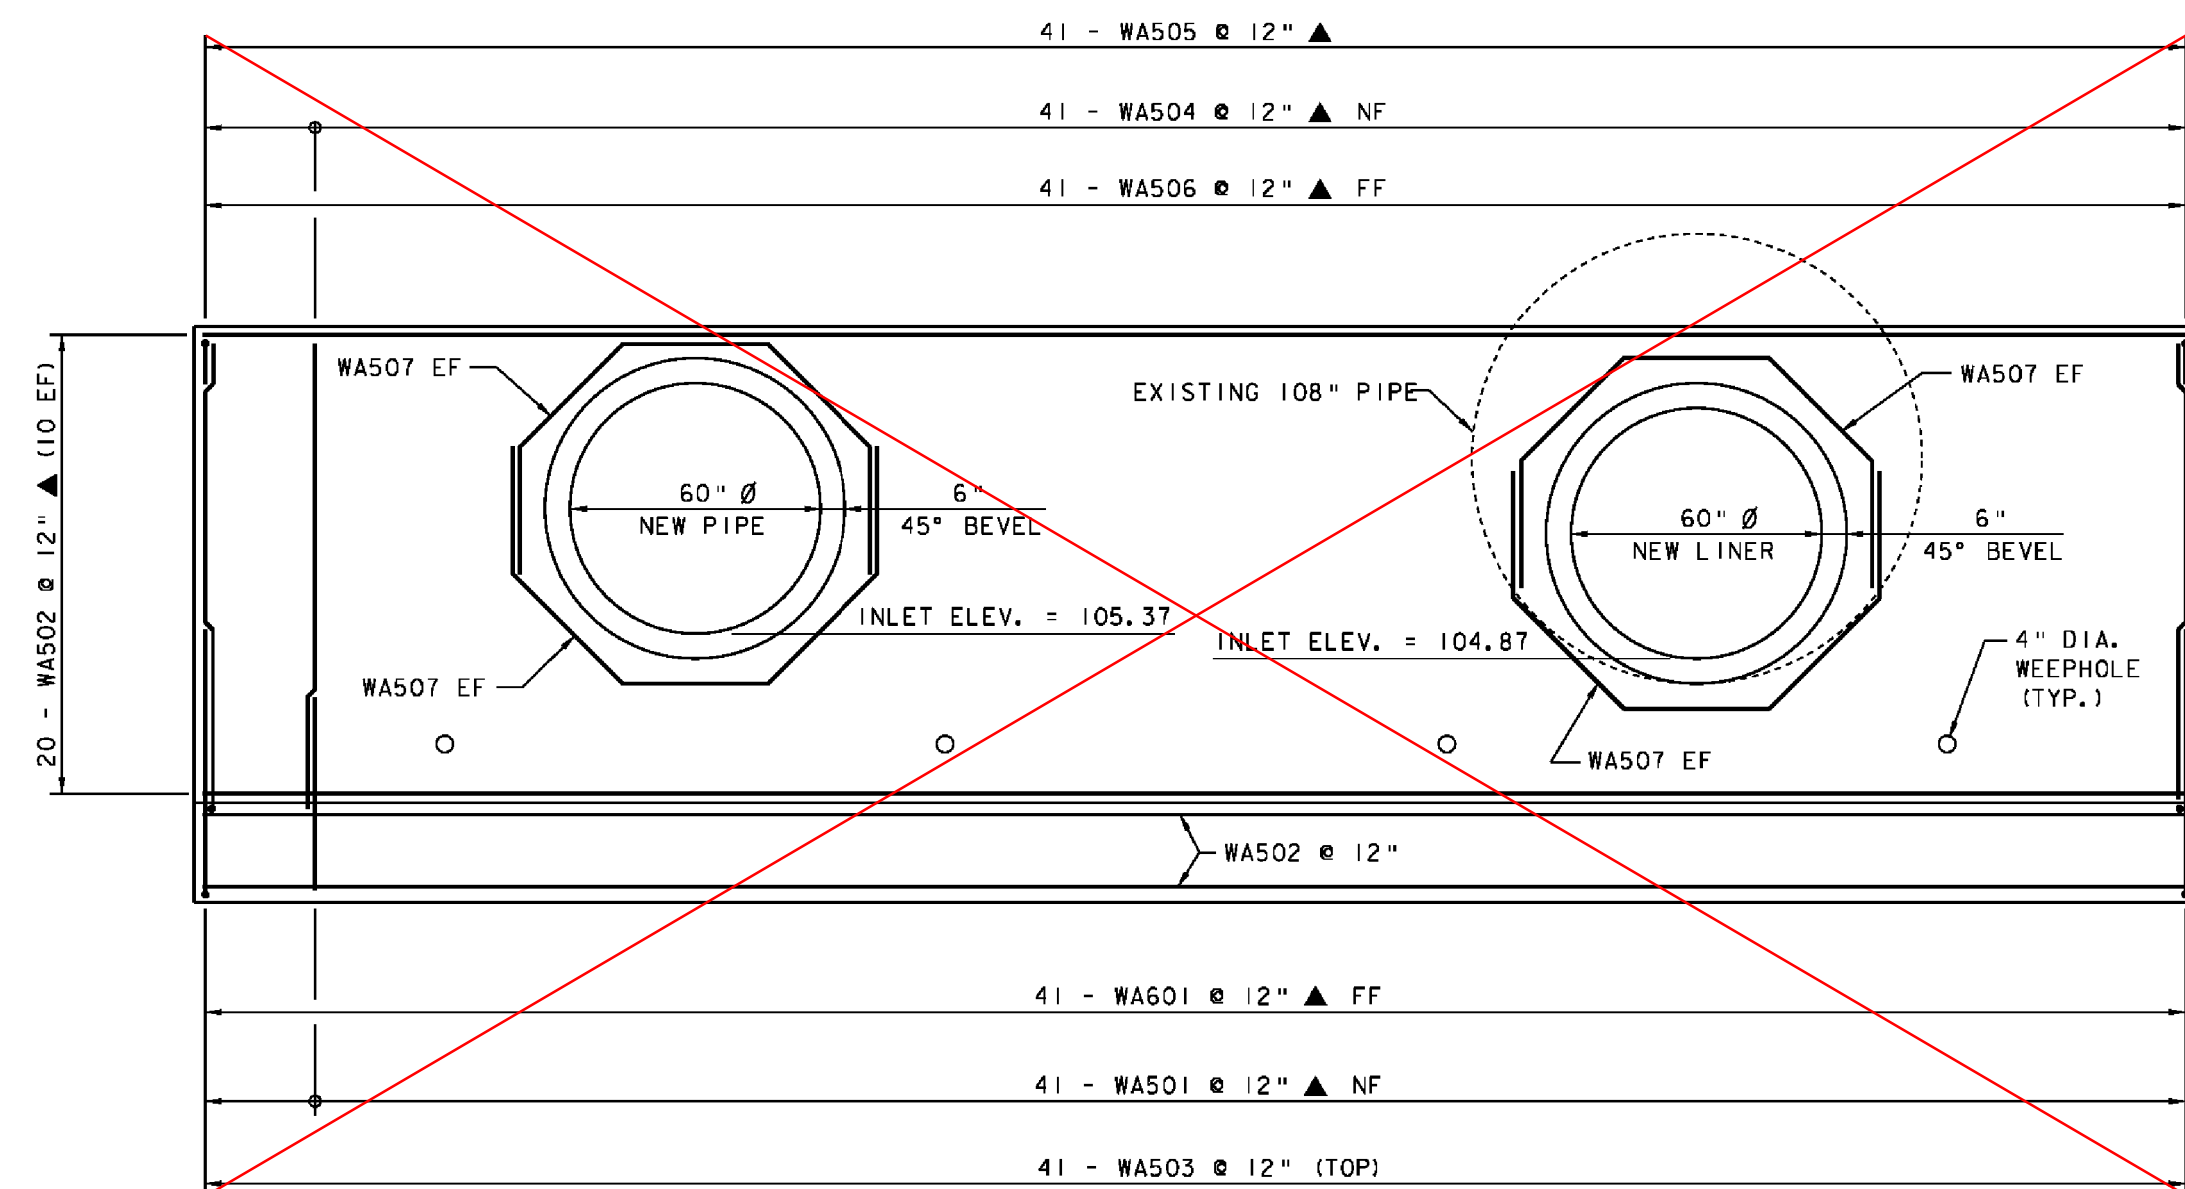


NEW HEADWALL DESIGN, PART OF D.V.E.P.
SECOND PIPE ELIMINATED

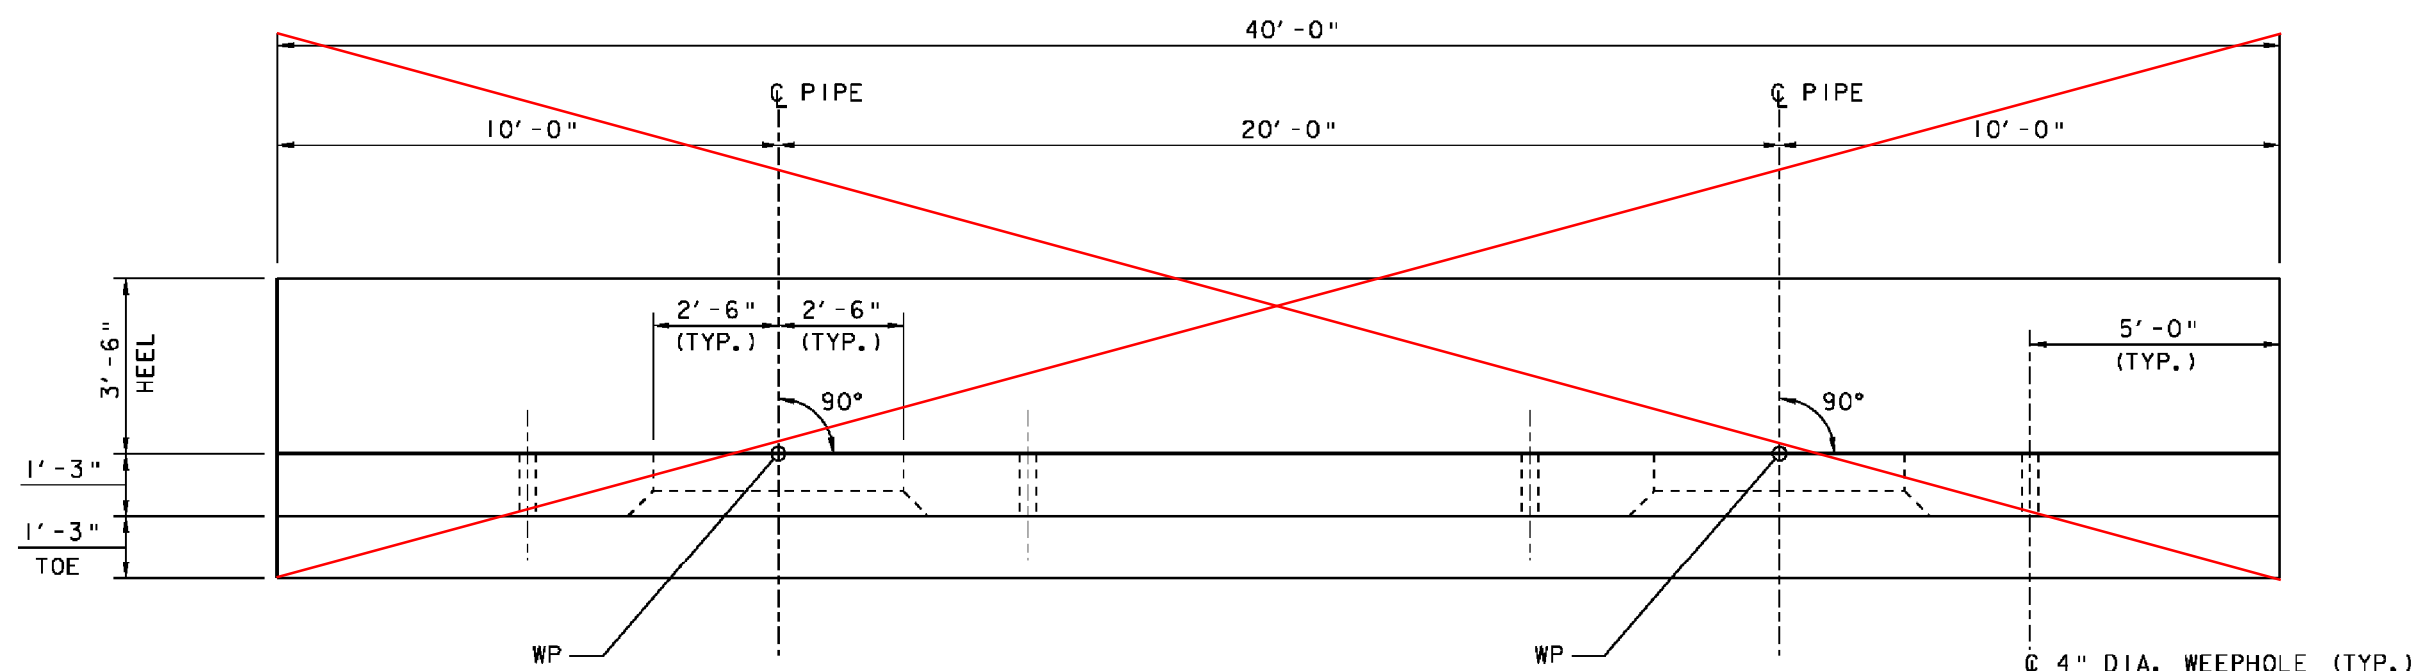



HEADWALL ELEVATION - INLET

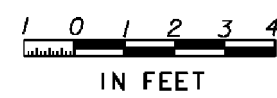

HEADWALL PLAN - INLET



ELEV. = 111.50
9'-6"
2'-0"
B.O.F. ELEV. = 100.00

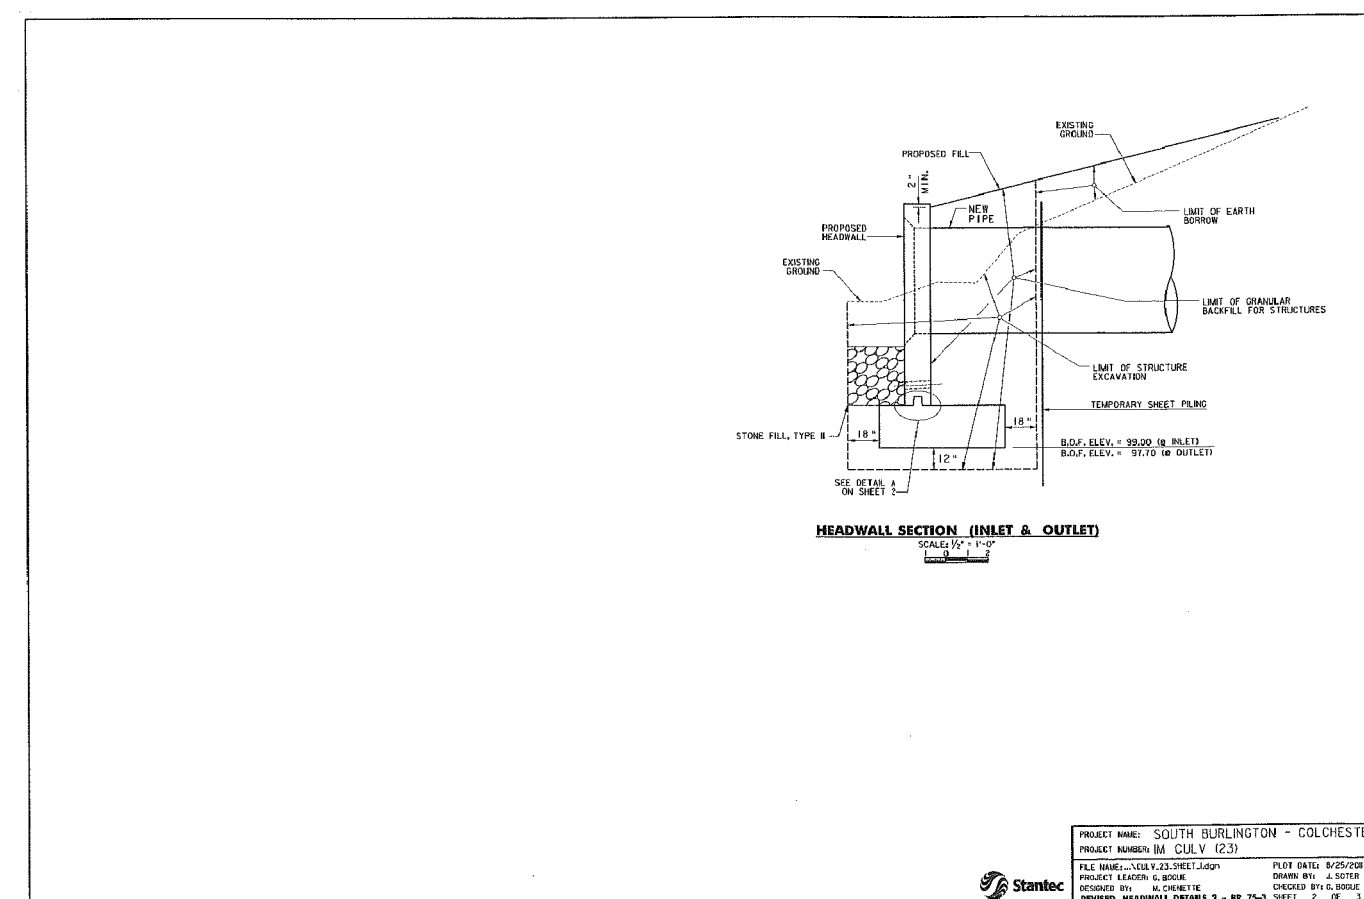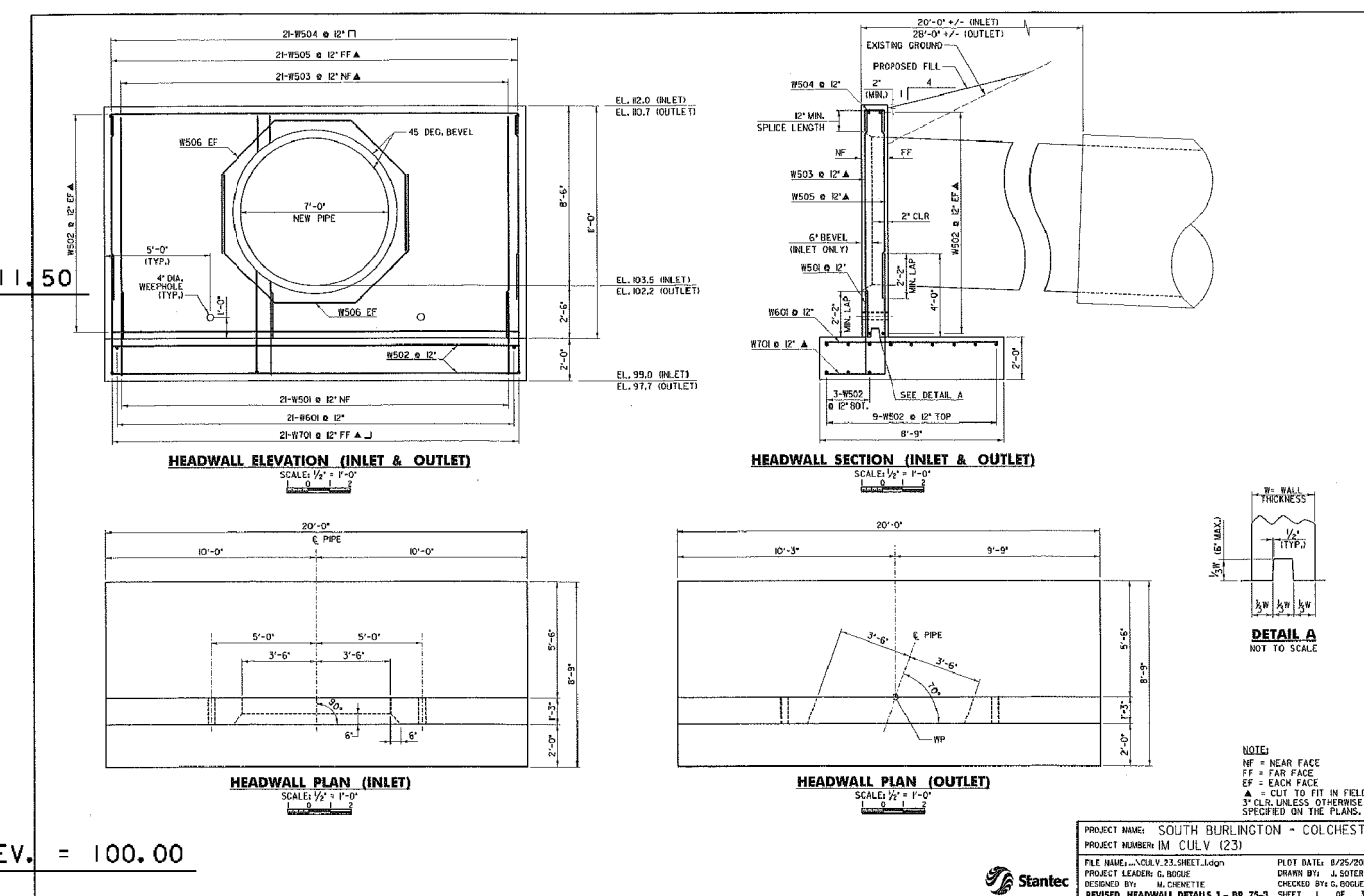

NOTE:

- NF - NEAR FACE
- FF - FAR FACE
- EF - EACH FACE
- ▲ - CUT TO FIT IN FIELD
- 3" CLR. UNLESS OTHERWISE SPECIFIED ON THE PLANS.

PROJECT NAME: SO. BURLINGTON - COLCHESTER
PROJECT NUMBER: IM CULV (23)

FILE NAME: headwall_colchester.dgn
PROJECT LEADER: D. BENOT
DESIGNED BY: W. DURACK
HEADWALL DETAILS SHEET 1 - COLCH. 75-3

PLOT DATE: 08-FEB-2011
DRAWN BY: S. MERKMAN
CHECKED BY: D. BENOT
SHEET 32 OF 36