




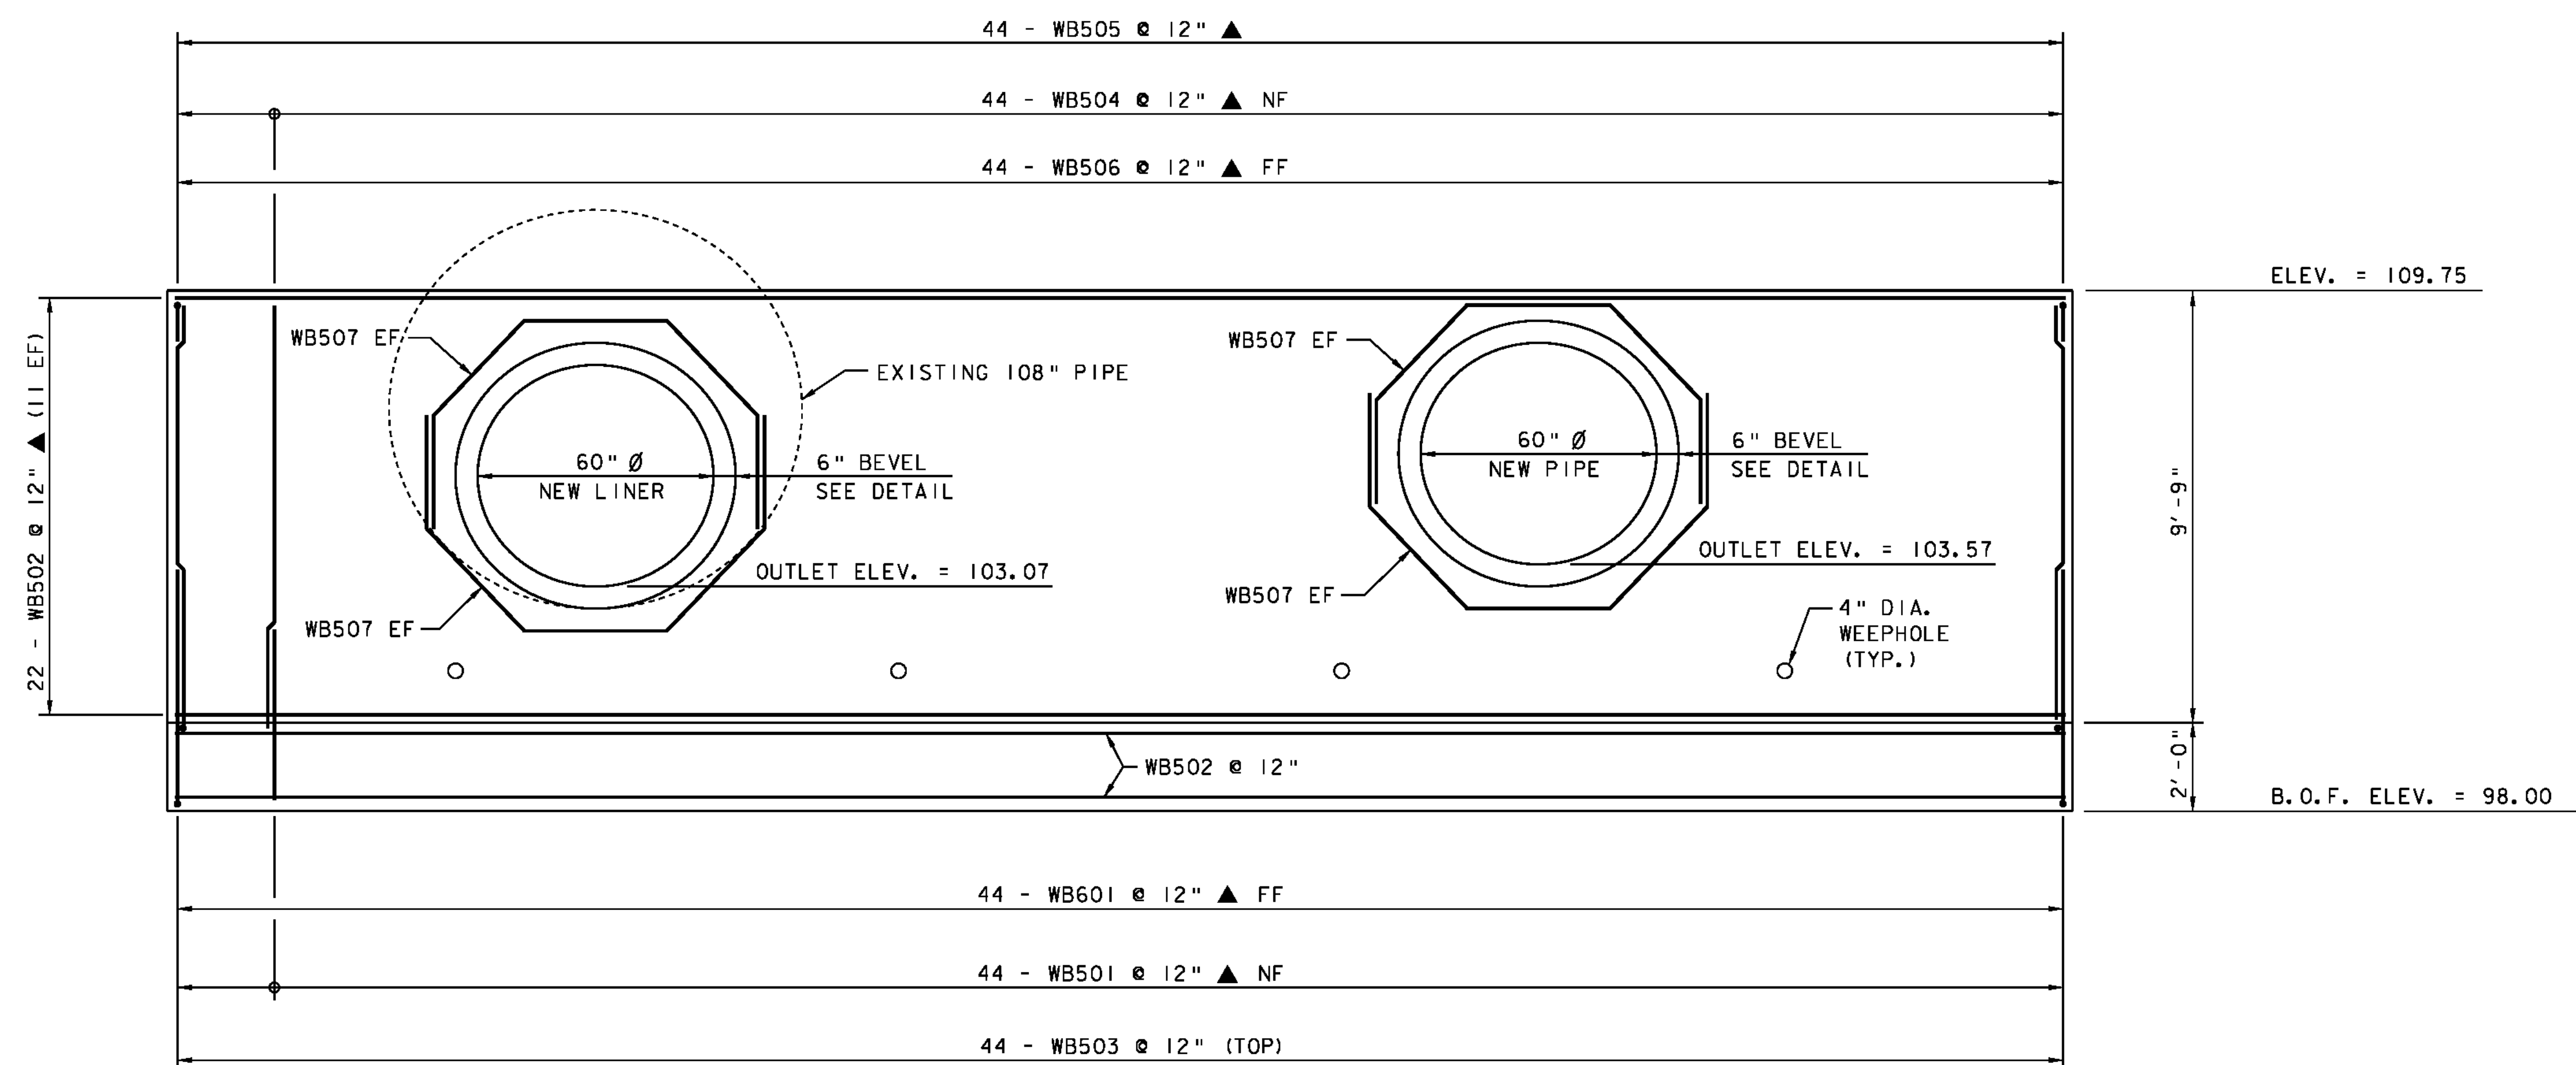

HEADWALL ELEVATION - OUTLET

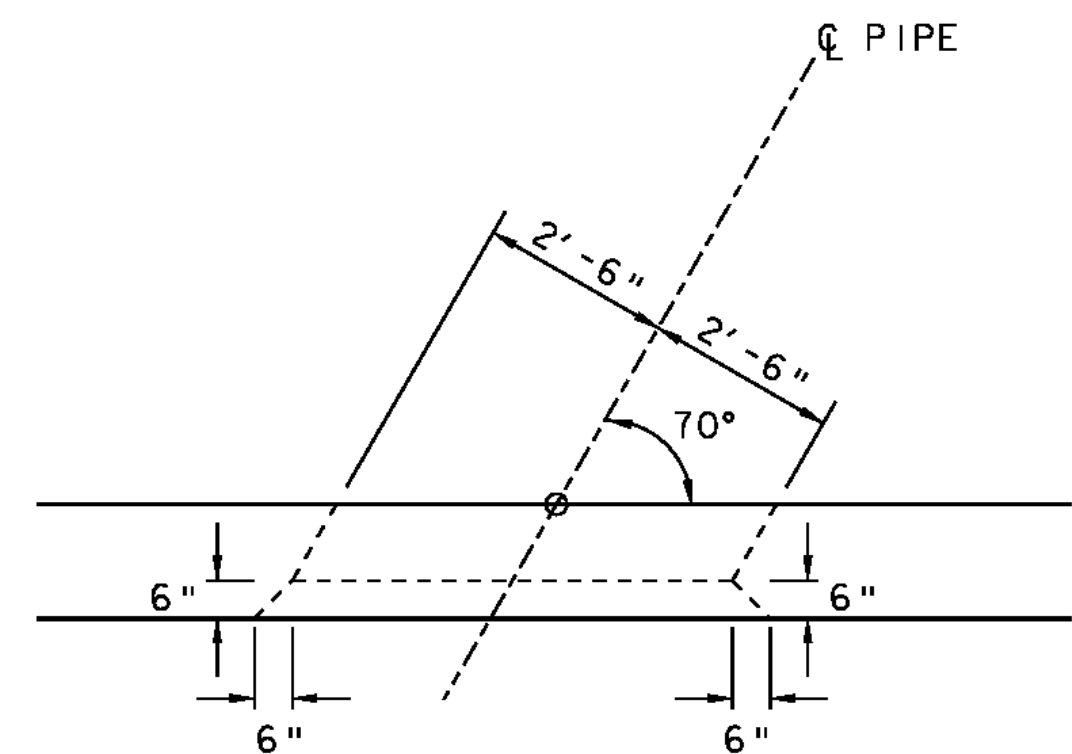

BEVEL DETAIL

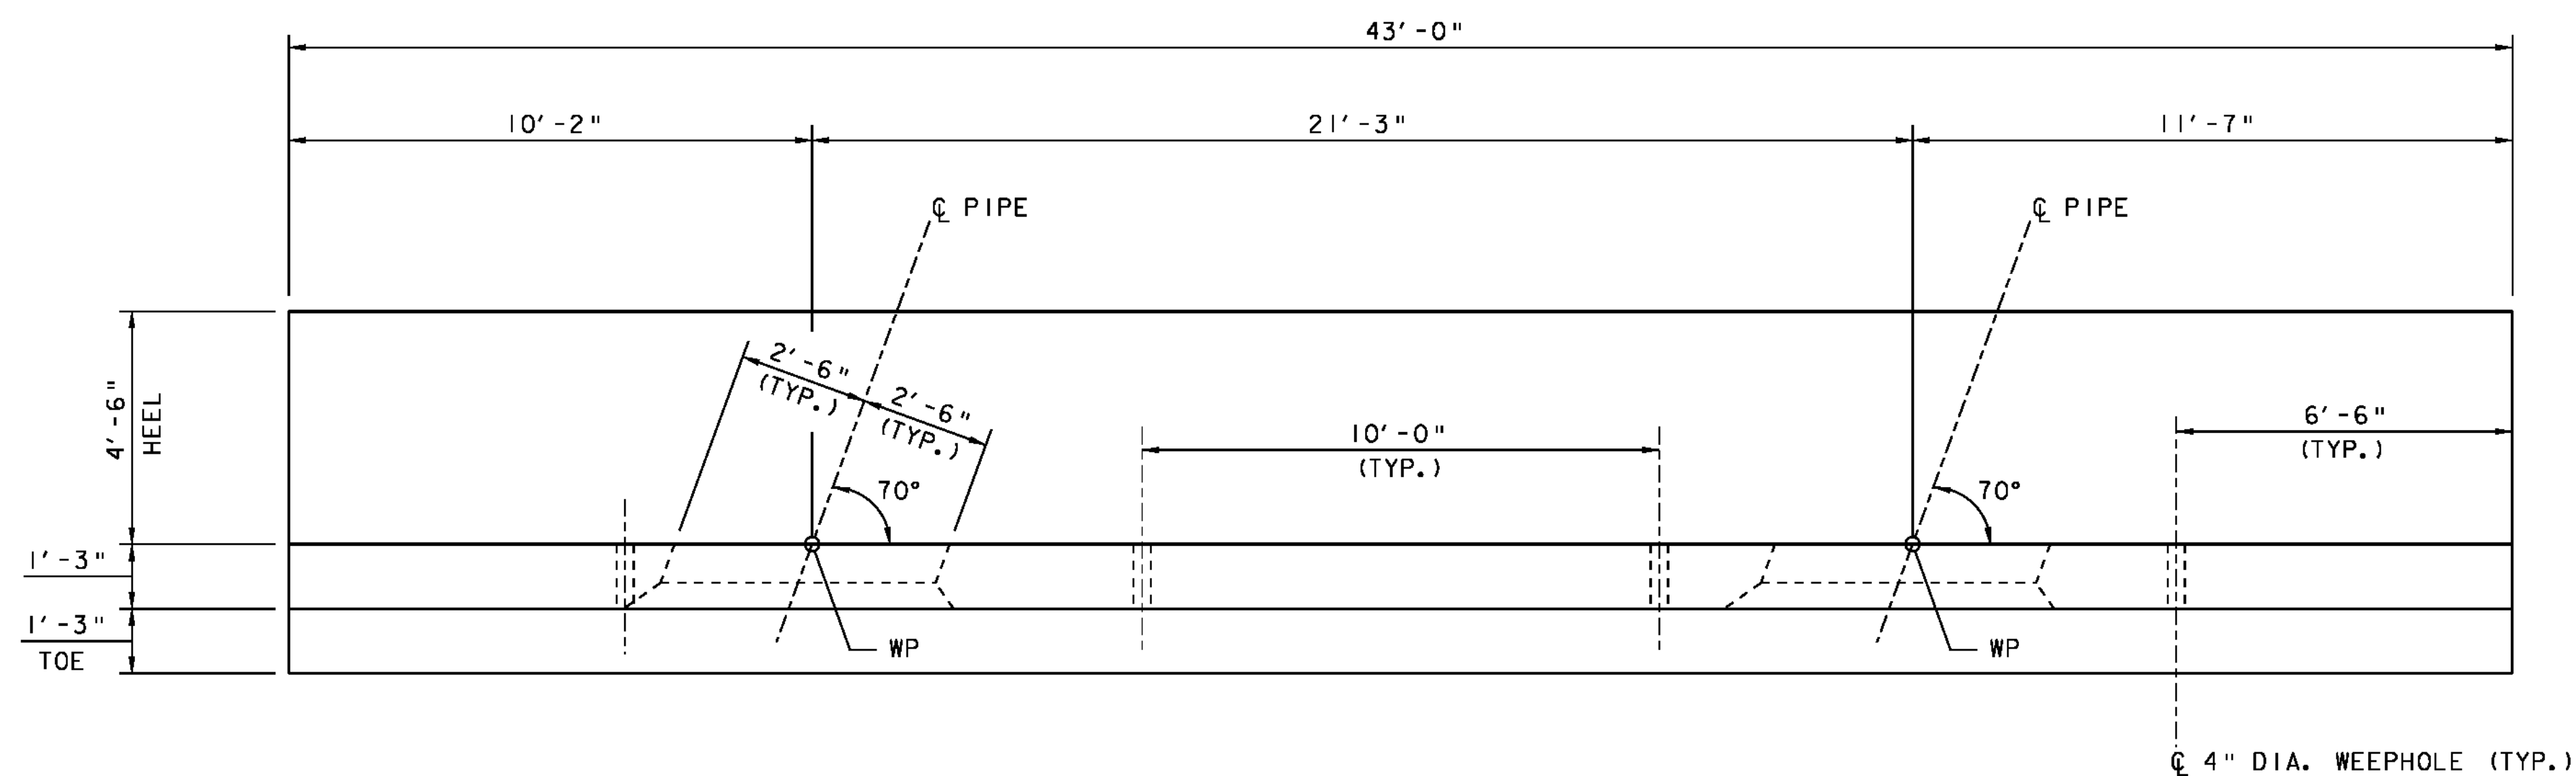

HEADWALL PLAN - OUTLET



NOTE:
 NF = NEAR FACE
 FF = FAR FACE
 EF = EACH FACE
 ▲ = CUT TO FIT IN FIELD
 3" CLR. UNLESS OTHERWISE
 SPECIFIED ON THE PLANS.

PROJECT NAME:	SO. BURLINGTON - COLCHESTER
PROJECT NUMBER:	IM CULV (23)
FILE NAME:	headwall.colchester.dgn
PROJECT LEADER:	D. BENOIT
DESIGNED BY:	W. DURACK
HEADWALL DETAILS SHEET 2 - COLCH. 75-3	
PLOT DATE:	08-FEB-2011
DRAWN BY:	S. MERKWAN
CHECKED BY:	D. BENOIT
SHEET	33 OF 36

