


REINFORCING STEEL SCHEDULE

ITEM	EACH	SIZE	LENGTH	MARK	TYPE	A	B	C	D	E	F	G	H	J	K	R	O	ITEM	EACH	SIZE	LENGTH	MARK	TYPE	A	B	C	D	E	F	G	H	J	K	R	O																														
COLCHESTER																																																																	
INLET FOOTING																																																																	
▲	41	5	4'- 1"	W501	STR																																																												
	10	5	39'- 6"	W502	STR																																																												
	41	5	5'- 6"	W503	STR																																																												
▲	41	6	6'- 7"	W601	17		0'- 0"	2'- 1"	4'- 6"																																																								
INLET STEM																																																																	
▲	20	5	39'- 6"	W502	STR																																																												
▲	41	5	9'- 2"	W504	STR																																																												
▲	41	5	2'- 11"	W505	17		1'- 0"	0'- 11"	1'- 0"																																																								
▲	41	5	9'- 2"	W506	STR																																																												
	8	5	13'- 9"	W507	14	2'- 6"	2'- 11"	2'- 11"	2'- 11"	2'- 6"			2'- 1"		2'- 1"																																																		
OUTLET FOOTING																																																																	
▲	44	5	4'- 1"	W501	STR																																																												
	11	5	42'- 6"	W502	STR																																																												
	44	5	6'- 6"	W503	STR																																																												
▲	44	6	6'- 7"	W601	17		0'- 0"	2'- 1"	4'- 6"																																																								
OUTLET STEM																																																																	
▲	22	5	42'- 6"	W502	STR																																																												
▲	44	5	9'- 5"	W504	STR																																																												
▲	44	5	2'- 11"	W505	17		1'- 0"	0'- 11"	1'- 0"																																																								
▲	44	5	9'- 5"	W506	STR																																																												
	8	5	14'- 1"	W507	14	2'- 6"	2'- 11"	3'- 3"	2'- 11"	2'- 6"			2'- 1"		2'- 1"																																																		

~ NOTES ~

- UNLESS OTHERWISE DESIGNATED, ALL BAR REINFORCEMENT FOR CONCRETE IN SIZES UP TO AND INCLUDING NO. 18 SHALL CONFORM TO THE REQUIREMENTS OF THE "SPECIFICATIONS FOR DEFORMED BILLET-STEEL BARS FOR CONCRETE REINFORCEMENT", AASHTO M 31 (ASTM A 615-SI). ALL BARS SHALL BE GRADE 60, UNLESS OTHERWISE DESIGNATED.
- FOR TYPICAL BENDING DETAILS, RECOMMENDED PIN DIAMETER "D" OF BENDS AND HOOKS, AND OTHER STANDARD PRACTICE, SEE CURRENT CONCRETE REINFORCING STEEL INSTITUTE "MANUAL OF STANDARD PRACTICE".
- BARS WHICH REQUIRE MORE ACCURATE BENDING THAN STANDARD PRACTICES SHOULD HAVE LIMITS INDICATED.
- ALL DIMENSIONS ARE OUT TO OUT OF BAR EXCEPT "A" AND "G" ON STANDARD 180 DEGREE AND 135 DEGREE HOOKS.
- "J" DIMENSION ON 180 DEGREE HOOKS TO BE SHOWN ONLY WHERE NECESSARY TO RESTRICT HOOK SIZE. OTHERWISE, STANDARD HOOKS ARE TO BE USED.
- "H" DIMENSION ON STIRRUPS TO BE SHOWN ONLY WHEN NECESSARY TO MAINTAIN CLEARANCES.
- WHERE SLOPE DIFFERS FROM 45 DEGREES, DIMENSIONS "H" AND "K" MUST BE SHOWN.
- ▲ DENOTES BARS TO BE CUT IN FIELD.
- ✱ DENOTES ONE EXTRA BAR ADDED FOR TESTING PURPOSES.
- △ DENOTES TWO EXTRA BARS ADDED FOR TESTING PURPOSES
- E IN BAR MARK PREFIX DENOTES EPOXY COATED REINFORCING STEEL.

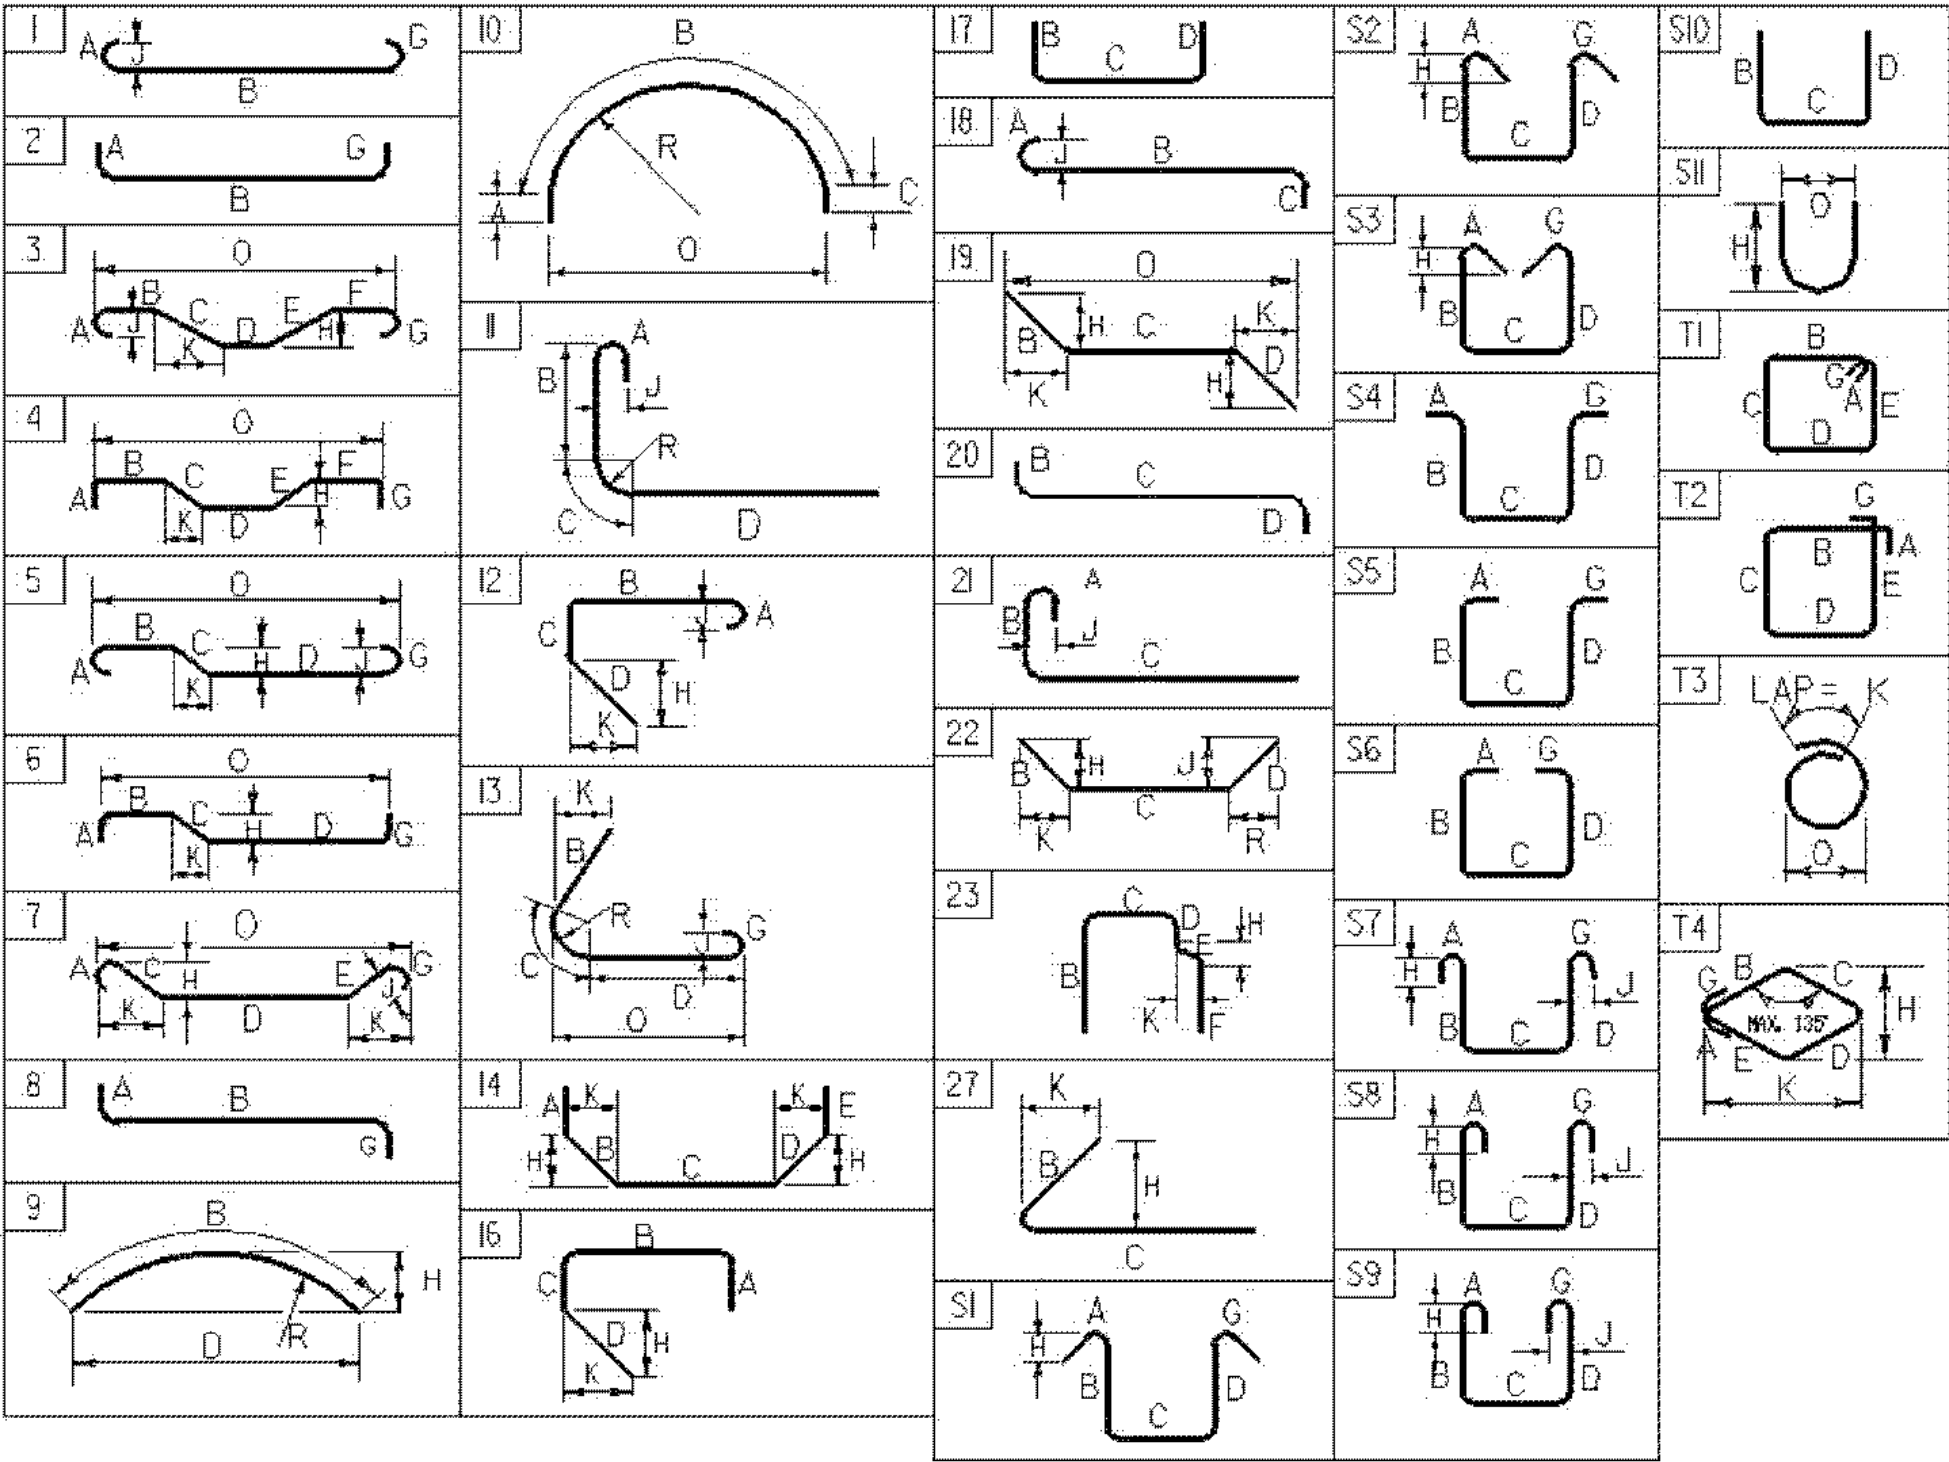

ASTM STANDARD REINFORCING BARS				
BAR SIZE DESIGNA- TION	WEIGHT POUNDS PER FOOT	NOMINAL DIMENSIONS ROUND SECTION		
		DIAMETER INCHES	AREA INCHES ²	PERIMETER INCHES
#3	0.376	0.375	0.11	1.178
#4	0.668	0.500	0.20	1.571
#5	1.043	0.625	0.31	1.963
#6	1.502	0.750	0.44	2.356
#7	2.044	0.875	0.60	2.749
#8	2.670	1.000	0.79	3.142
#9	3.400	1.128	1.00	3.544
#10	4.303	1.270	1.27	3.990
#11	5.313	1.410	1.56	4.430
#14	7.65	1.693	2.25	5.32
#18	13.60	2.257	4.00	7.09

PROJECT NAME: SOUTH BURLINGTON - COLCHESTER
PROJECT NUMBER: IM CULV (23)
FILE NAME: z09a046engreinf colchester.xls
PROJECT MANAGER: DMB
DESIGNED BY: SFD
PLOT DATE: 8/31/2010
DRAWN BY: SLM
CHECKED BY: DMK
REINFORCING STEEL SCHEDULE SHEET 75-3
SHEET 36 OF 36