


INTERSTATE 89 MAINLINE TREATMENT SCHEMATIC

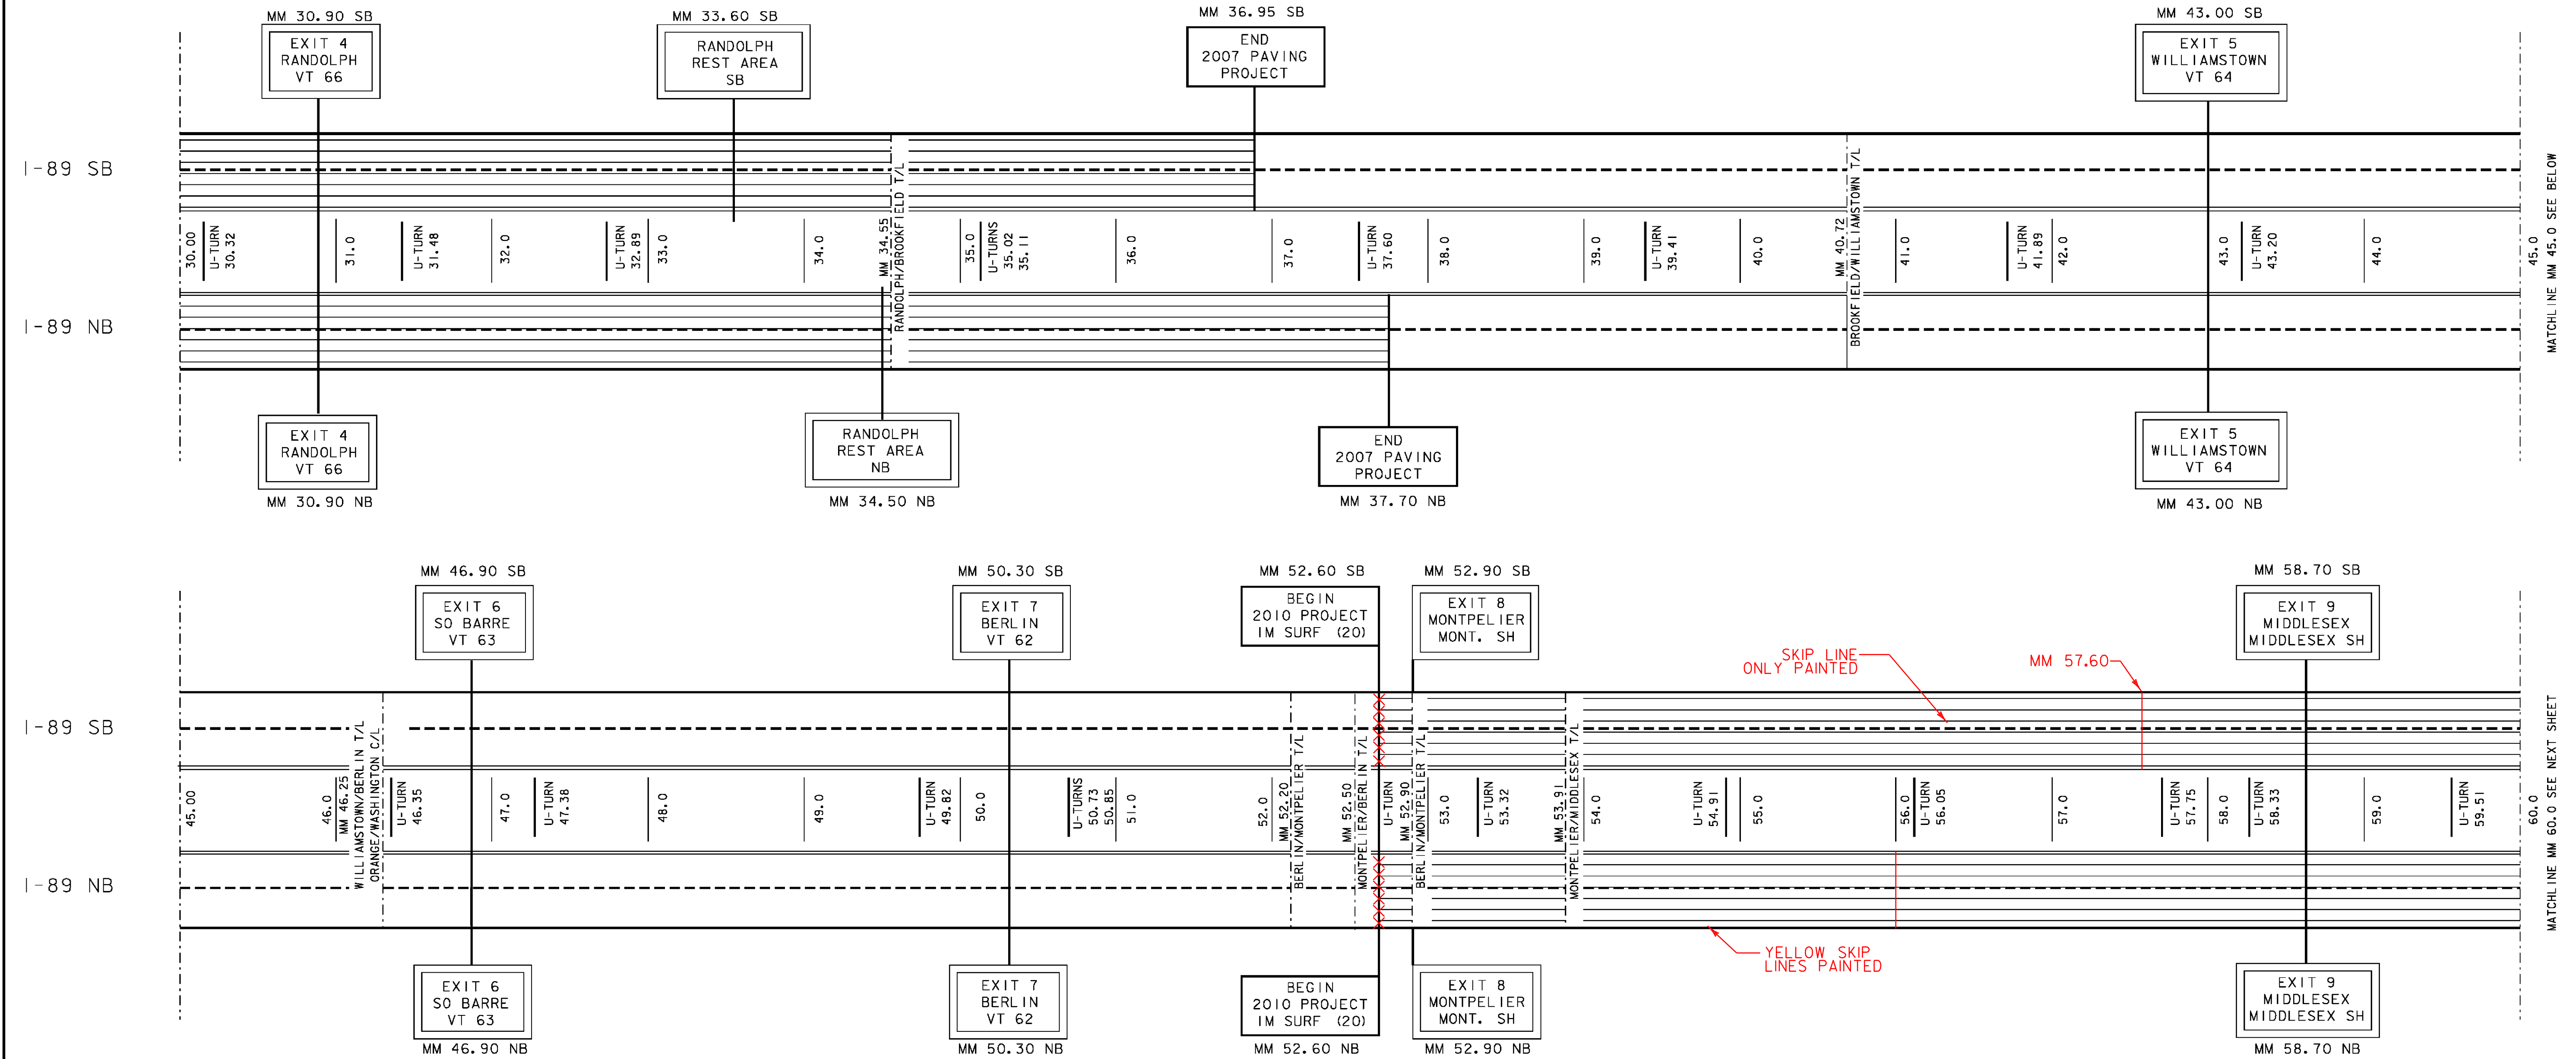

LEGEND

- [Pattern] = AREA NOT TO BE PAINTED
- [Pattern] = AREA TO BE DONE AT NIGHT
- [Pattern] = AREA OF WORN DURABLES WHERE ENGINEER MAY DESIGNATE AREAS TO BE PAINTED
- [Line] = 6'' SOLID WHITE LINE
- [Line] = 6'' DASHED WHITE LINE
- [Line] = 6'' SOLID YELLOW LINE

NOT TO SCALE	PROJECT:	PROJECT NO. :
	STATEWIDE	IMG MARK(110)
	DESIGN FILE NAME: p09a328.dgn IPARM FILE NAME: p09a328ms2.l SURVEYED BY: SQUAD LEADER: A GAMBLE	PLOT DATE: 19-JAN-2010 SURVEY DATE: DRAWN BY: KAS SHEET: 16 OF 29