

TEMPORARY 6 INCH YELLOW LINE

EXIT 14  
NB OFF RAMP STA. 9+40 ~ 18+70 SOLID LT  
NB ON RAMP STA. 0+00 ~ 11+00 SOLID LT

6 INCH YELLOW LINE

EXIT 14  
NB OFF RAMP STA. 9+40 ~ 18+70 SOLID LT  
NB ON RAMP STA. 0+00 ~ 11+00 SOLID LT

TEMPORARY 6 INCH WHITE LINE

EXIT 14  
NB OFF RAMP STA. 0+00 ~ 17+55 LT DOTTED LANE LINE  
NB OFF RAMP STA. 0+00 ~ 18+70 SOLID RT  
NB ON RAMP STA. 0+00 ~ 19+05 SOLID RT  
NB ON RAMP STA. 11+00 ~ 13+30 LT DOTTED LANE LINE

6 INCH WHITE LINE

EXIT 14  
NB OFF RAMP STA. 0+00 ~ 17+55 LT DOTTED LANE LINE  
NB OFF RAMP STA. 0+00 ~ 18+70 SOLID RT  
NB ON RAMP STA. 0+00 ~ 19+05 SOLID RT  
NB ON RAMP STA. 11+00 ~ 13+30 LT DOTTED LANE LINE

TEMPORARY 12 INCH WHITE LINE

EXIT 14  
MAINLINE (GORE STRIPES) SOLID LT  
NB OFF RAMP STA. 7+55 ~ 9+40 SOLID LT (GORE)  
NB ON RAMP STA. 11+00 ~ 13+30 SOLID LT (GORE)

12 INCH WHITE LINE


EXIT 14  
MAINLINE (GORE STRIPES) SOLID LT  
NB OFF RAMP STA. 7+55 ~ 9+40 SOLID LT (GORE)  
NB ON RAMP STA. 11+00 ~ 13+30 SOLID LT (GORE)

TEMPORARY LETTER OR SYMBOL

EXIT 14  
NB OFF RAMP STA. 8+47 "STOP"  
NB OFF RAMP STA. 8+63 "AHEAD"  
NB OFF RAMP STA. 11+42 "STOP"


LETTER OR SYMBOL

EXIT 14  
NB OFF RAMP STA. 8+47 "STOP"  
NB OFF RAMP STA. 8+63 "AHEAD"  
NB OFF RAMP STA. 11+42 "STOP"

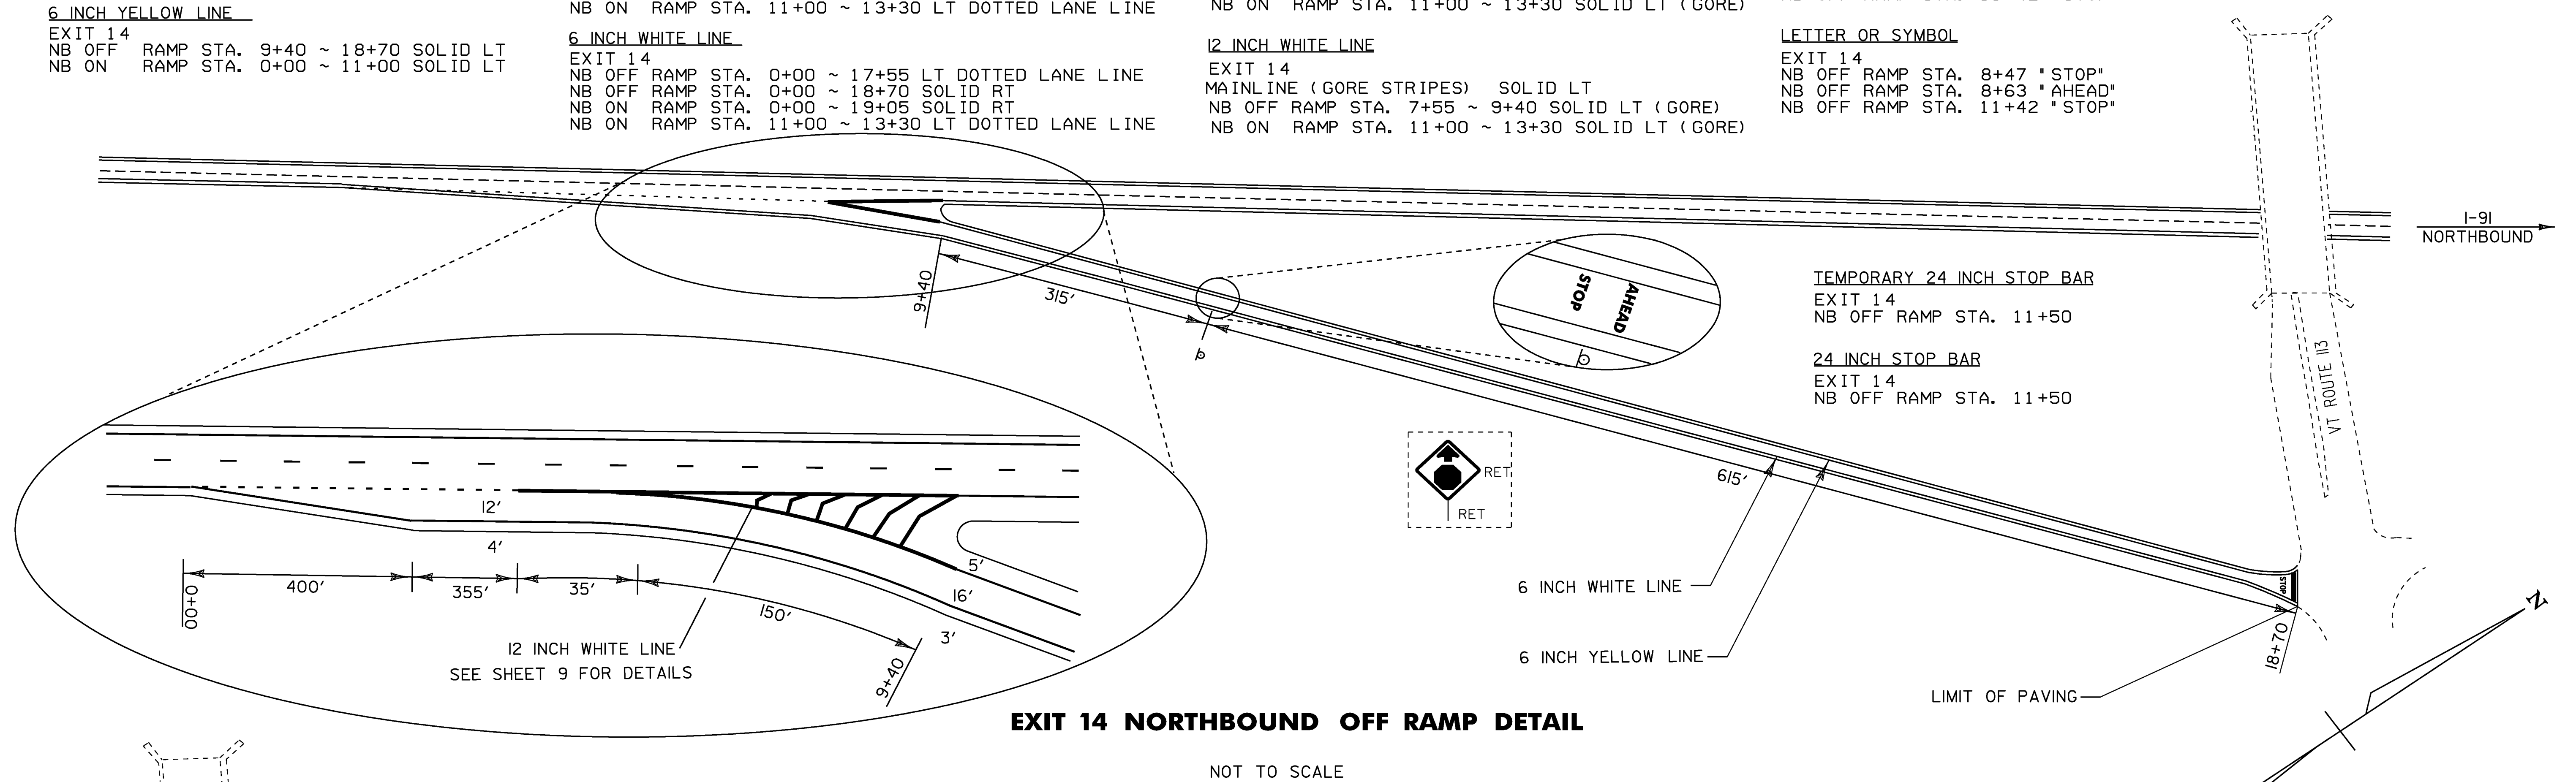

**EXIT 14 NORTHBOUND OFF RAMP DETAIL**

NOT TO SCALE

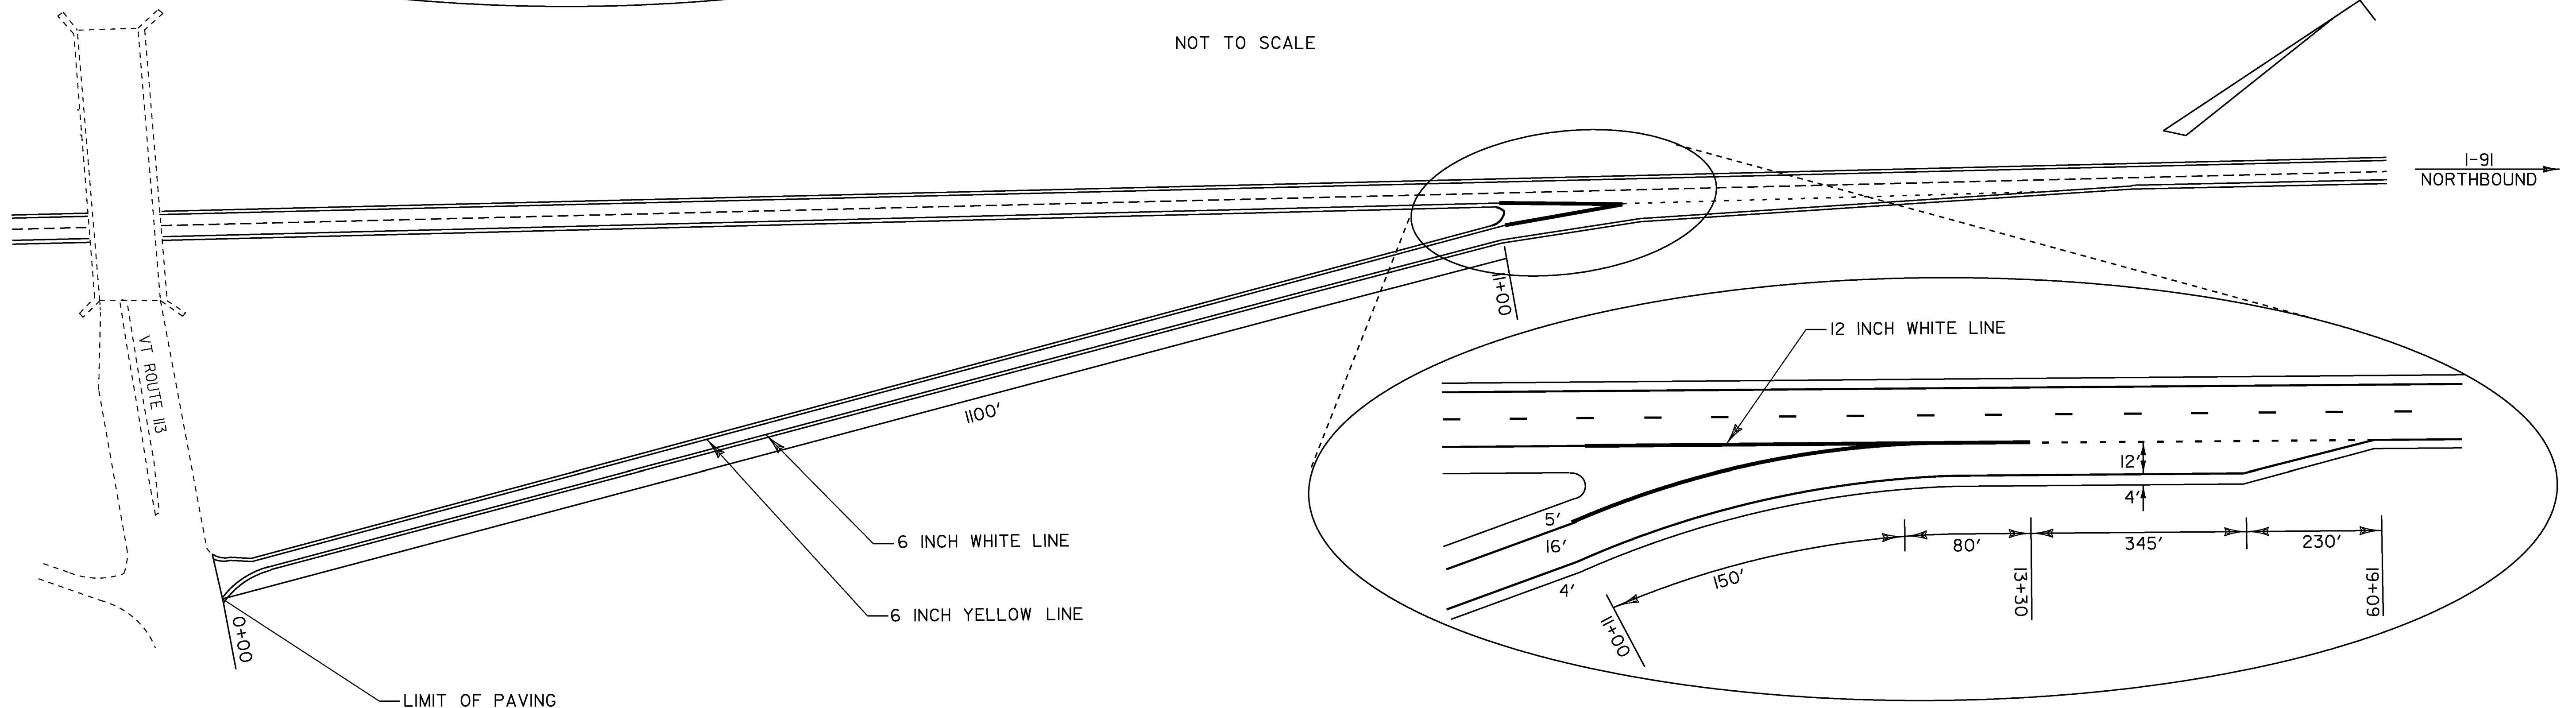

**EXIT 14 NORTHBOUND ON RAMP DETAIL**

SEE SHEET 9 FOR DETAILS

NOT TO SCALE

LEGEND

RET = RETAIN

**RAMP  
DETAILS  
2**

|                   |                        |              |             |
|-------------------|------------------------|--------------|-------------|
| PROJECT:          | NORWICH - FAIRLEE      | PROJECT NO.: | IM SURF(19) |
| DESIGN FILE NAME: | /pave/09a380/pa380.dgn | PLOT DATE:   | 22-APR-2010 |
| IPARM FILE NAME:  | p09a380*7.1            | SURVEY DATE: | 11/97       |
| SURVEYED BY:      | CLD Inc                | DRAWN BY:    | JLR         |
| SQUAD LEADER:     | M. FOWLER              | SHEET:       | 6 OF 11     |

DATUM  
VERTICAL \_\_\_\_\_  
HORIZONTAL \_\_\_\_\_