



TEMPORARY 6 INCH YELLOW LINE

EXIT 15
NB OFF RAMP STA. 6+75 ~ 15+70 SOLID LT
NB ON RAMP STA. 0+00 ~ 15+60 SOLID LT

6 INCH YELLOW LINE

EXIT 15
NB OFF RAMP STA. 6+75 ~ 15+70 SOLID LT
NB ON RAMP STA. 0+00 ~ 15+60 SOLID LT

TEMPORARY 6 INCH WHITE LINE

EXIT 15
NB OFF RAMP STA. 0+00 ~ 4+25 LT DOTTED LANE LINE
NB OFF RAMP STA. 0+00 ~ 15+70 SOLID RT
NB ON RAMP STA. 0+00 ~ 15+60 SOLID RT
NB ON RAMP STA. 8+95 ~ 15+60 RT DOTTED LANE LINE

6 INCH WHITE LINE

EXIT 15
NB OFF RAMP STA. 0+00 ~ 4+25 LT DOTTED LANE LINE
NB OFF RAMP STA. 0+00 ~ 15+70 SOLID RT
NB ON RAMP STA. 0+00 ~ 15+60 SOLID RT
NB ON RAMP STA. 8+95 ~ 15+60 RT DOTTED LANE LINE

TEMPORARY 12 INCH WHITE LINE

EXIT 15
MAINLINE (GORE STRIPES) SOLID LT
NB OFF RAMP STA. 4+65 ~ 6+75 SOLID LT
NB ON RAMP STA. 4+50 ~ 8+95 SOLID LT

12 INCH WHITE LINE

EXIT 15
MAINLINE (GORE STRIPES) SOLID LT
NB OFF RAMP STA. 4+65 ~ 6+75 SOLID LT
NB ON RAMP STA. 4+50 ~ 8+95 SOLID LT

TEMPORARY LETTER OR SYMBOL

EXIT 15
NB OFF RAMP STA. 10+42 - "STOP"
NB OFF RAMP STA. 10+58 - "AHEAD"
NB OFF RAMP STA. 15+56 - "STOP"

LETTER OR SYMBOL


EXIT 15
NB OFF RAMP STA. 10+42 - "STOP"
NB OFF RAMP STA. 10+58 - "AHEAD"
NB OFF RAMP STA. 15+56 - "STOP"

TEMPORARY 24 INCH STOP BAR

EXIT 15
NB OFF RAMP STA. 15+62

24 INCH STOP BAR


EXIT 15
NB OFF RAMP STA. 15+62

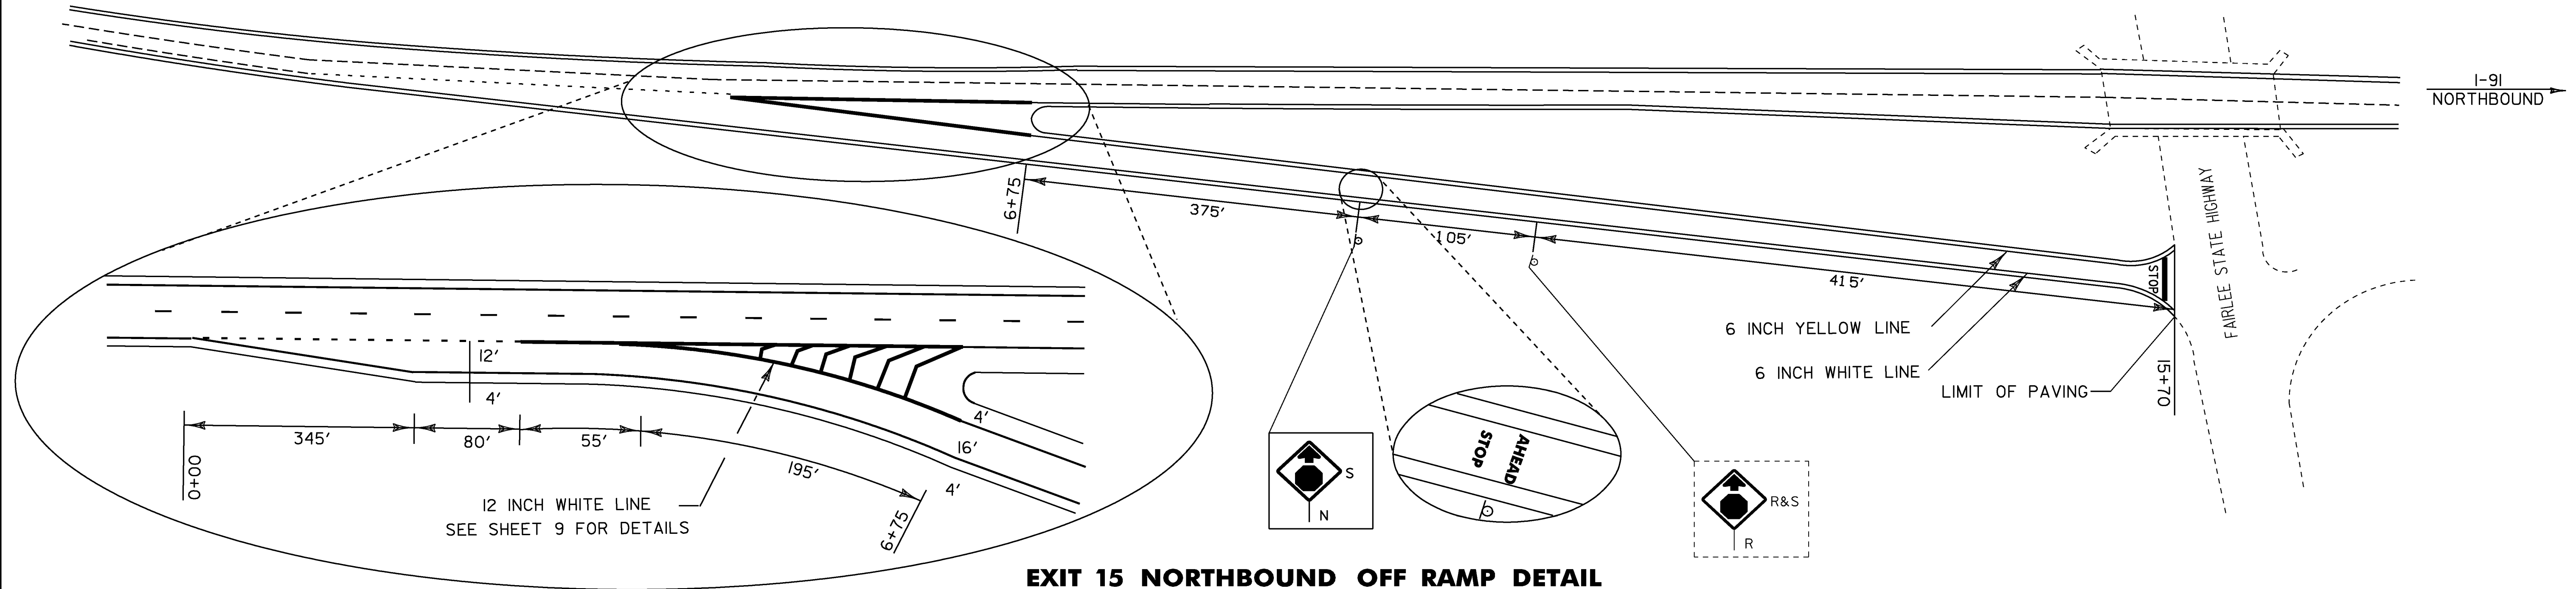

EXIT 15 NORTHBOUND OFF RAMP DETAIL

SEE SHEET 9 FOR DETAILS

NOT TO SCALE

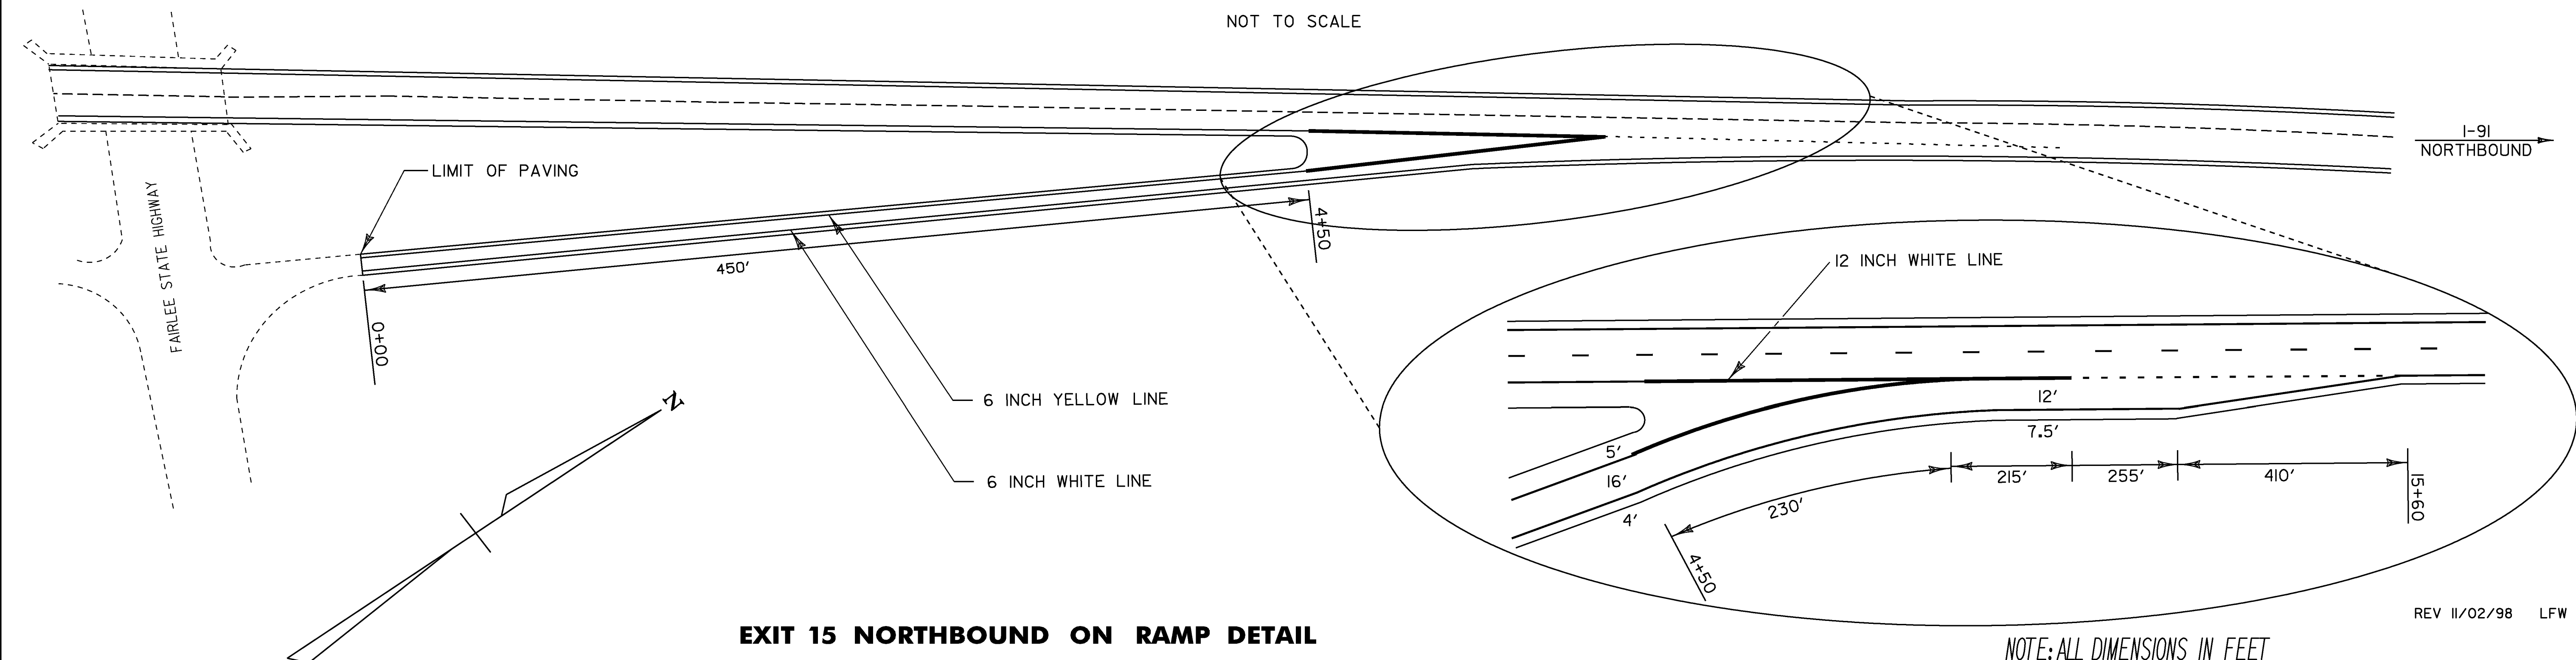

EXIT 15 NORTHBOUND ON RAMP DETAIL

SEE SHEET 9 FOR DETAILS

NOT TO SCALE

NOTE: ALL DIMENSIONS IN FEET

REV 11/02/98 LFW

DATUM
VERTICAL _____
HORIZONTAL _____

LEGEND

RET = RETAIN
S = SALVAGE
R&S = REMOVE & SALVAGE
N = NEW

**RAMP
DETAILS
3**

PROJECT:

NORWICH - FAIRLEE

PROJECT NO.:

IM SURF(19)

DESIGN FILE NAME: /pave/09a380/p09a380.dgn

IPARM FILE NAME: p09a380*8.1

SURVEYED BY: CLD Inc

SQUAD LEADER: M. FOWLER

PLOT DATE: 22-APR-2010

SURVEY DATE: 11/97

DRAWN BY: JLR

SHEET: 7 OF 11