

STATE OF VERMONT
AGENCY OF TRANSPORTATION




PROPOSED IMPROVEMENT
BRIDGE PROJECT

TOWN OF RICHMOND
COUNTY OF CHITTENDEN
BRIDGE NO. 57 N&S ON I-89

PROJECT LOCATION: BRIDGE NO. 57 N&S LOCATED ON I-89 OVER NECR, VERBURG ROAD AND BROOK.

PROJECT DESCRIPTION: THIS PROJECT INVOLVES CLEANING AND REPAINTING THE EXISTING STEEL SUPERSTRUCTURE MEMBERS AND MINOR ASSOCIATED WORK.

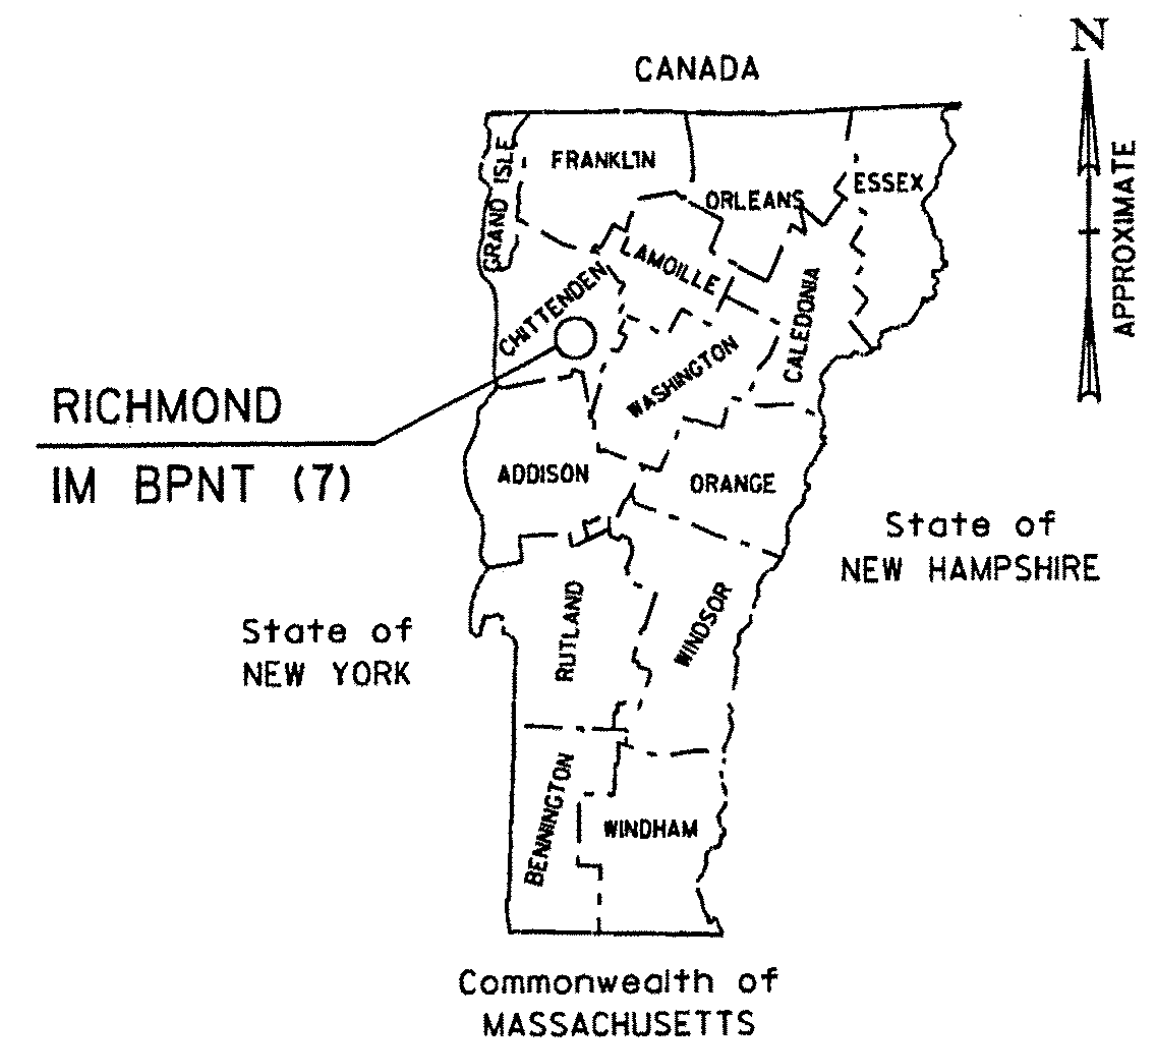

LOCATION MAP
NOT TO SCALE

INDEX OF SHEETS

- 1 TITLE SHEET
- 2 QUANTITY SHEET
- 3 PROJECT NOTES & STANDARD DETAILS
- 4-6 TRAFFIC CONTROL SHEETS
- 7-10 REFERENCE SHEETS - BRIDGE 57
- 11-14 REFERENCE SHEETS - STANDARDS
- 15 REFERENCE SHEET - BRIDGE 57 RIGHT OF WAY

STANDARD SHEETS

E-100	CONSTRUCTION APPROACH SIGNS	01/02/04
E-100A	SIDE ROAD CONSTRUCTION-APPROACH SIGNS	01/02/04
E-101	CONSTRUCTION SIGN DETAILS	05/30/03
E-102	CONSTRUCTION SIGN DETAILS	06/30/03
E-102A	CONSTRUCTION SIGN DETAILS	05/01/04
E-103	MAINLINE TRAFFIC CONTROL DIVIDED HIGHWAY ONE LANE CLOSED	03/01/04
E-106	TRAFFIC CONTROL-MISCELLANEOUS DETAILS	03/01/04
E-107	DELINEATION, BARRICADES AND DETOURS FOR CONSTRUCTION AREAS	06/30/03
E-107A	BREAKAWAY BARRICADE DETAILS	06/08/09

RECORD PLANS

CONTRACTOR: ATSAJIS BROTHERS PAINTING CO.-WARREN, MI

RESIDENT ENGINEER: SCOTT WHEATLEY

CONSTRUCTION BEGAN: AUGUST 23, 2010

CONSTRUCTION COMPLETE: MARCH 16, 2012

RECORD PLANS BY: SCOTT WHEATLEY

I HEREBY CERTIFY THAT ALL THE CONSTRUCTION REQUIRED BY THIS SET OF DRAWINGS HAS BEEN ACCOMPLISHED AS INDICATED HEREIN.

BY Scott Wheatley RESIDENT ENGINEER

DATE Aug 23, 2012

NOTE: Any further information concerning final quantities, amounts or other details relative to this project may be found at Central Files in the electronic archives.


QUALITY ASSURANCE PROGRAM: LEVEL

CONVENTIONAL SYMBOLS


COUNTY LINE	
TOWN LINE	
LIMITS OF ACCESS	
POINT OF ACCESS	
FENCE LINE	
STONE WALL	
TRAVELED WAY	
GUARD RAIL	
RAILROAD	
SURVEY LINE	
CULVERT	
POWER POLE	
TELEPHONE POLE	
TREES	
CONTROL OF ACCESS	
PROPERTY LINE	
R.O.W. TAKING LINE	
SLOPE RIGHTS	
TOP OF CUT	
TOE OF SLOPE	

DATUM

VERTICAL N/A
HORIZONTAL N/A

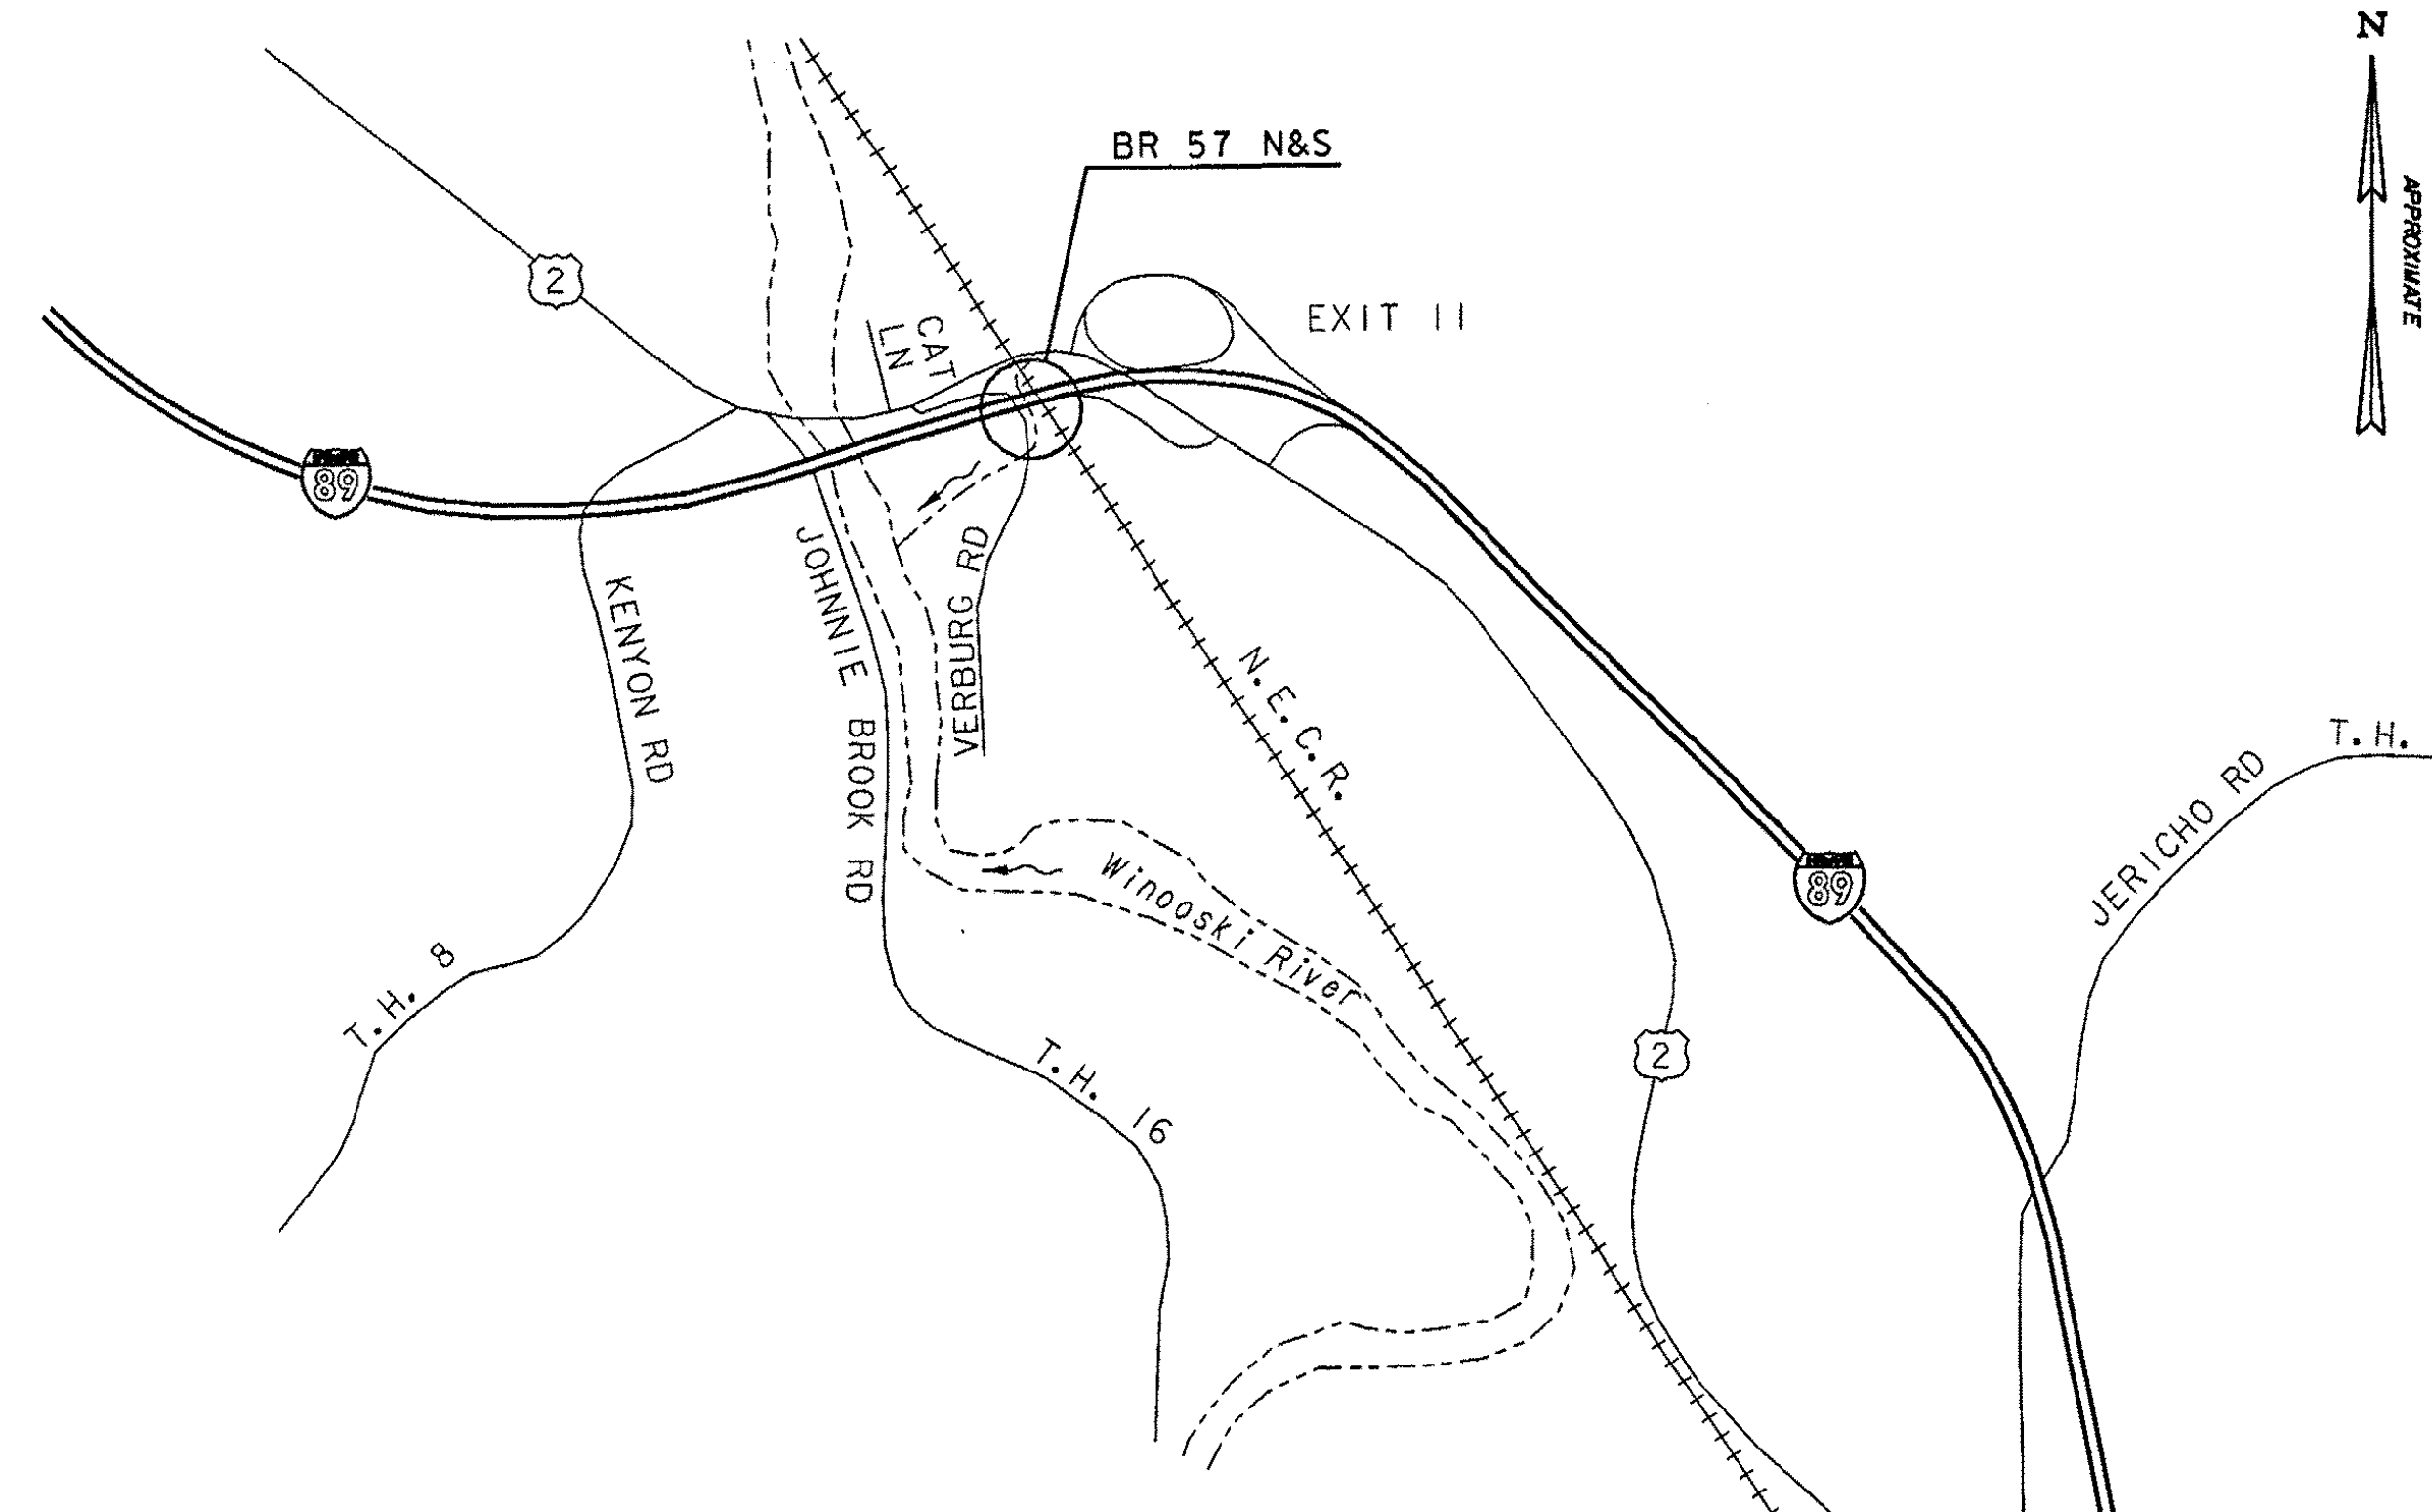

PLAN
NOT TO SCALE

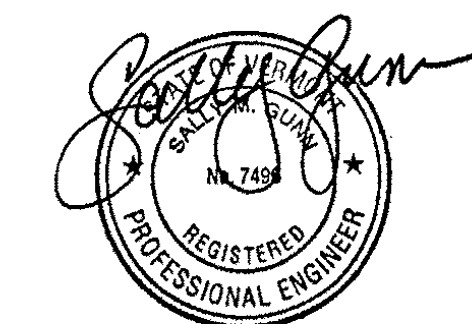

THESE PLANS ARE SUBJECT TO SUCH ENGINEERING CHANGES AS MAY BE REQUIRED BY THE FEDERAL HIGHWAY ADMINISTRATION OR THE DIRECTOR OF PROGRAM DEVELOPMENT. CONSTRUCTION IS TO BE CARRIED ON IN ACCORDANCE WITH THESE PLANS AND THE STANDARD SPECIFICATIONS FOR CONSTRUCTION DATED 2006, AS APPROVED BY THE FEDERAL HIGHWAY ADMINISTRATION ON JUNE 15, 2006 FOR USE ON THIS PROJECT, INCLUDING ALL SUBSEQUENT REVISIONS AND SUCH REVISED SPECIFICATIONS AND SPECIAL PROVISIONS AS ARE INCORPORATED IN THESE PLANS.



DIRECTOR OF PROGRAM DEVELOPMENT

APPROVED Richard F. Sargent DATE 4/11/11

PROJECT MANAGER: MARK SARGENT, P.E.

PROJECT NAME: RICHMOND

PROJECT NUMBER: IM BPNT (7)

SHEET 1 OF 15 SHEETS