

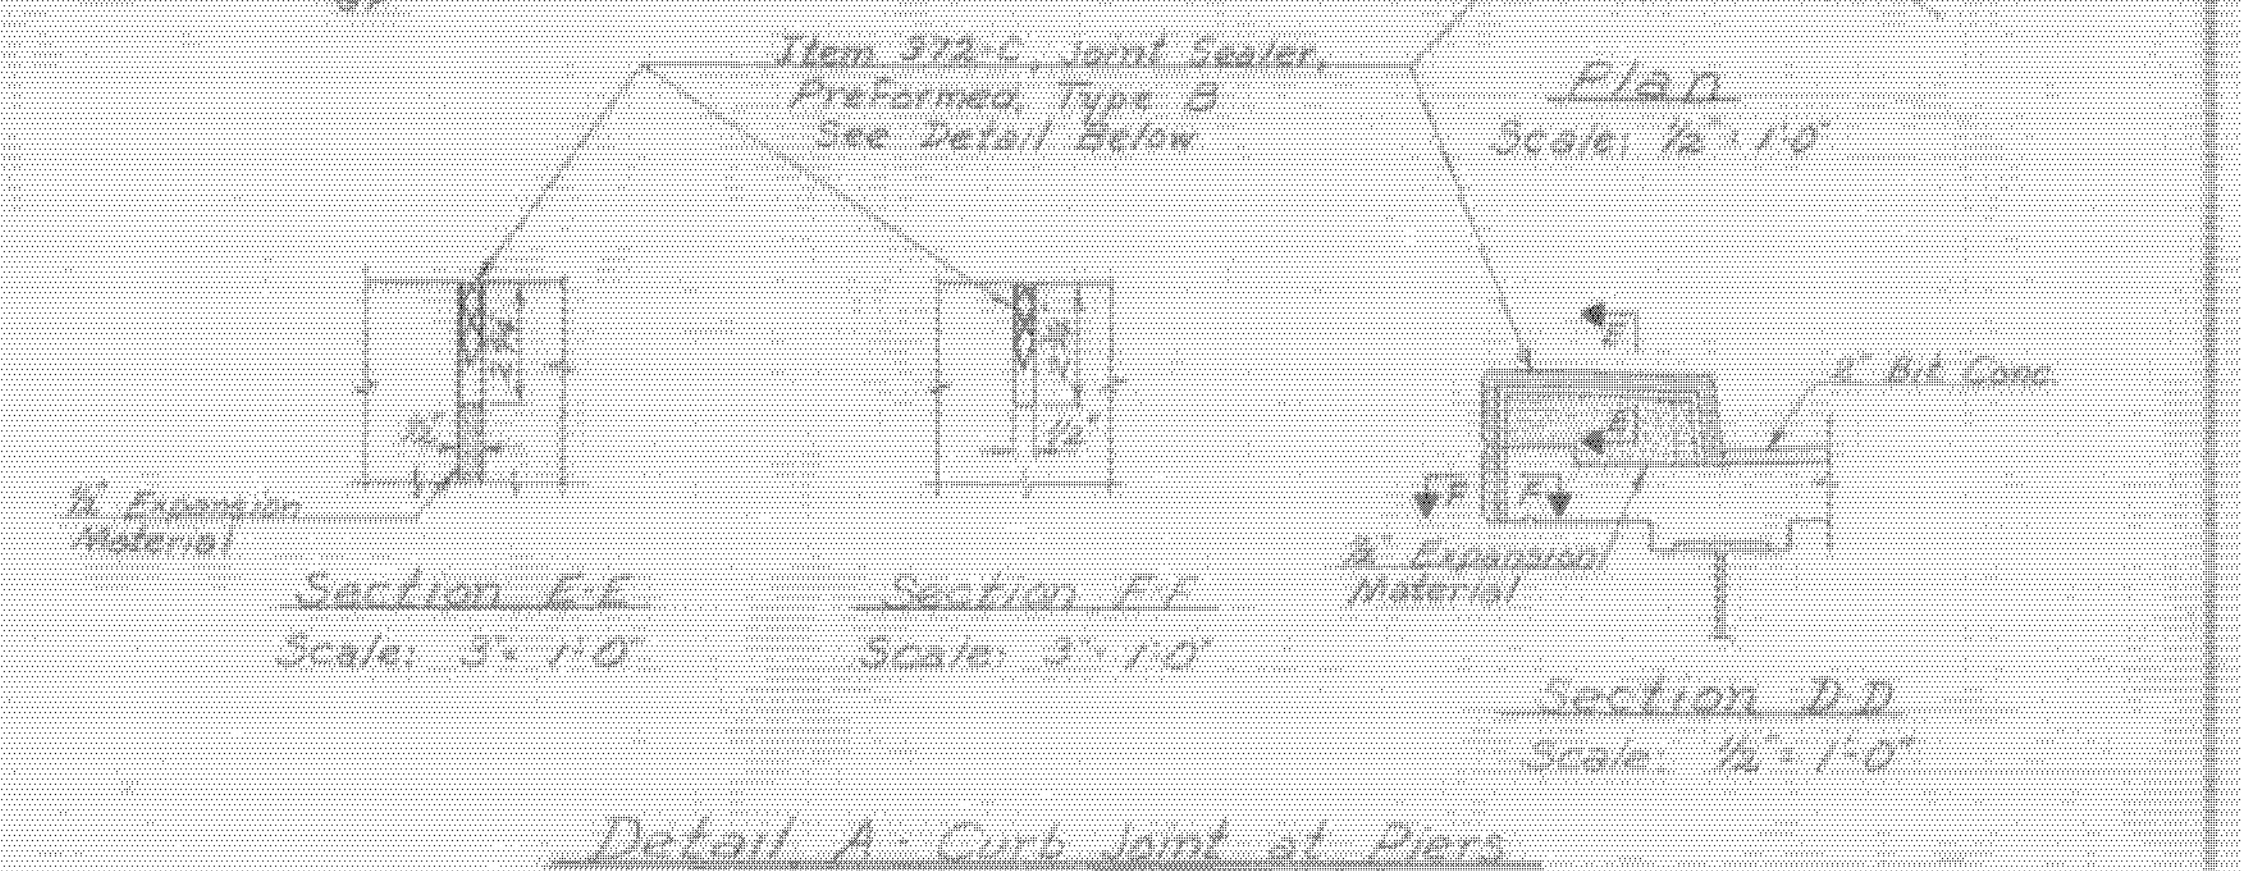
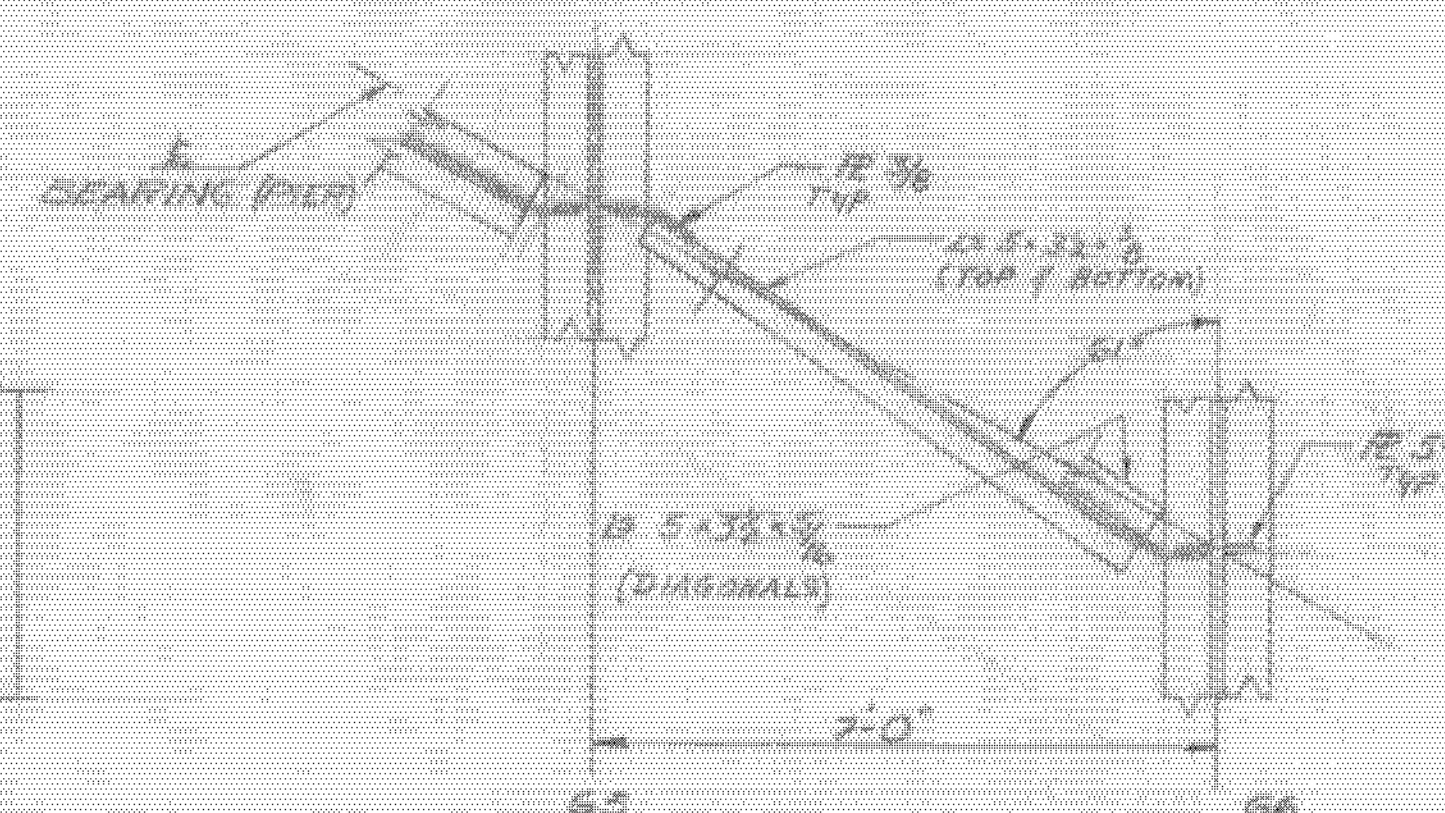
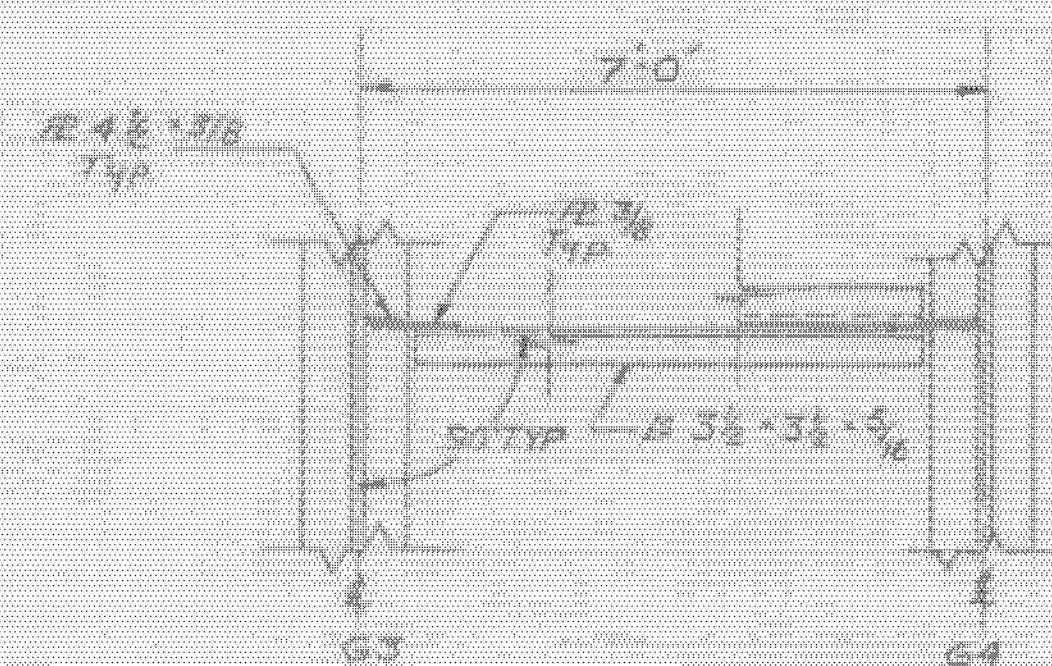
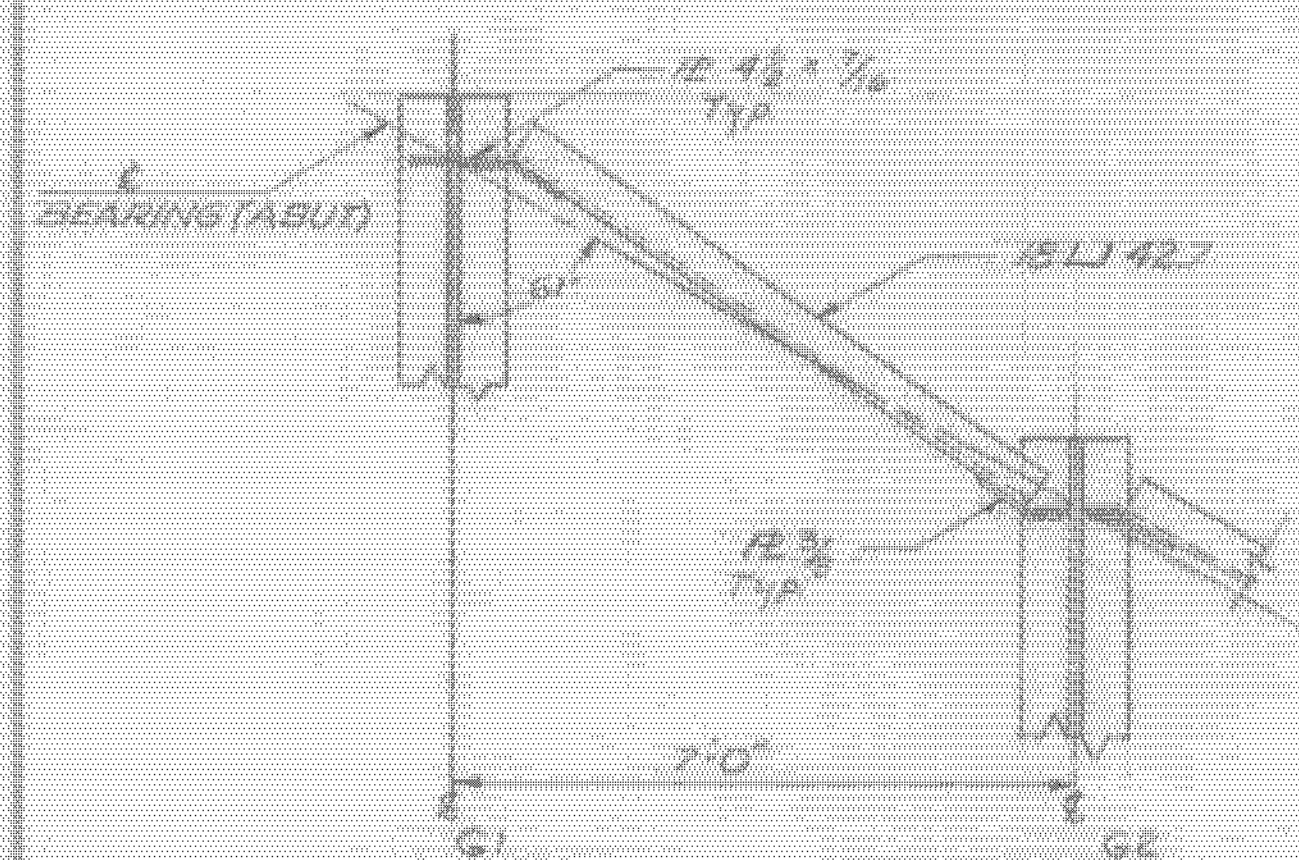
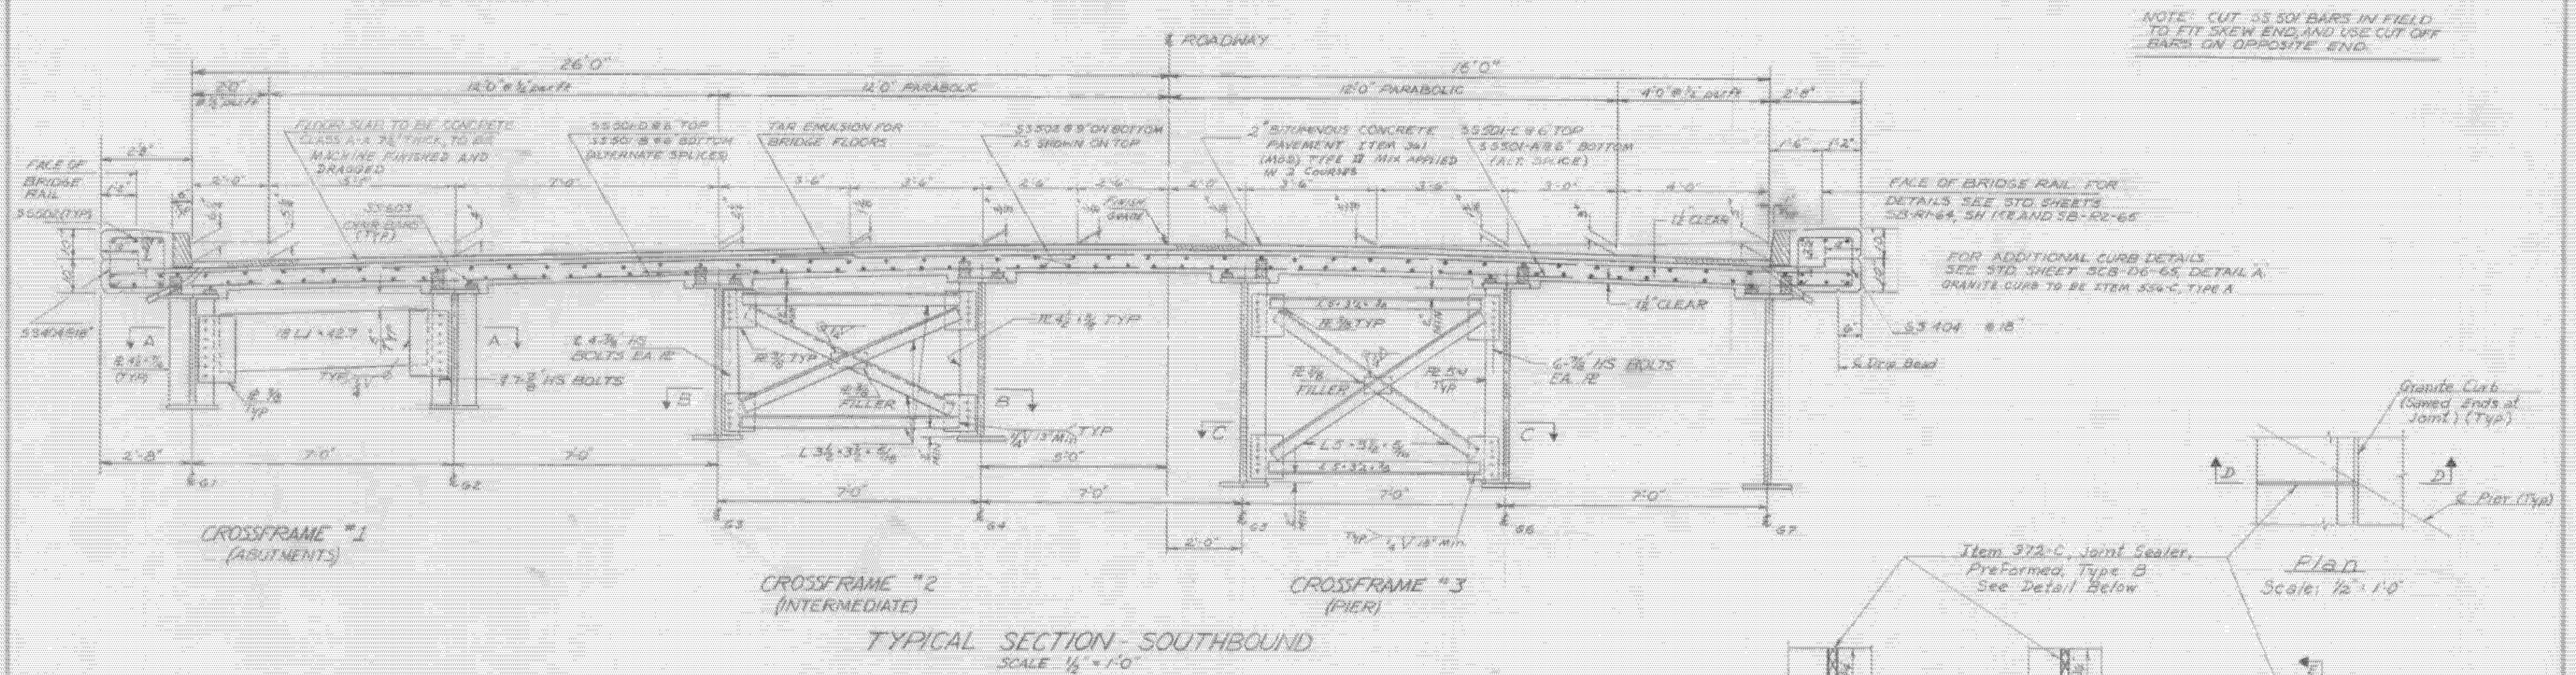


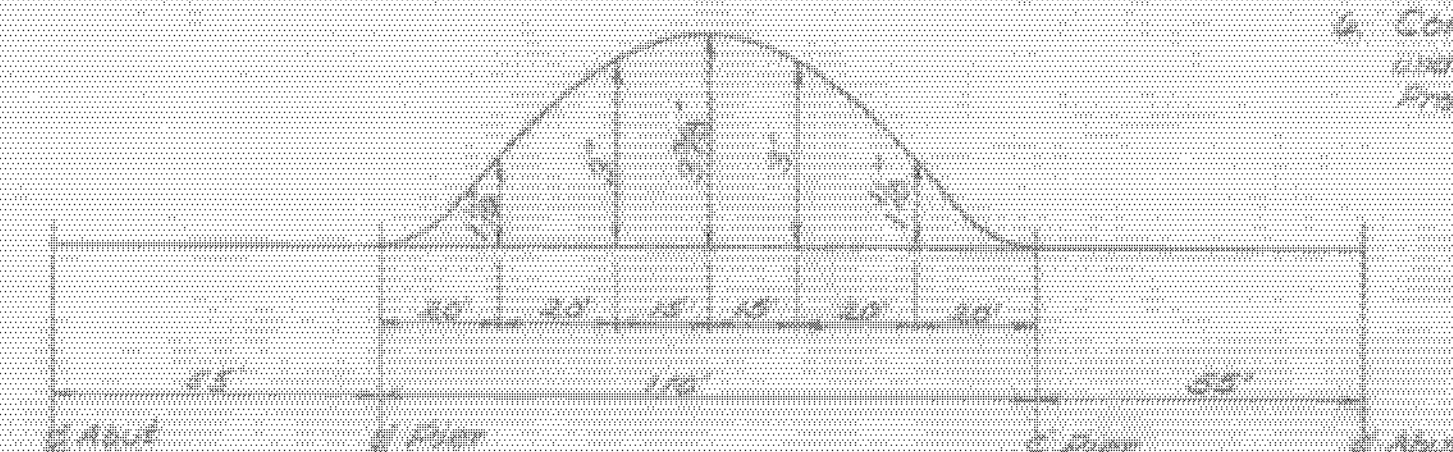

- ### Notes
1. For General Notes see Br. 200
 2. All structural steel shall be ASTM A 36-62T unless otherwise noted on the plans.
 3. All field connections shall be made with "A" High Strength bolts in $\frac{3}{4}$ " ϕ holes unless otherwise noted on the plans.
 4. All girders shall be cambered as indicated in Camber Diagram below.
 5. For limits of Water Repellent Item 440, see Br. 201
 6. Concrete Floor Slab is to be finished as specified under Item 401.05, Subarticle I, of the Special Provisions.

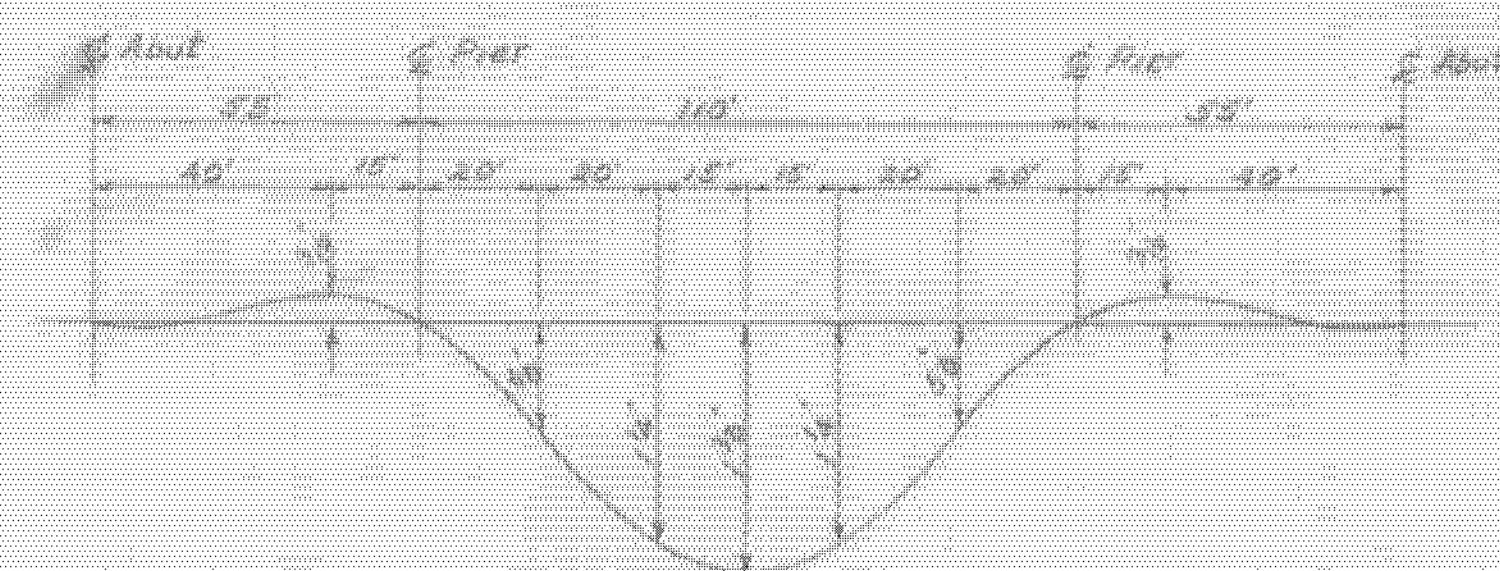

WESTMINSTER-NORWICH
IM BPNT (8)
SHEET 32 OF 58
BRIDGE 48

FOR REFERENCE ONLY

STATE OF VERMONT
DEPARTMENT OF HIGHWAYS

PROJECT TOWN OF NORWICH
TOWN OF NORWICH SR 4B
ROUTE NO. I-91 STA. 3975+50.1
I-91 OVER VT R/A
SB SECTION AND GINER DETAILS
SCALE: AS SHOWN
IN CHARGE R. Gossley
DESIGNED
DRAWN BY D. TRAP CHECKED BY D. Gossley
Reviewed
PROJECT NO. 191-260
SHEET 14 OF 20 SR 206