



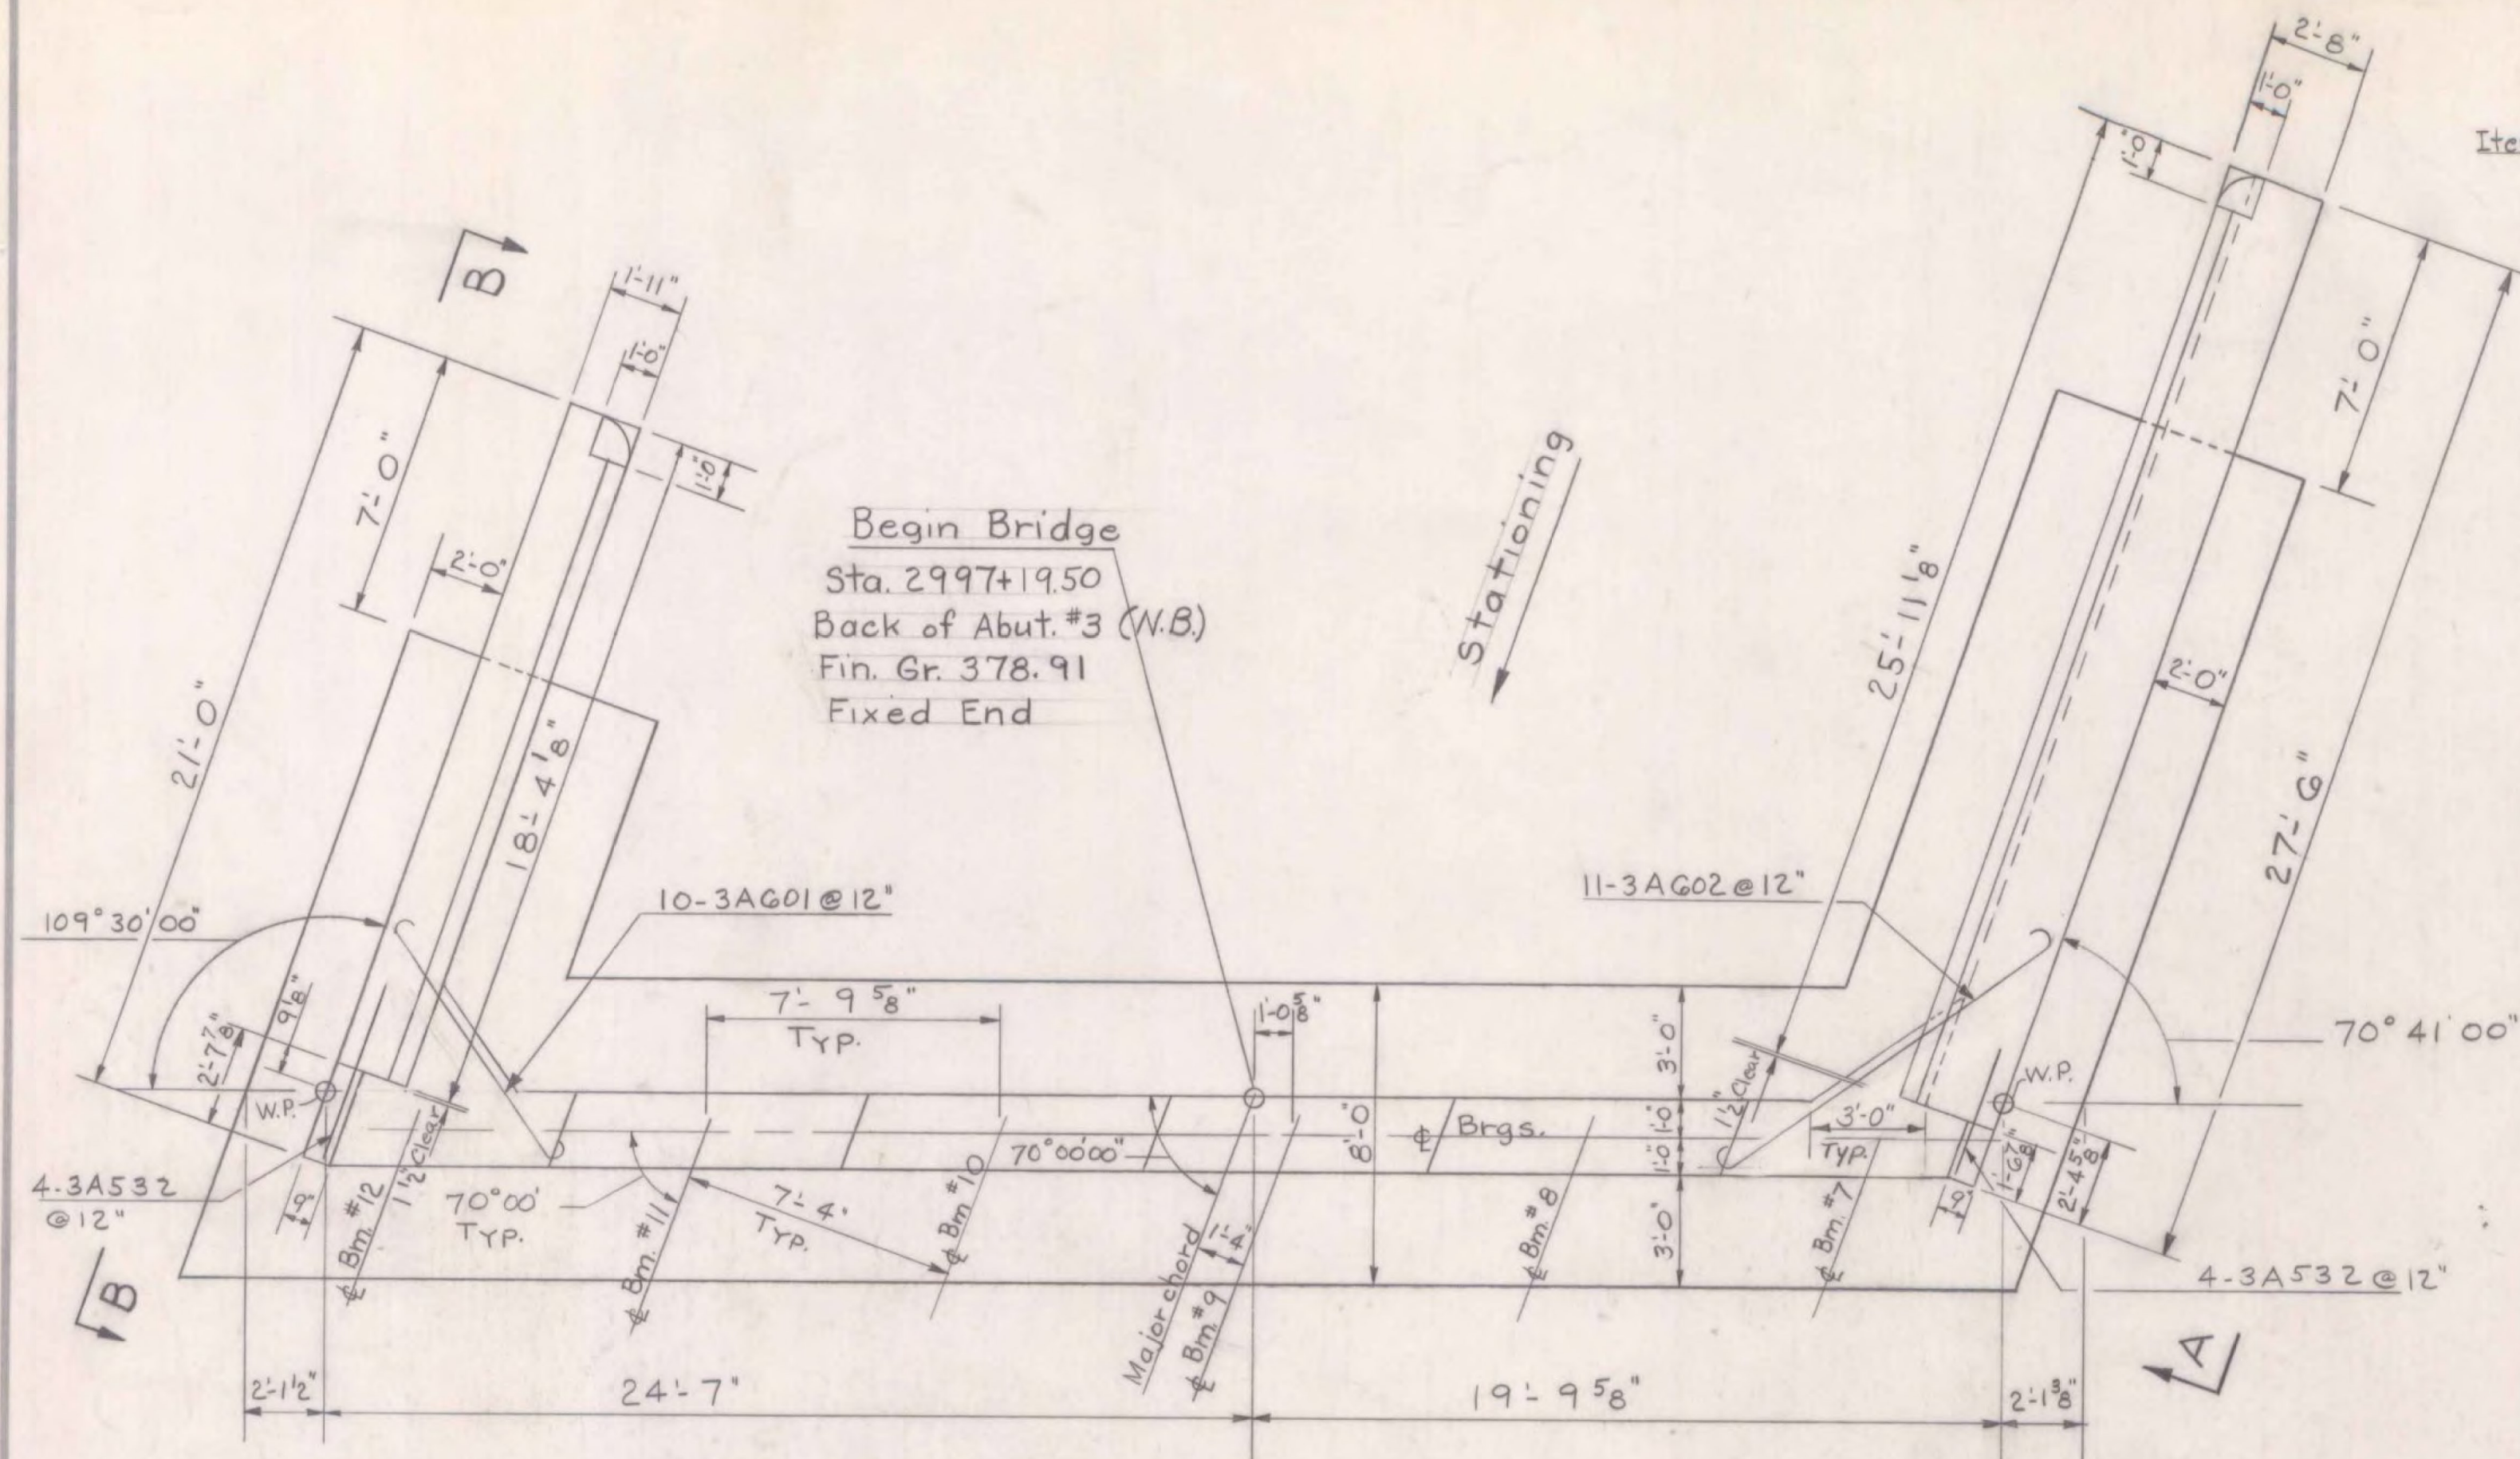


Plan

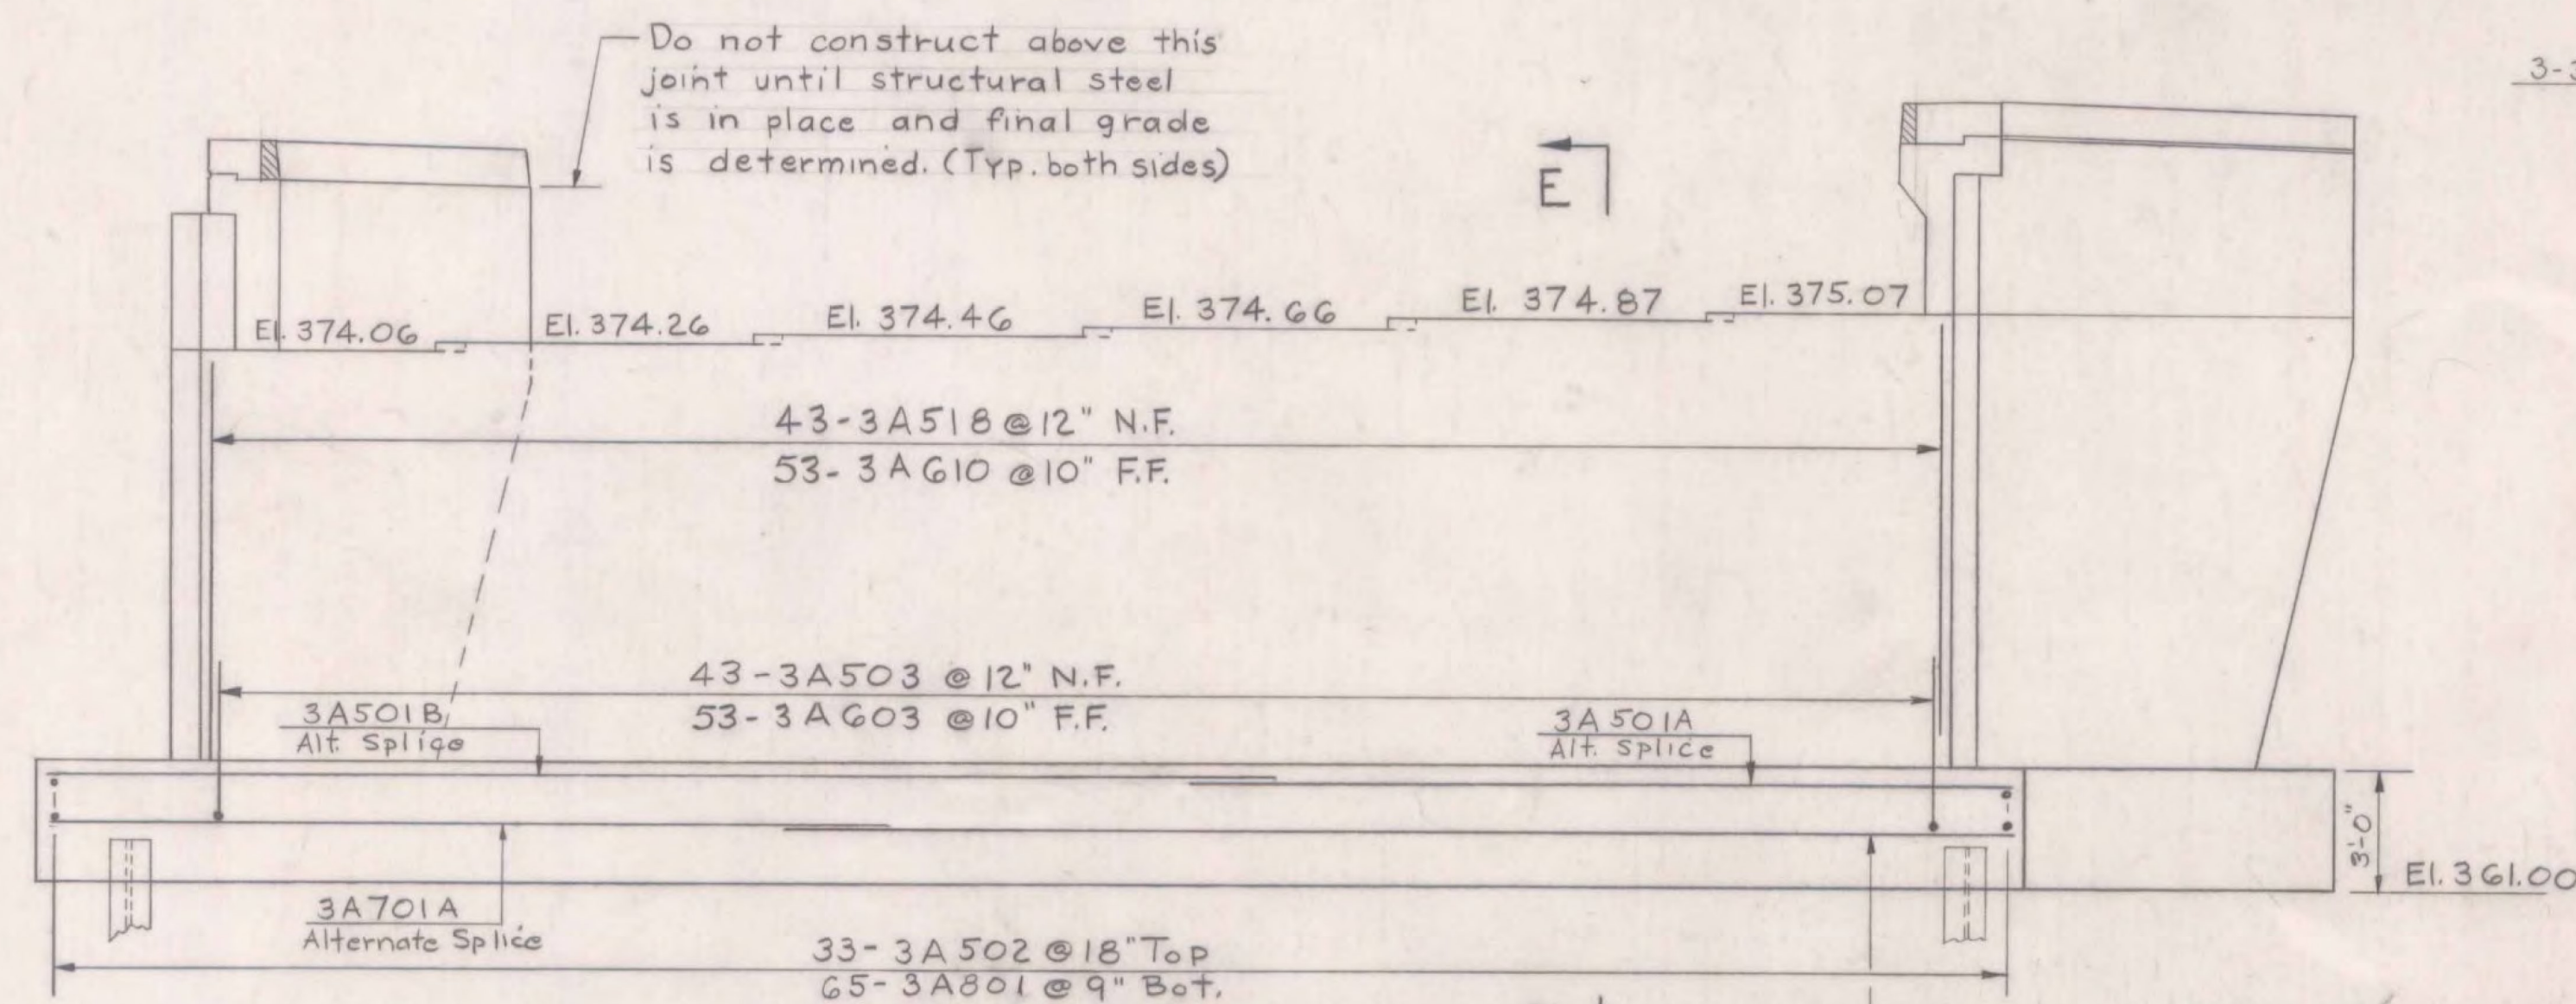


Elevation

No. of Piles	Size	Estimated Length of Piles	Splices Allowed for Piles not Exceeding Plan Length (to be paid for only if used.)	Splices Estimated for Piles Exceeding Plan Length (to be paid for only if used.)
21	12BP53	35		5

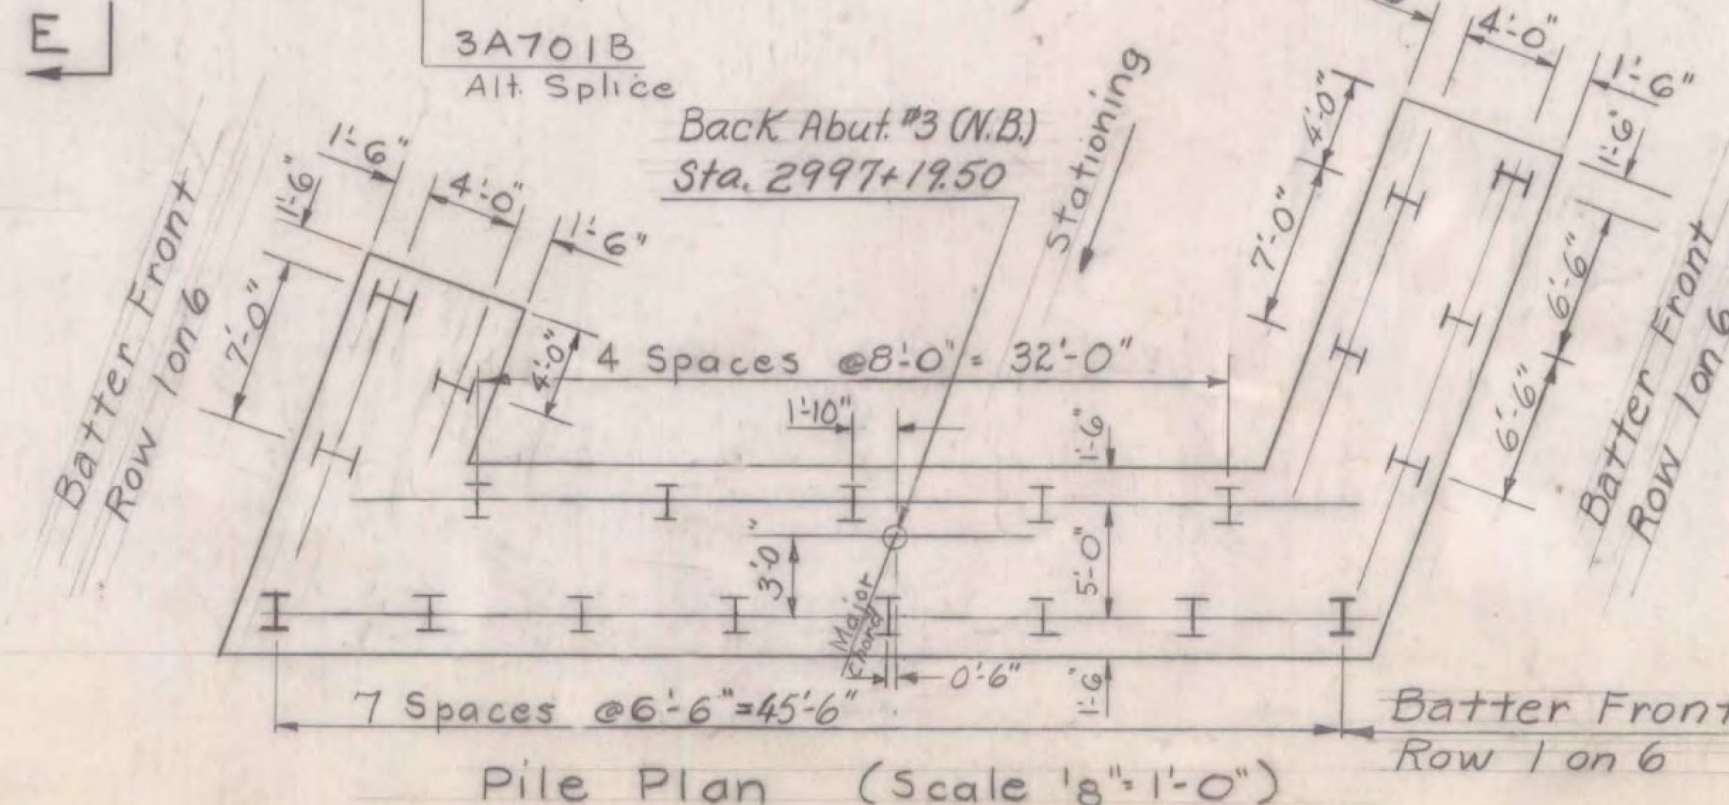


Pile Plan (Scale 1/8"=1'-0")

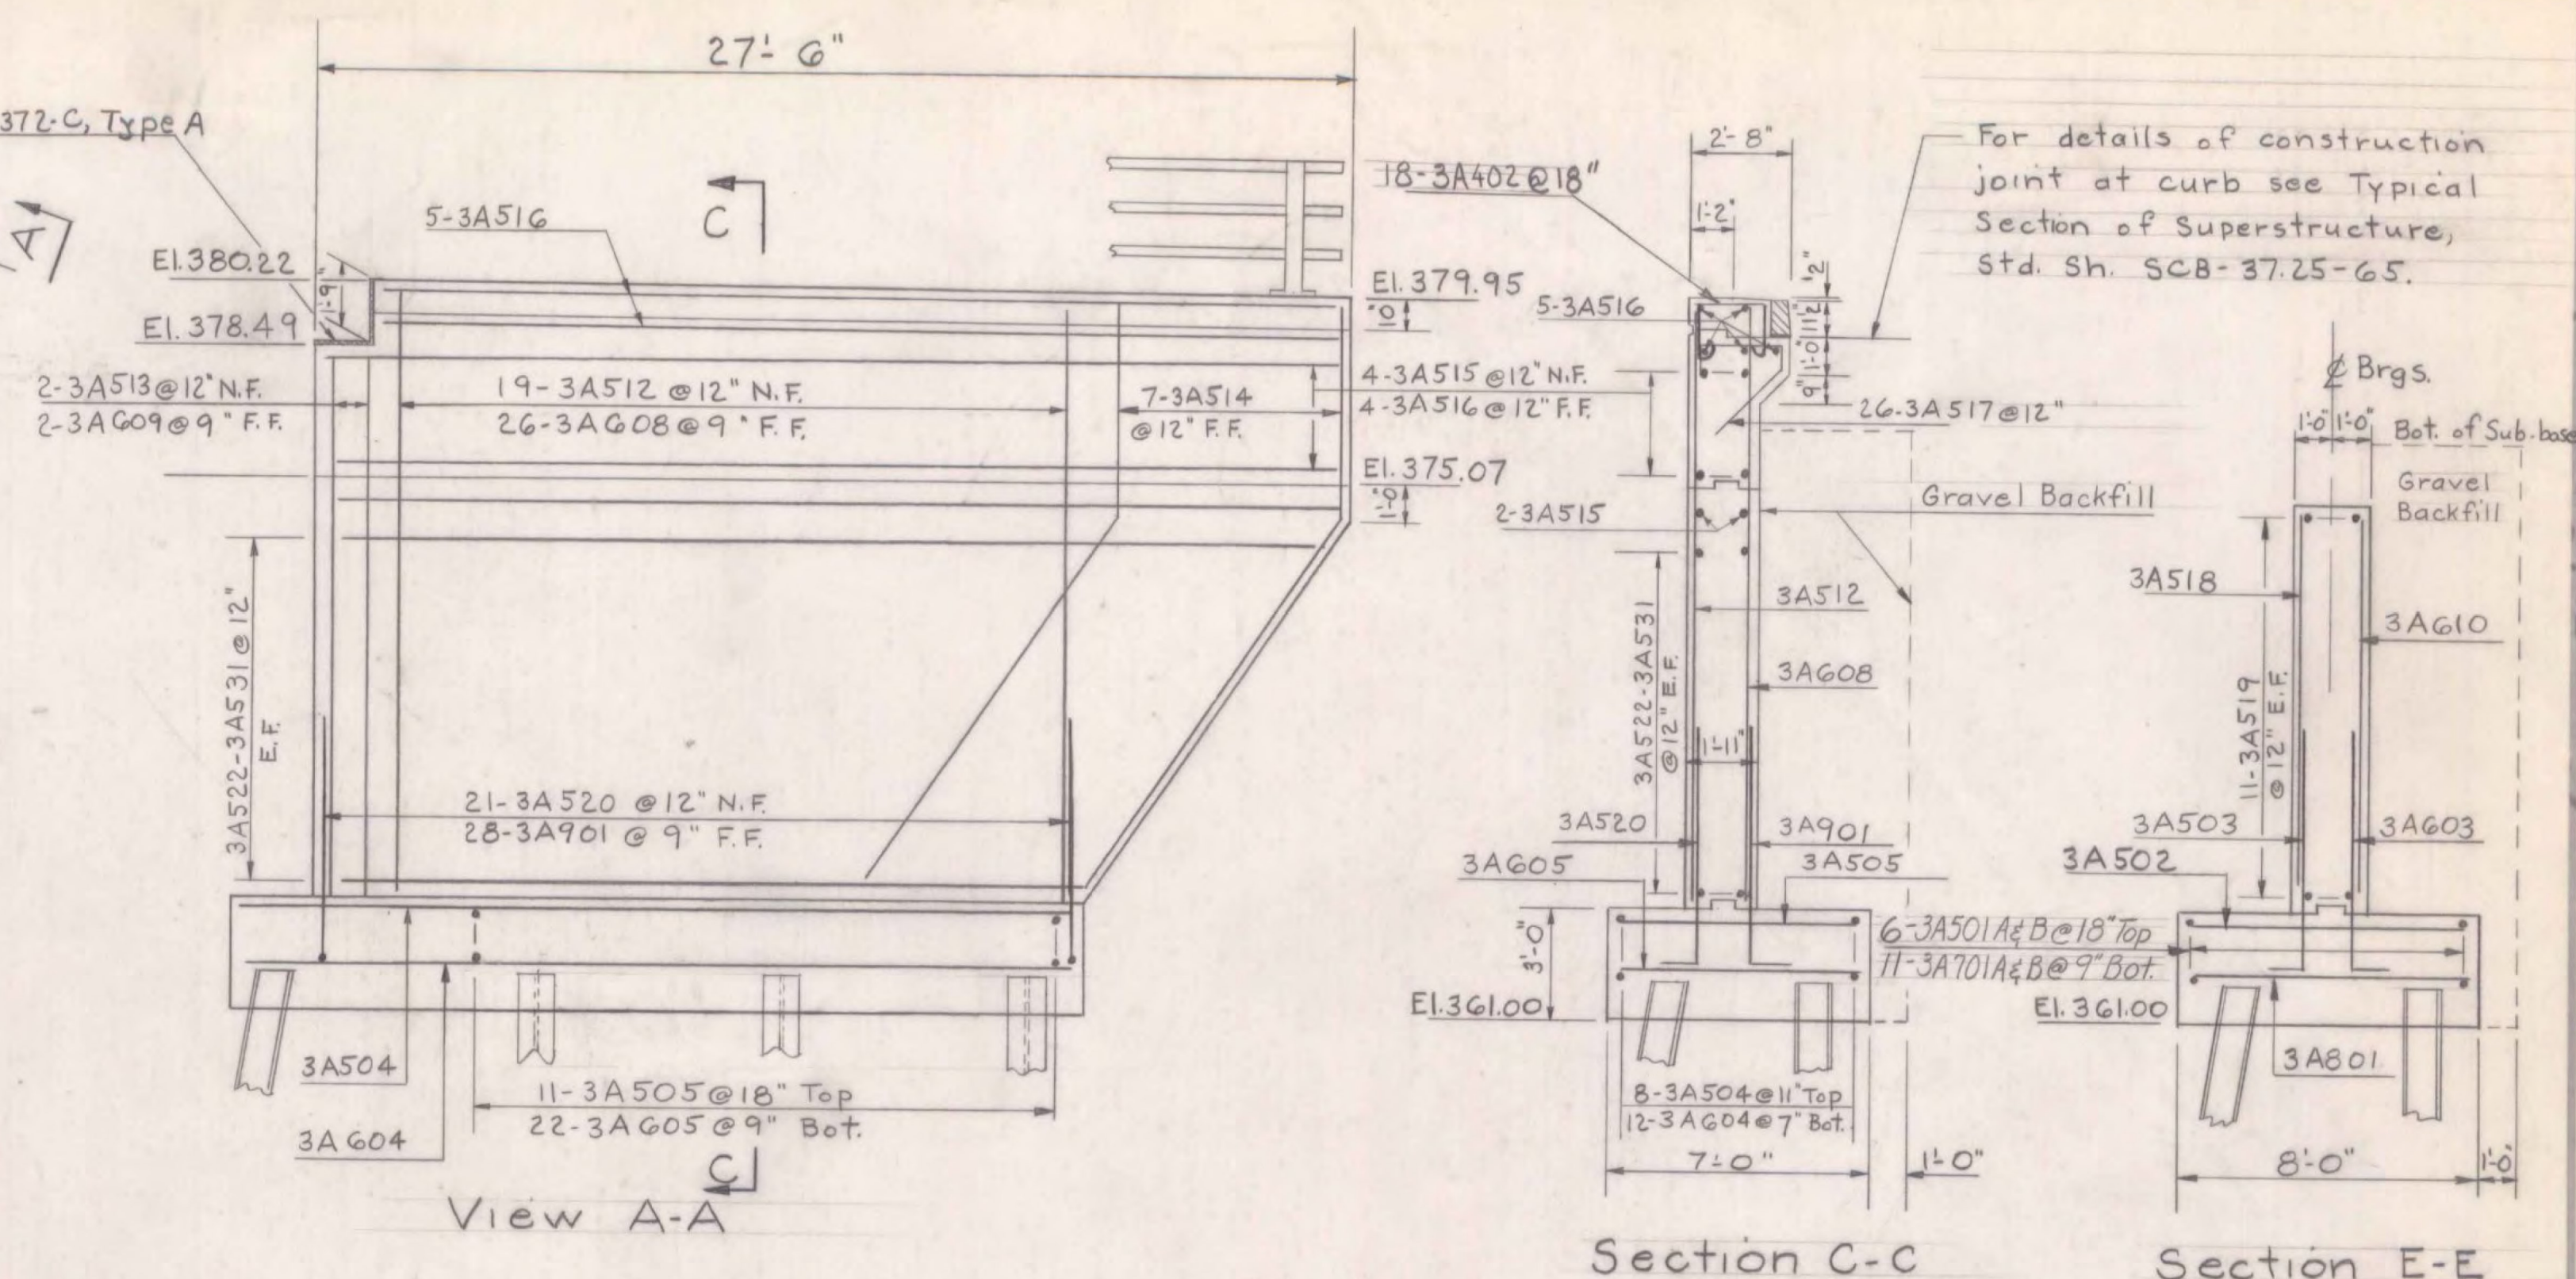

View A-A

Section C-C

Section E-E

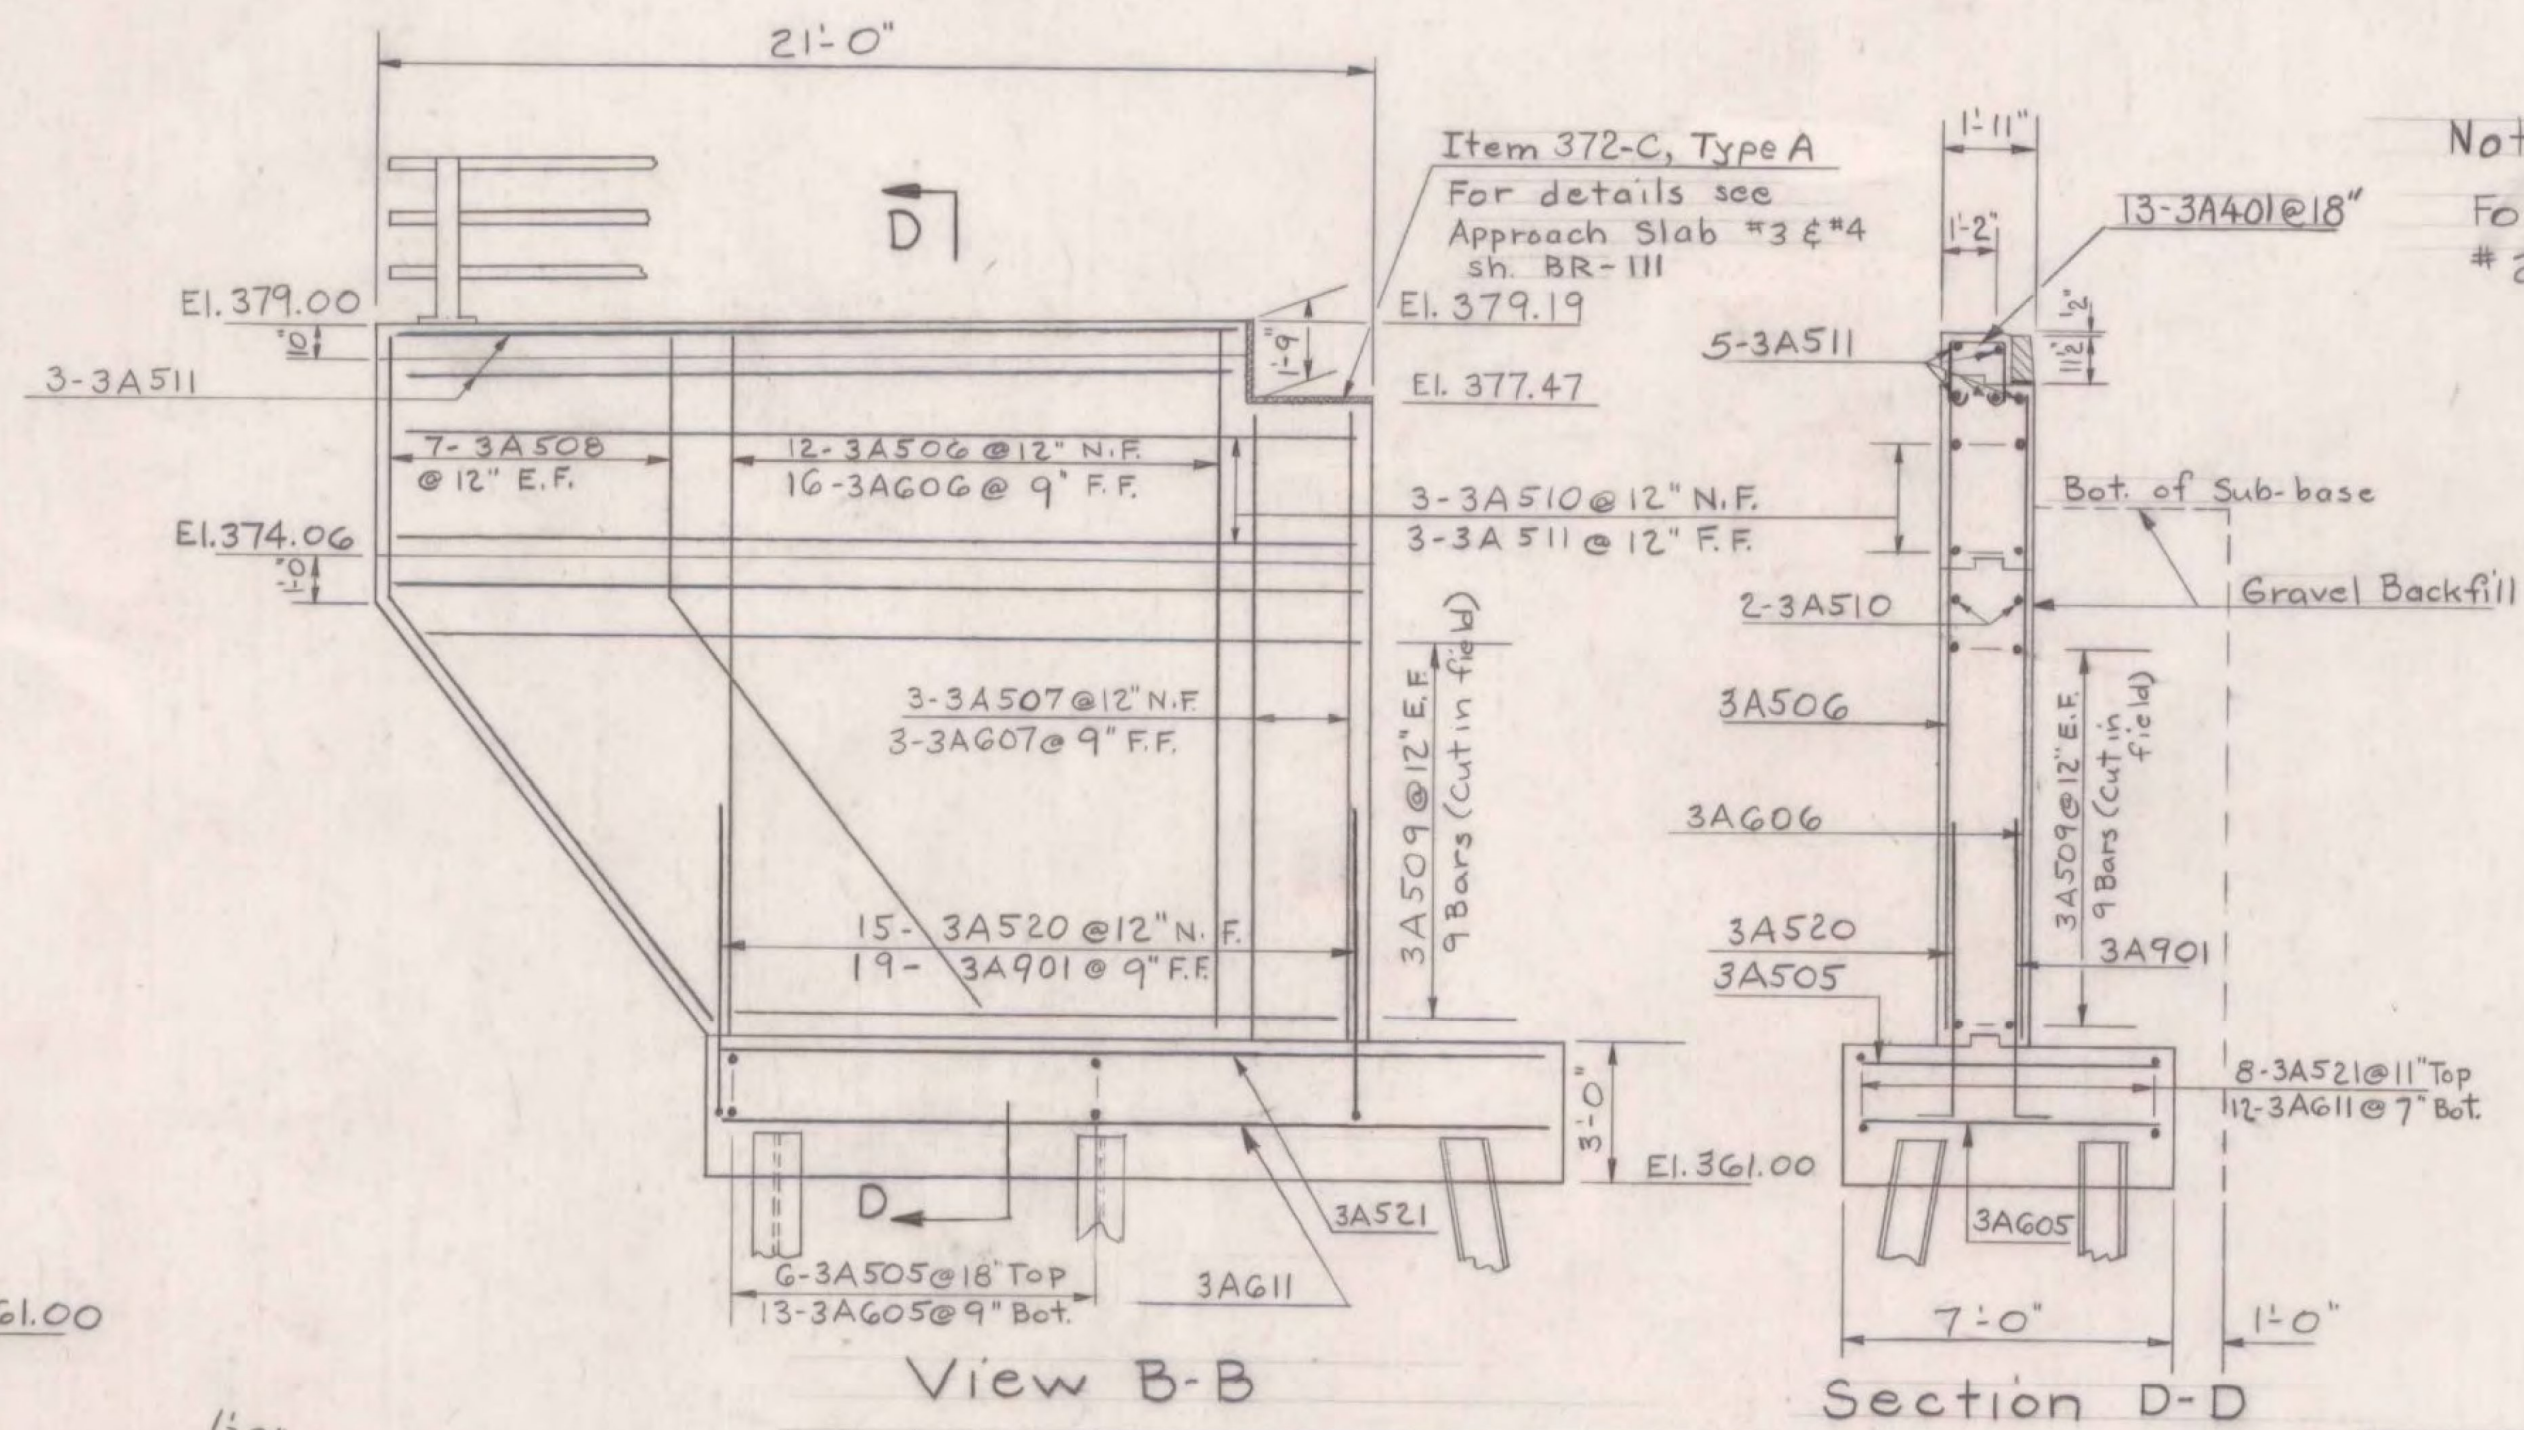

View B-B

Section D-D

Note:
For Abutment Notes see Abut. #2 (S.B.) Sh. BR-107.

E.F. Each Face
F.F. Far Face
N.F. Near Face

ITEM NO.	ITEM	UNIT	NET	TOTAL	FINAL
	CHAN. EXCAV. OF EARTH	C.Y.			
	CHAN. EXCAV. OF ROCK	C.Y.			
	UNCLASS. CHAN. EXCAV.	C.Y.			
	STRUCT. EXCAV.	C.Y.			
	CONC. CLASS AA (MOD.)	C.Y.			
	CONC. CLASS B (MOD.)	C.Y.			
	REINF. STEEL	LBS.			
	ASPHALTIC-ASB. COATING	S.Y.			
	TREATED TIMBER PILING	L.F.			
	SPLICES FOR STEEL PILING	EA.			
	STEEL PILING	L.F.			
	UNTREATED TIMBER PILING	L.F.			

WILLISTON - GEORGIA
IM MEMB(25)
SHEET 35 OF 38
BRIDGES 84 N AND S
FOR REFERENCE ONLY

STATE OF VERMONT
DEPARTMENT OF HIGHWAYS

TOWN OF Milton-Georgia
ROUTE No. I 89 LOG STA. I 89 over Town Road #6
Abutment #3 (N.B.)
SCALE 1/4"=1'-0" & as Noted
SURVEYED BY _____
DRAWN BY A.J.C. CHECKED BY J.W.
PROJECT No. I 89-3(39)
SHEET 66 OF 278