
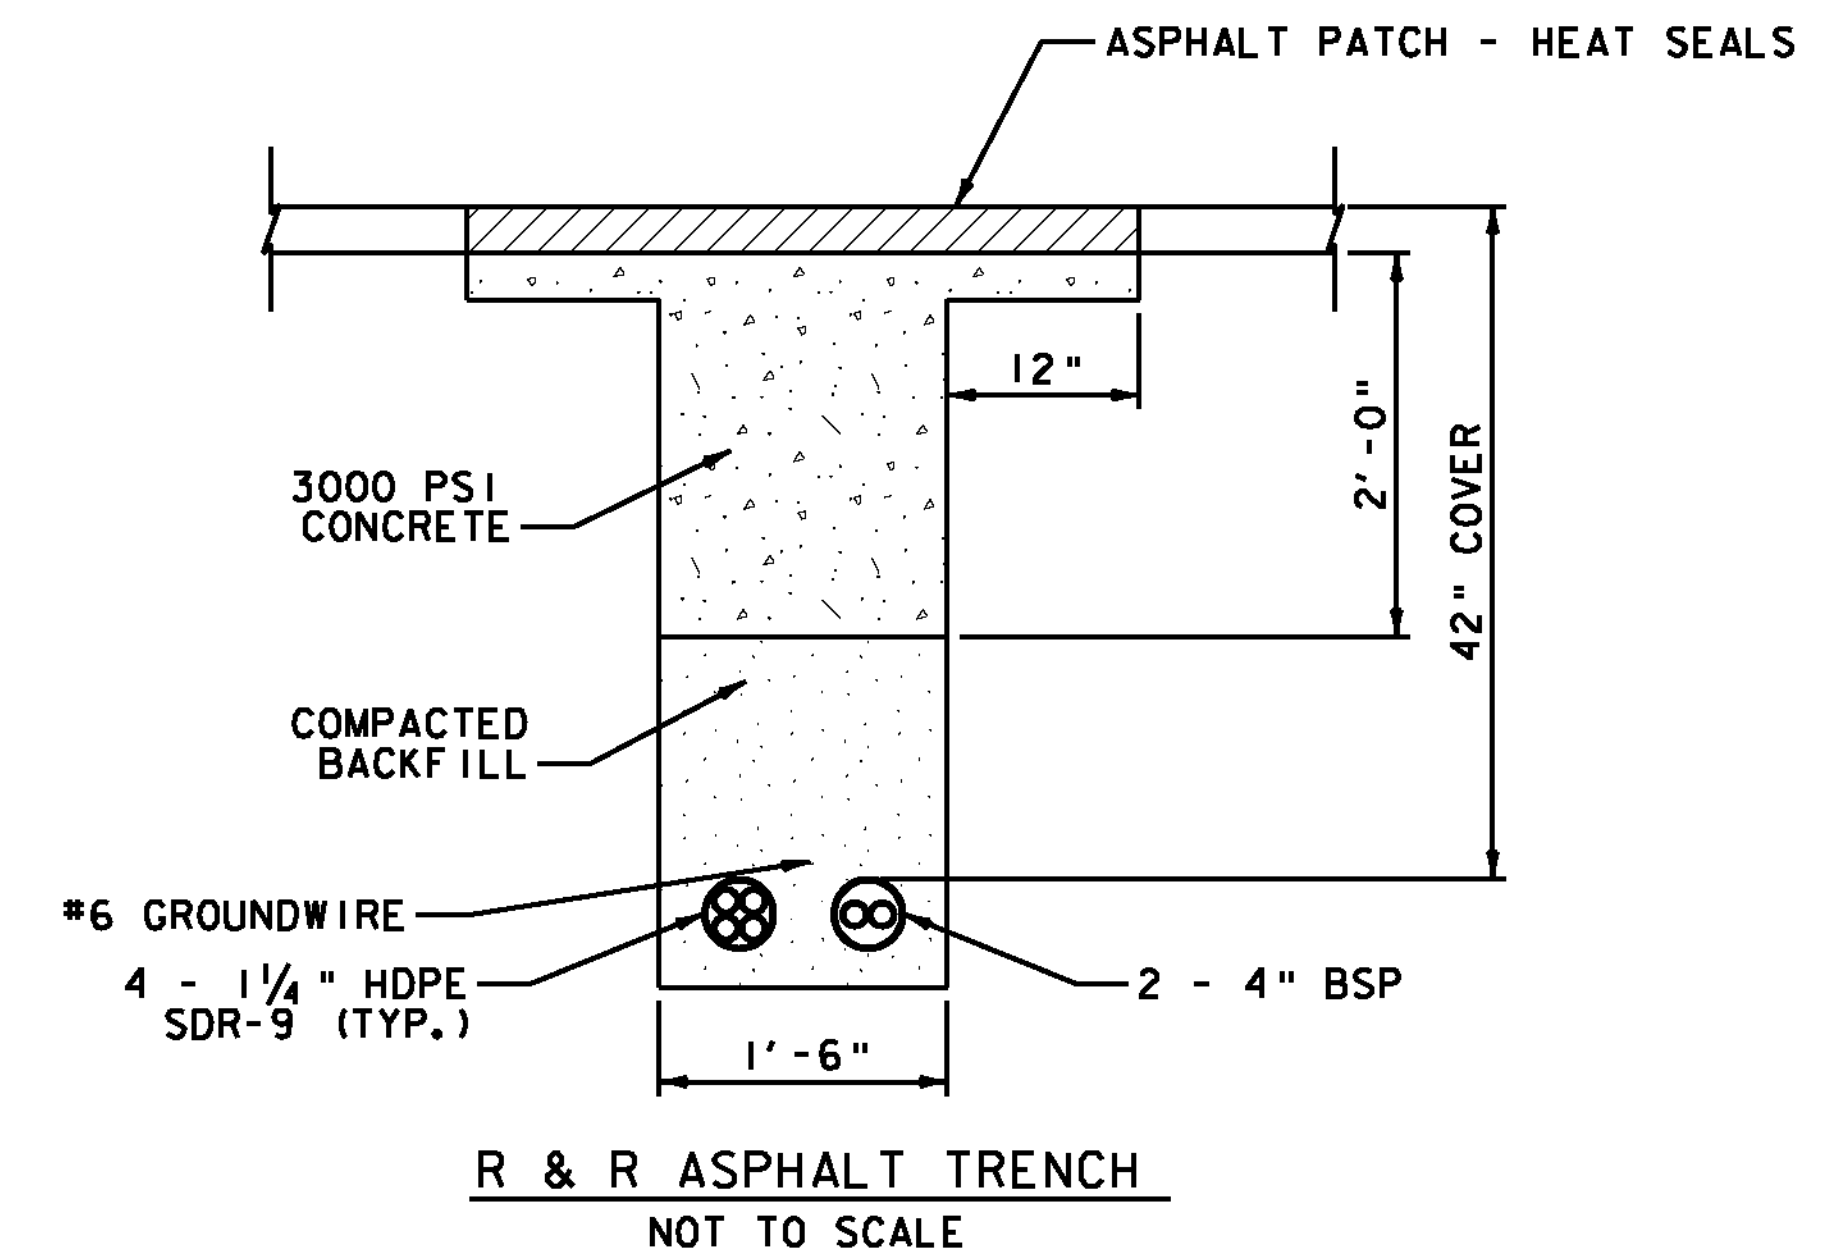
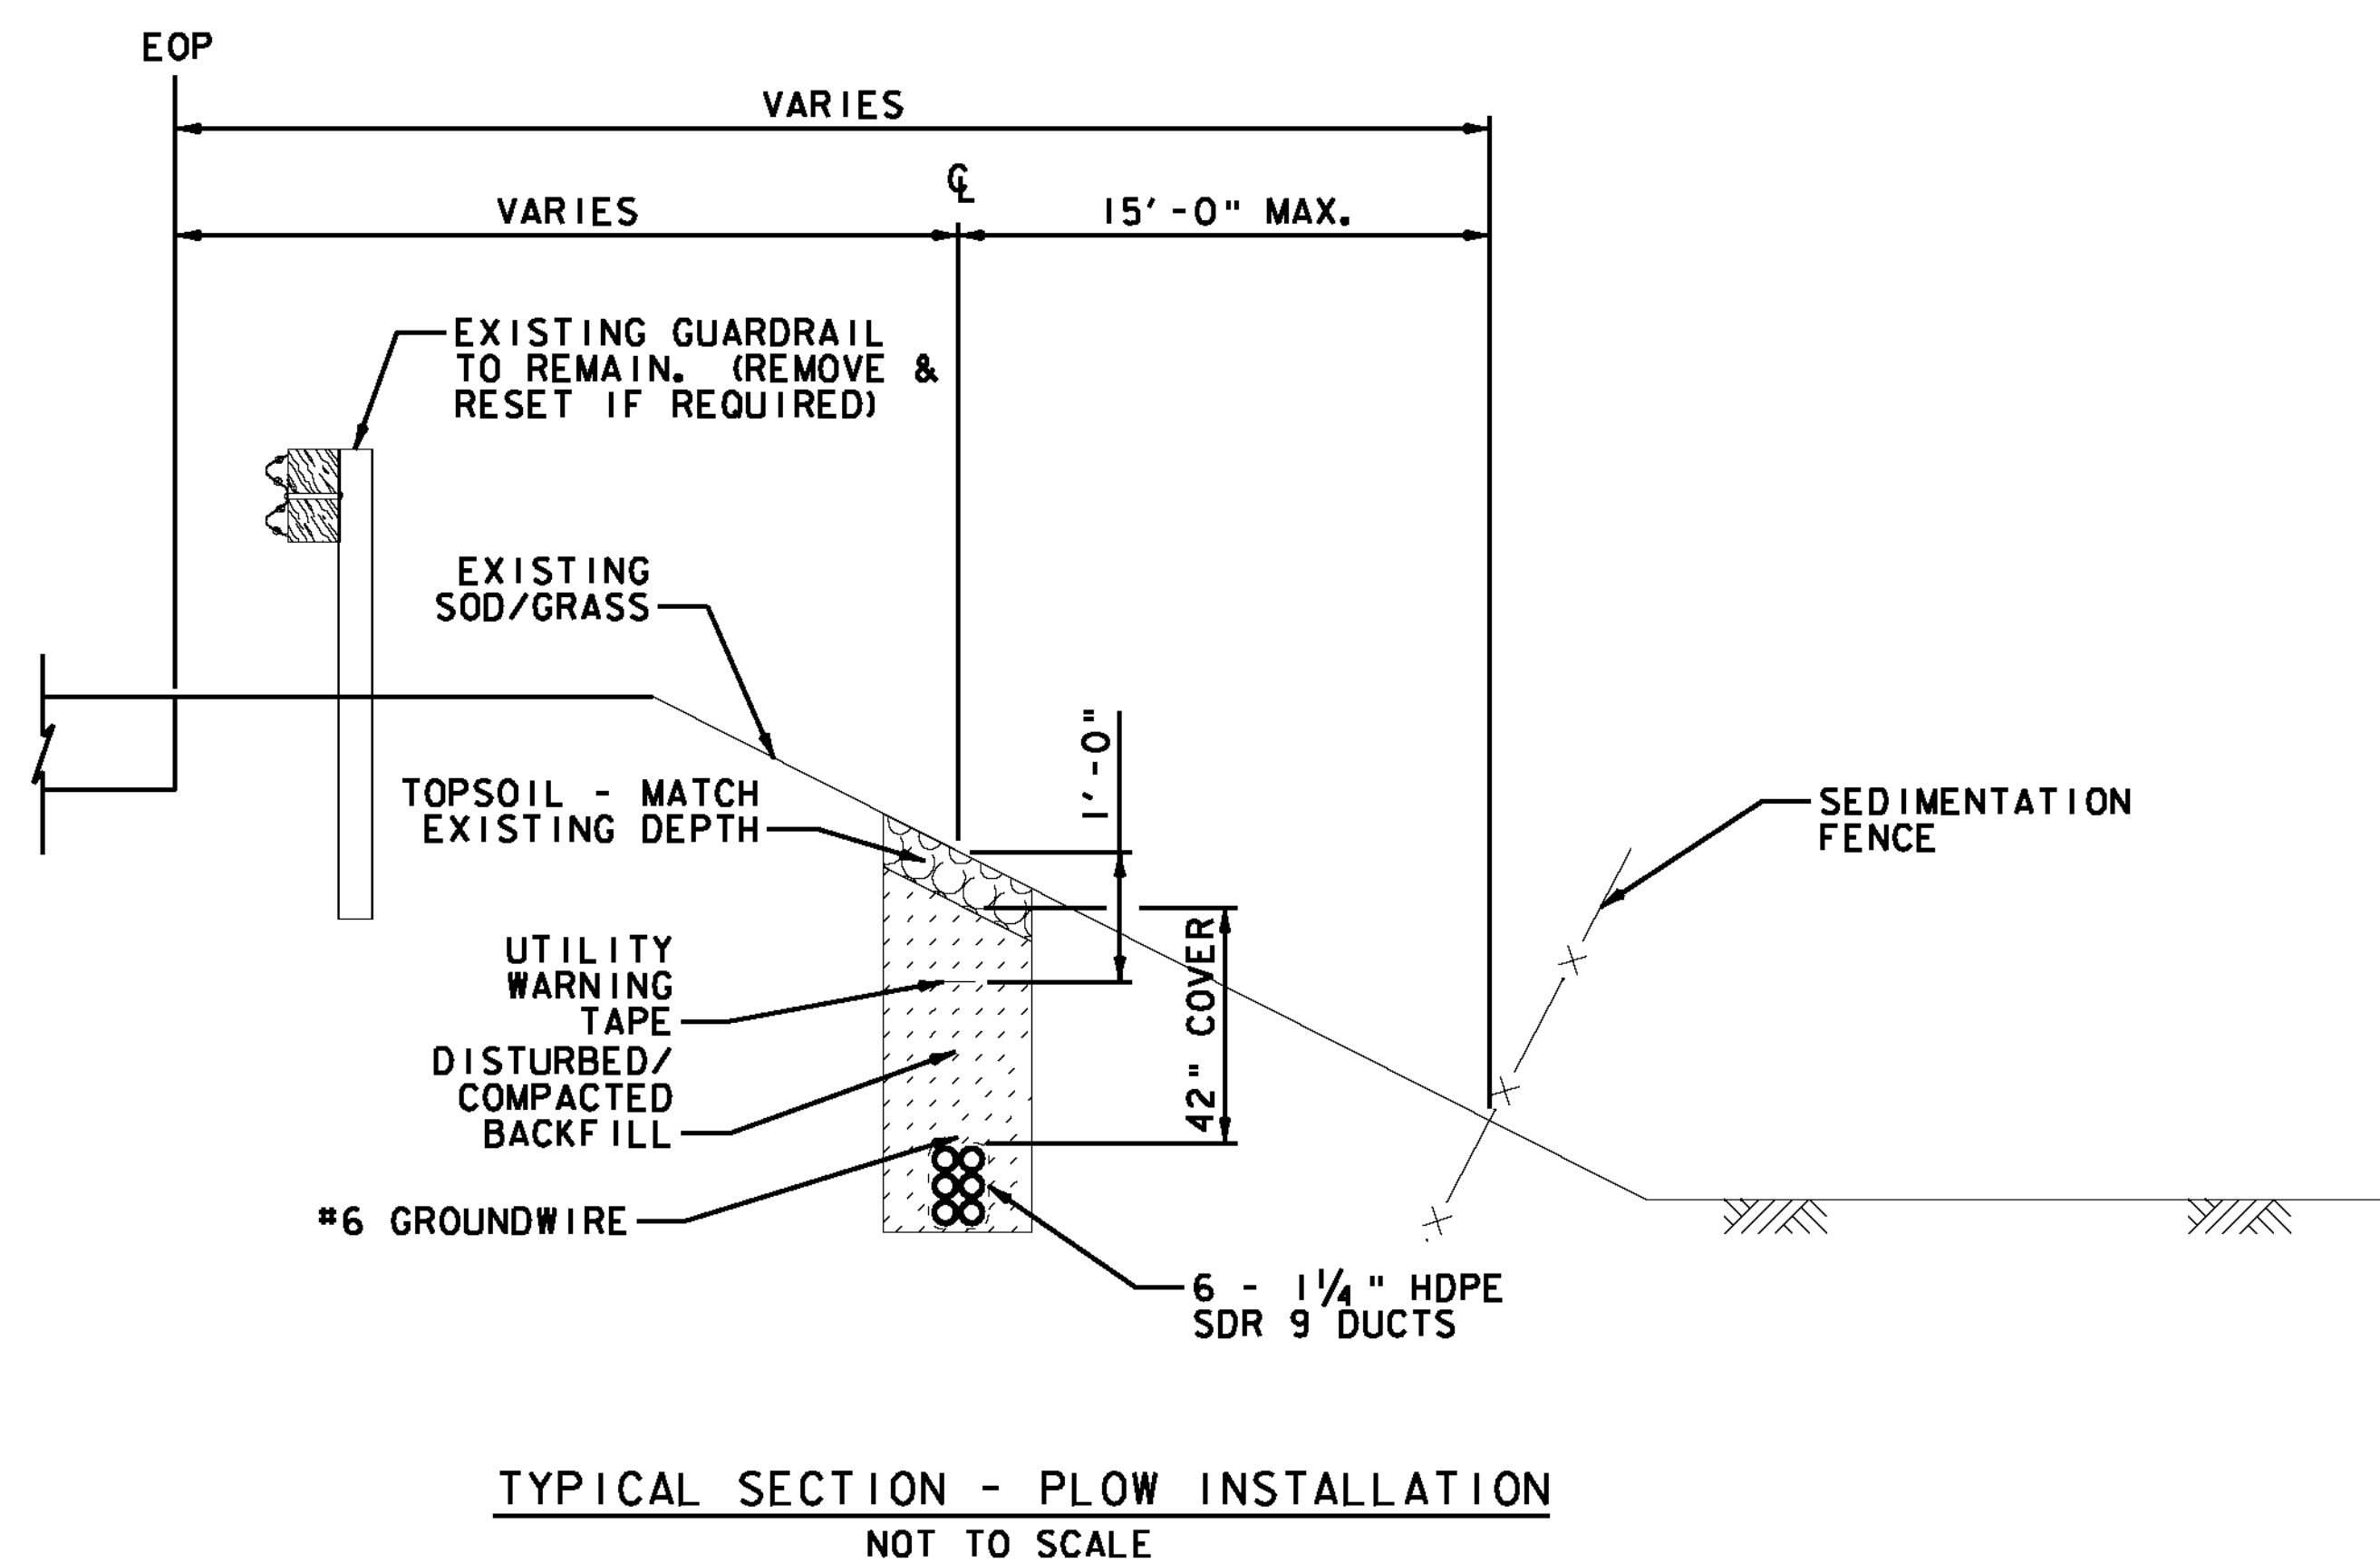


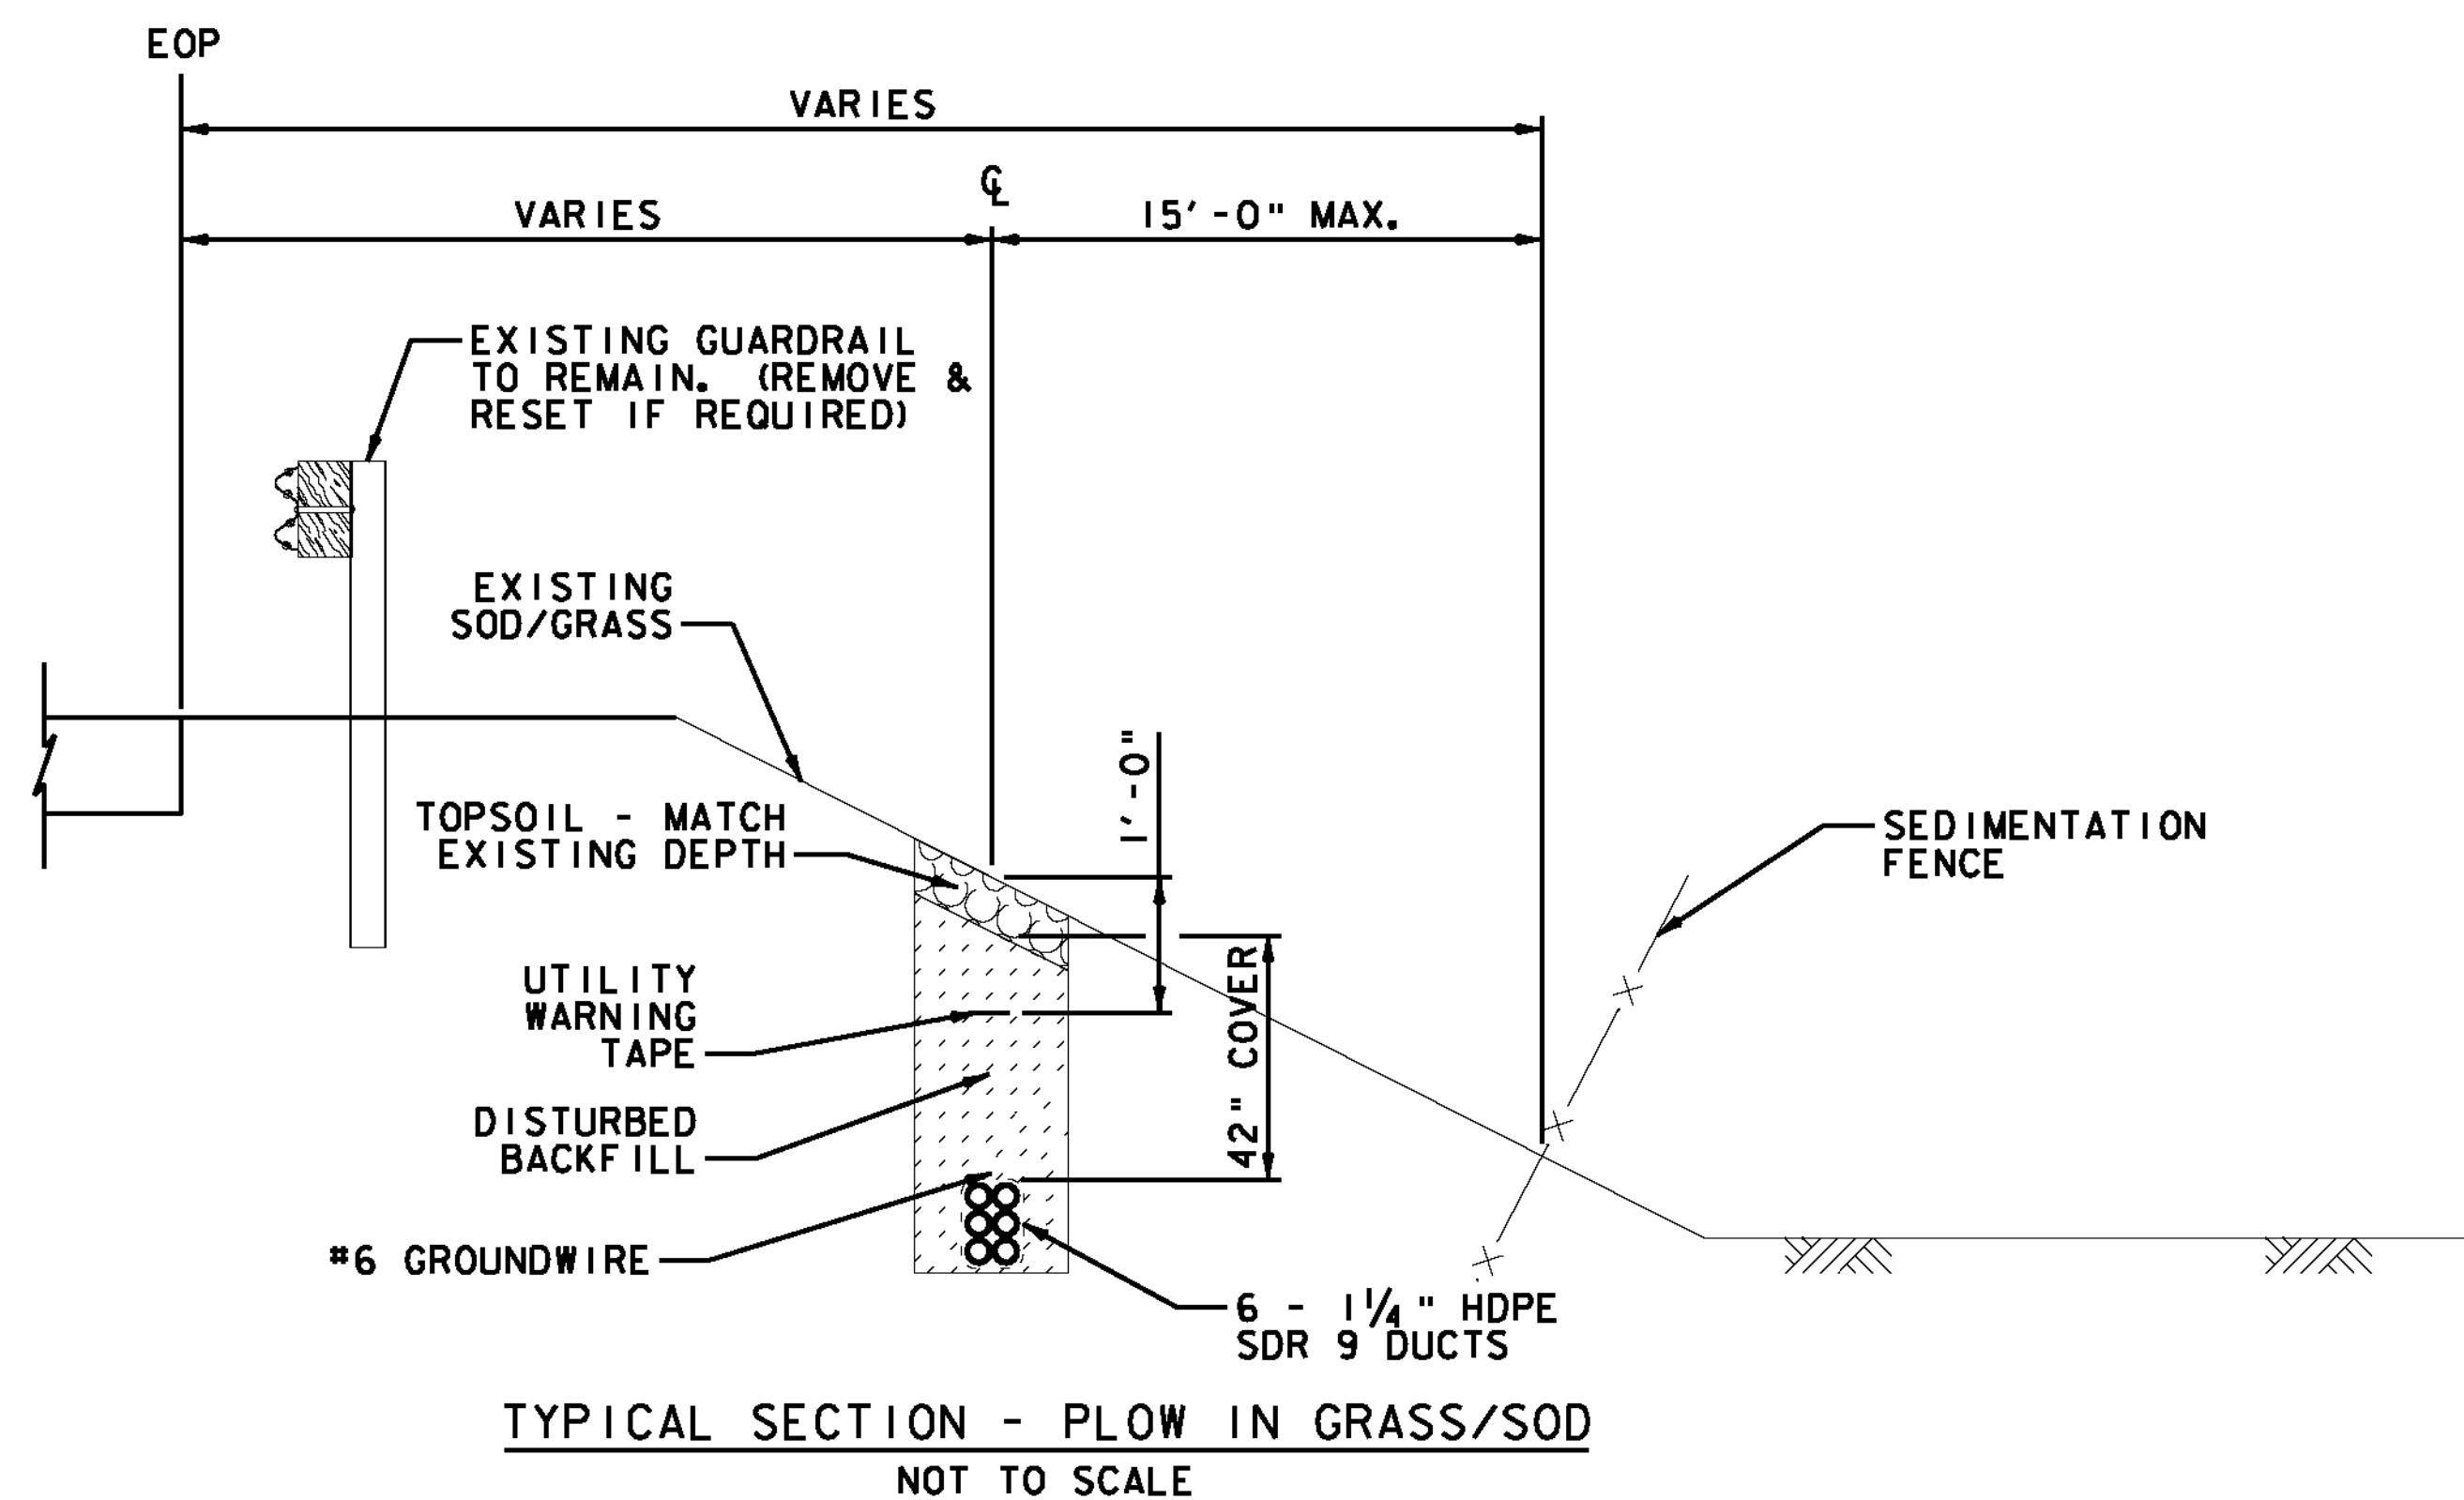

PROJECT NAME: HARTFORD SHARON
PROJECT NUMBER: FITS503

FILE NAME: z06e142CDTL2.dgn
PROJECT LEADER: J. YOUNG
DESIGNED BY: J. DURANTE
CONSTRUCTION DETAILS 2

PLOT DATE: 9/15/2010
DRAWN BY: S. GUNN
CHECKED BY: J. YOUNG
SHEET 37 OF 70