
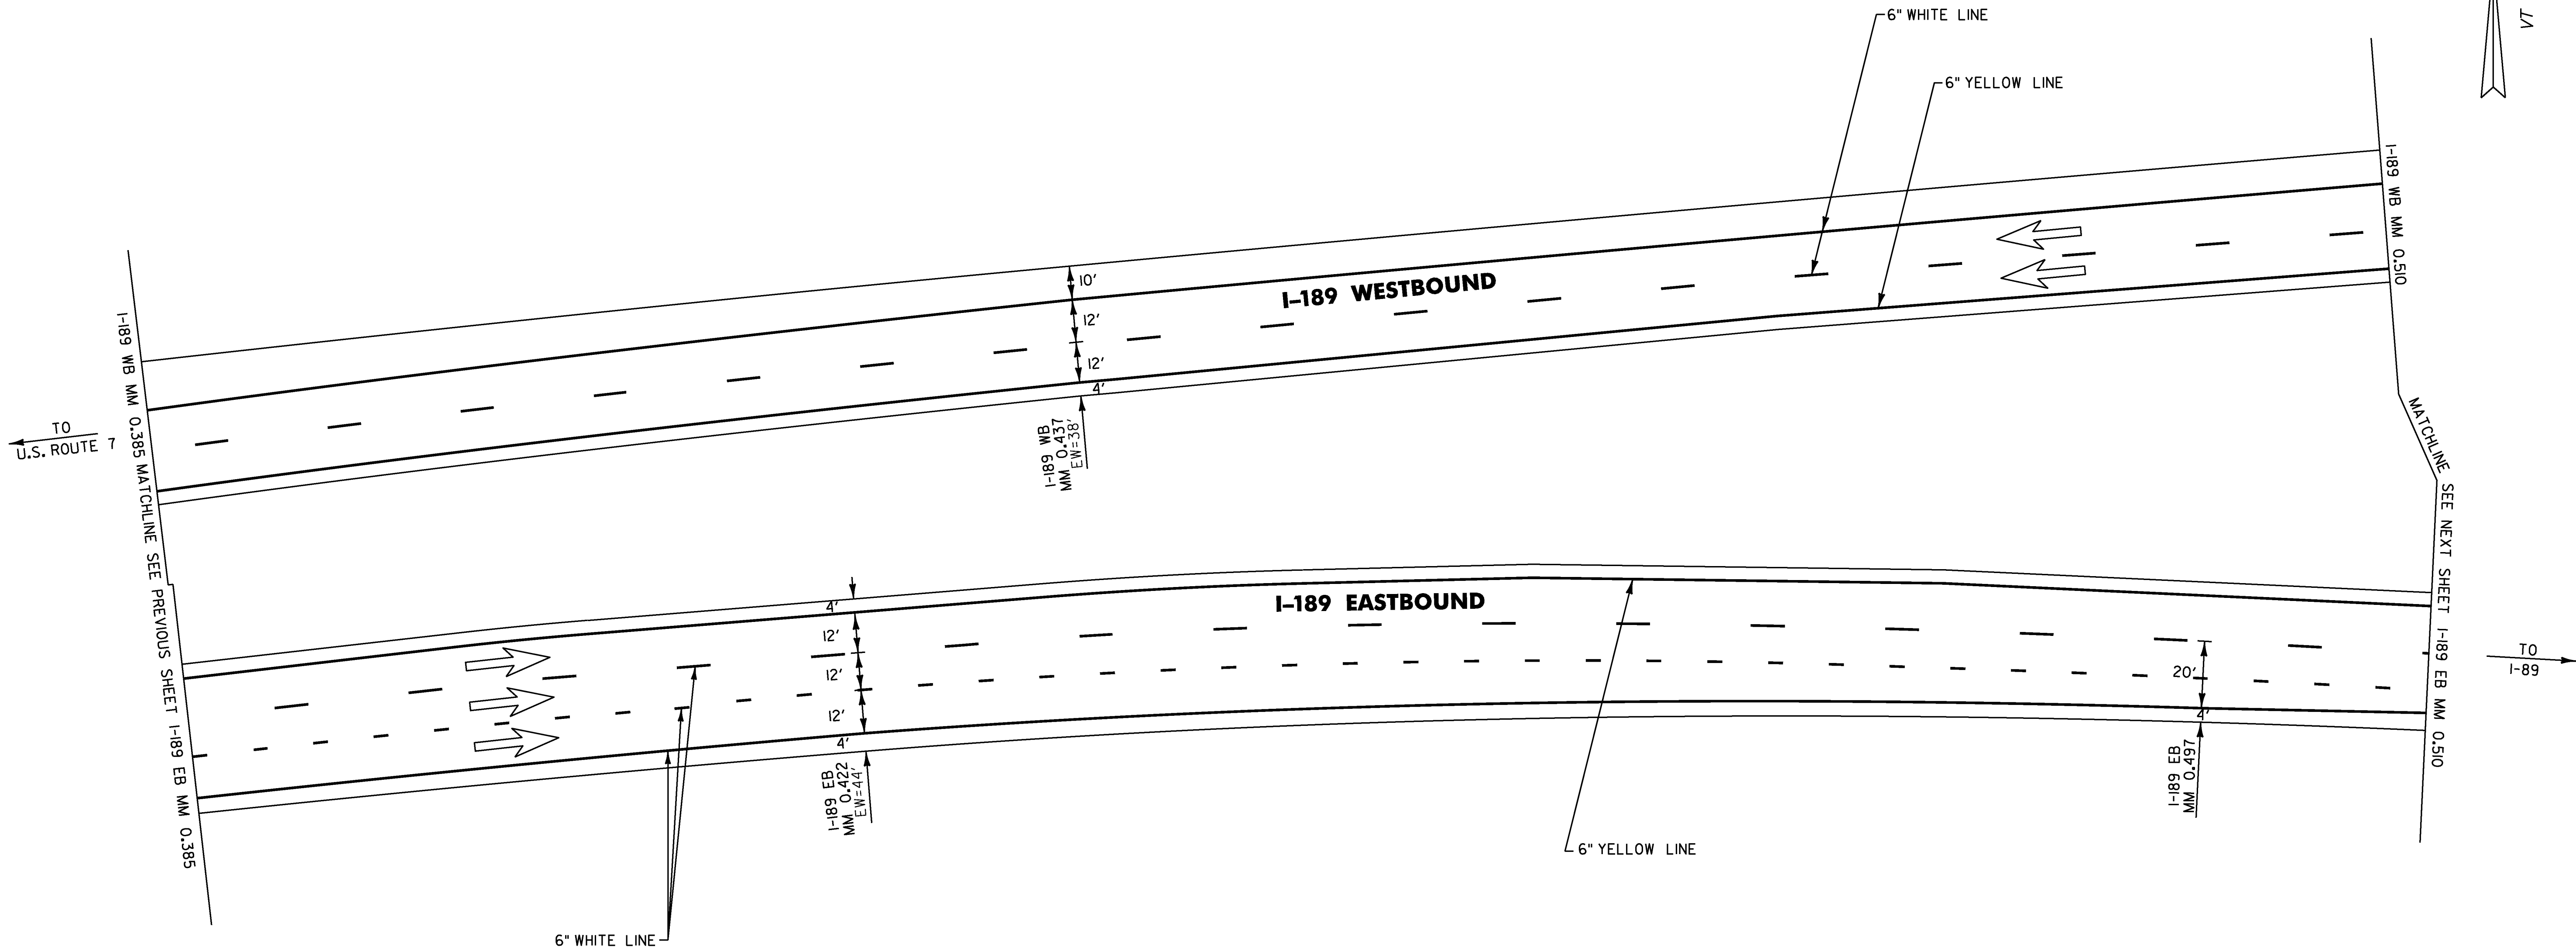


TEMPORARY 6" WHITE LINE
I-189 EB MM 0.385 TO I-189 EB MM 0.510, DASHED CENTERLINE/SOLID RT.
I-189 EB MM 0.385 TO I-189 EB MM 0.510, DOTTED RT.
I-189 WB MM 0.385 TO I-189 WB MM 0.510, SOLID LT./DASHED CENTERLINE

6" WHITE LINE
I-189 EB MM 0.385 TO I-189 EB MM 0.510, DASHED CENTERLINE/SOLID RT.
I-189 EB MM 0.385 TO I-189 EB MM 0.510, DOTTED RT.
I-189 WB MM 0.385 TO I-189 WB MM 0.510, SOLID LT./DASHED CENTERLINE

TEMPORARY 6" YELLOW LINE
I-189 EB MM 0.385 TO I-189 EB MM 0.510, SOLID LT.
I-189 WB MM 0.385 TO I-189 WB MM 0.510, SOLID RT.

6" YELLOW LINE
I-189 EB MM 0.385 TO I-189 EB MM 0.510, SOLID LT.
I-189 WB MM 0.385 TO I-189 WB MM 0.510, SOLID RT.

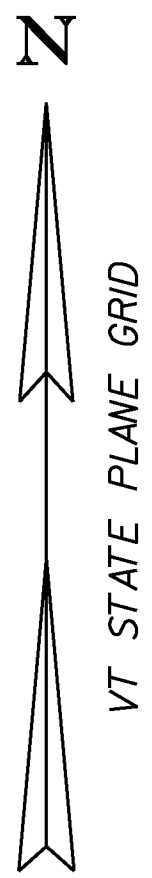

NOTES: 1) FOR STRIPING DETAILS AT THE GORES, SEE VAOT STANDARDS E-191 & E-192
2) DIRECTION OF TRAVEL
3) EW= EXISTING ROADWAY WIDTH

NOT TO SCALE

LAYOUT SHEET #6	PROJECT NAME: BURLINGTON-SO. BURLINGTON	
	PROJECT NUMBER: IM SURF (30)	
	FILE NAME: Ila028/Ila028.dgn	PLOT DATE: 12-APR-2012
	PROJECT LEADER: M. FOWLER	DRAWN BY: L. BULLOCK
	DESIGNED BY: L. BULLOCK	CHECKED BY: M. FOWLER
	Ila028Ia6.I	SHEET 21 OF 49