


INDEX OF SHEETS

- 1 TITLE SHEET
- 2 COMMON NOTES TO BOTH ALTERNATES
- 3 ALTERNATE A TYPICAL SHEET
- 4 ALTERNATE B TYPICAL SHEET
- 5 BRIDGE DETAIL SHEET # 1
- 6 BRIDGE DETAIL SHEET # 2
- 7 QUANTITY SHEET
- 8 PAVEMENT MARKING DETAIL SHEET
- 9 MAINLINE PAVEMENT MARKING SHEET
- 10 EXIT 14 PAVEMENT MARKING SHEET
- 11 EXIT 15 PAVEMENT MARKING SHEET
- 12 EXIT 16 PAVEMENT MARKING SHEET
- 13 ROUGHNESS DATA INFORMATION
- 14 RUTTING DATA INFORMATION
- 15 CONSTRUCTION APPROACH SIGNING EXIT 14
- 16 CONSTRUCTION APPROACH SIGNING EXIT 15
- 17 CONSTRUCTION APPROACH SIGNING EXIT 16
- 18 CONSTRUCTION APPROACH MAINLINE SIGNING SHEET
- 19 TRAFFIC CONTROL NOTE SHEET

STATE OF VERMONT AGENCY OF TRANSPORTATION



PROJECT LOCATION
NORWICH - BRADFORD IM SURF (31)

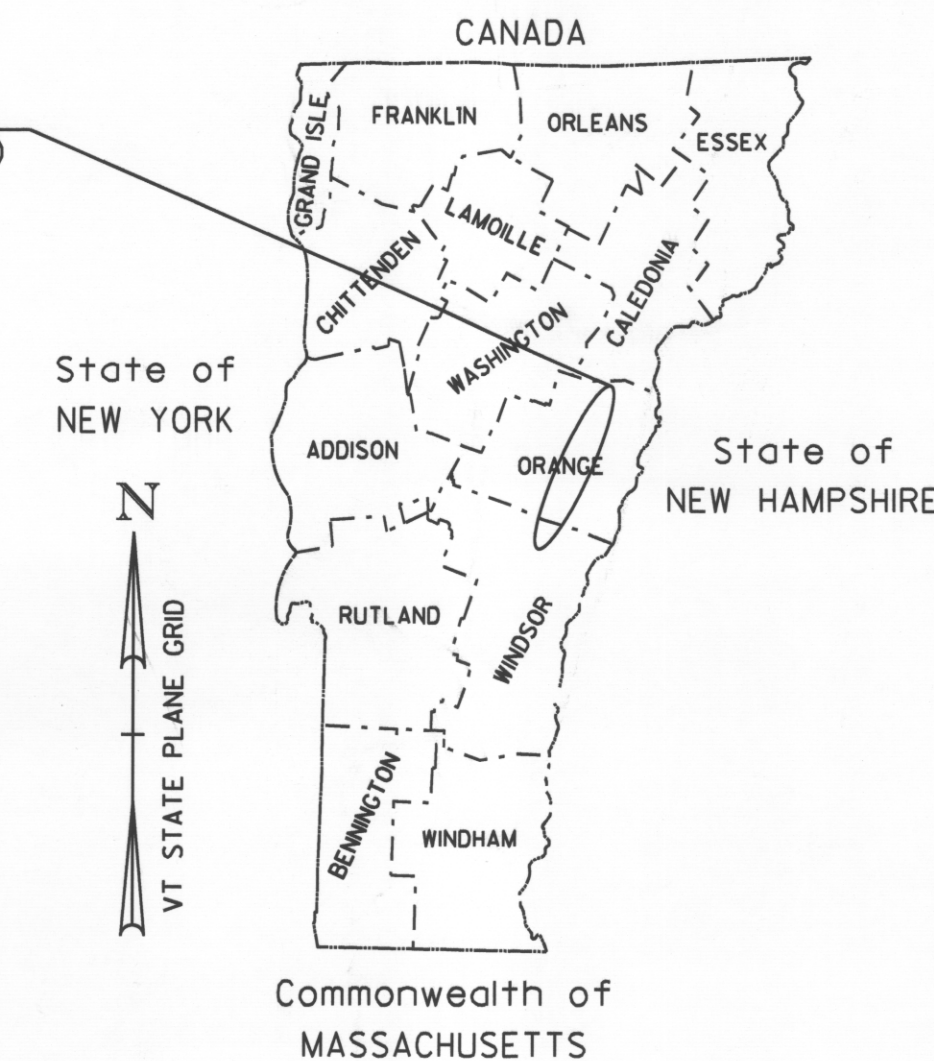

PROPOSED IMPROVEMENT

TOWNS OF NORWICH, THETFORD, FAIRLEE AND BRADFORD COUNTIES OF WINDSOR AND ORANGE INTERSTATE 91 SOUTHBOUND

BEGINNING IN THE TOWN OF NORWICH IN THE SOUTHBOUND LANE AT MILE MARKER 76.443 AND EXTENDING NORTHERLY ALONG INTERSTATE 91 FOR A DISTANCE OF 116,091.36 FT (21.987 MILES) TO MILE MARKER 98.430 IN THE TOWN OF BRADFORD.

LENGTH OF ROADWAY = 116,091.36 FT = (21.987 MILES) (SOUTHBOUND LANE)
LENGTH OF PROJECT = 116,091.36 FT = (21.987 MILES) (SOUTHBOUND LANE)

WORK TO BE PERFORMED UNDER THIS PROJECT INCLUDES SURFACE PREPARATION INVOLVING PATCHING, POTHOLE REPAIR, AND CRACK-SEALING; OVERLAYING WITH A THIN BITUMINOUS CONCRETE WEARING COURSE ON THE EXISTING INTERSTATE TYPICAL, AND APPLICABLE PAVEMENT MARKINGS.

TRAFFIC DATA

I-91 - SOUTHBOUND	2012 AADT	2022 AADT	2012 DHV	2022 DHV	FLEXIBLE ESALS (2012 - 2022)	FLEXIBLE ESALS (2012 - 2032)
BEGIN PROJECT TO EXIT 14	6,200	6,900	880	980	3,530,000	8,425,000
EXIT 14 TO EXIT 15	4,900	5,600	660	750	1,958,000	4,804,000
EXIT 15 TO EXIT 16	4,000	4,600	560	640	2,658,000	6,452,000
EXIT 16 TO END PROJECT	4,000	3,200	390	440	2,839,000	6,795,000

VAOT STANDARDS

100	01/02/2004
100A	01/02/2004
101	05/30/2003
102	06/30/2003
102A	05/01/2004
103	03/01/2004
105	05/01/2004
106	05/01/2004
107A	06/08/2009
108	06/08/2009
108A	06/08/2009
110	08/08/1995
120	08/08/1995
121	08/08/1995
150	05/01/2004
164	06/08/2009
191	02/01/1999
193	08/18/1995

RECORD PLANS

CONTRACTOR: GORMAN GROUP, LLC - ALBANY, NY

RESIDENT ENGINEER: PAUL PERRY

CONSTRUCTION BEGAN: APRIL 16, 2012

CONSTRUCTION COMPLETE: SEPTEMBER 20, 2012

RECORD PLANS BY: PAUL PERRY & J. HYDE


I HEREBY CERTIFY THAT ALL THE CONSTRUCTION REQUIRED BY THIS SET OF DRAWINGS HAS BEEN ACCOMPLISHED AS INDICATED HEREIN.

BY: *Paul Perry* DATE: 04/02/13

RESIDENT ENGINEER

NOTE: Any further information concerning final quantities, amounts or other details relative to this project may be found at Central Files in the electronic archives.

MM 76.443
BEGIN PROJECT IM SURF (31)

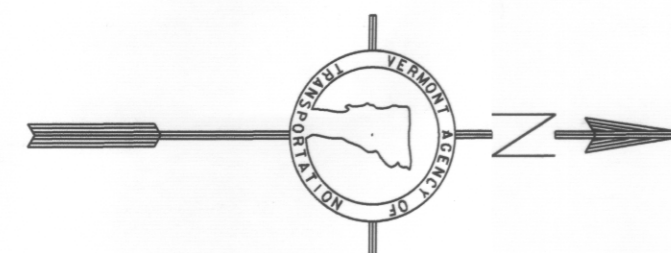

MM 98.43
END PROJECT IM SURF (31)


QUALITY ASSURANCE PROGRAM: LEVEL 1

CONVENTIONAL SYMBOLS

COUNTY LINE	— — — — —
TOWN LINE	— — — — —
LIMITS OF ACCESS	— o — o — o — o —
POINT OF ACCESS	X
FENCE LINE	X — X — X — X —
STONE WALL	o — o — o — o — o — o — o — o —
TRAVELED WAY	— — — — —
GUARD RAIL	o — o — o — o — o — o — o — o —
RAILROAD	— — — — —
SURVEY LINE	— — — — —
CULVERT	— — — — —
POWER POLE	⊕
TELEPHONE POLE	⊕
TREES	⊗
CONTROL OF ACCESS	— — — — —
PROPERTY LINE	— — — — —
R.O.W. TAKING LINE	SR — SR — SR —
SLOPE RIGHTS	— — — — —
TOP OF CUT	— — — — —
TOE OF SLOPE	— — — — —

SURVEYED BY :
SURVEYED DATE :

DATUM
VERTICAL
HORIZONTAL

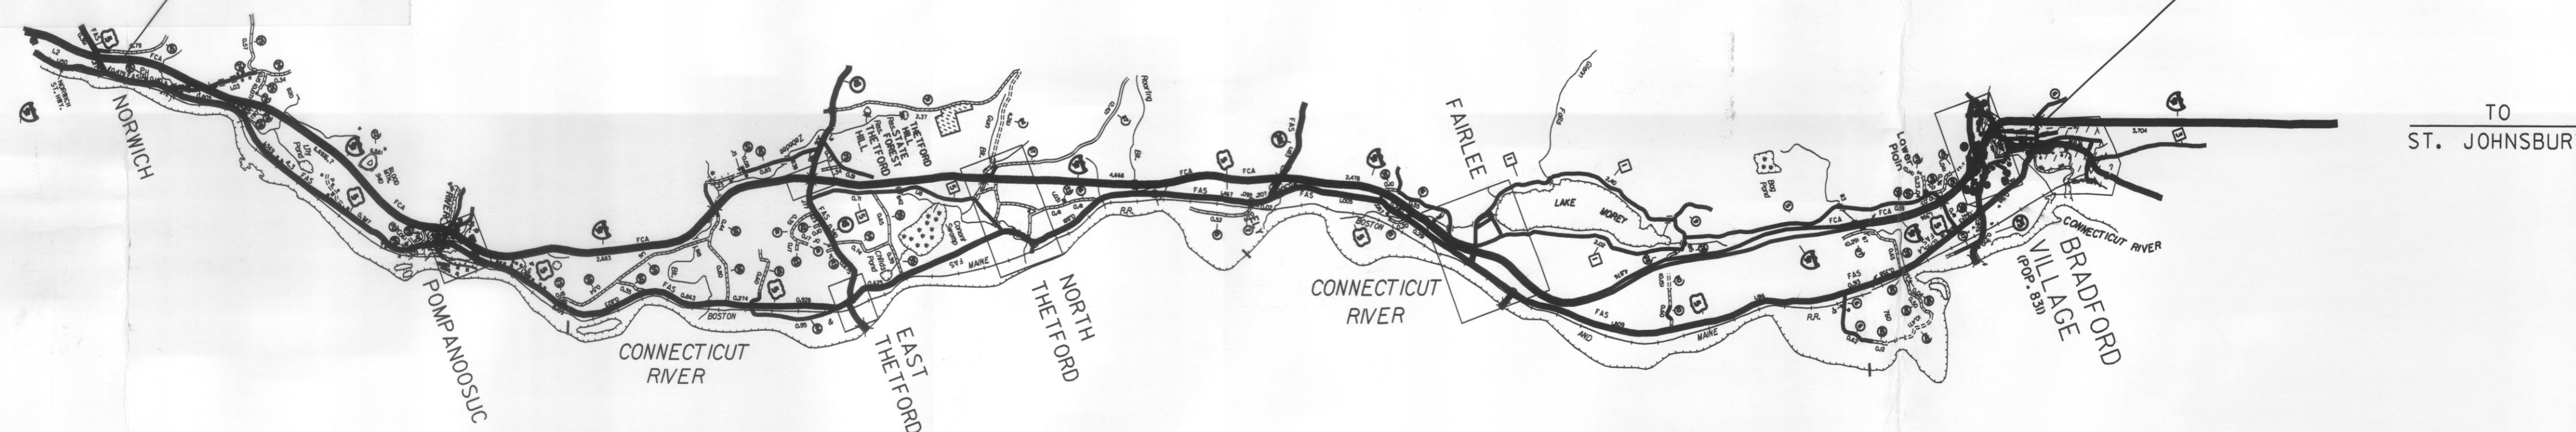

THESE PLANS ARE SUBJECT TO SUCH ENGINEERING CHANGES AS MAY BE REQUIRED BY THE FEDERAL HIGHWAY ADMINISTRATION OR THE DIRECTOR OF PROGRAM DEVELOPMENT.

CONSTRUCTION IS TO BE CARRIED ON IN ACCORDANCE WITH THESE PLANS AND THE STANDARD SPECIFICATIONS FOR CONSTRUCTION DATED 2011, AS APPROVED BY THE FEDERAL HIGHWAY ADMINISTRATION ON JULY 20, 2011 FOR USE ON THIS PROJECT, INCLUDING ALL SUBSEQUENT REVISIONS AND SUCH REVISED SPECIFICATIONS AND SPECIAL PROVISIONS AS ARE INCORPORATED IN THESE PLANS.

DIRECTOR OF PROGRAM DEVELOPMENT

APPROVED: *Paul Perry* DATE: 2/4/12

PROJECT MANAGER : MIKE FOWLER

PROJECT NAME : NORWICH - BRADFORD
PROJECT NUMBER : IM SURF (31)

SHEET 1 OF 19 SHEETS