
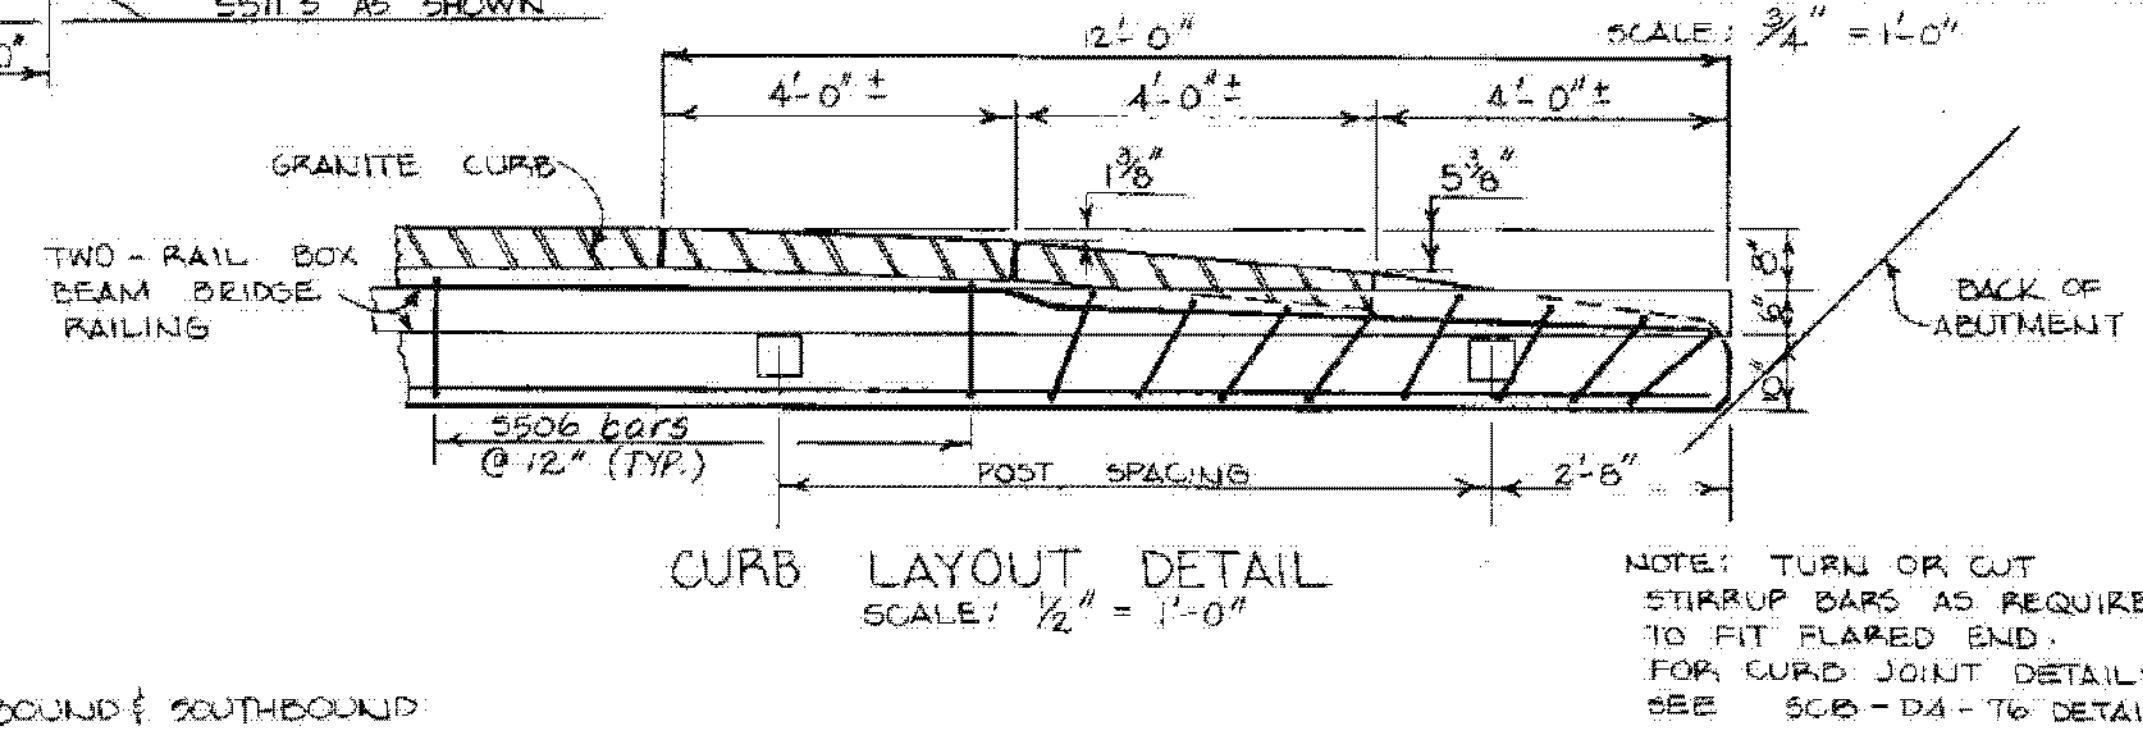
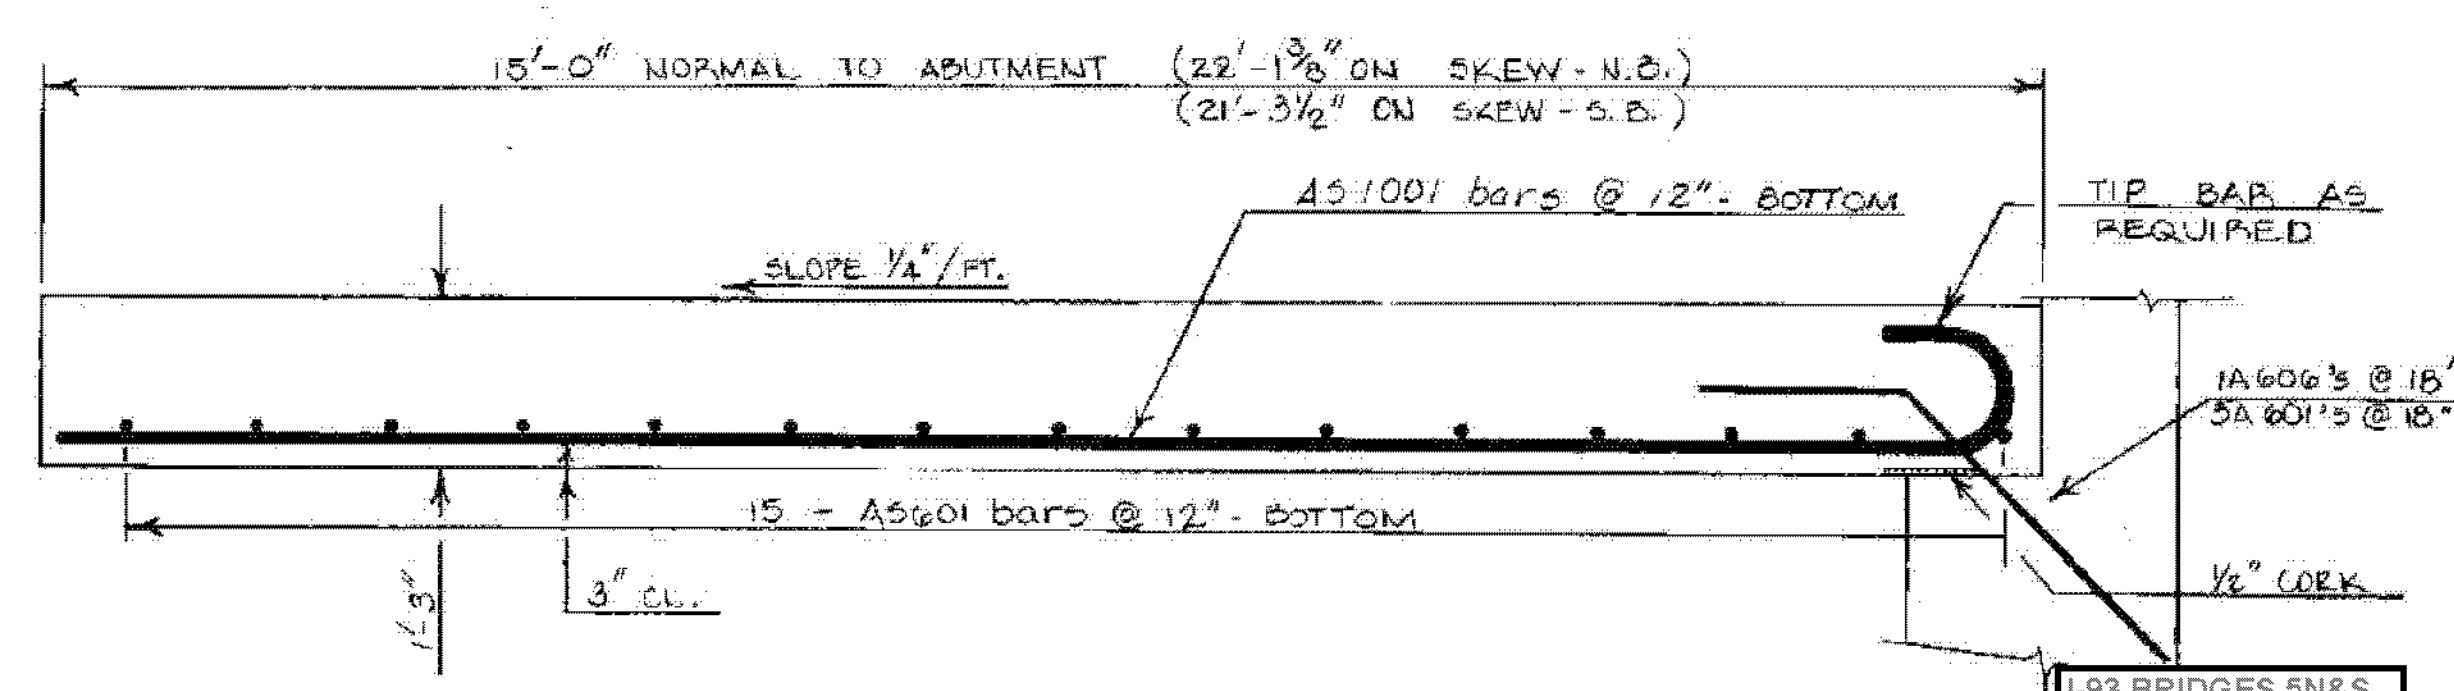
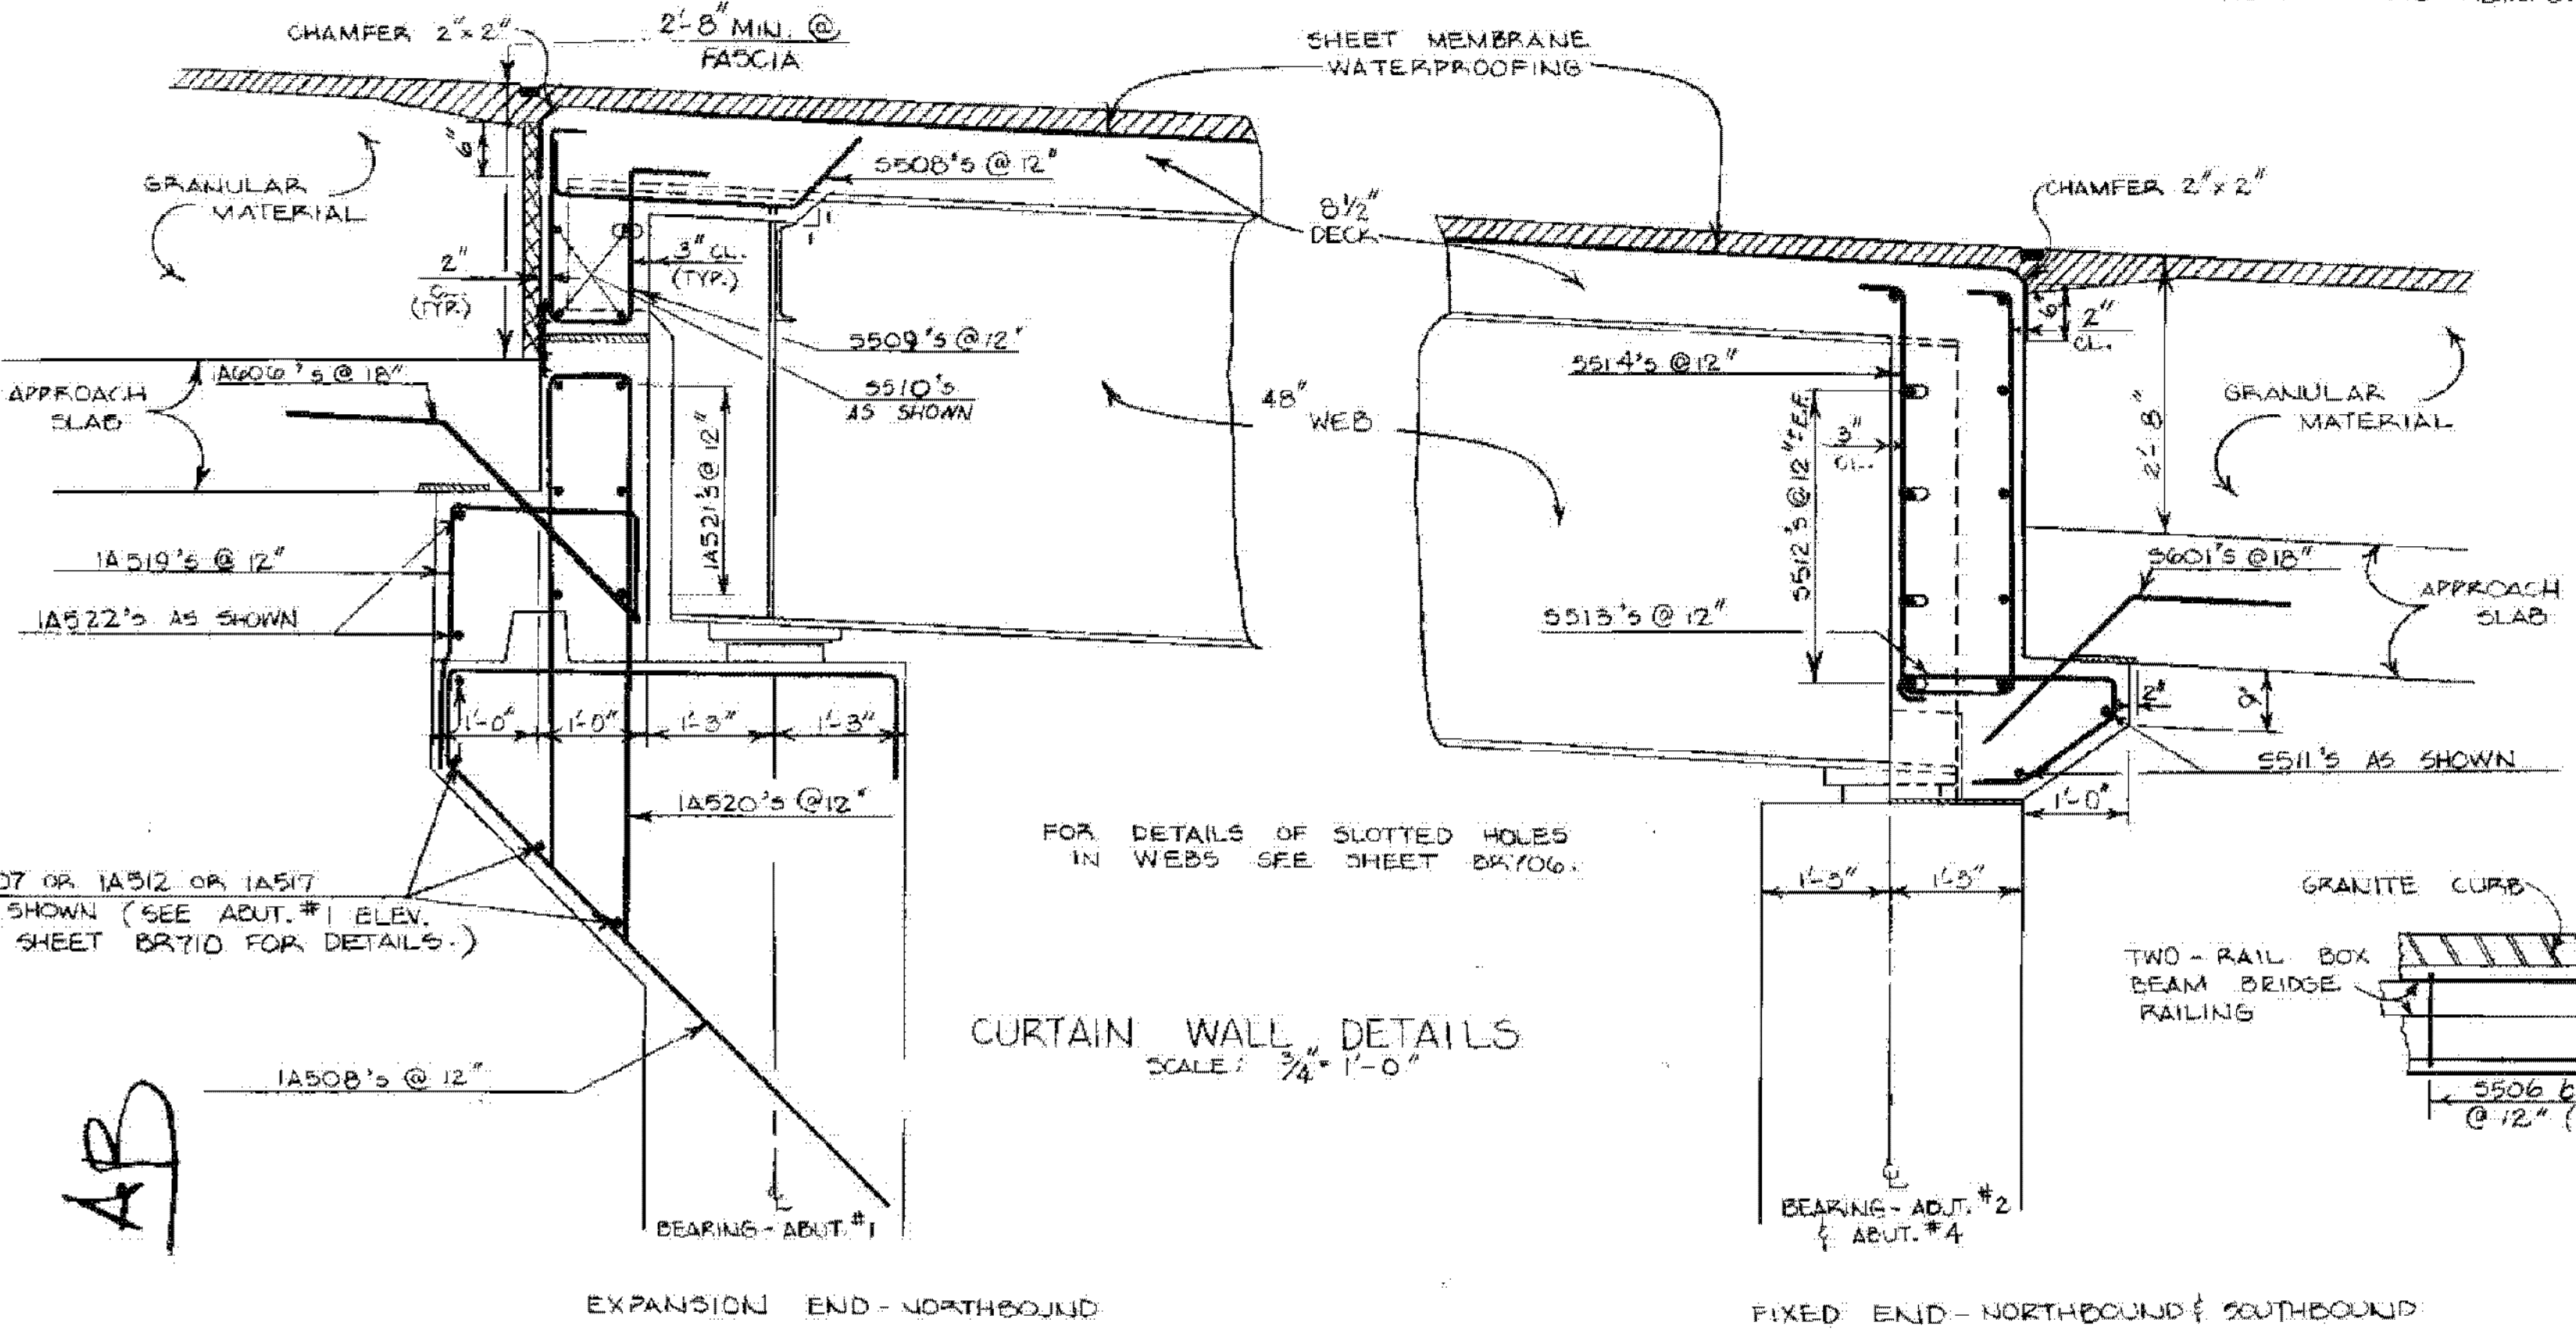


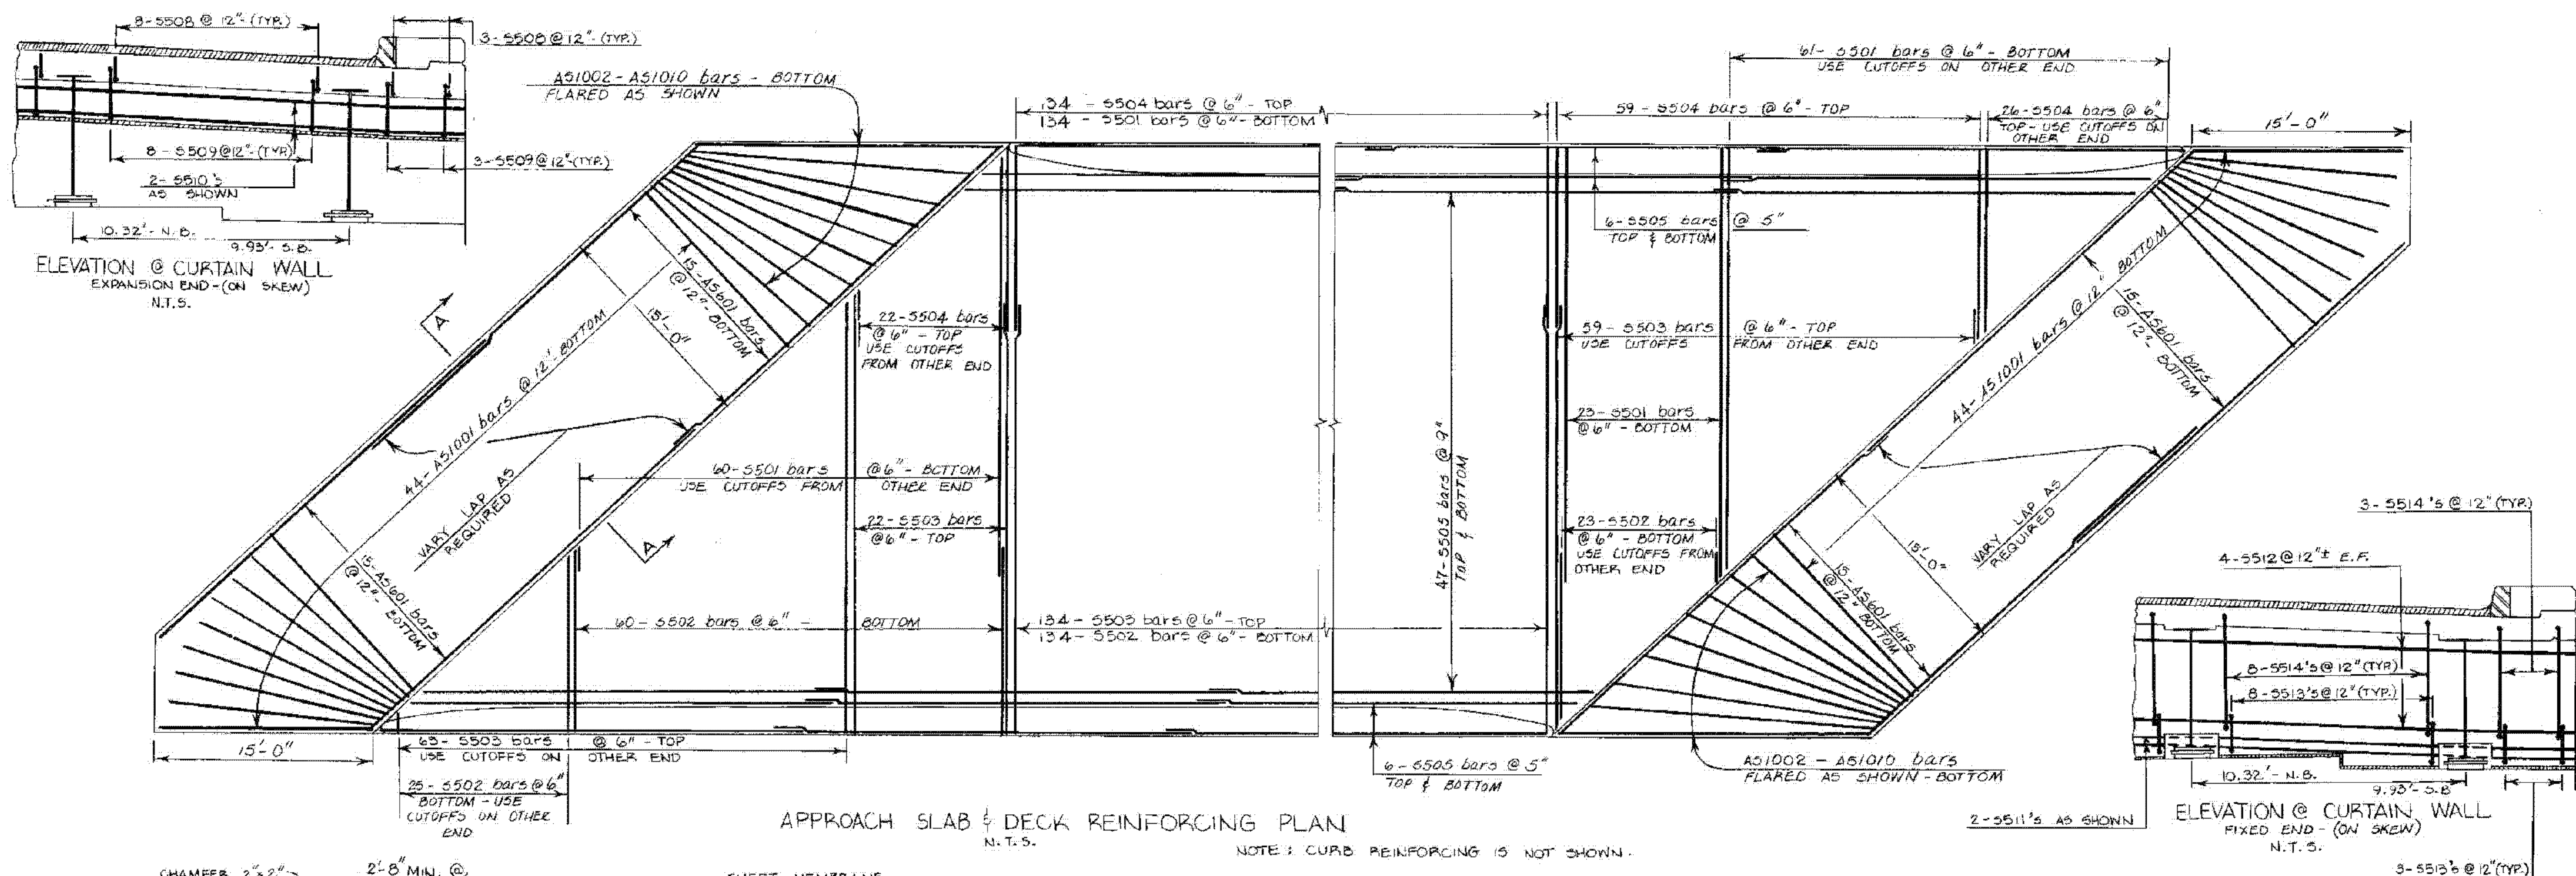

STATE OF VERMONT AGENCY OF TRANSPORTATION	
TOWN OF WATERFORD	Bridge No. 67
HIGHWAY NO. I 93	Loc. Sta. 354+83
I 93 OVER TOWN HIGHWAY #7	
APPROACH SLAB & DECK REINFORCING PLAN	
Designed by G.S. ROGERS	Drawn by G.L. DAVIS
Checked by G.S. ROGERS date 7-80	Bridge Design Supervisor F.W. Bolkum date 7/80
PROJECT WATERFORD	PROJECT NO. I93-1(3) CONTR.#2
Bridge Sheet No. BR709	Sheet 160 of 531

BRUNING 44-131-4723-1