




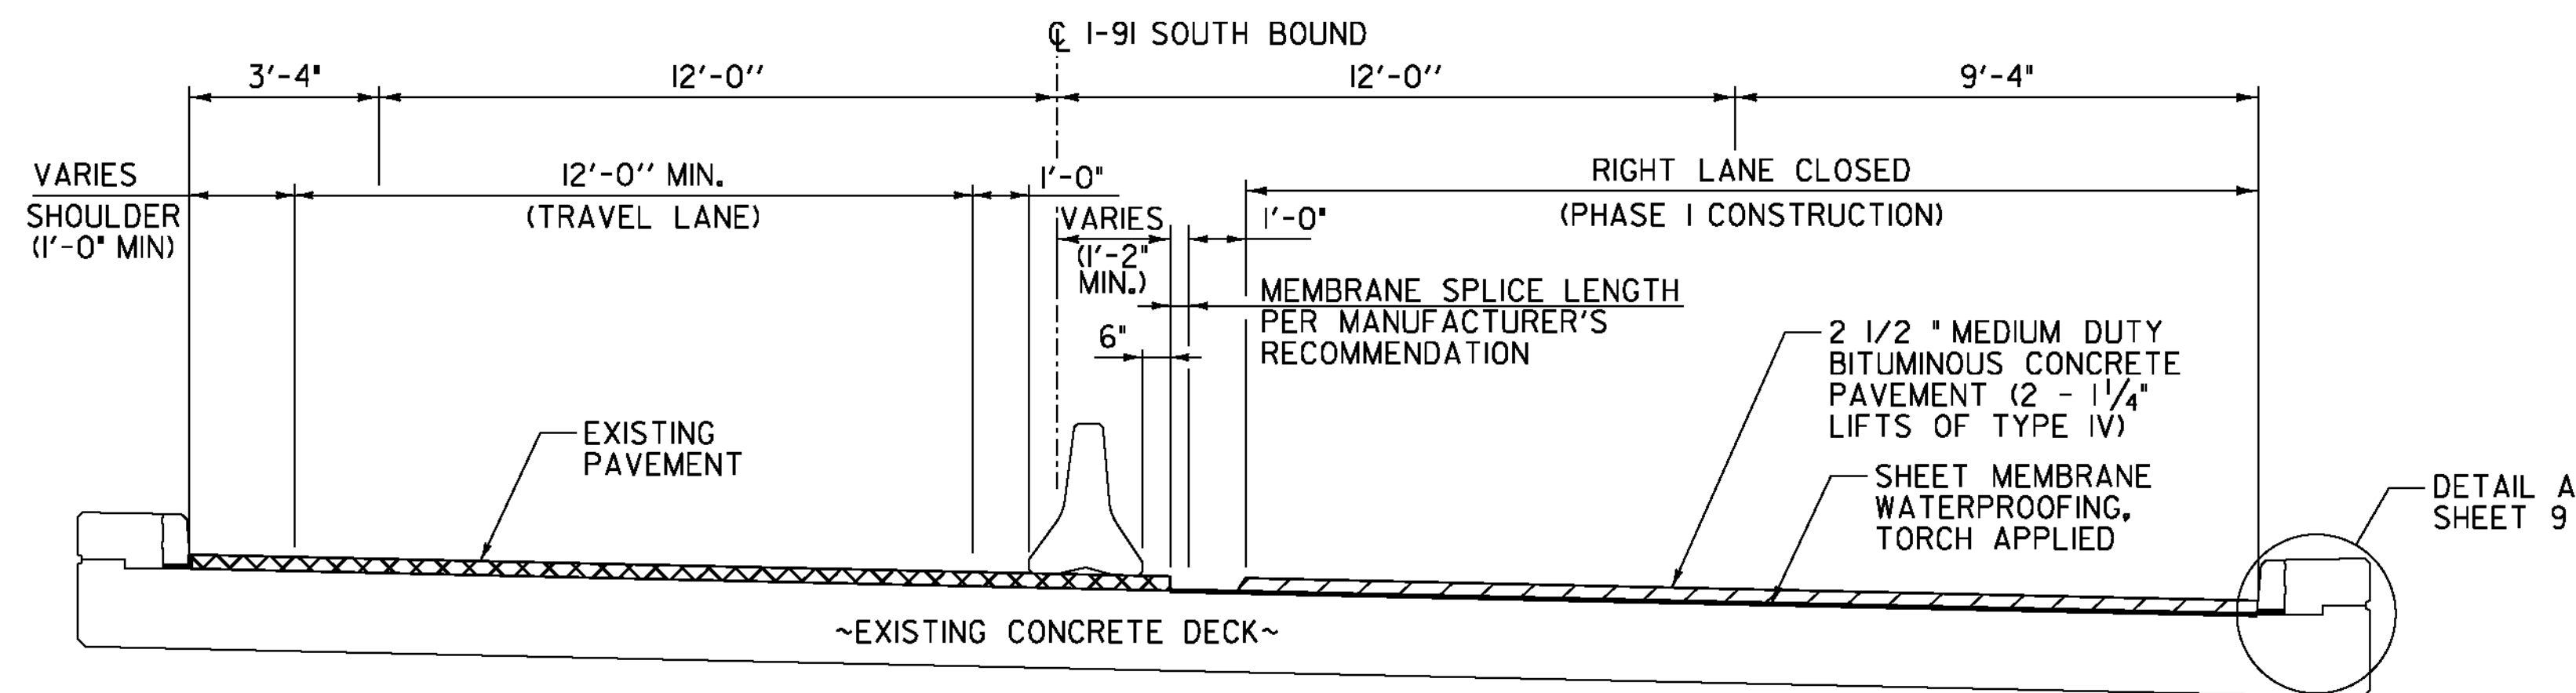


TYPICAL SECTION - PHASE I CONSTRUCTION - BRIDGE NO. 81S
NOT TO SCALE

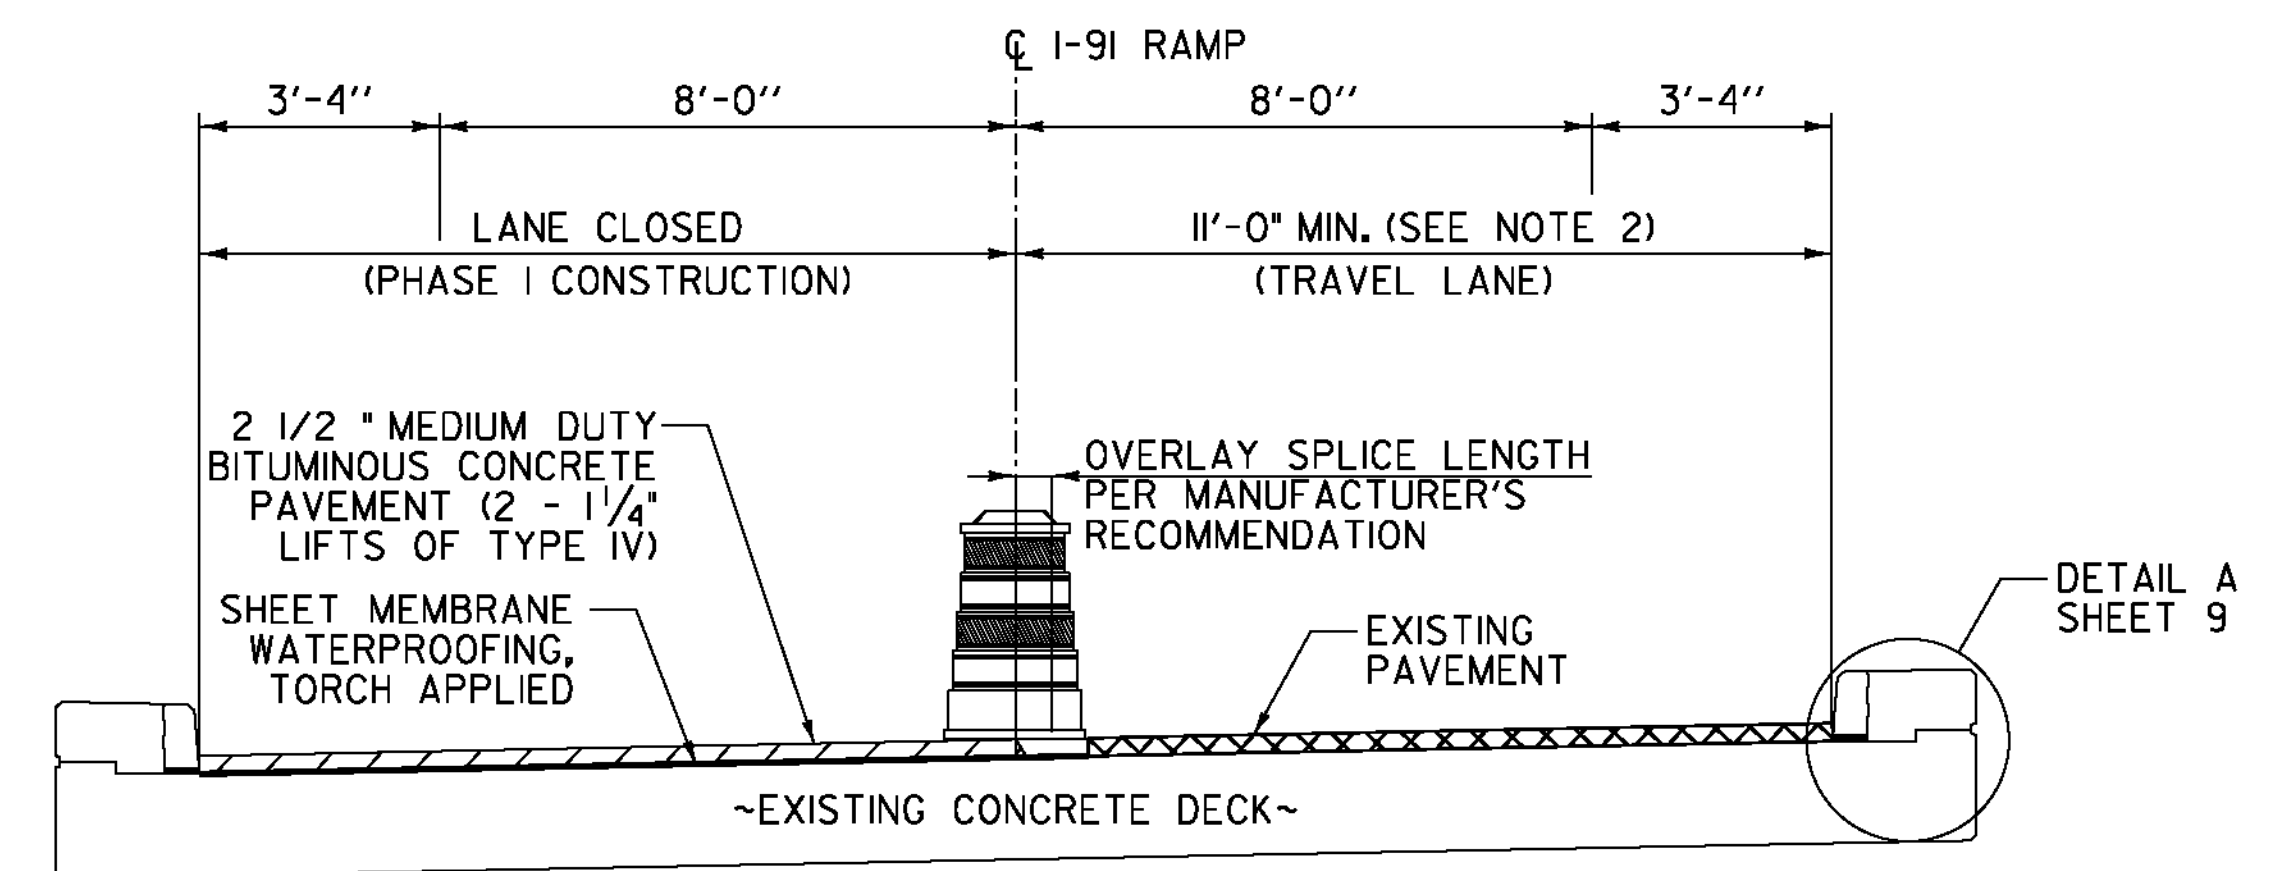

TYPICAL SECTION - PHASE I CONSTRUCTION - BRIDGE NO. 81B
NOT TO SCALE

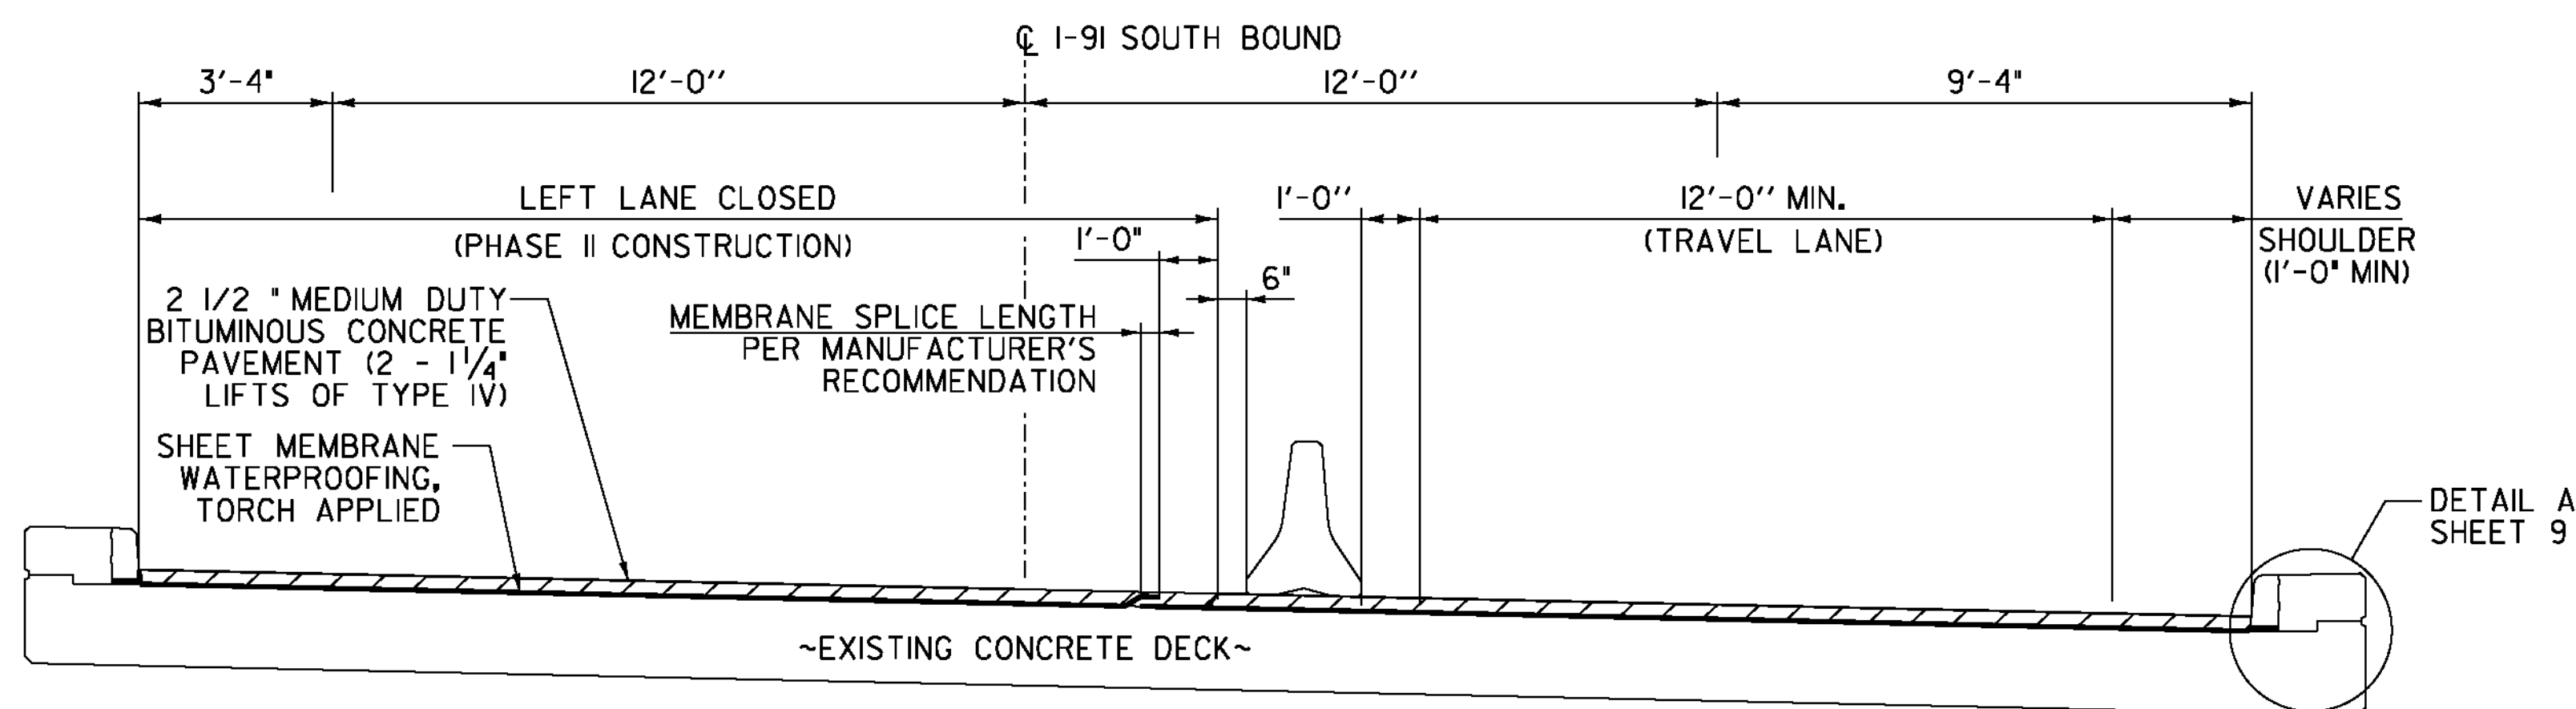

TYPICAL SECTION - PHASE II CONSTRUCTION - BRIDGE NO. 81S
NOT TO SCALE

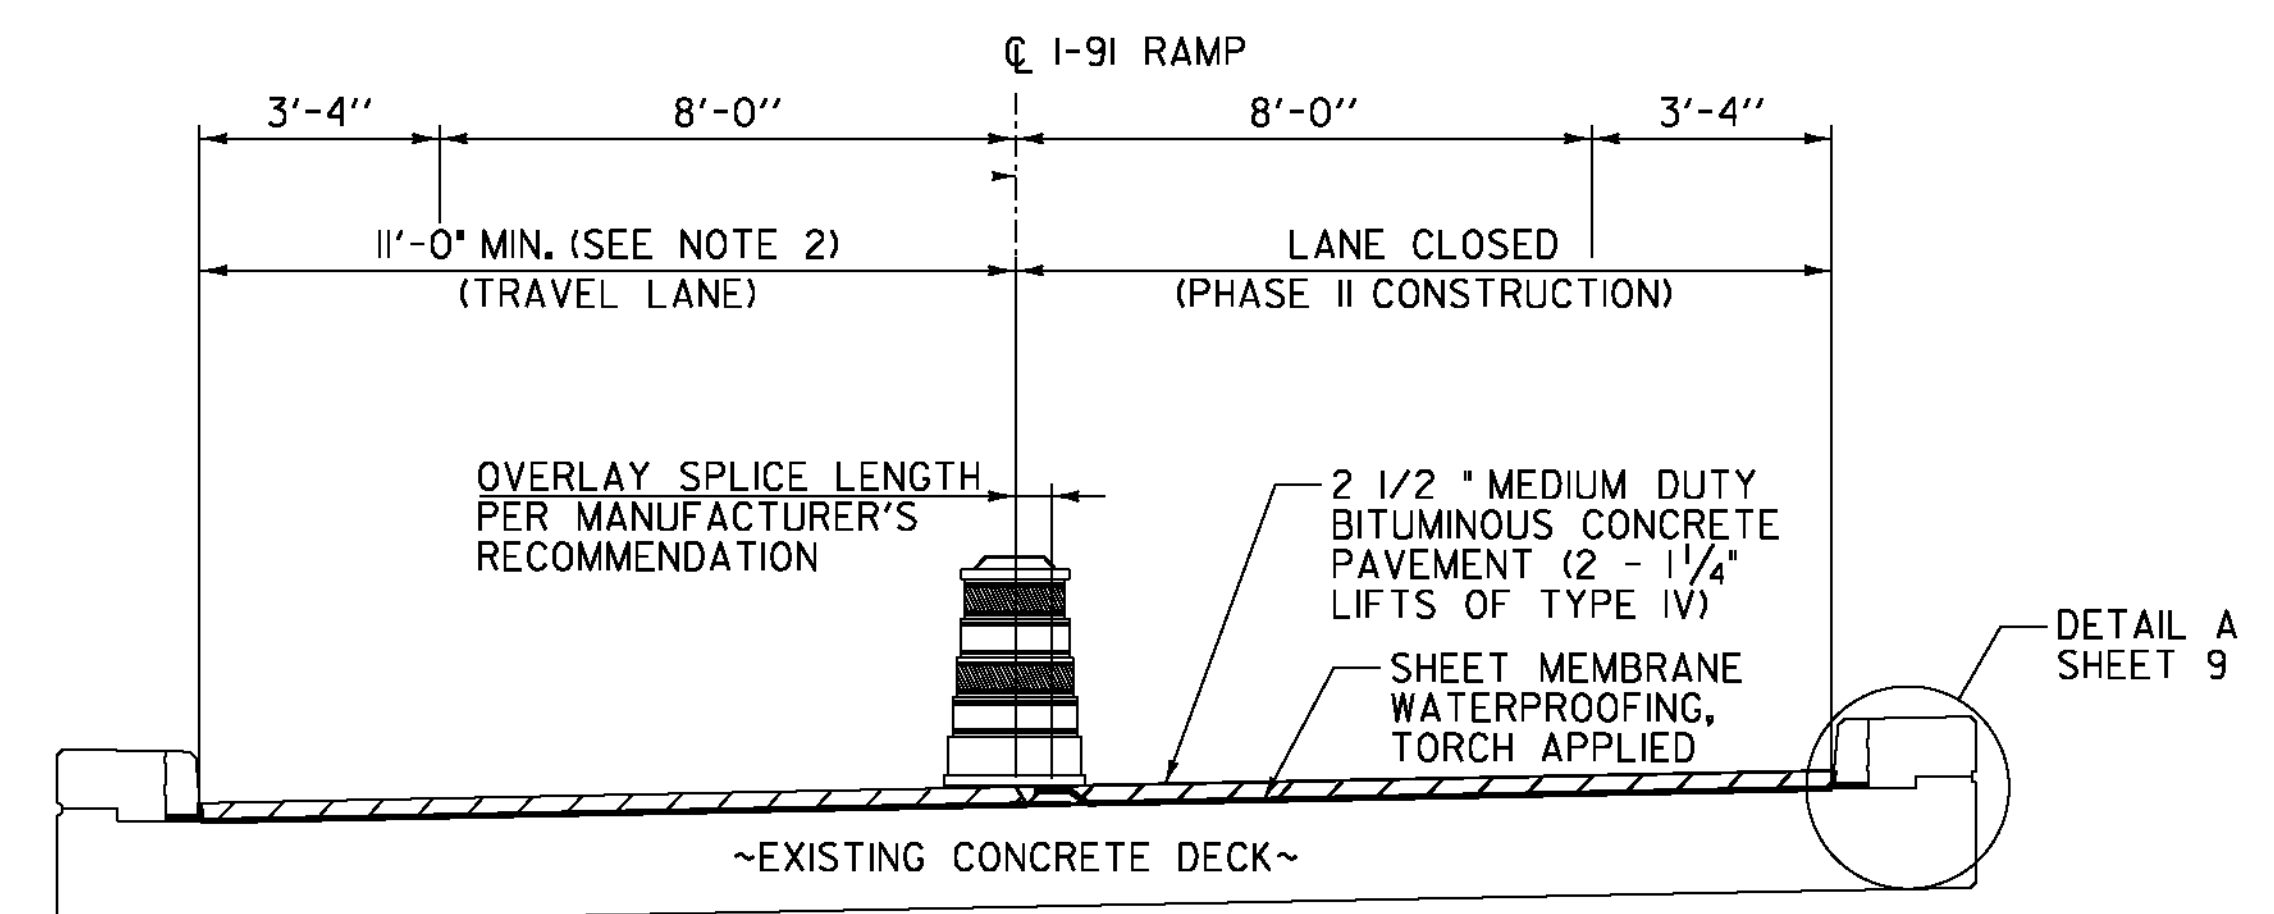

TYPICAL SECTION - PHASE II CONSTRUCTION - BRIDGE NO. 81B
NOT TO SCALE

NOTES:

1. PLACEMENT OF THE MEMBRANE SHALL START AT THE LOW SIDE OF THE BRIDGE. THE SPLICE SHALL BE AS SHOWN ABOVE, WITH THE HIGH SIDE OVERLAPPING THE LOW SIDE.
2. TEMPORARY BARRELS SHALL BE MOVED AND REPLACED AS NECESSARY TO ACCOMMODATE OVERSIZED VEHICLES AND CONSTRUCTION ACTIVITIES. PAYMENT SHALL BE INCIDENTAL TO ITEM 641.10.

PROJECT NAME: WATERFORD - ST. JOHNSBURY
PROJECT NUMBER: IM MEMB(32)

FILE NAME: s1a298conc_details.dgn PLOT DATE: 3/15/2012
PROJECT LEADER: JPB DRAWN BY: MWS
DESIGNED BY: SRB CHECKED BY: JF
BITUMINOUS CONCRETE DETAILS SHEET 2 SHEET 10 OF 43