
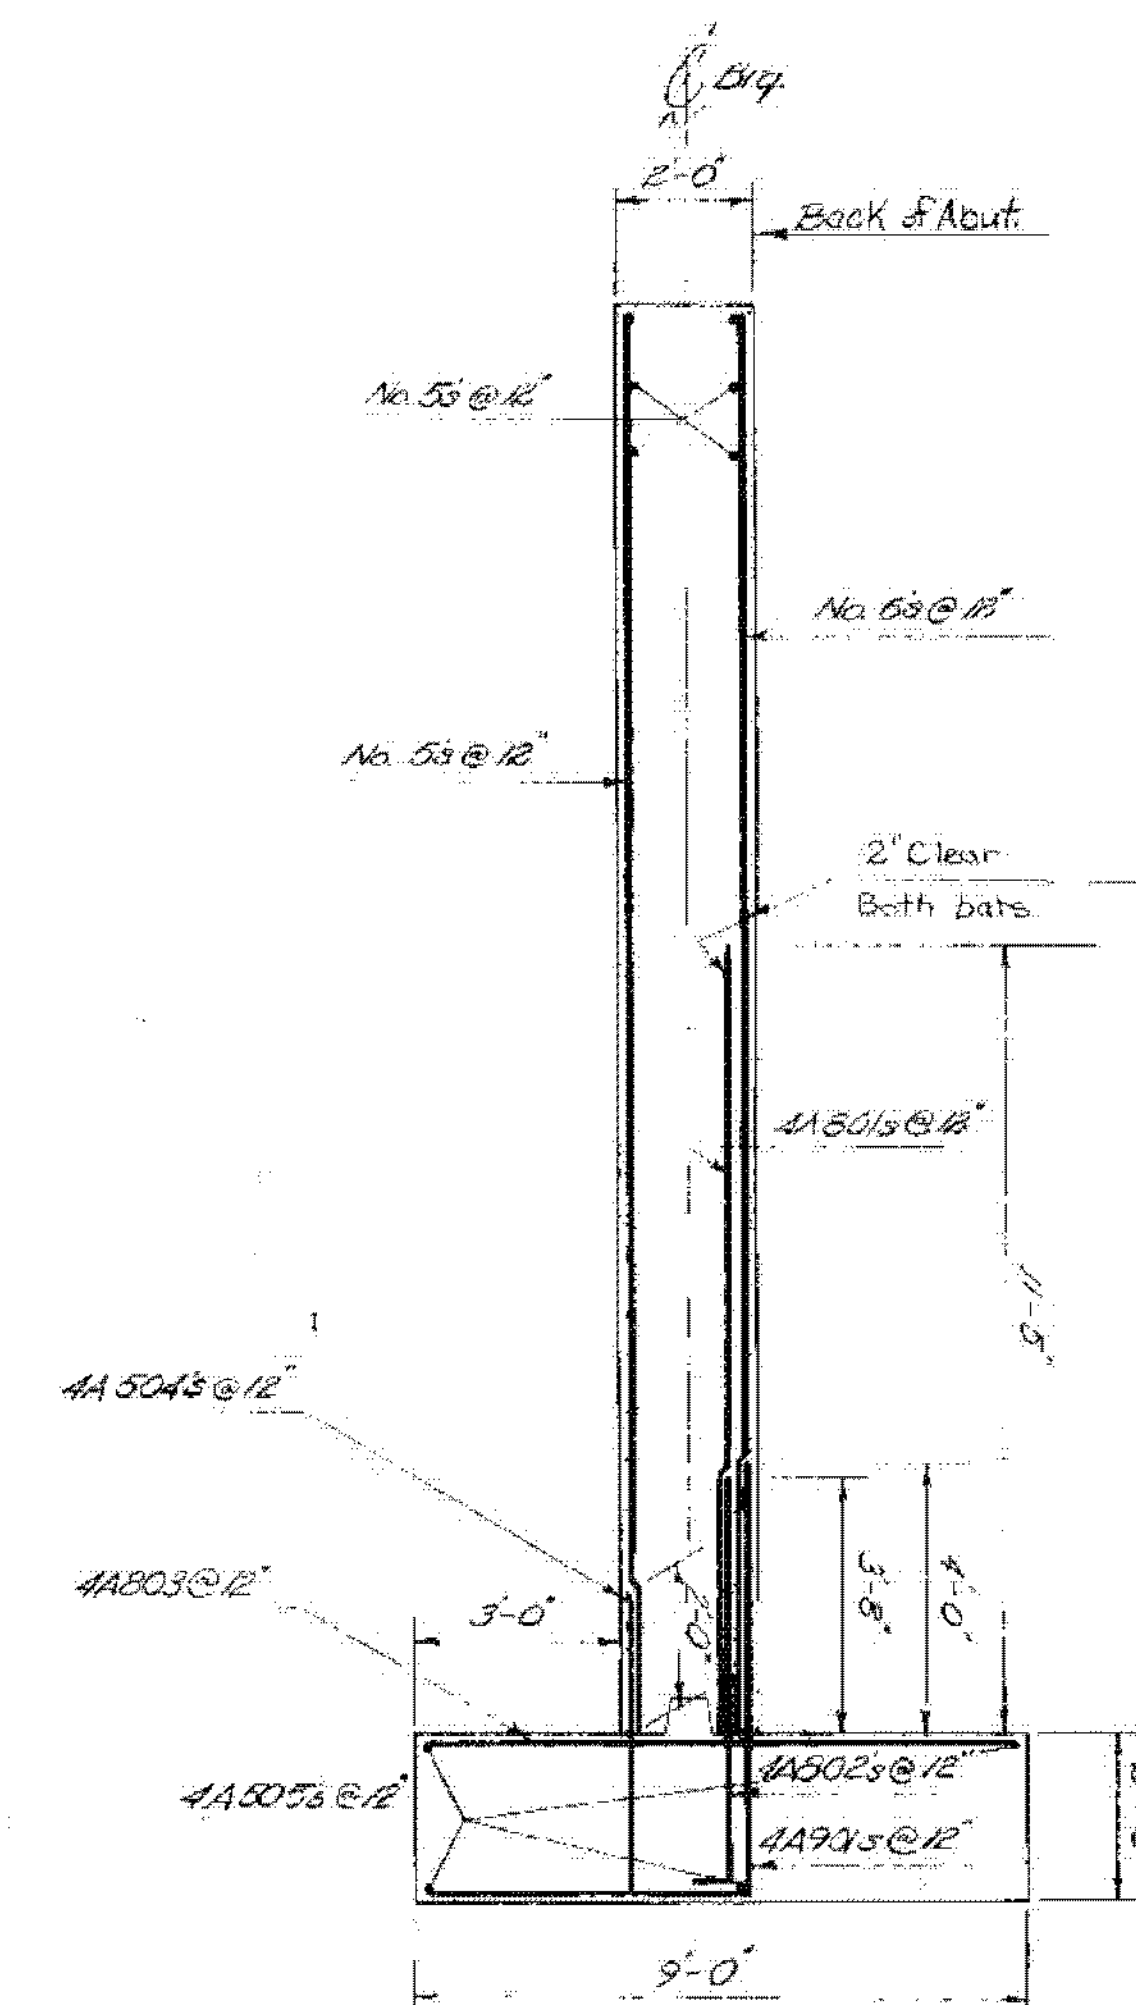
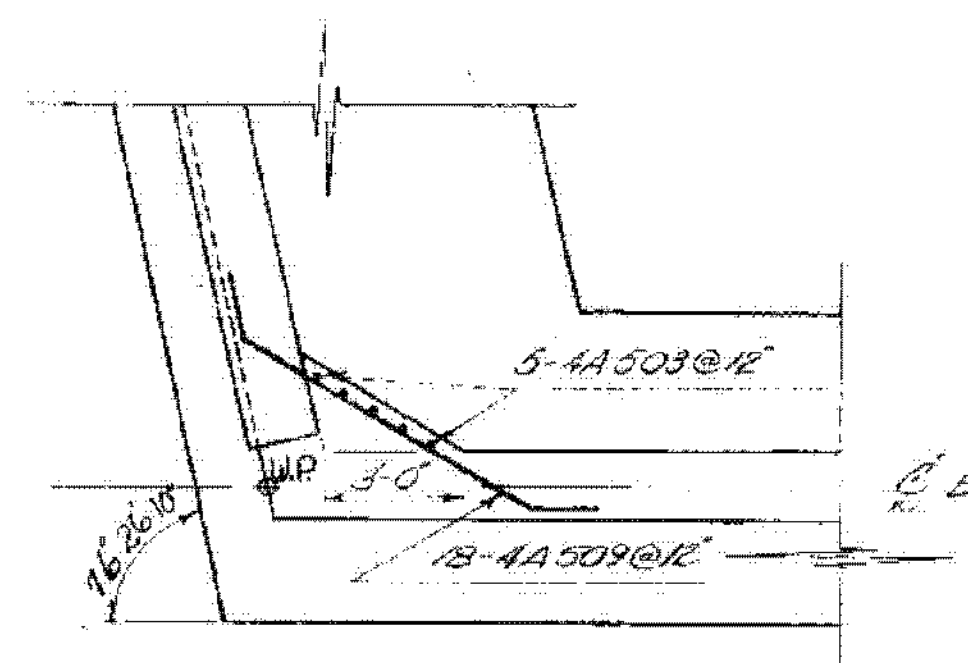
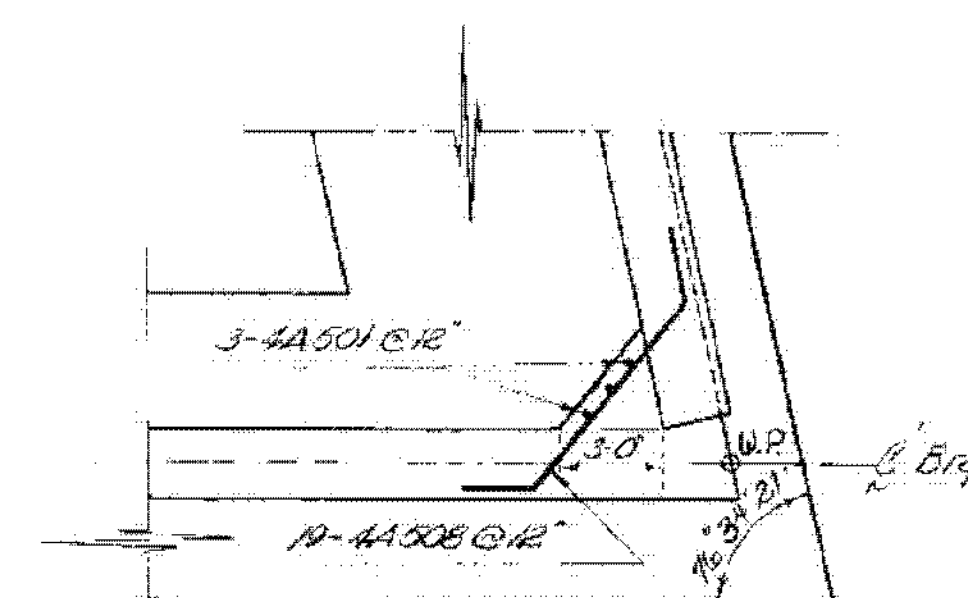
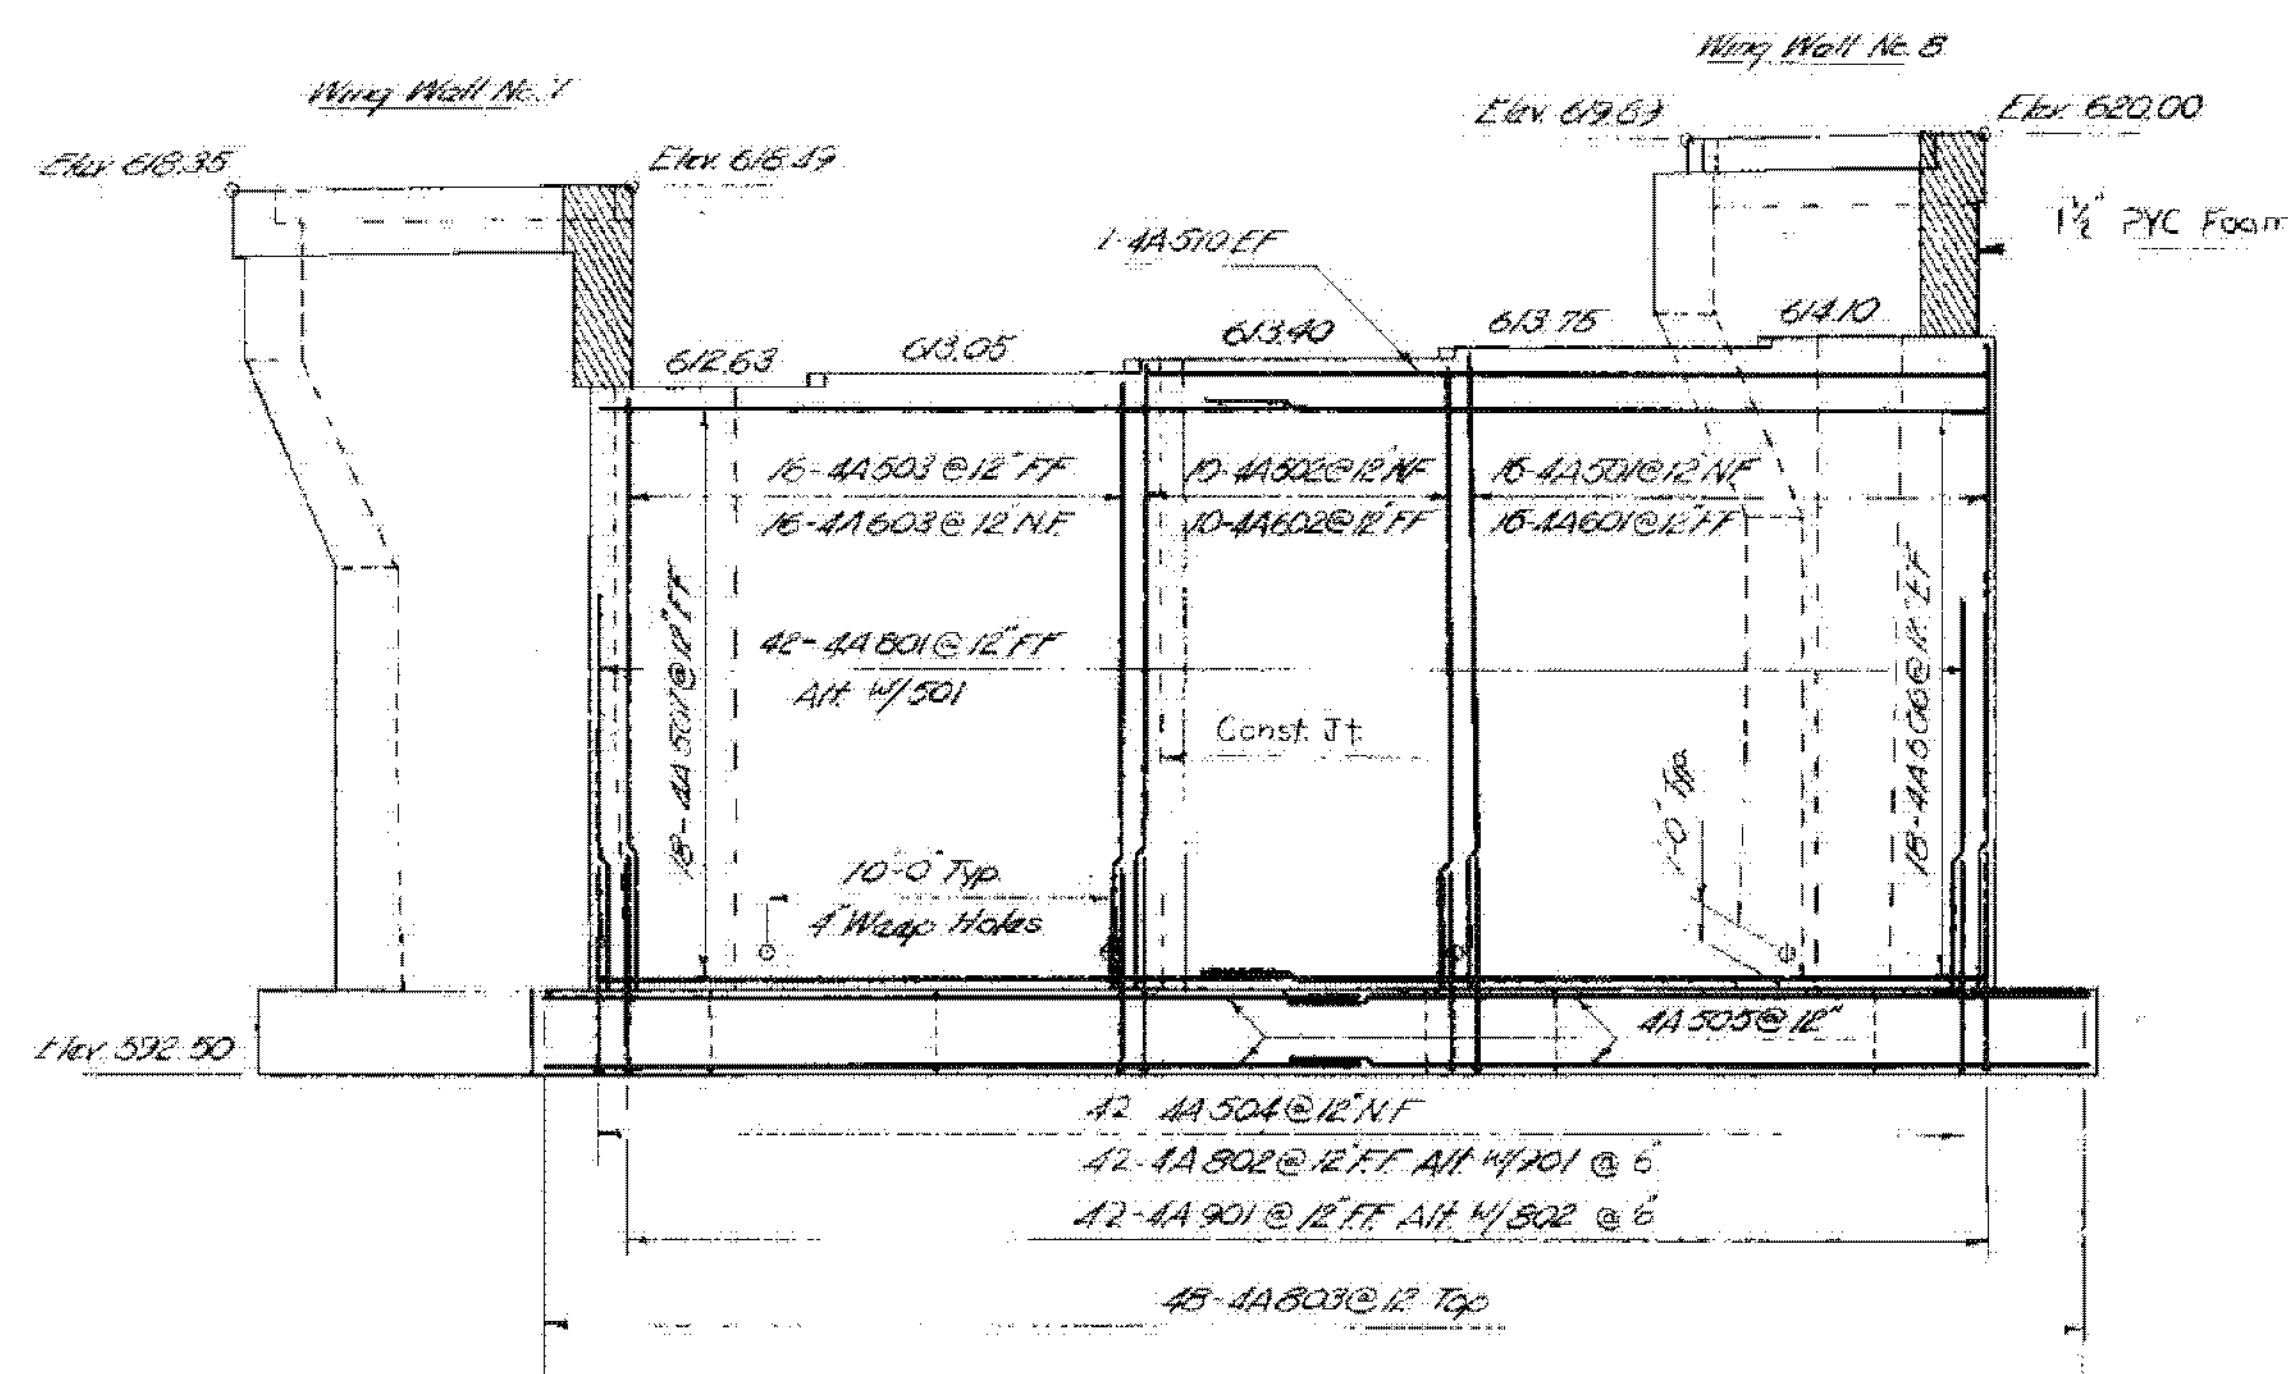


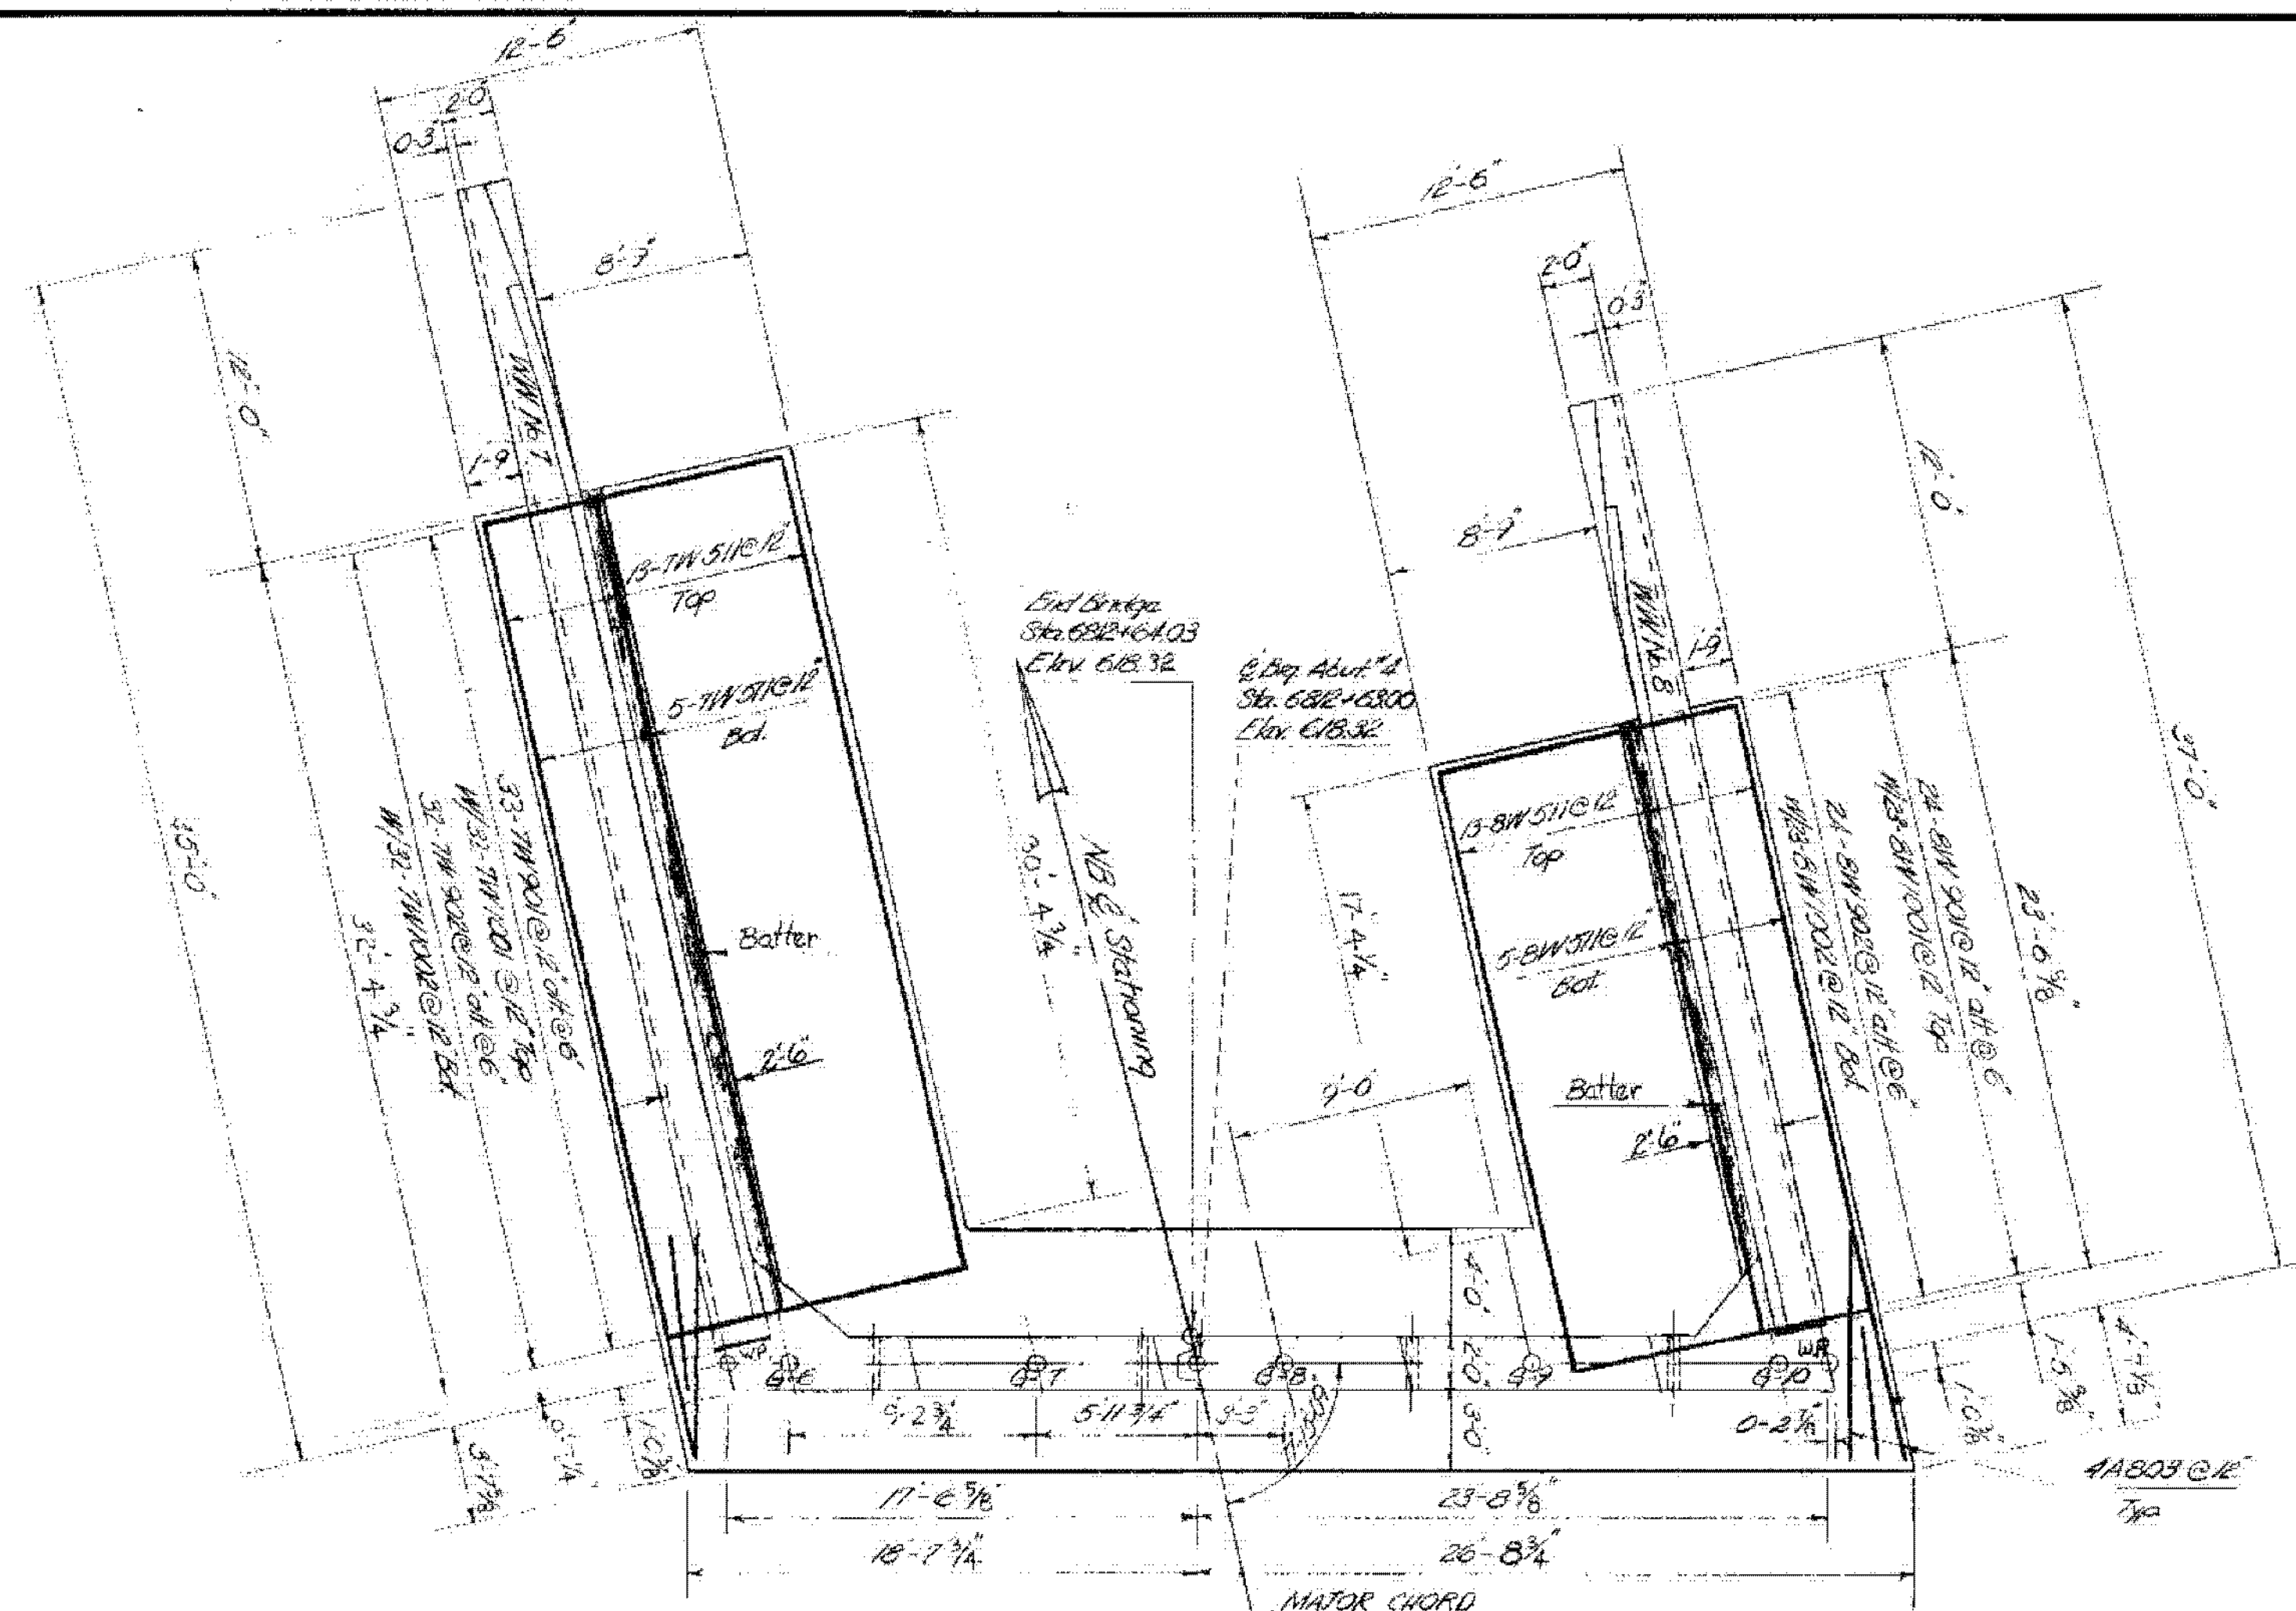

Note:
1. For quantity limit typical see BR412.

I-91 BRIDGES 81&S	
WATERFORD - ST. JOHNSBURY IM MEMB(32) SHEET 24 OF 43 FOR REFERENCE ONLY	

STATE OF DEPARTMENT OF HIGHWAYS	
TOWN OF <i>Waterford</i>	Bridge No. <i>4</i>
HIGHWAY NO. <i>I 91</i>	Log Sta. _____ Surv. Sta. _____
<i>Int. Rte. I91 NB Over Ramp S to E</i> <i>NB Abutment 4</i>	
Designed by <i>M. Danforth</i> Checked by <i>J. Burnett</i> date <i>3-19-76</i>	Drawn by <i>W. Stoddard</i> Bridge Design Supervisor <i>R. Haupt</i> date <i>3-19-76</i>
PROJECT <i>Barnet - St. Johnsbury</i>	PROJECT NO. <i>EAC I91 - 2(59)</i>
Bridge Sheet No. <i>BR 416</i>	Sheet <i>119 a</i> of <i>353</i>