




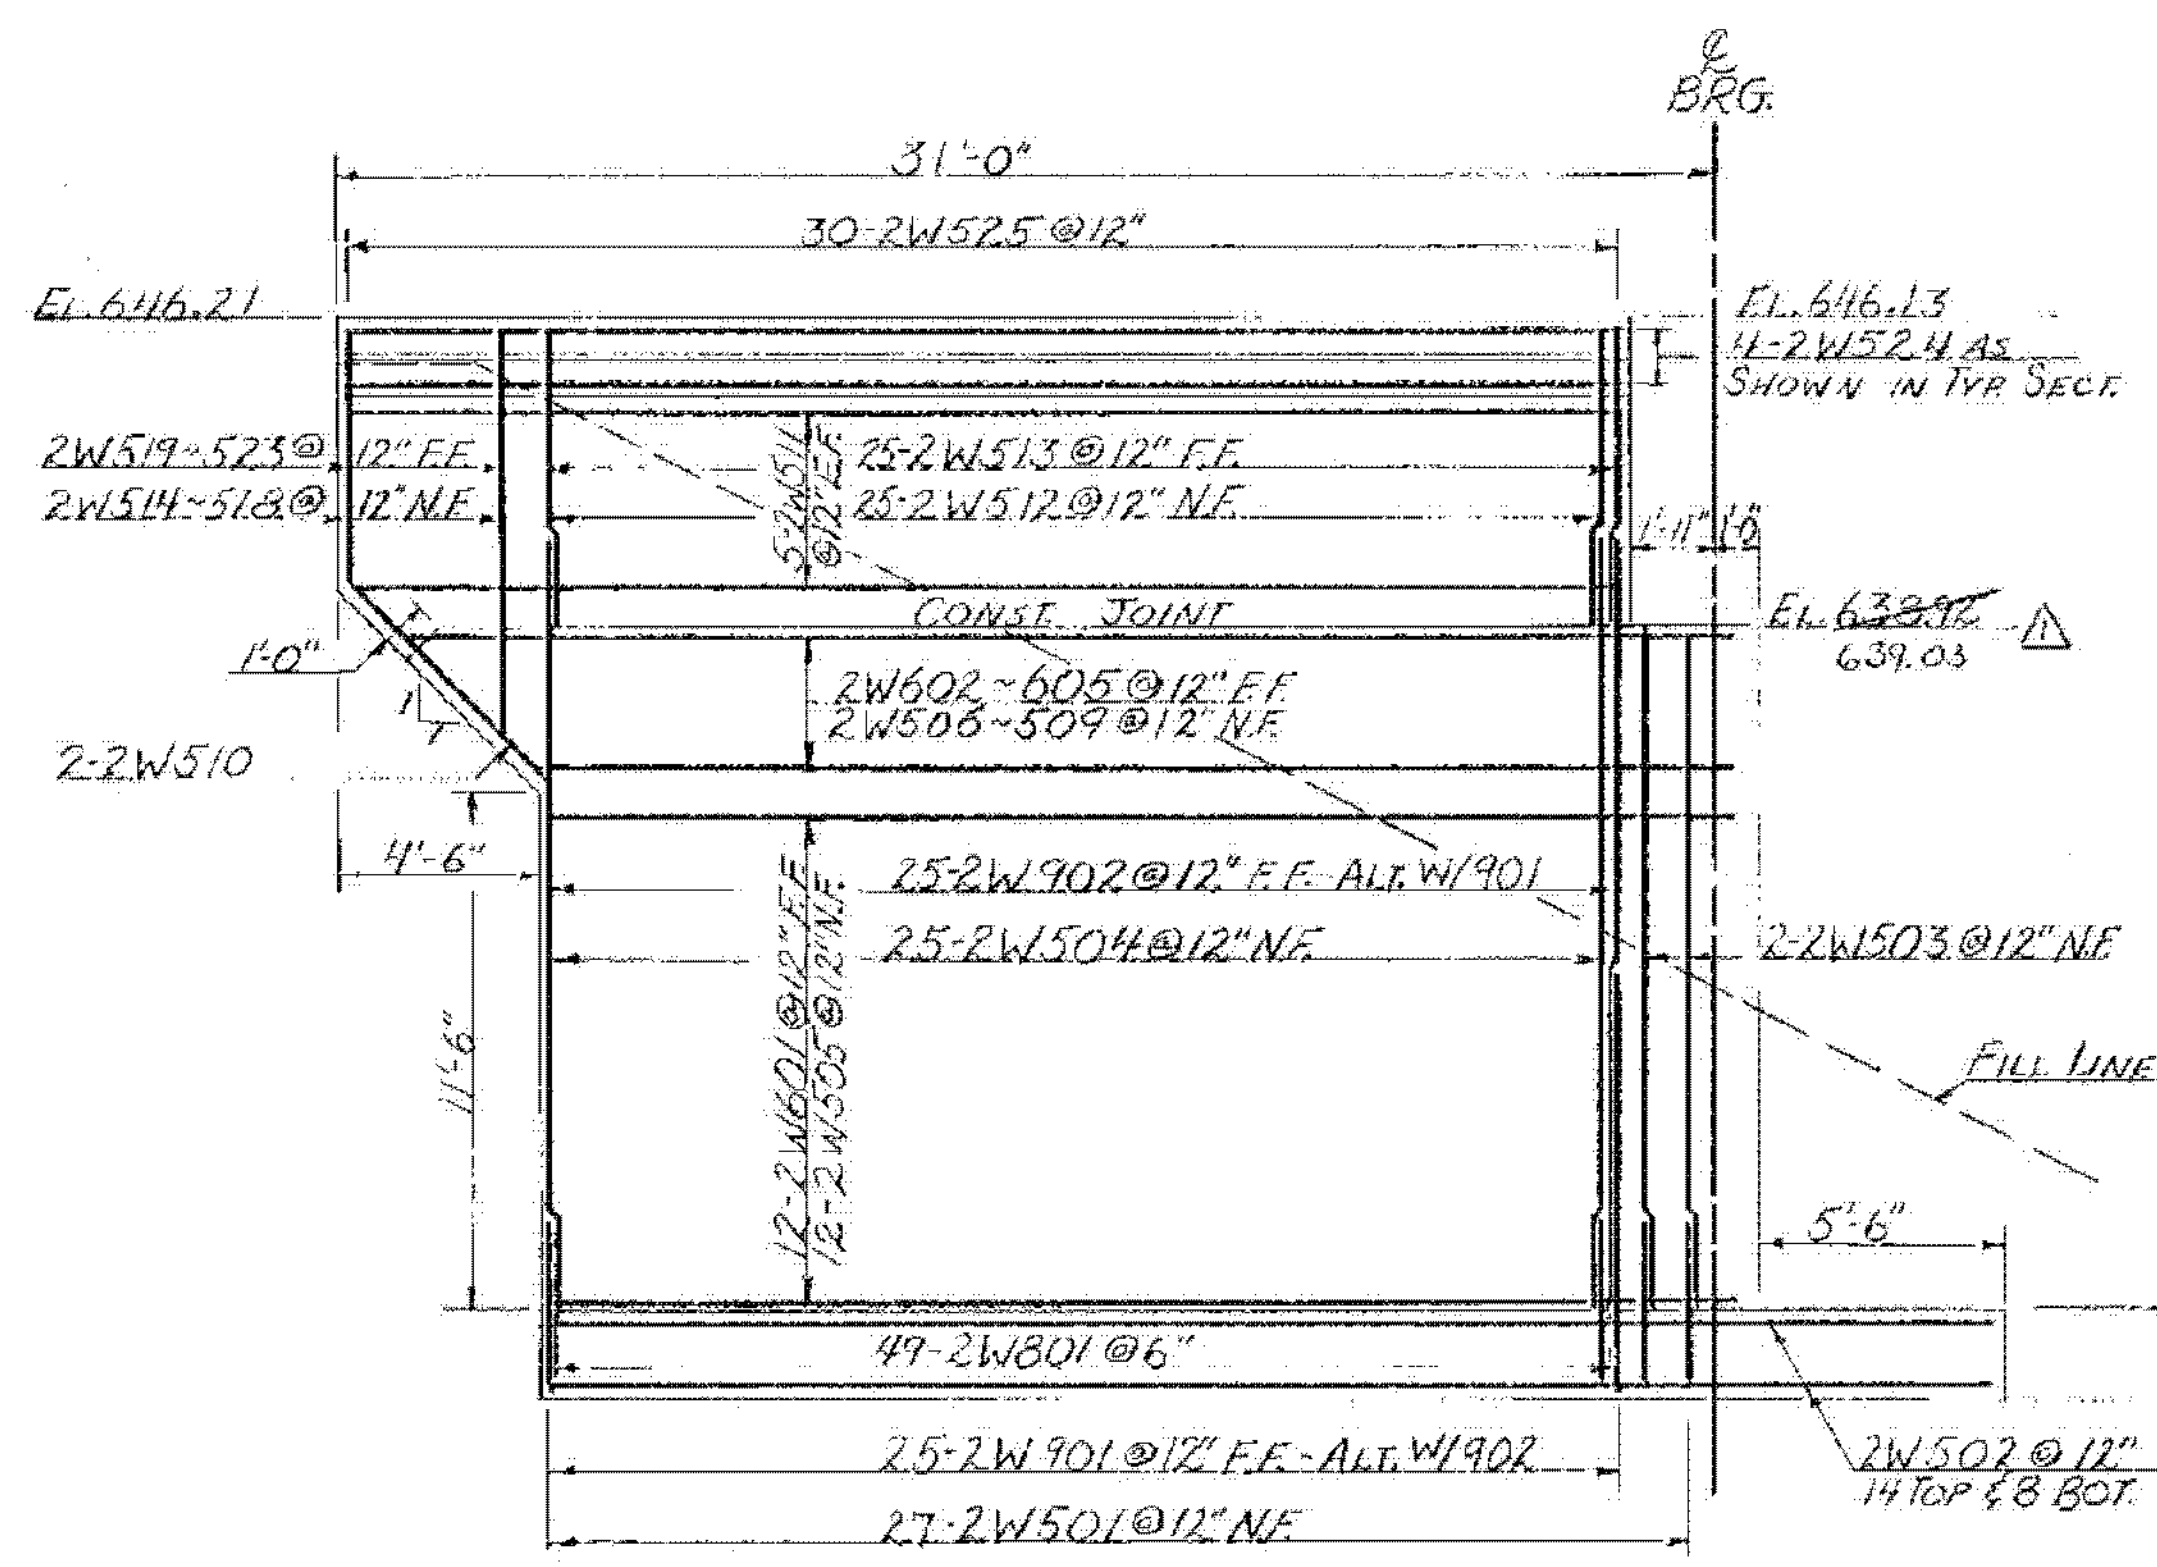


W.W.*2 ELEVATION
SCALE: 1/4" = 1'-0"

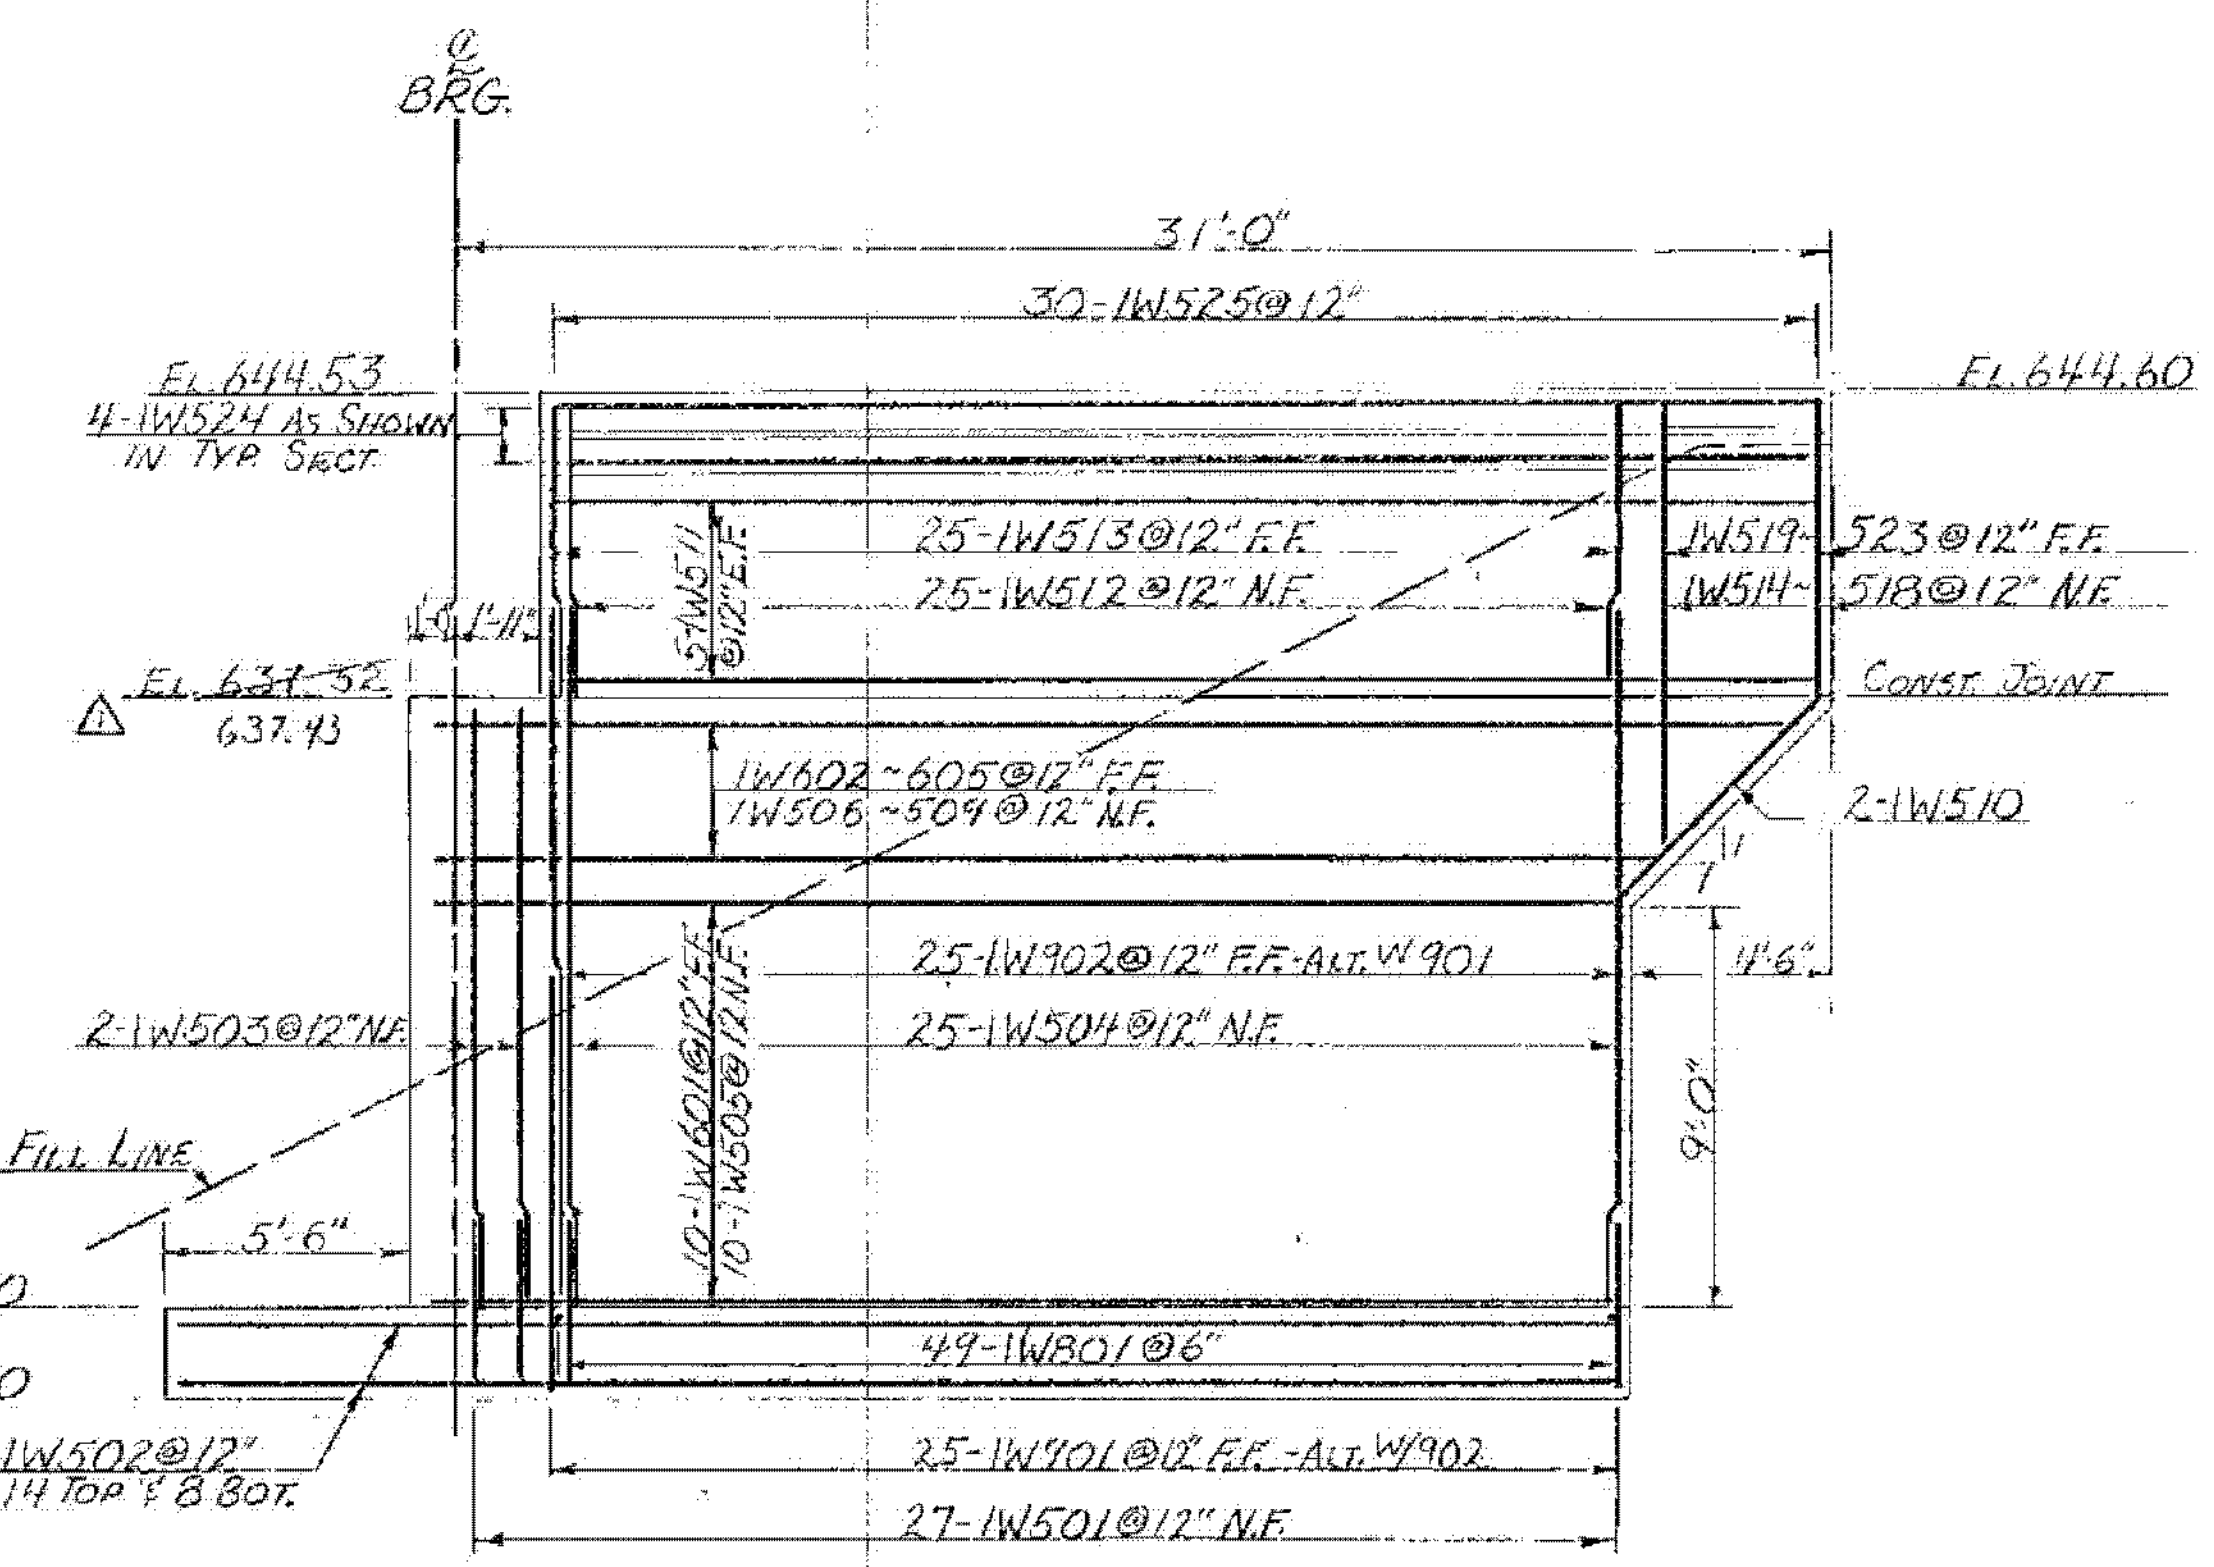


W.W.*1 ELEVATION
SCALE: 1/4" = 1'-0"

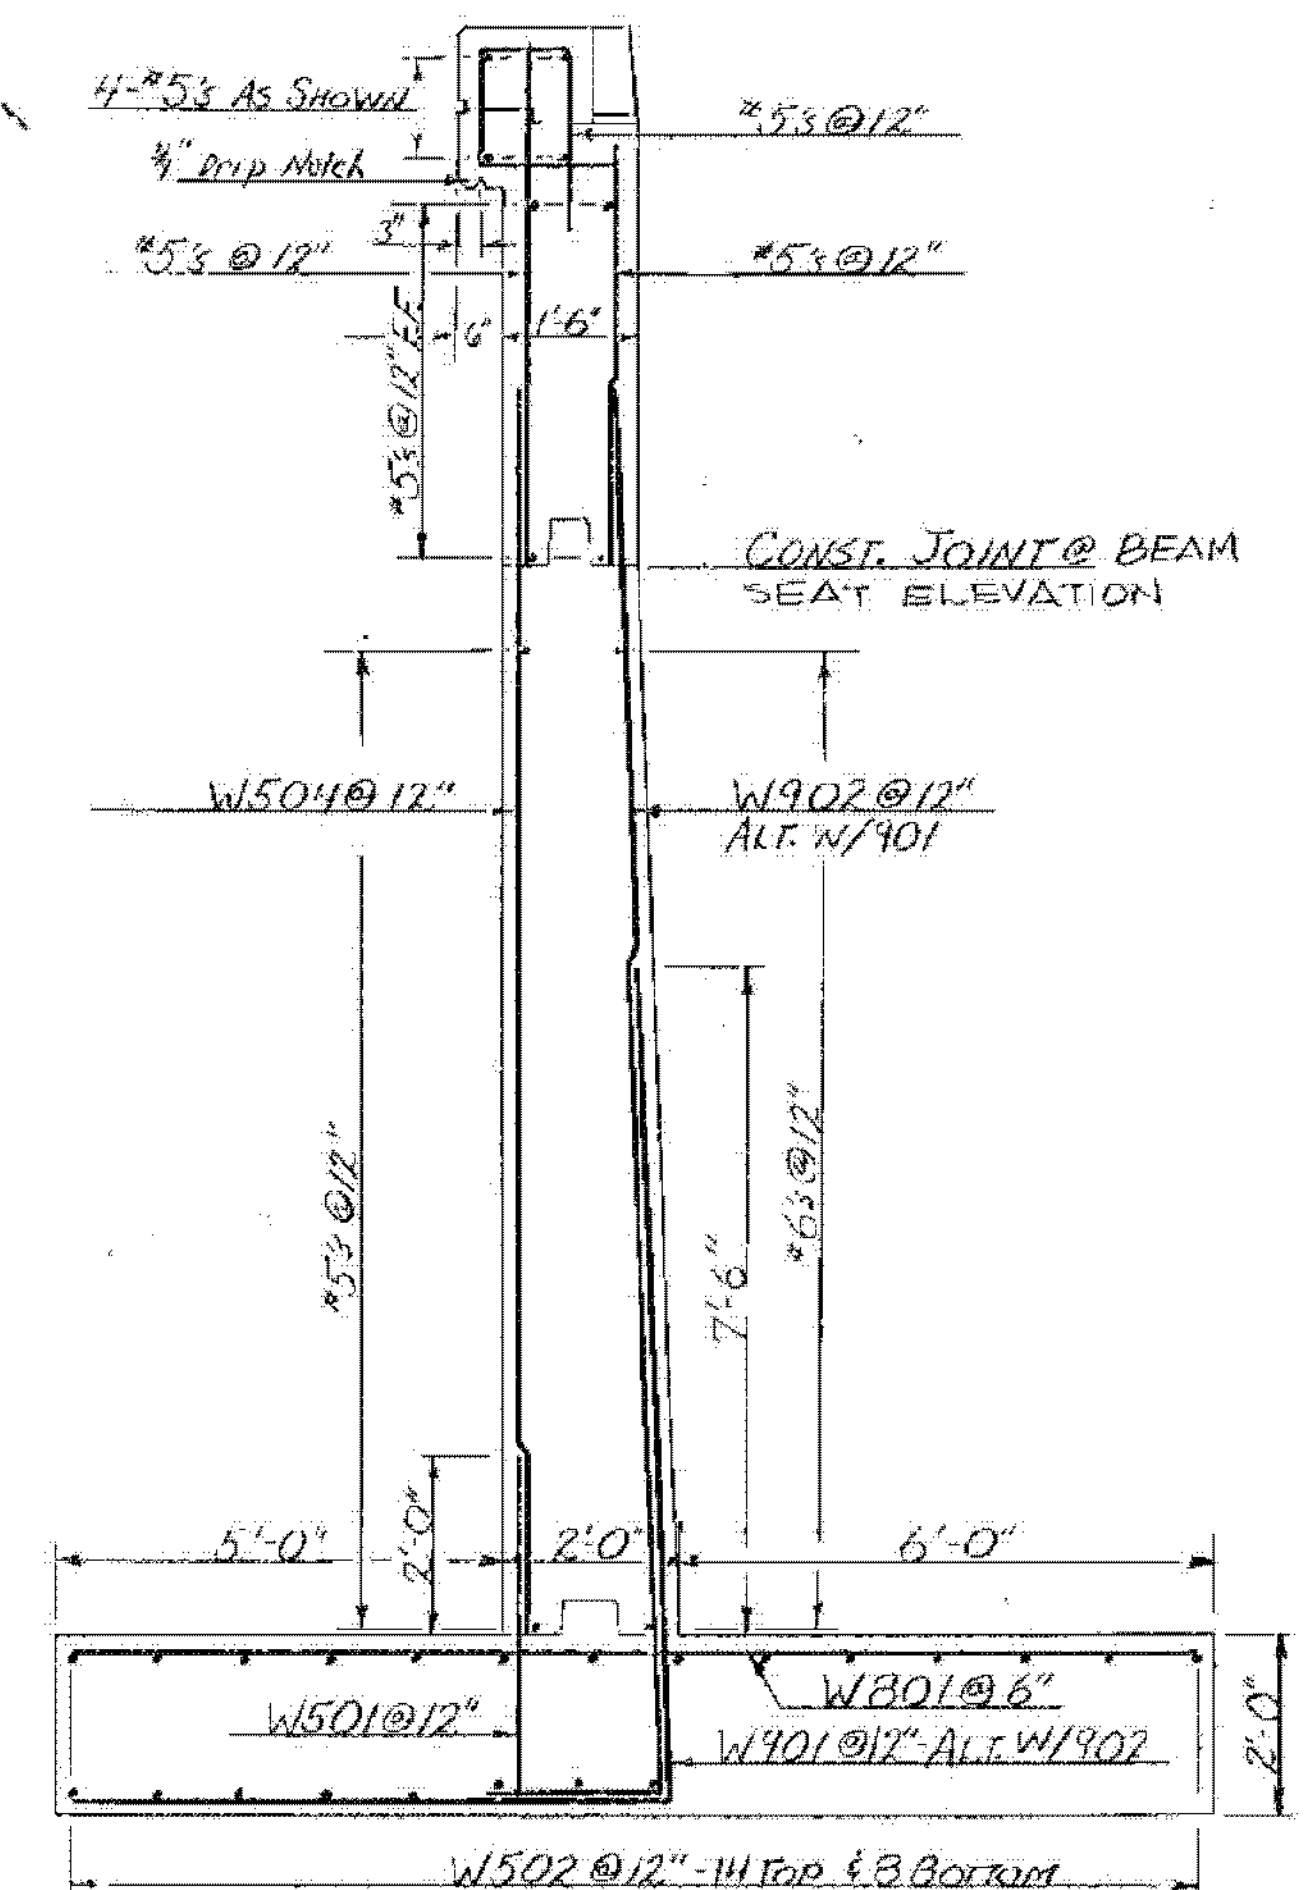

TYPICAL SECTION
SCALE: 1/2" = 1'-0"

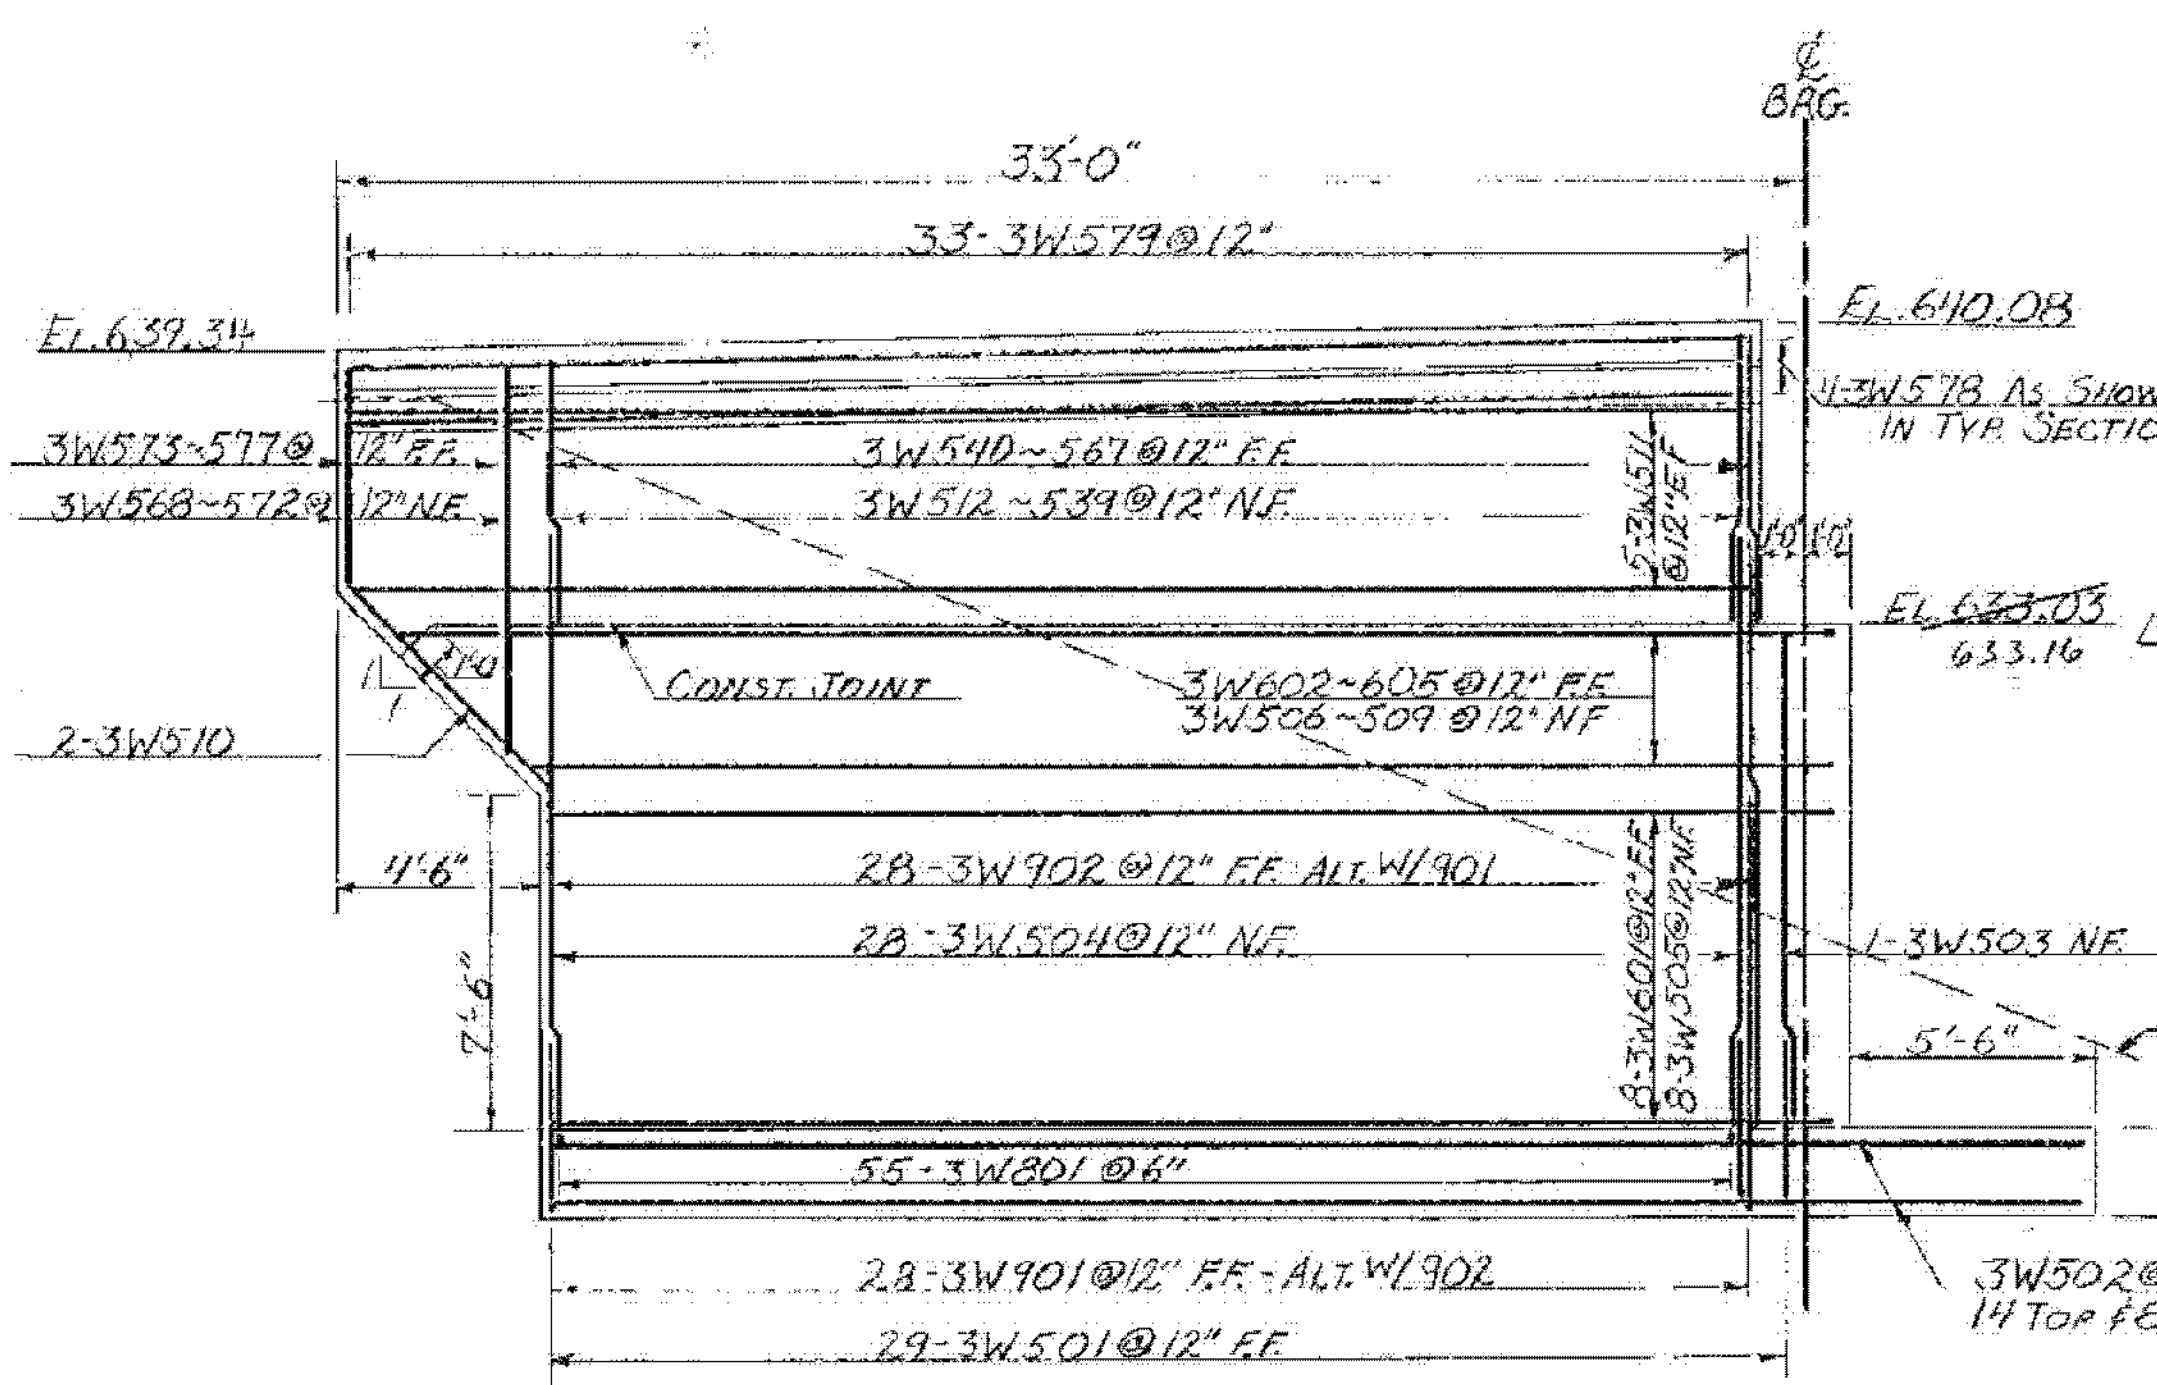

W.W.*3 ELEVATION
SCALE: 1/4" = 1'-0"

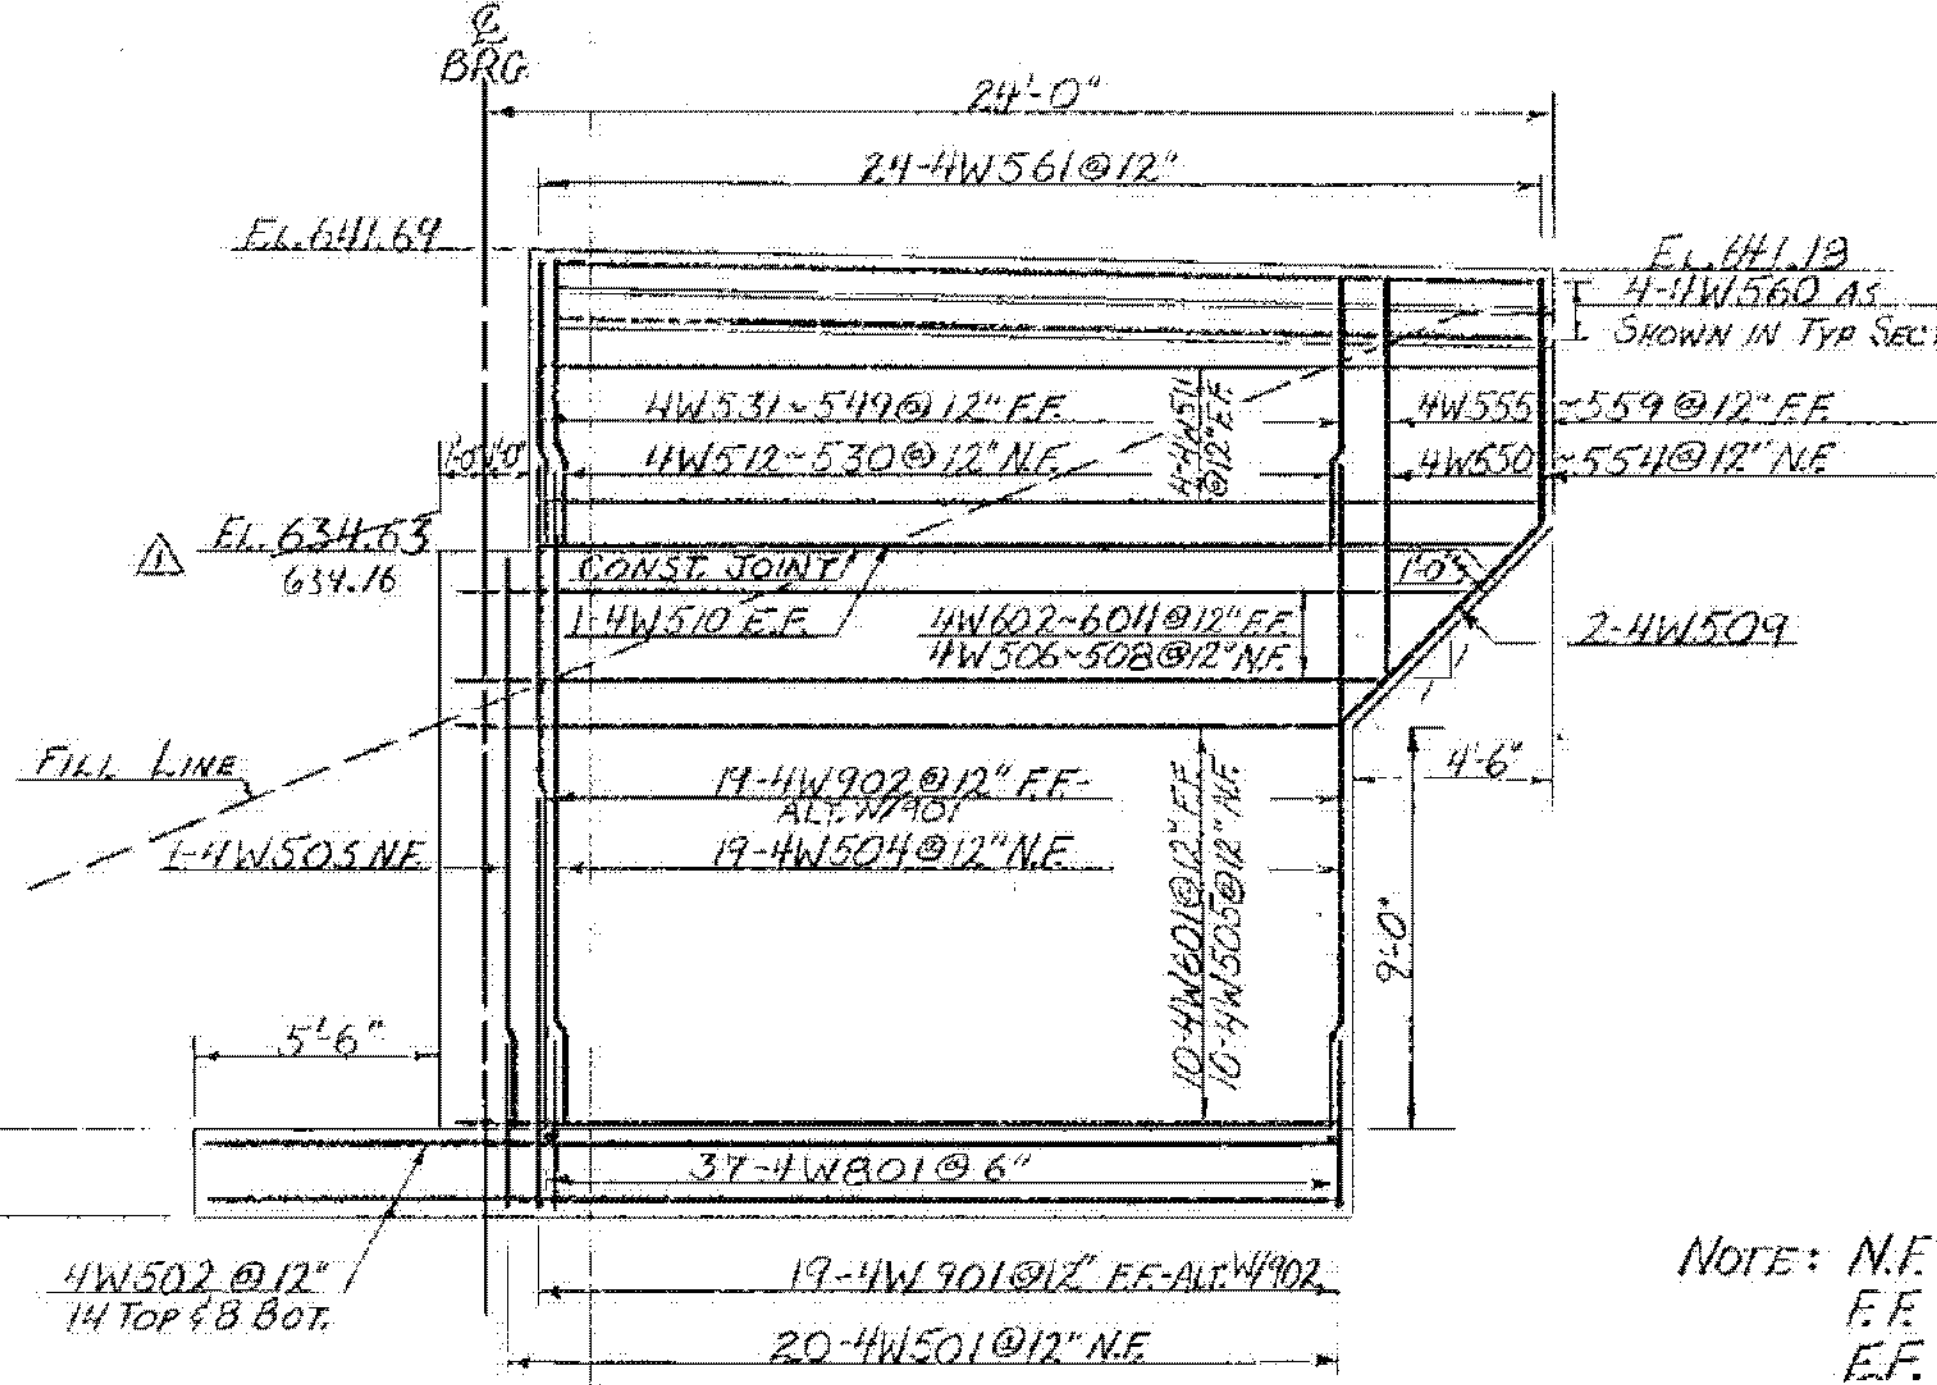

W.W.*4 ELEVATION
SCALE: 1/4" = 1'-0"

NOTE: N.F. = NEAR FACE
F.F. = FAR FACE
E.F. = EACH FACE

I-91 BRIDGES 81B
WATERFORD - ST. JOHNSBURY
IM MEMB(32)
SHEET 32 OF 43
FOR REFERENCE ONLY

STATE OF VERMONT AGENCY OF TRANSPORTATION			
TOWN OF	WATERFORD	Bridge No.	18
HIGHWAY NO.	I 93	Log Sta.	
WINGWALL 1,2,3 & 4 DETAILS		Surv. Sta.	RAMP W.S. 15+00
RAMP W.S. OVER I 91 NB+SB RAMP S. to E.			
Designed by	D. BURLEY	Drawn by	S. BASCOM
Checked by	A. Elwood	Bridge Design Supervisor	R.S. HAUT date 7-80
PROJECT	CONTRACT 3	PROJECT NO.	I 93-1(3)
WATERFORD		Bridge Sheet No.	BR 1810
		Sheet	167 of 550