




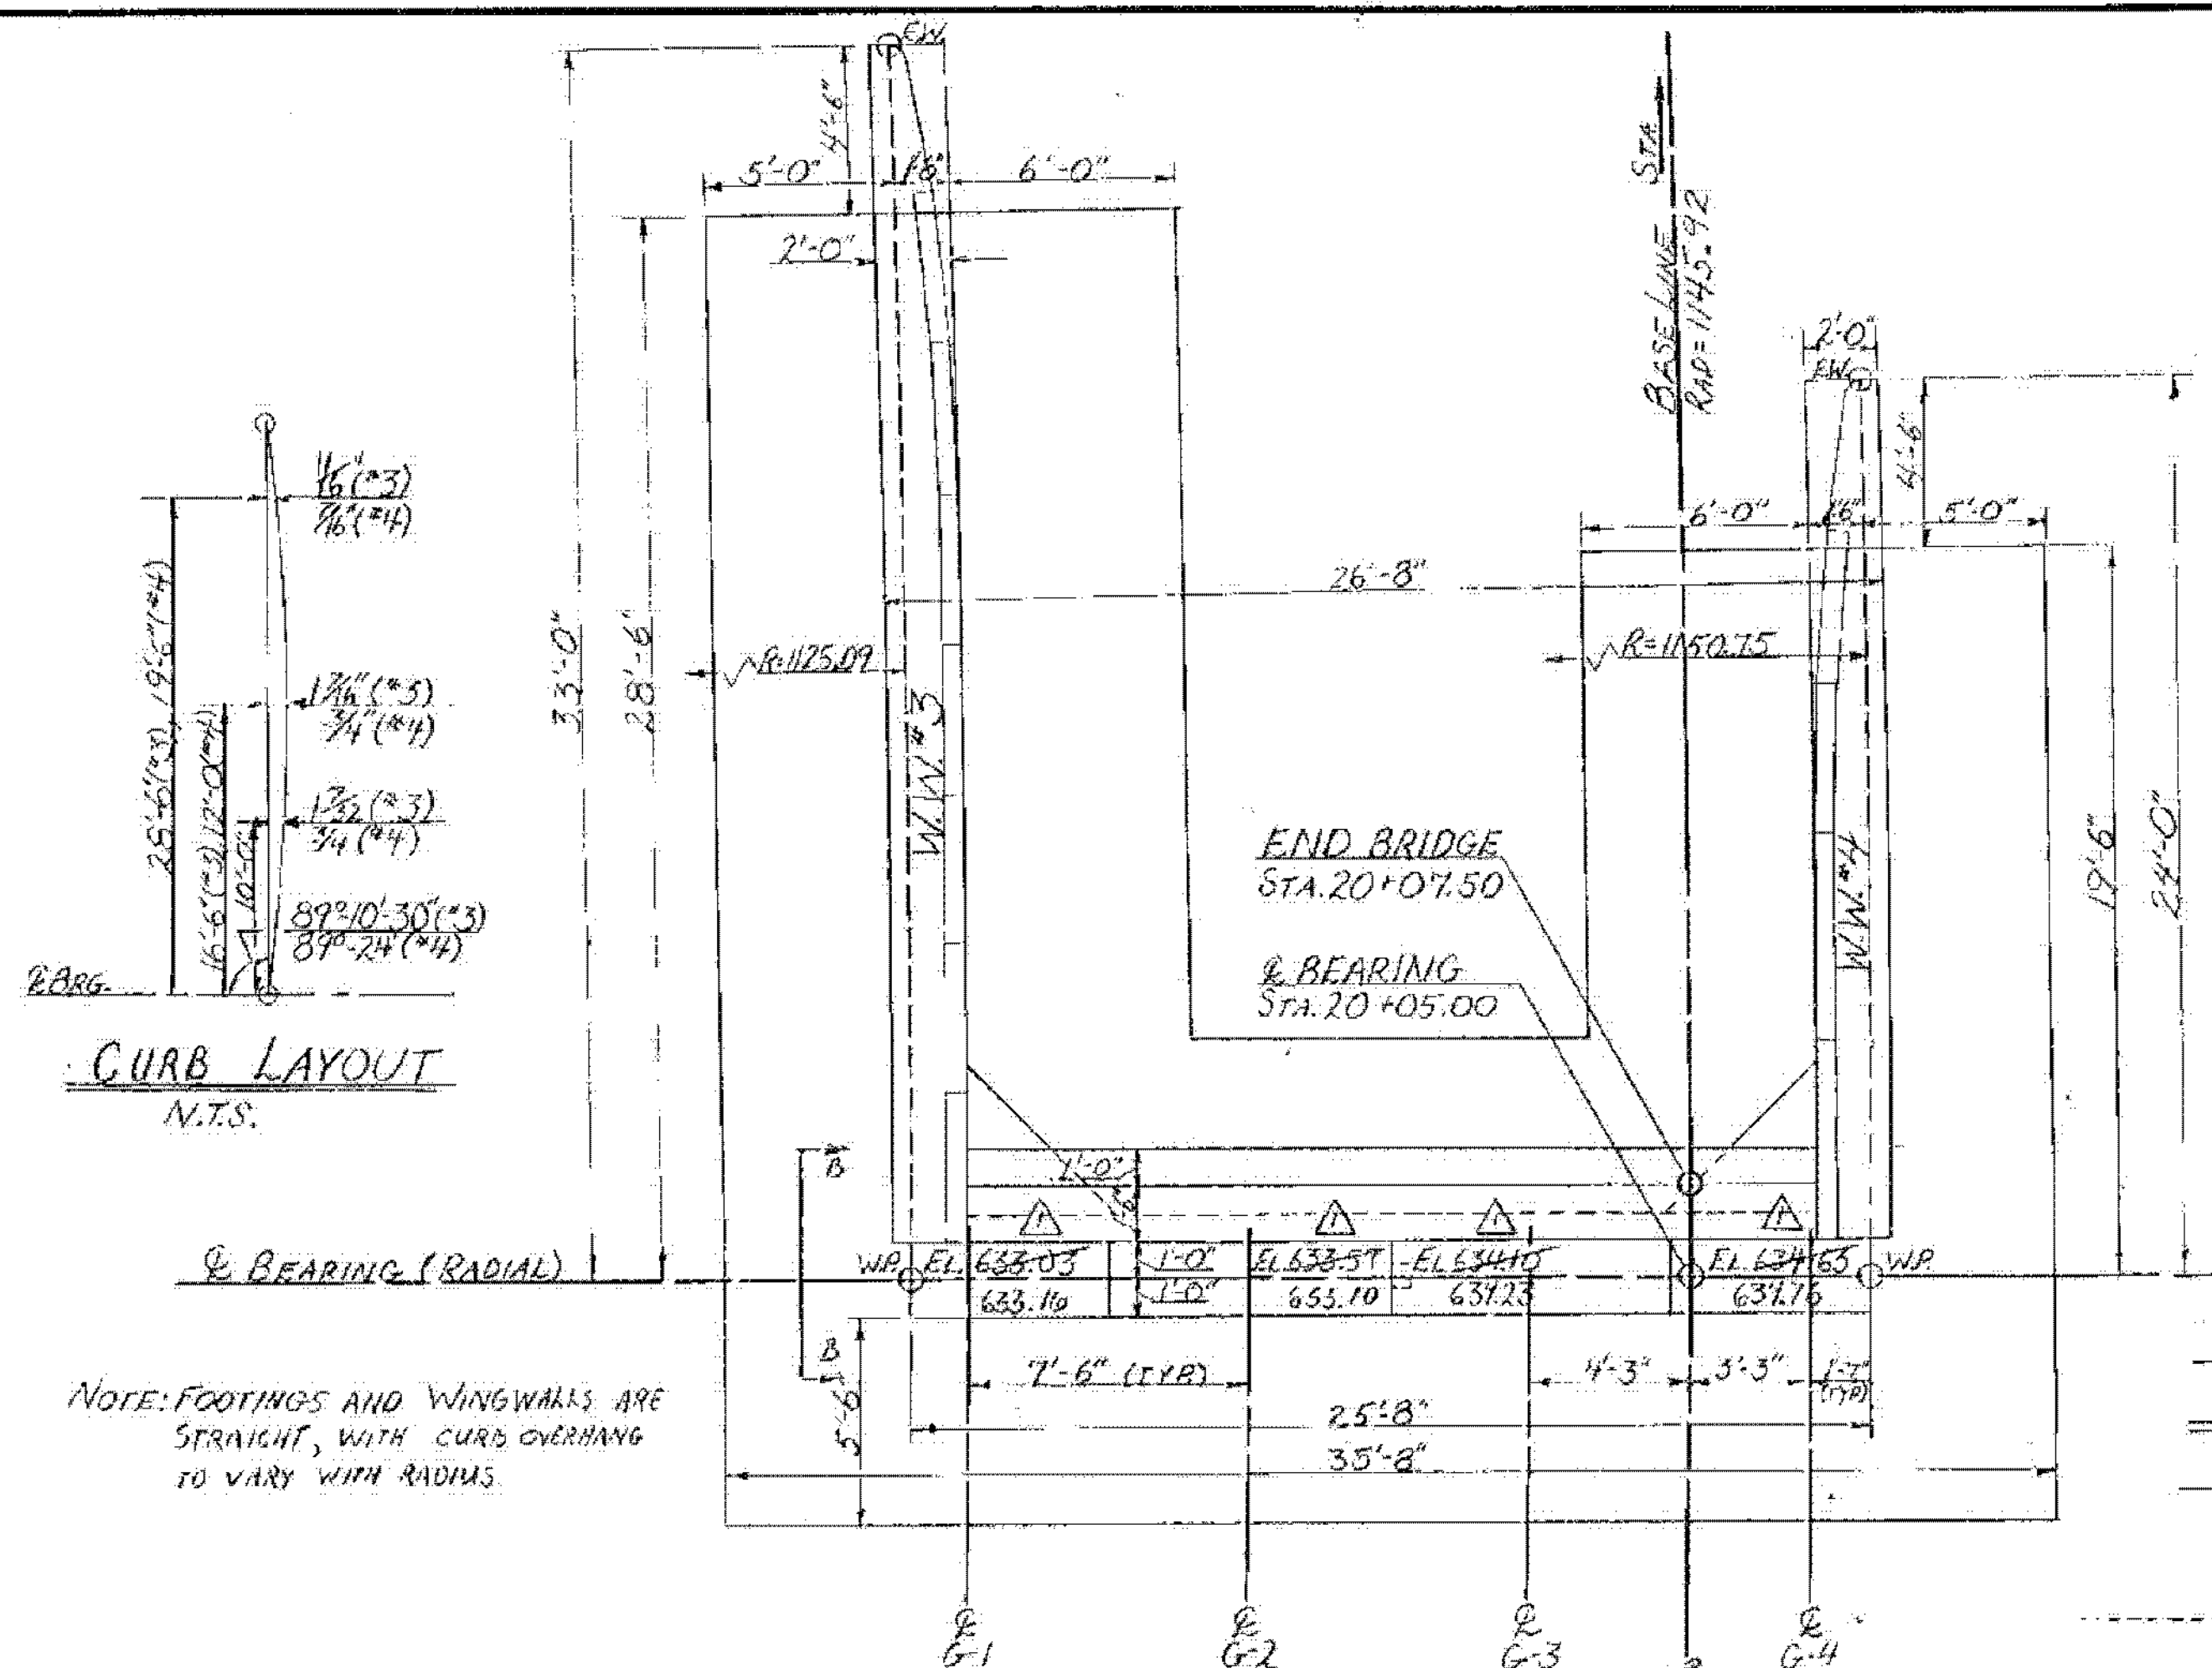


PLAN VIEW
SCALE: 1/4" = 1'-0"

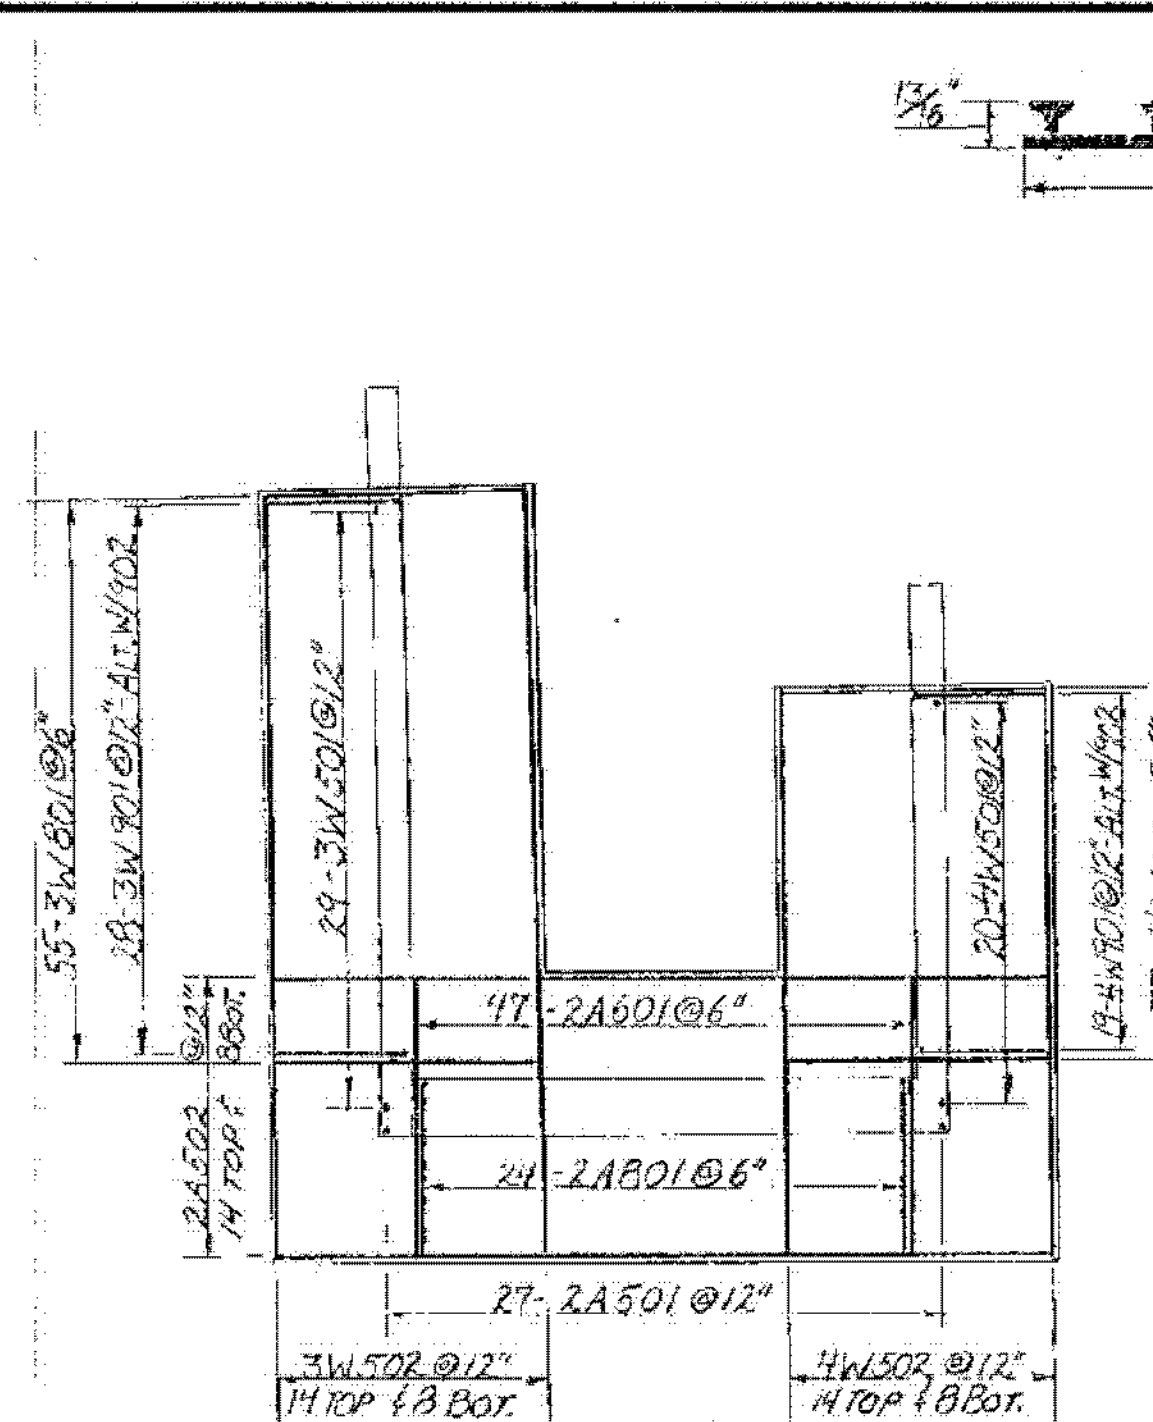


Elevation @ B-13
SCALE: 1/2" = 1'-0"

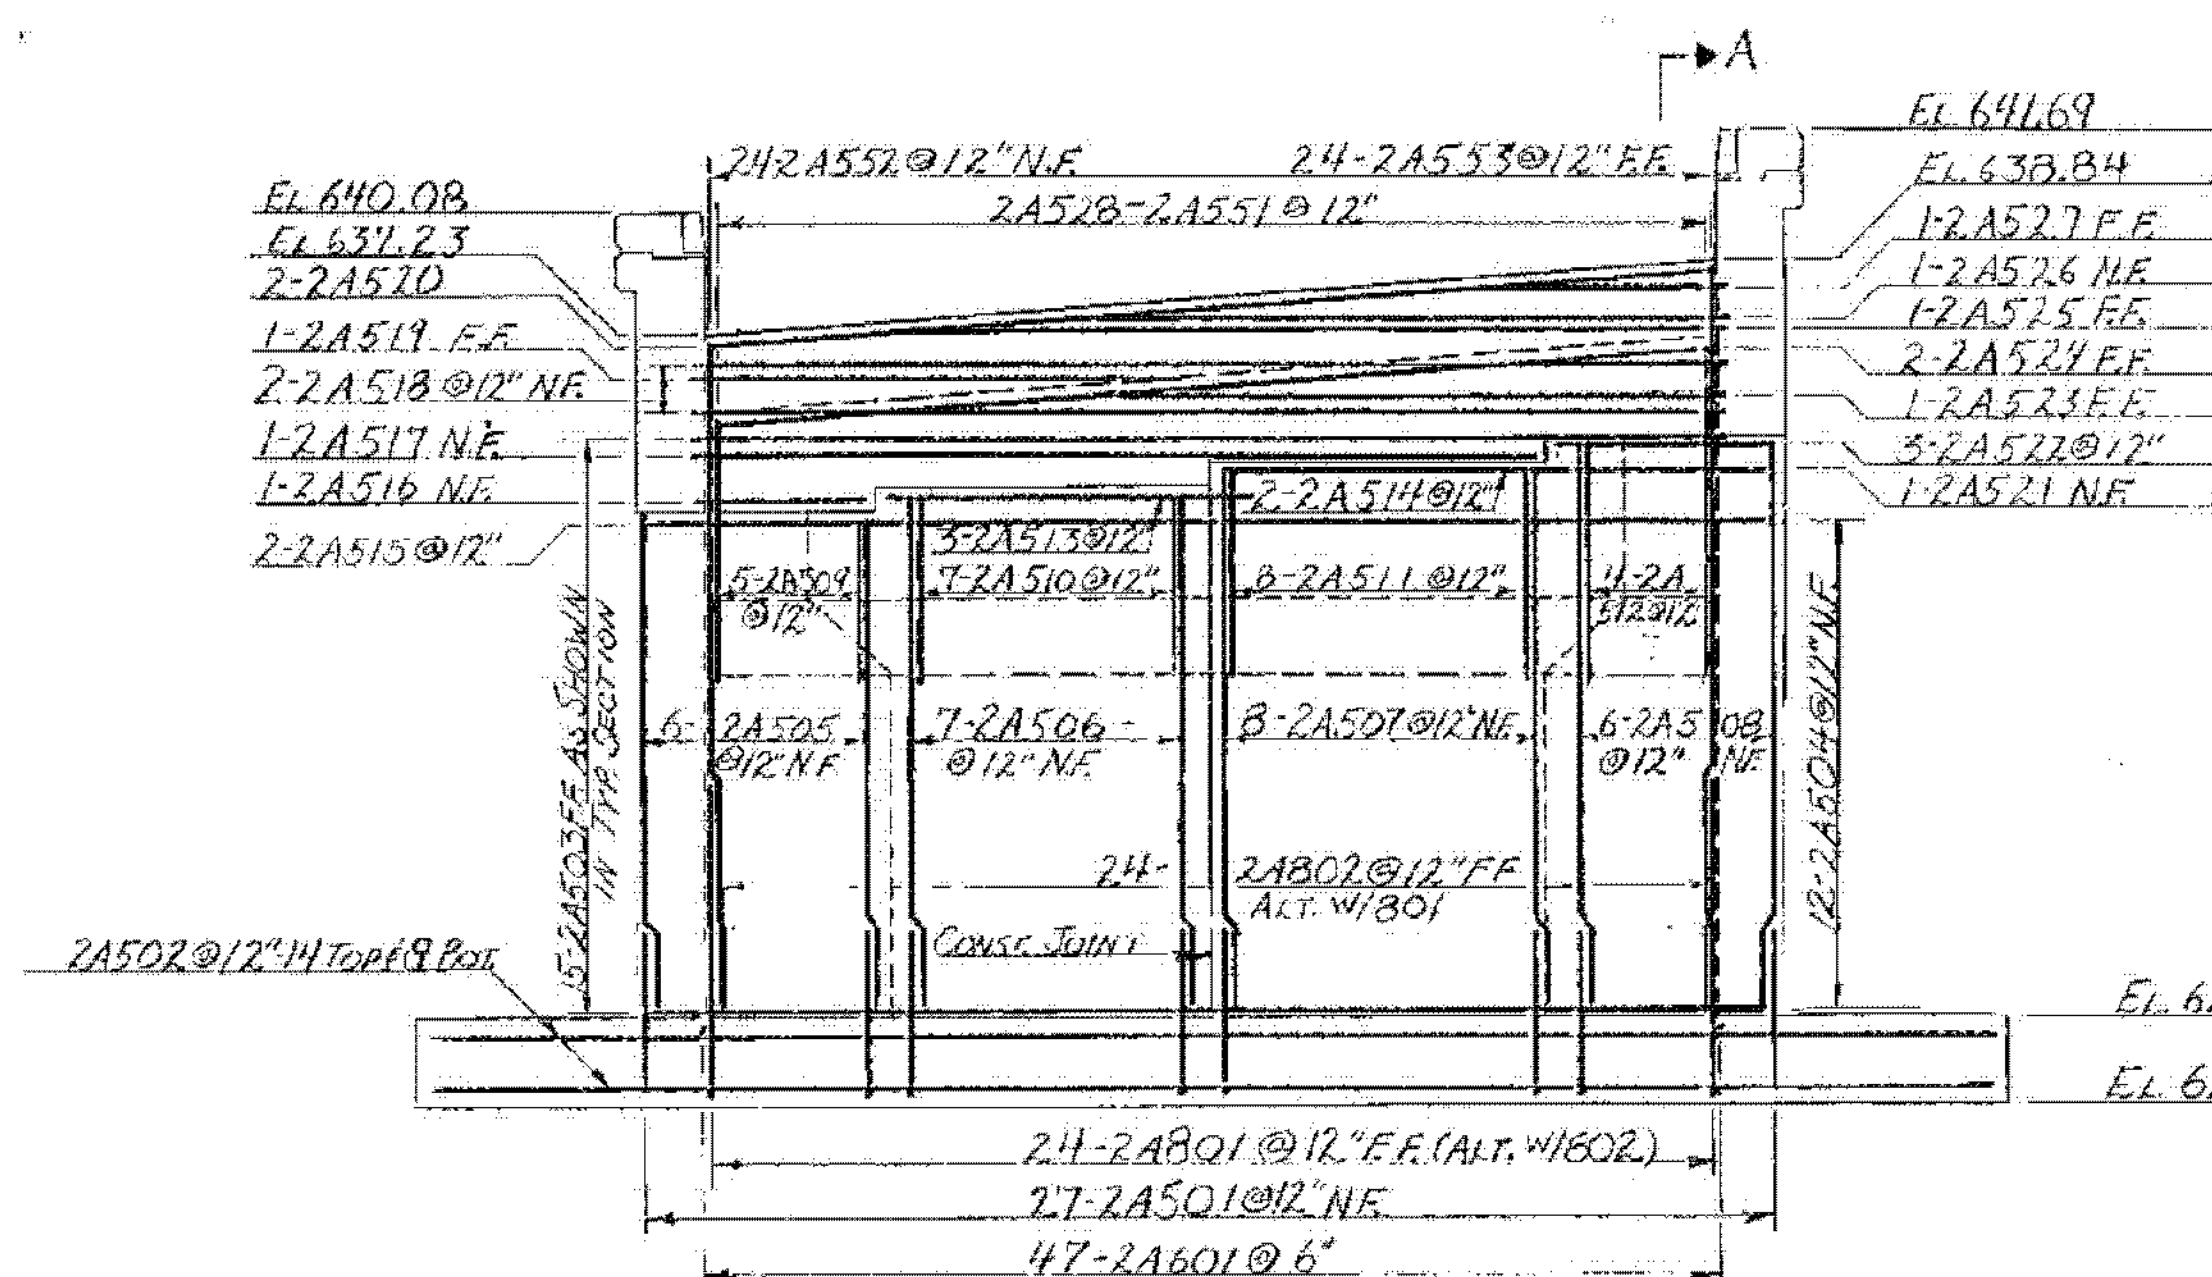

ELEVATION
SCALE: 1/4" = 1'-0"

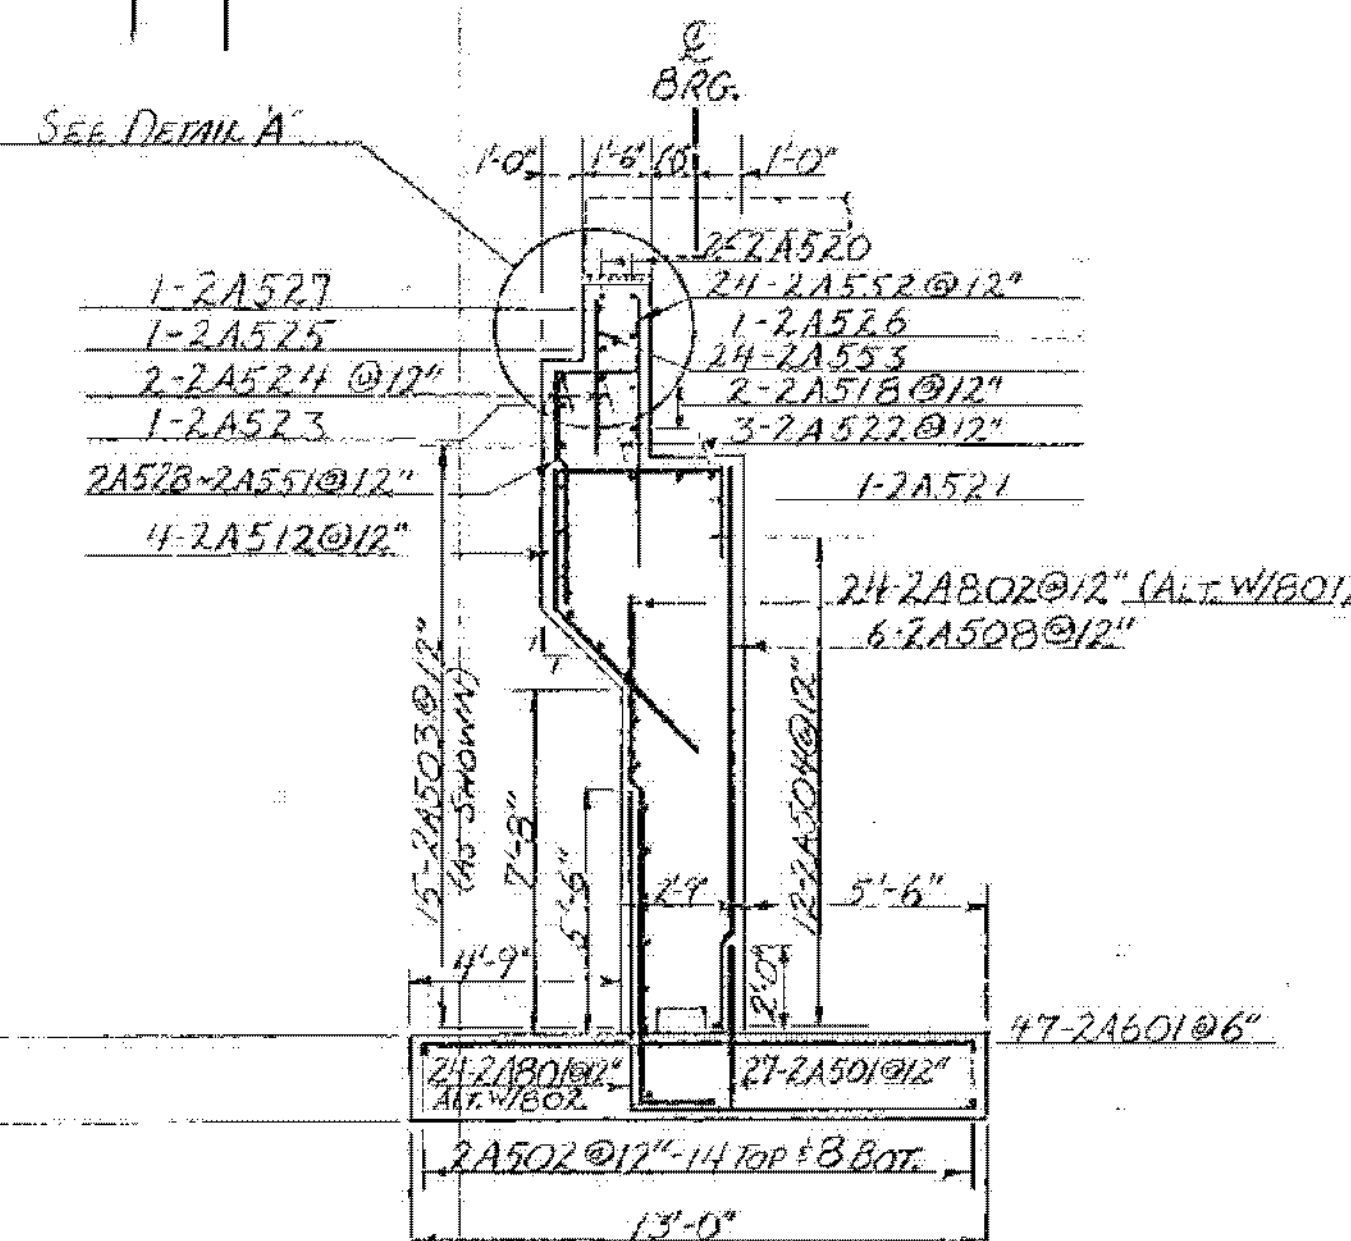

TYPICAL SECTION A-A
SCALE: 1/4" = 1'-0"

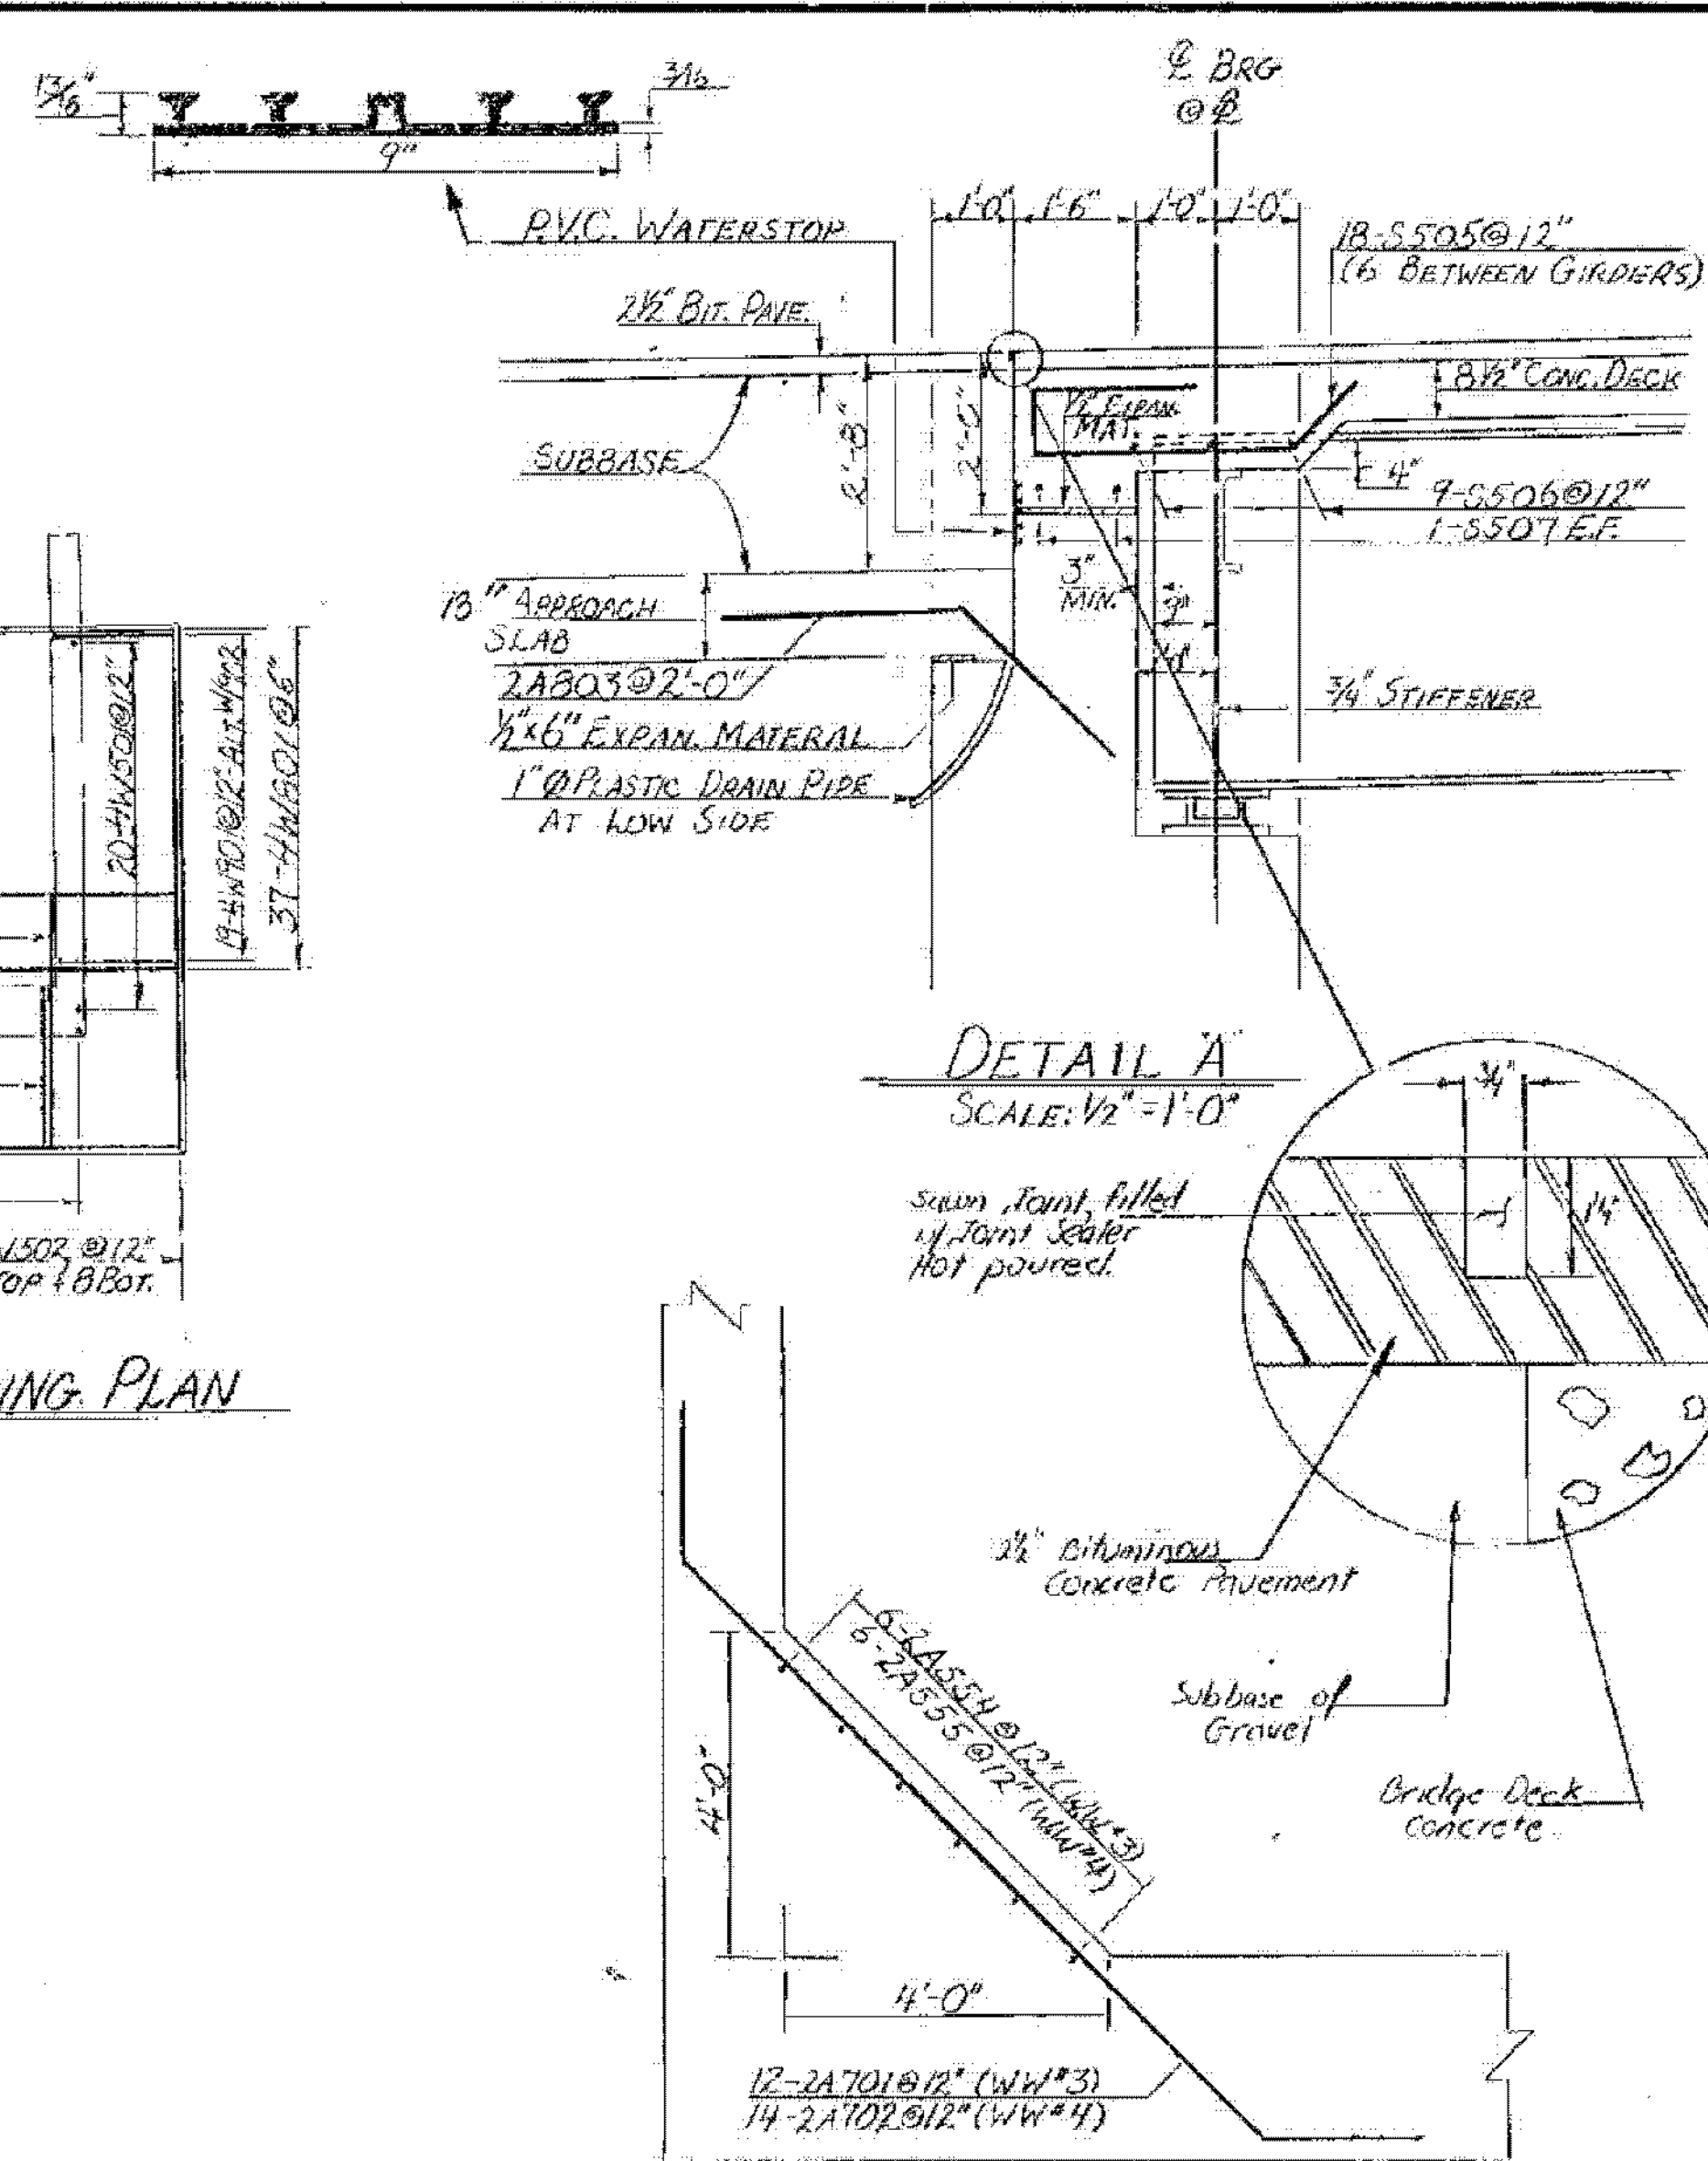

NOTE: N.F. = NEAR FACE
F.F. = FAR FACE
E.F. = EACH FACE

I-91 BRIDGES 81B
WATERFORD - ST. JOHNSBURY
IM MEMB(32)
SHEET 33 OF 43
FOR REFERENCE ONLY

STATE OF VERMONT AGENCY OF TRANSPORTATION			
TOWN OF	WATERFORD	Bridge No.	18
HIGHWAY NO.	I-93	Log Sta.	
ABUTMENT 2 DETAILS		Surv. Sta.	RAMP W. TO S. OVER I-91 NB, E. SB, RAMP S. TO E.
Designed by	D. BURLEY	Drawn by	S. BASCOM
Checked by	A. ELWOOD date 7-80	Bridge Design Supervisor	R.S. HAUPT date 7-80
PROJECT	CONTRACT 3 WATERFORD	PROJECT NO.	I 93-1 (3)
Bridge Sheet No.	BR1811	Sheet	170 of 550