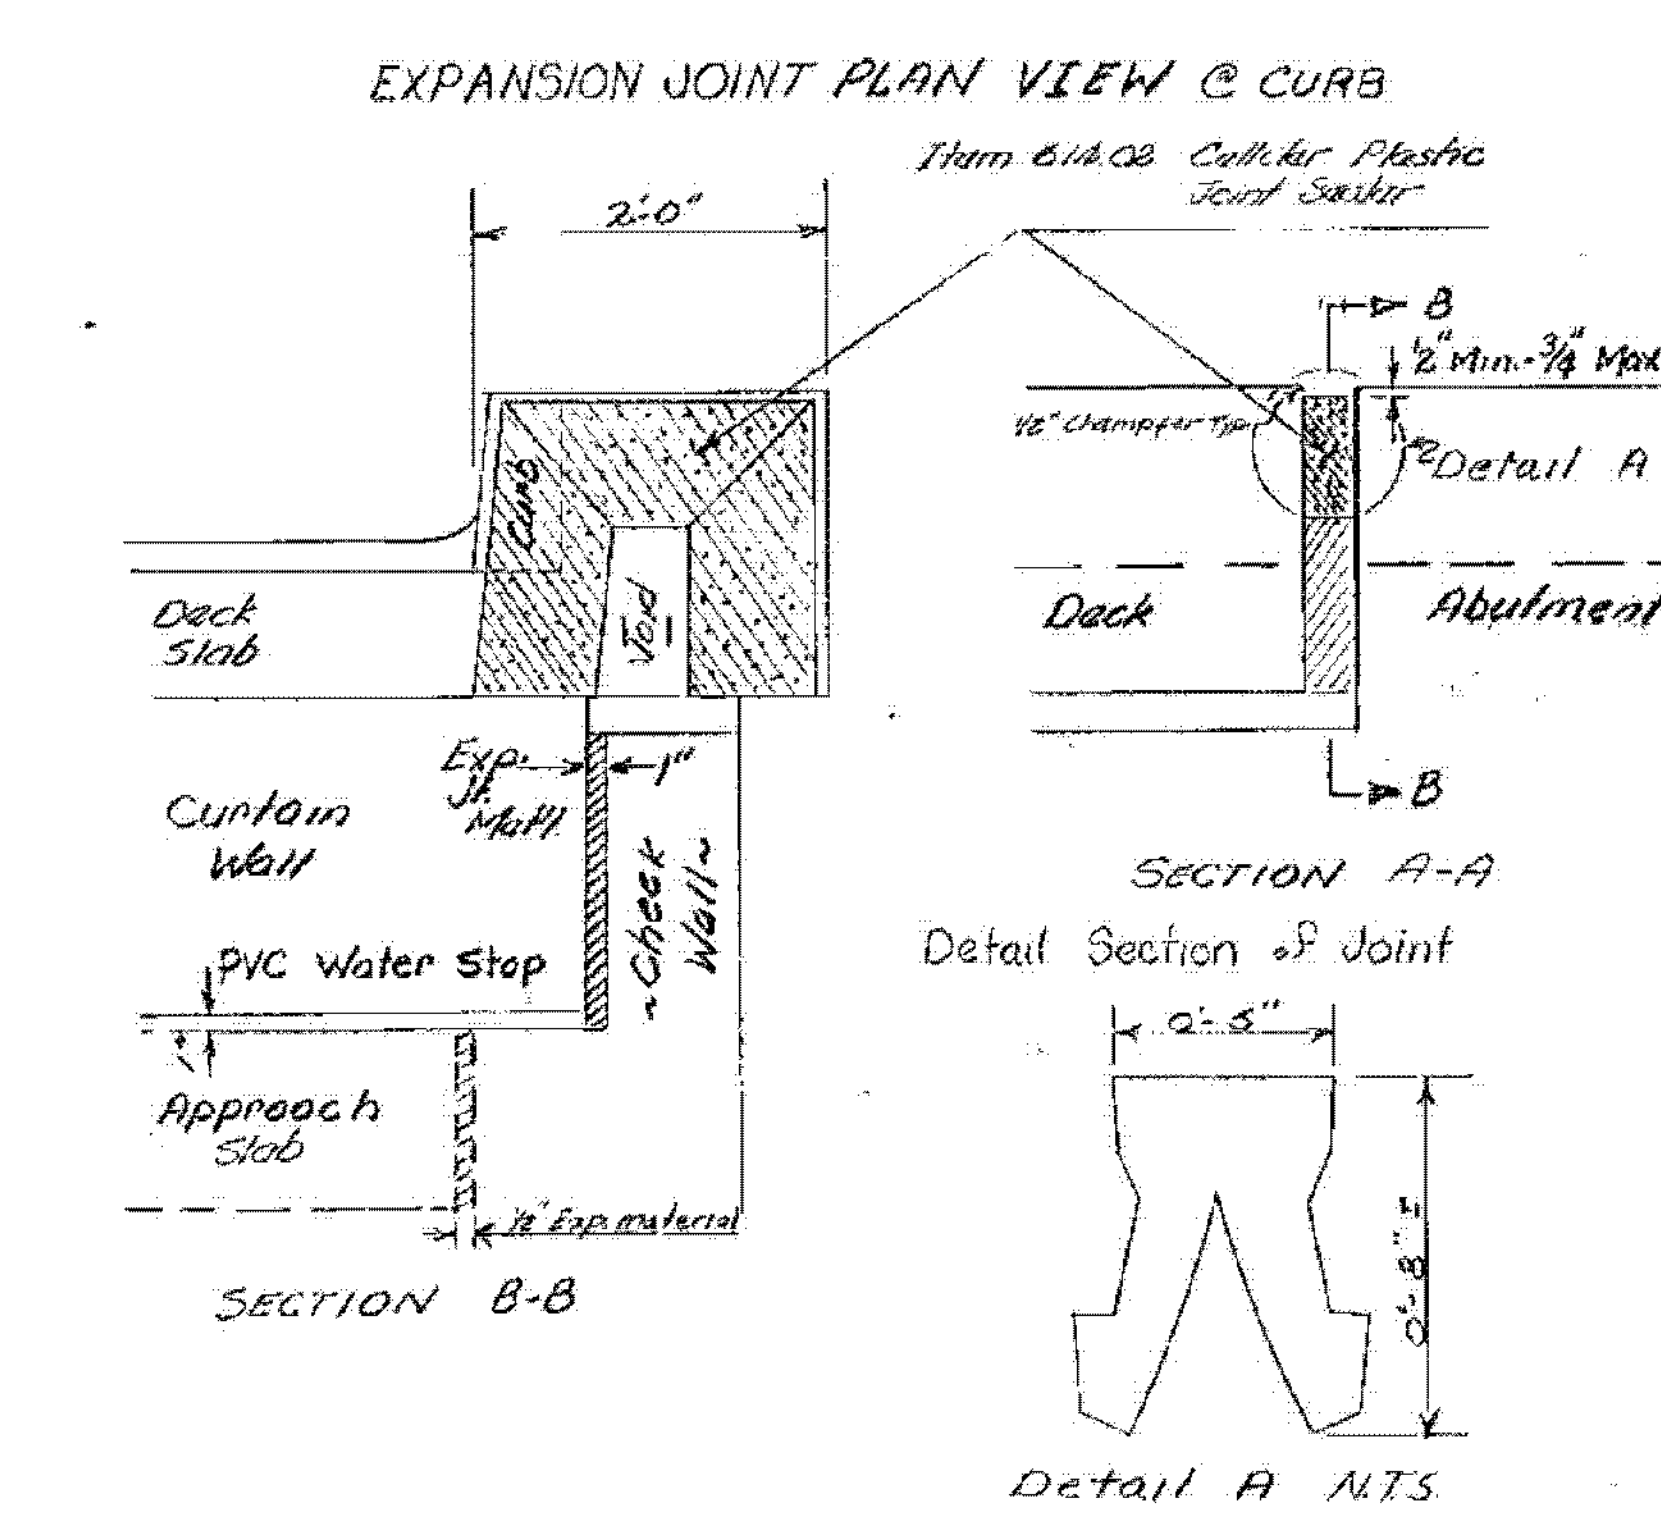
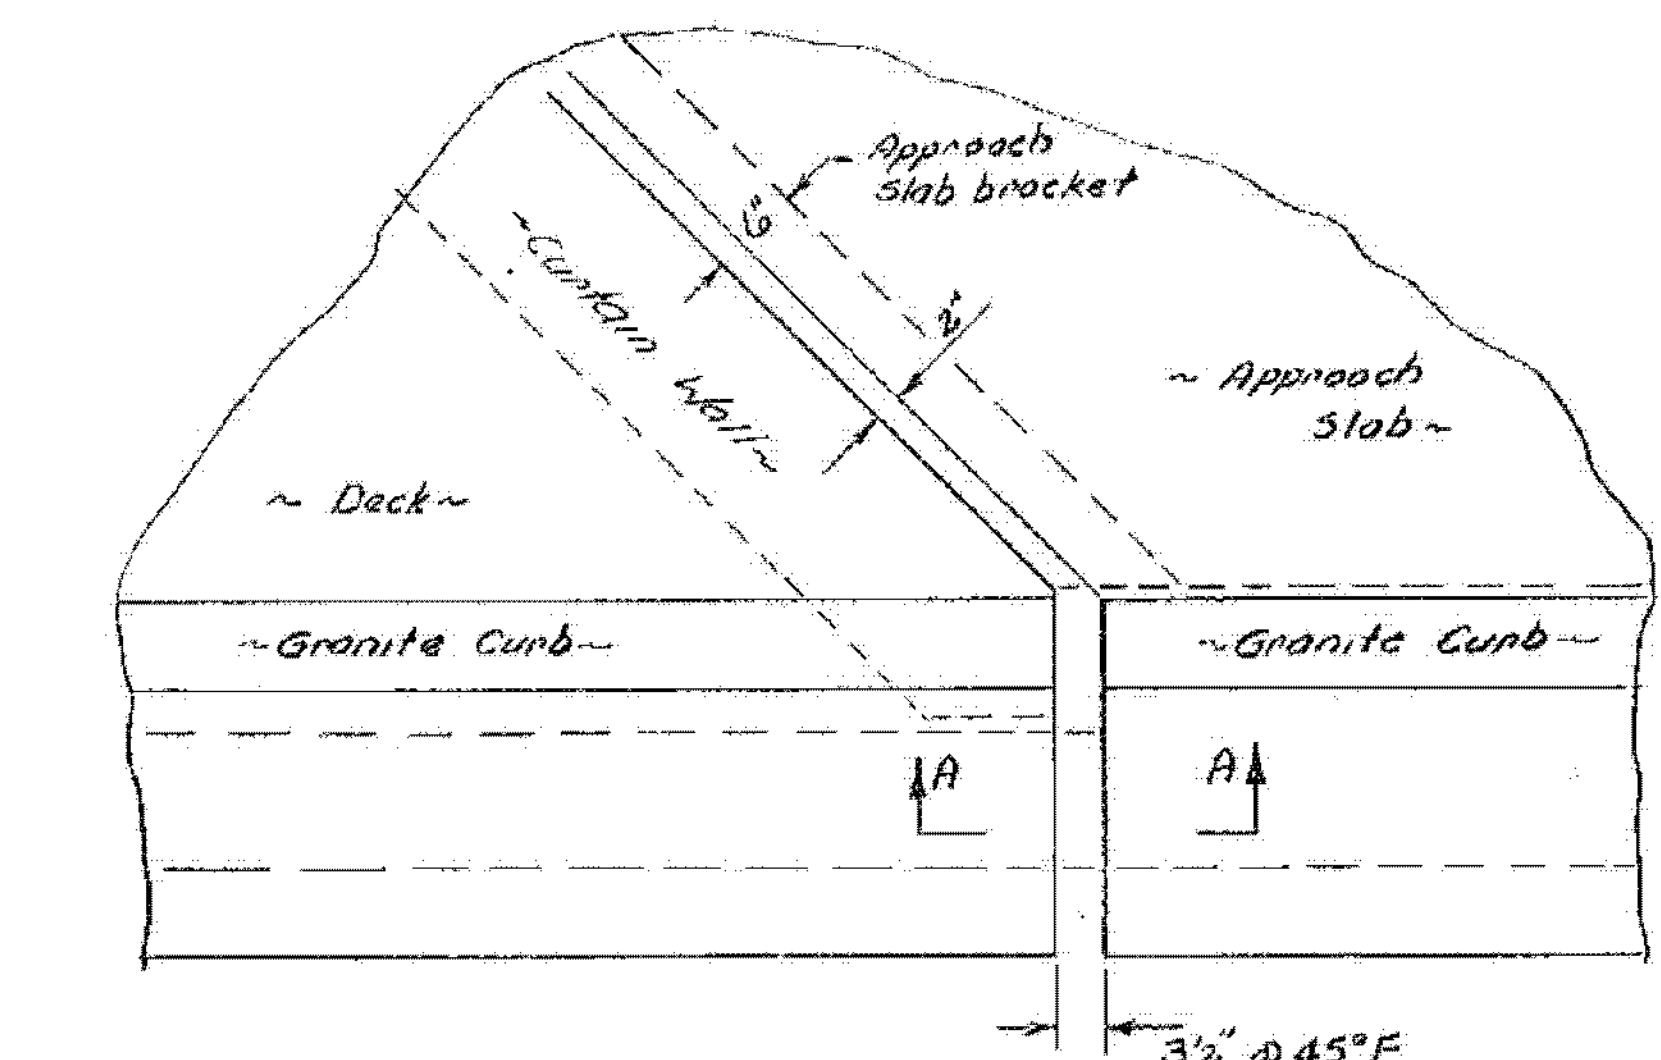
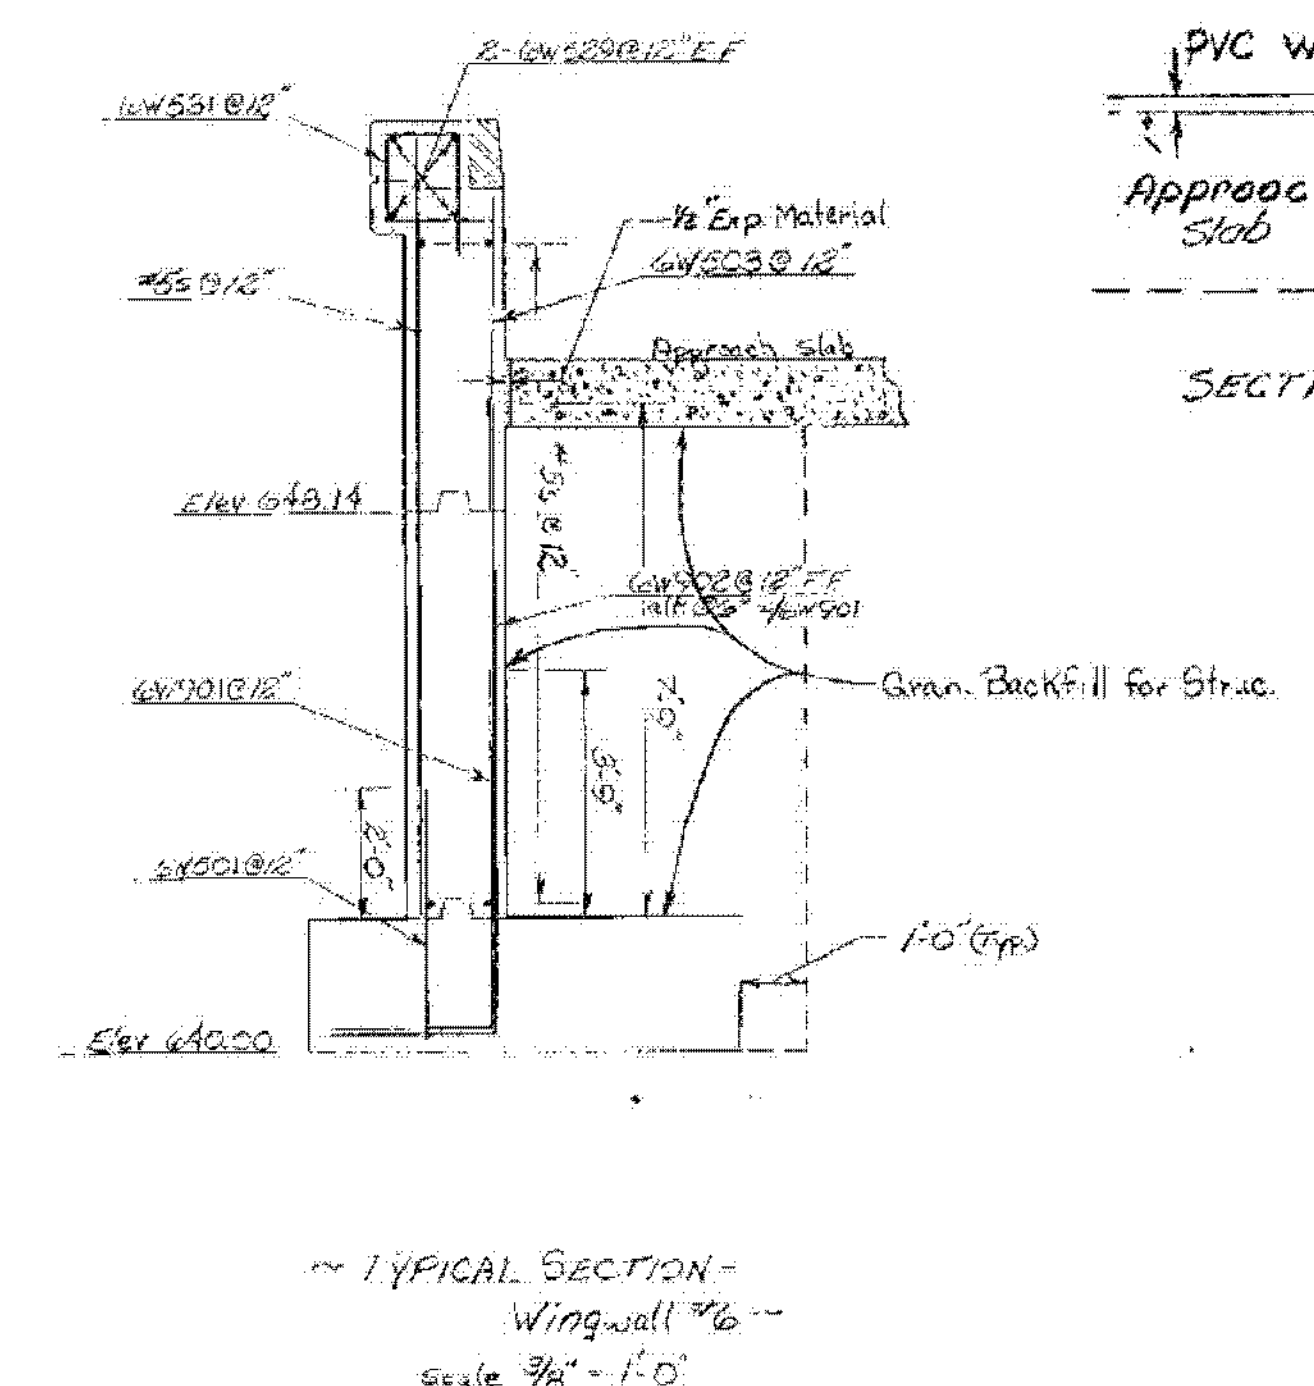
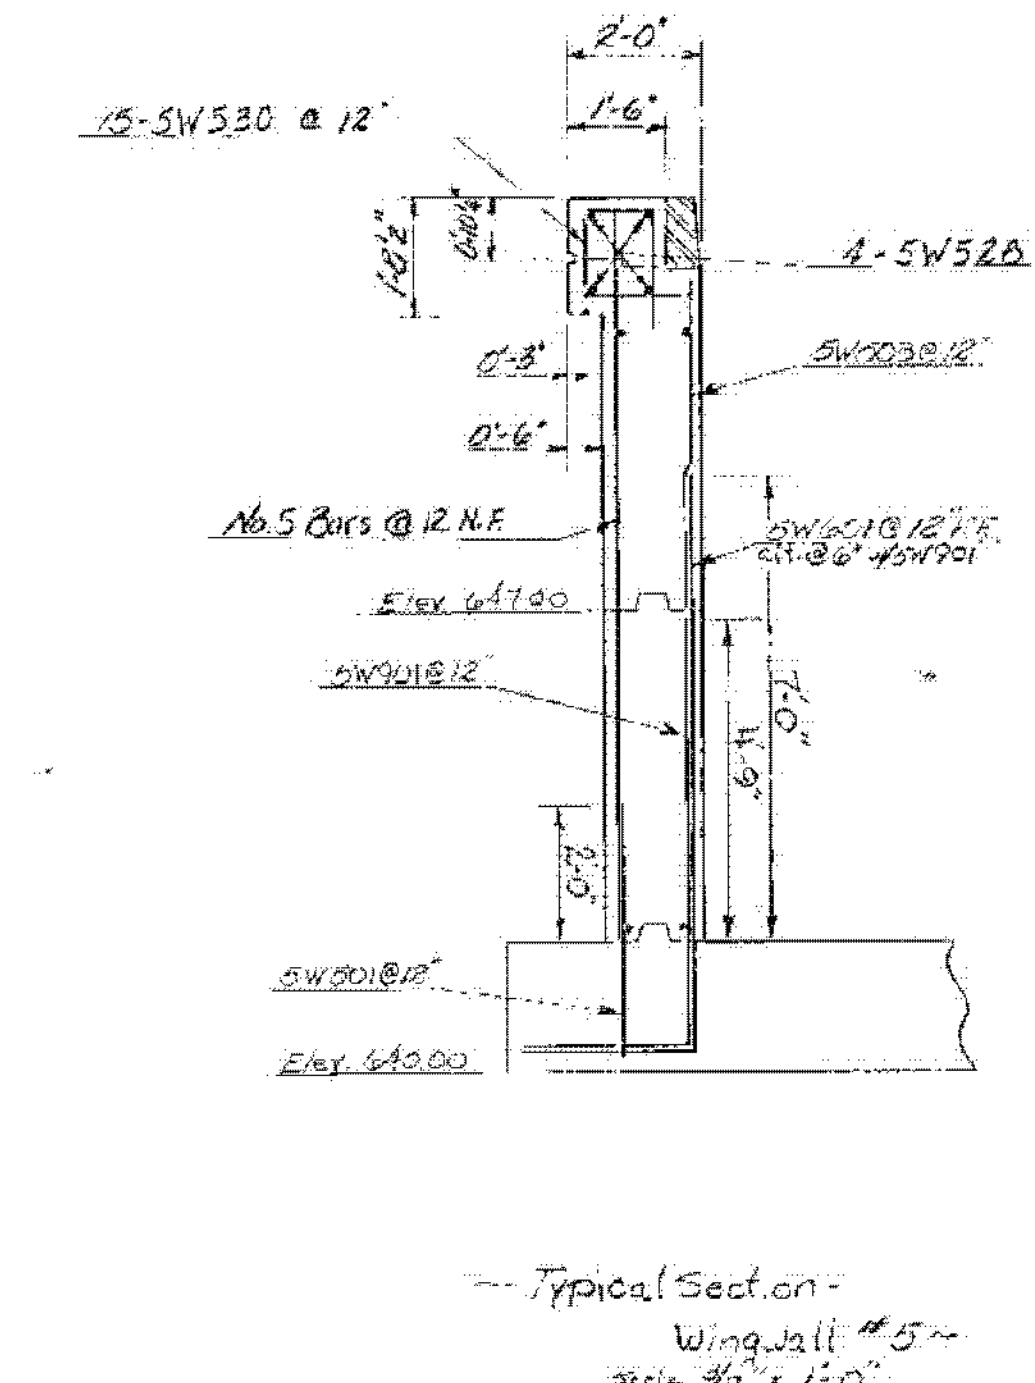
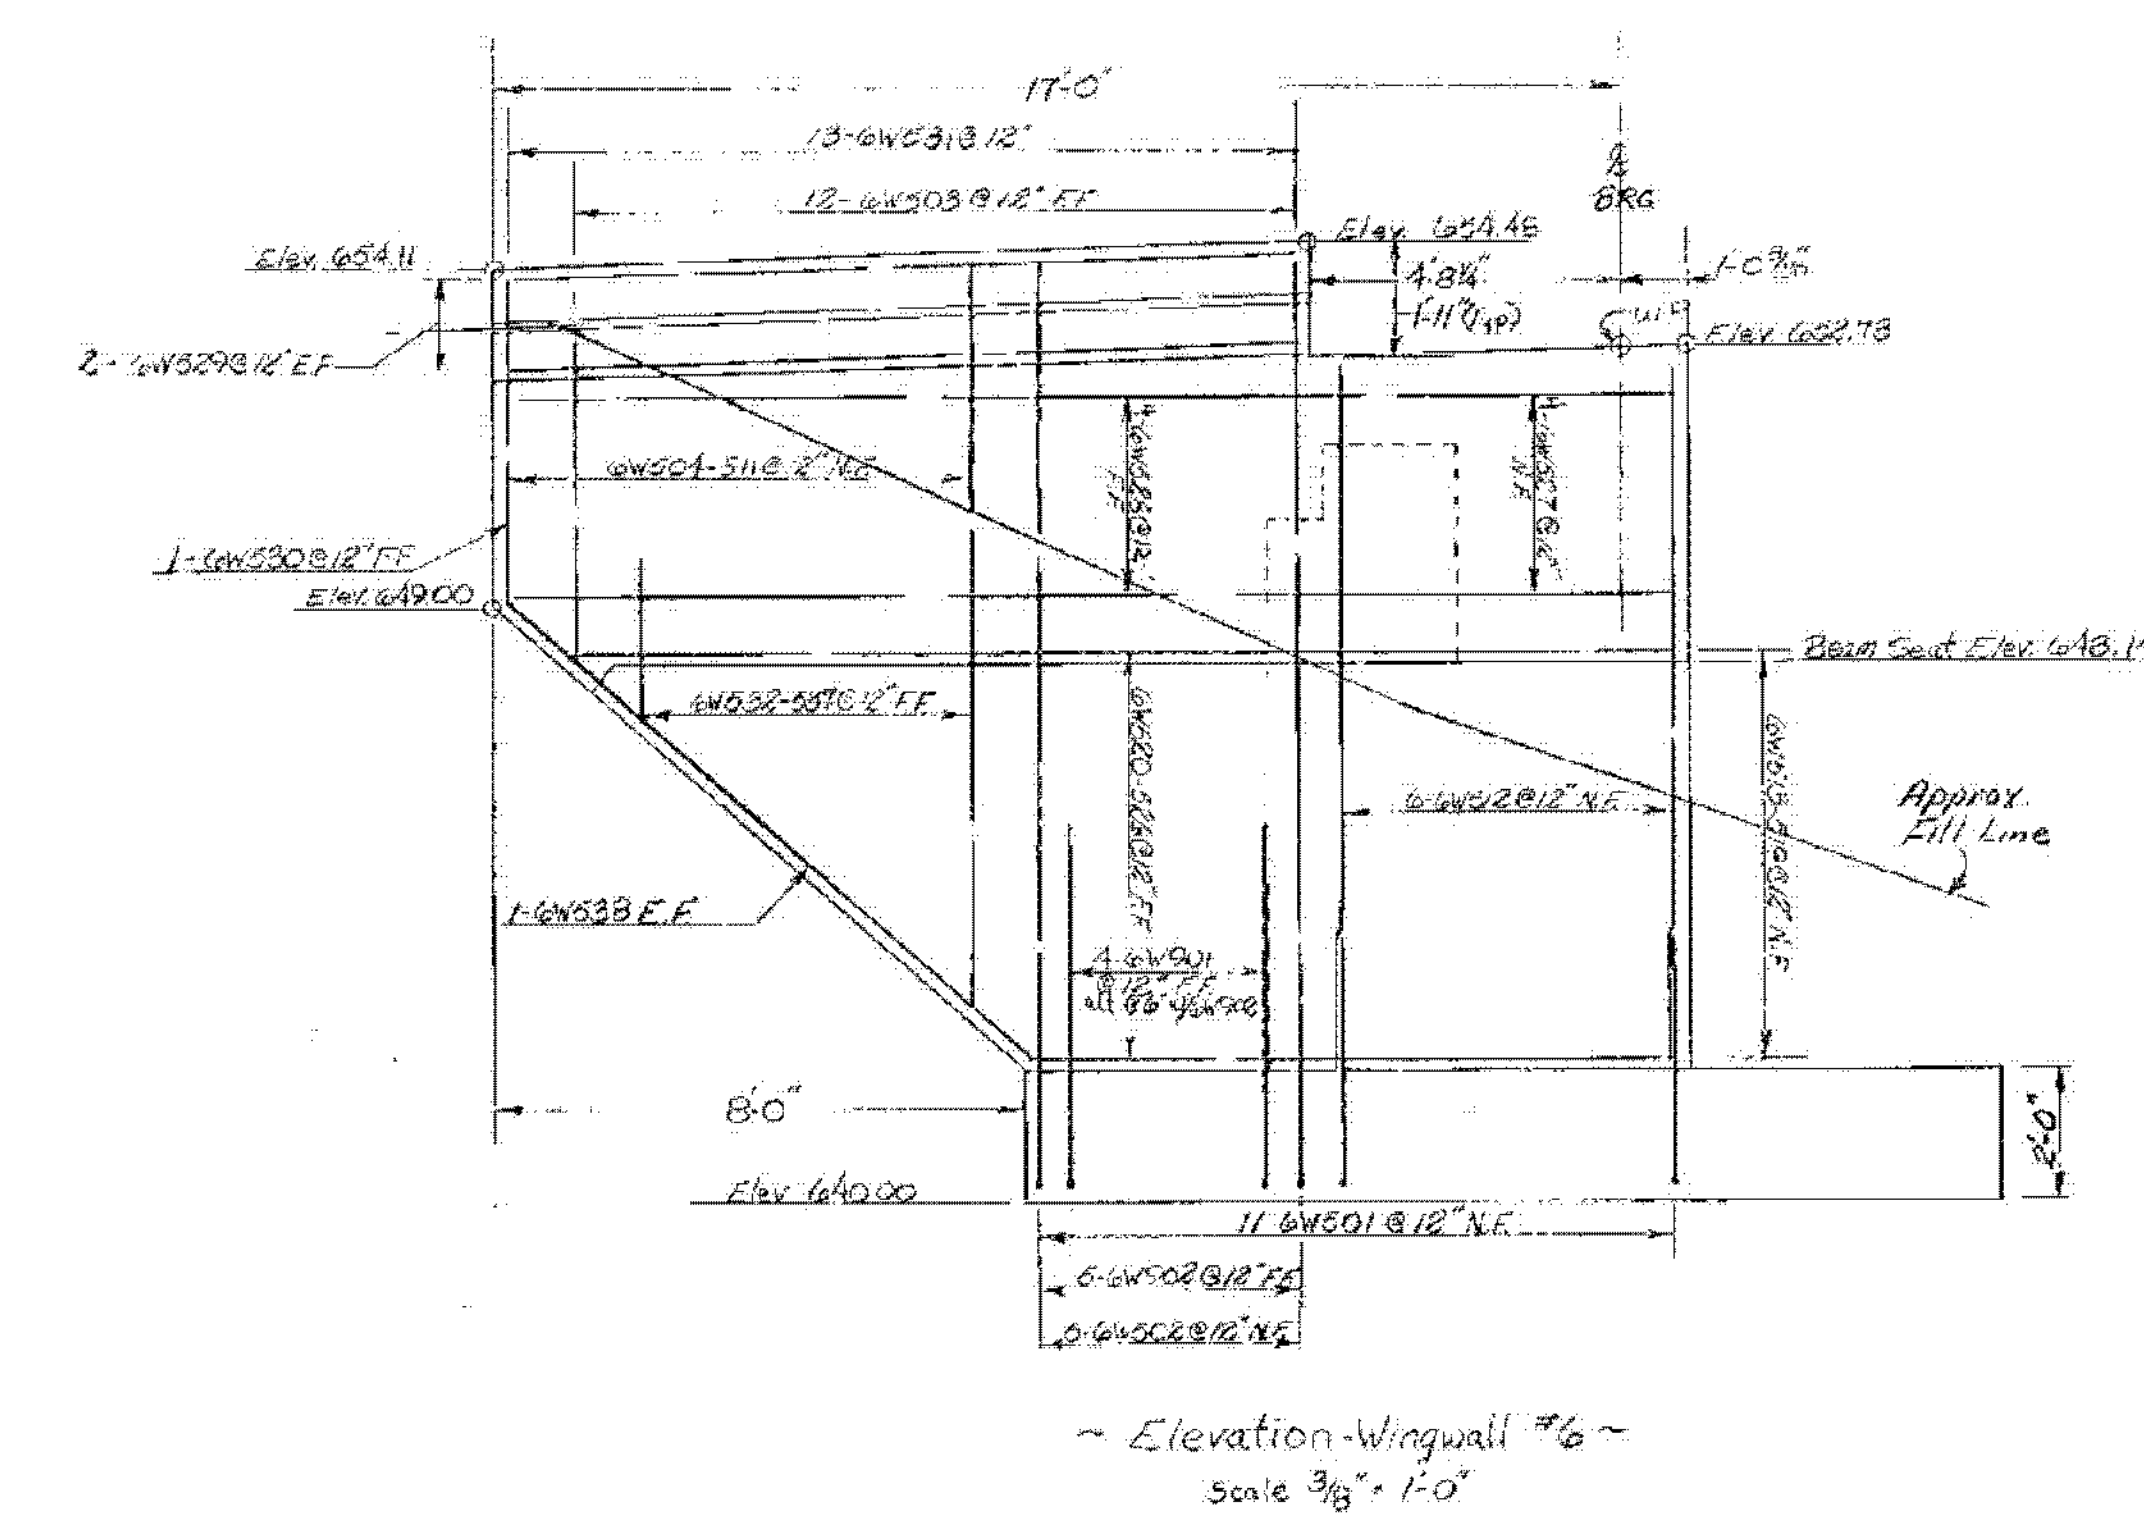
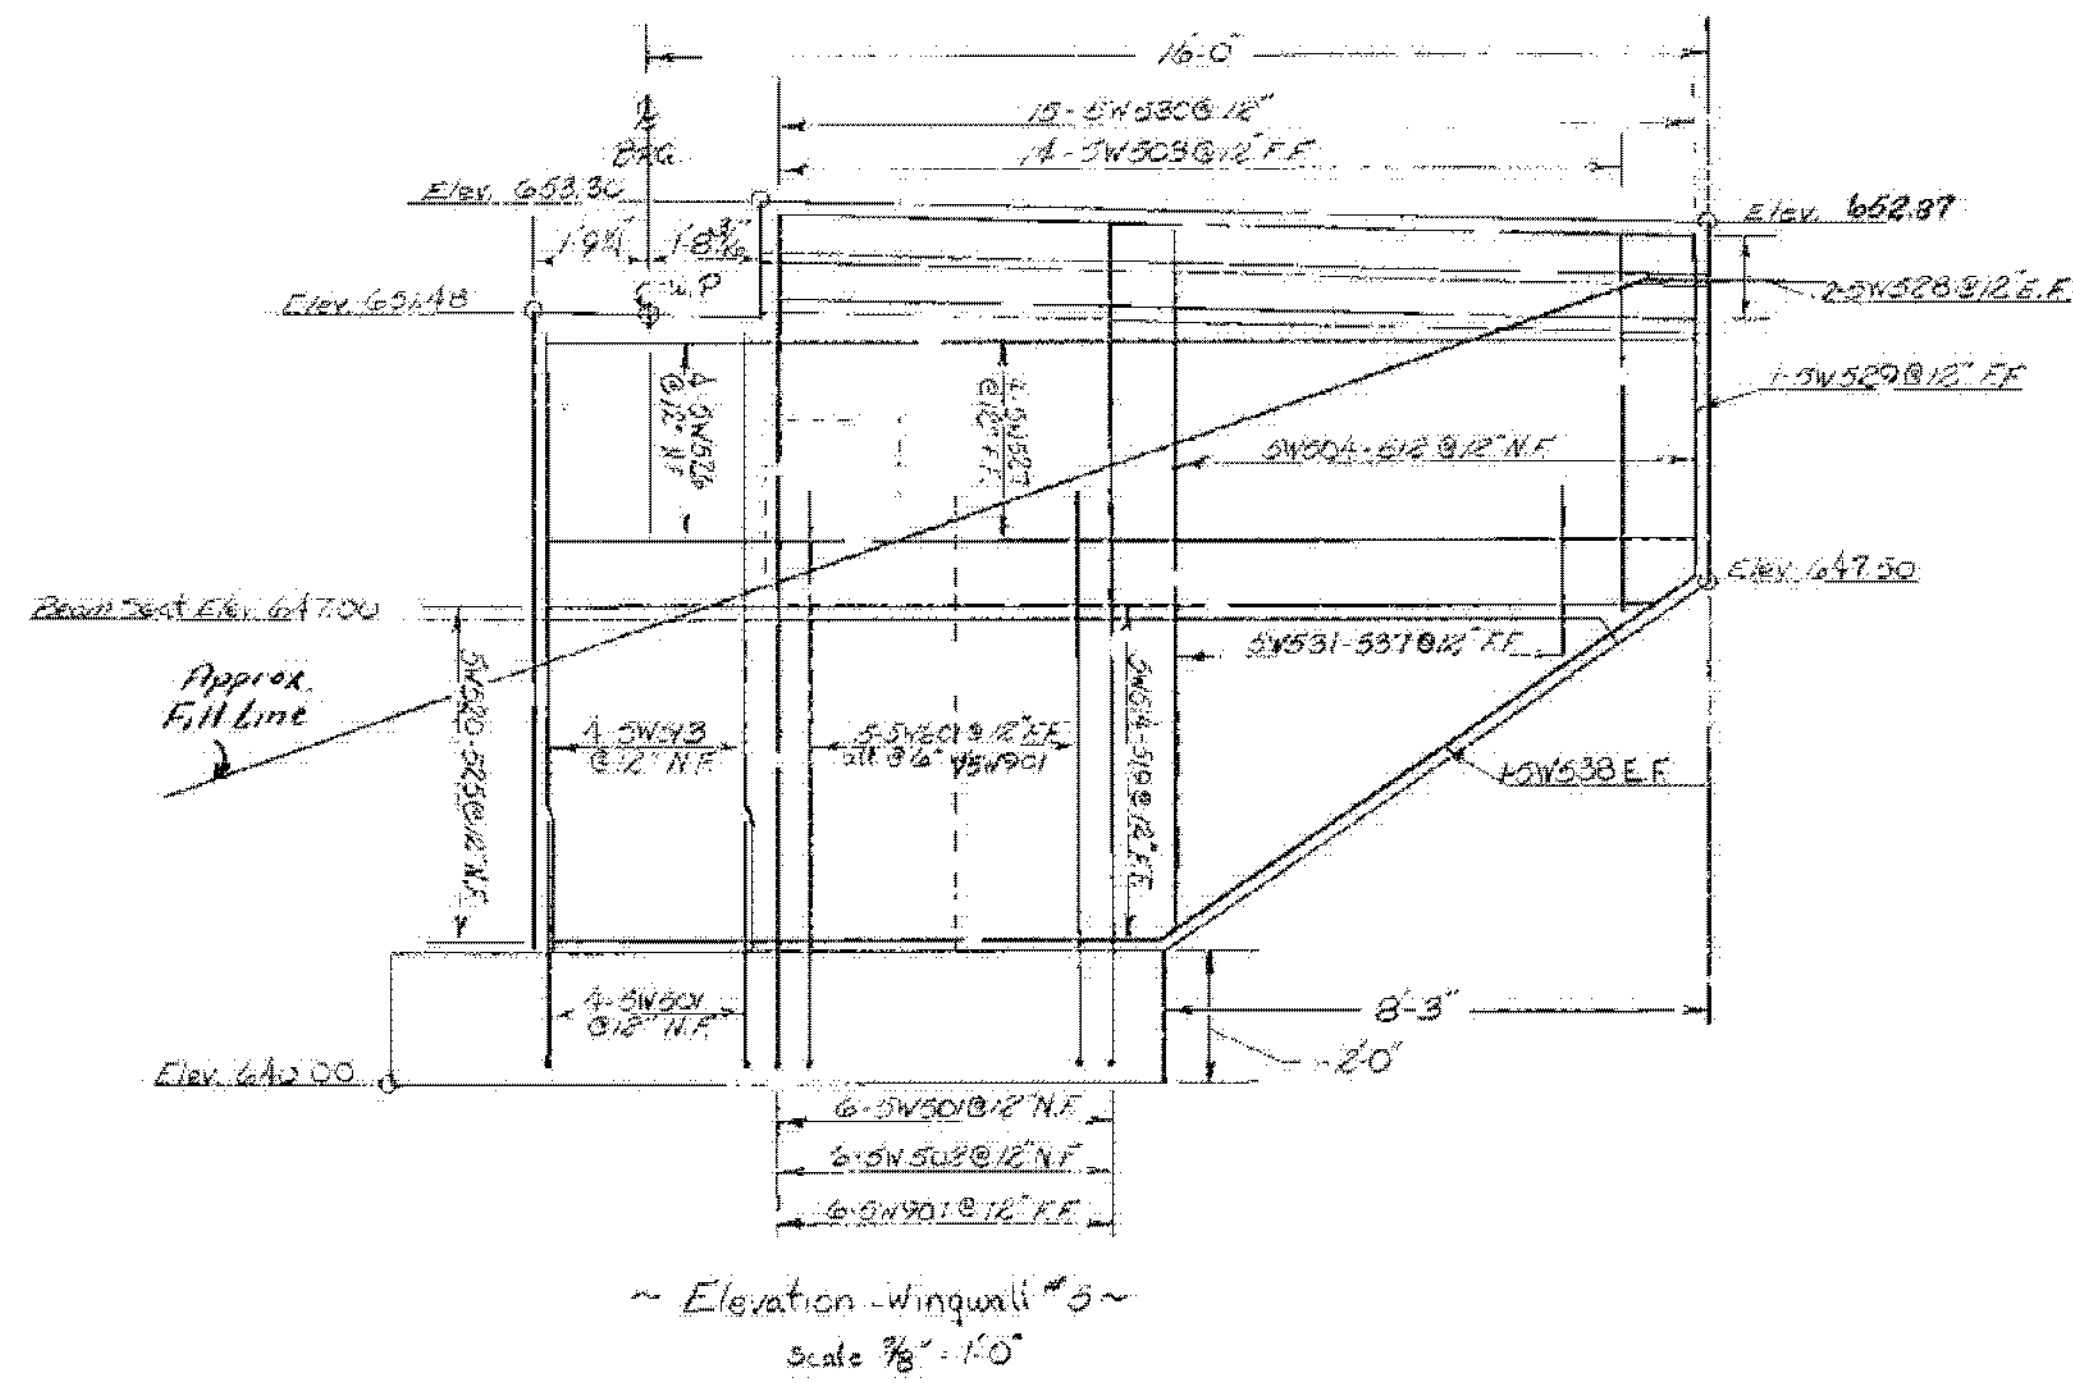


ABUTMENT CURB EXPANSION JOINT
Scale: 1" = 1'-0"

STATE OF VERMONT DEPARTMENT OF HIGHWAYS	
TOWN OF St. Johnsbury	Bridge No. Log Sta.
HIGHWAY NO. 191	Surv. Sta. 6845+00
191 N.B. #58 over U.S. 5 Relocation	
Designed by A. Howard	Drawn by R. Whitehead
Checked by J. Burnett	Bridge Design Supervisor
PROJECT Barnet - St. Johnsbury	PROJECT NO. EAC 191-2(59)
Bridge Sheet No. 120	Sheet 184 of 308