


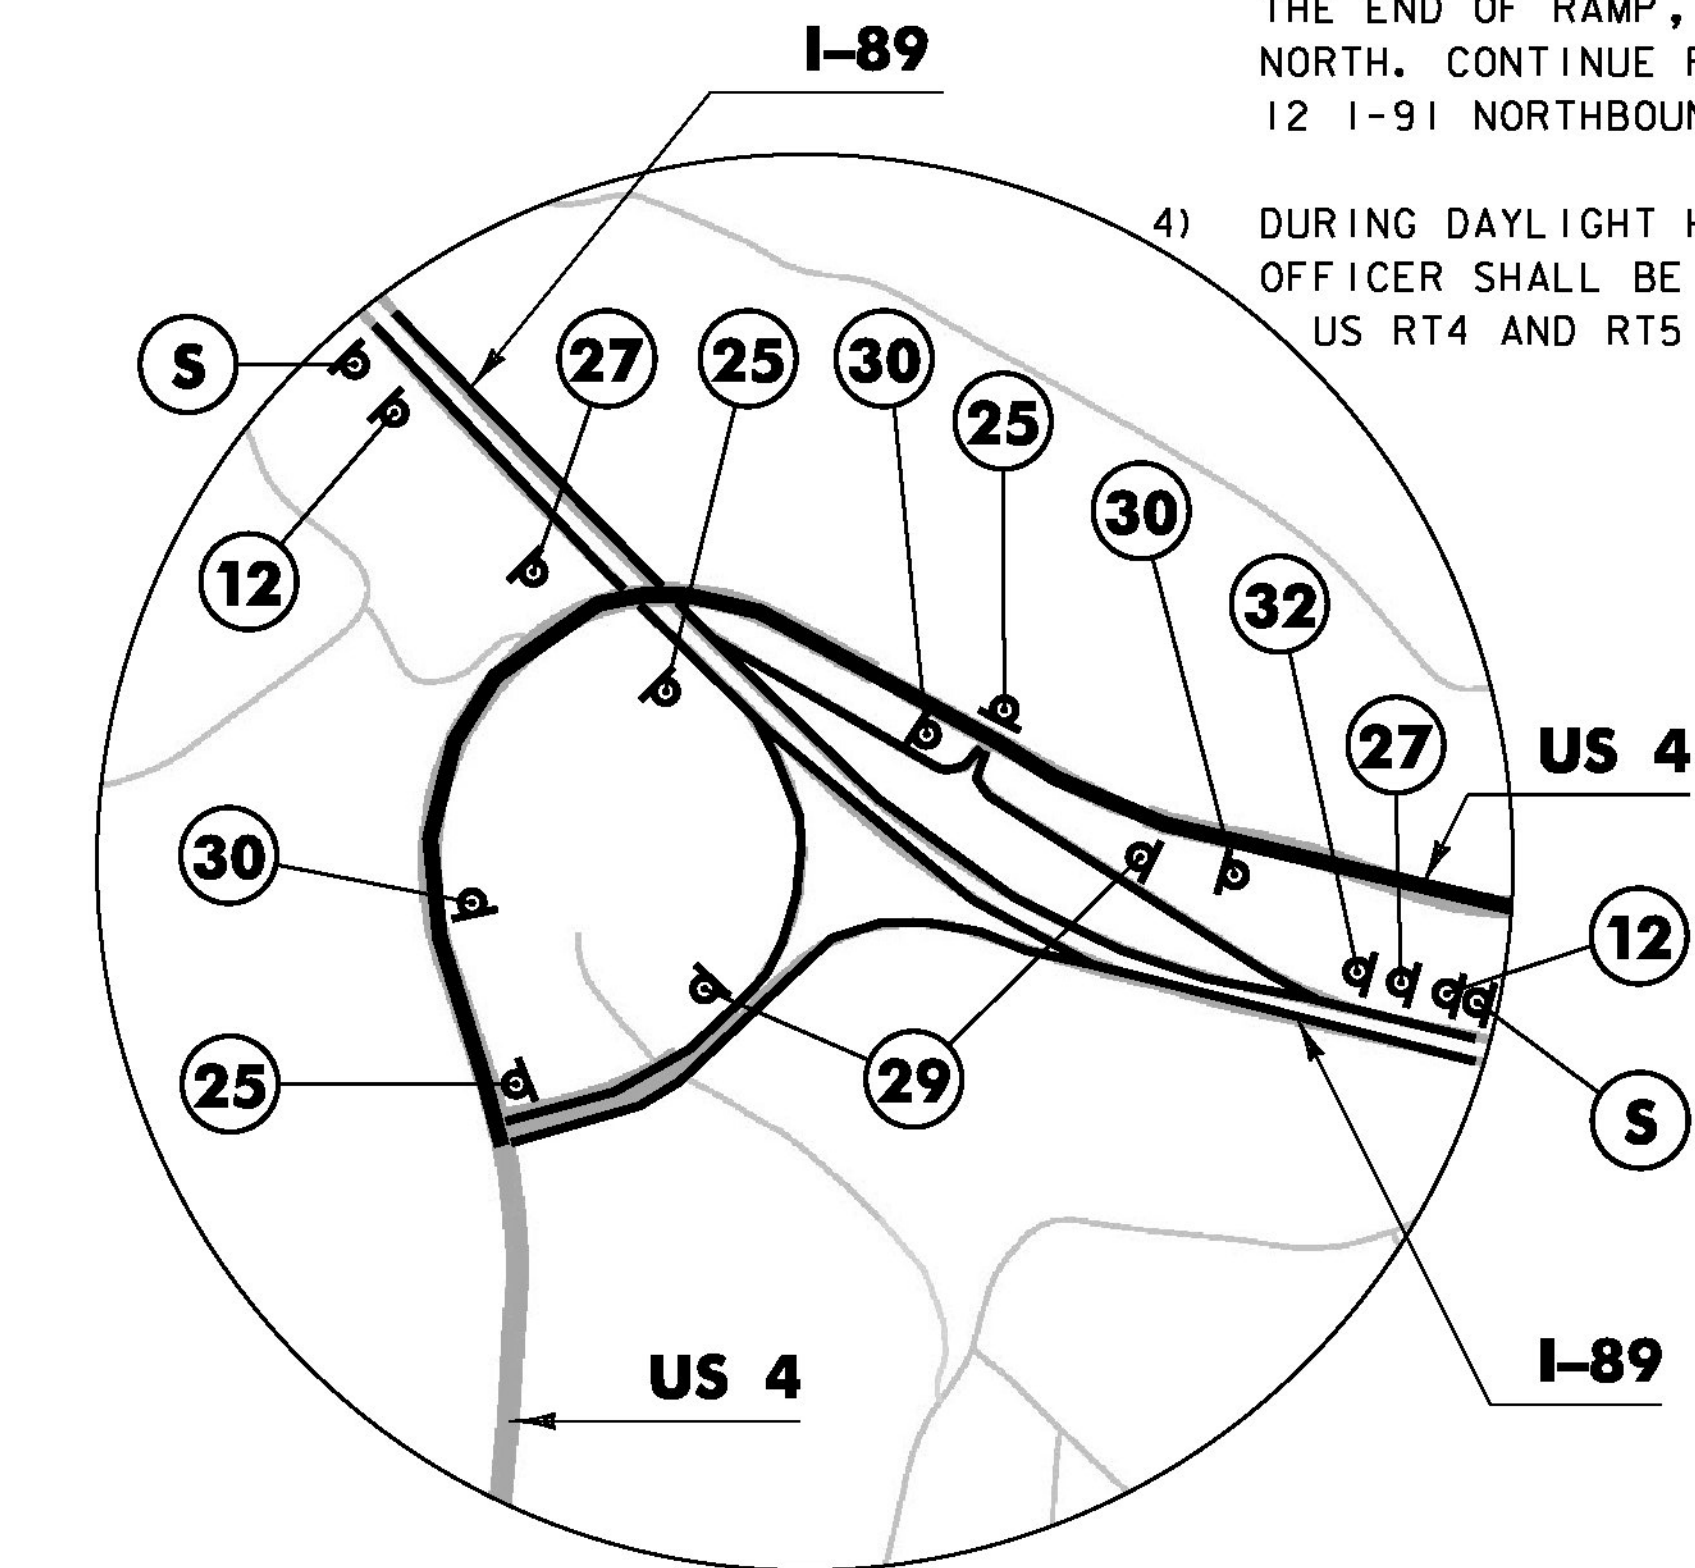

COVER SIGN

NOT TO SCALE

PLOT DATE: 15-DEC-2014
DRAWN BY: J. SALVATORI
CHECKED BY: M. MILLER
SHEET 53 OF 166