




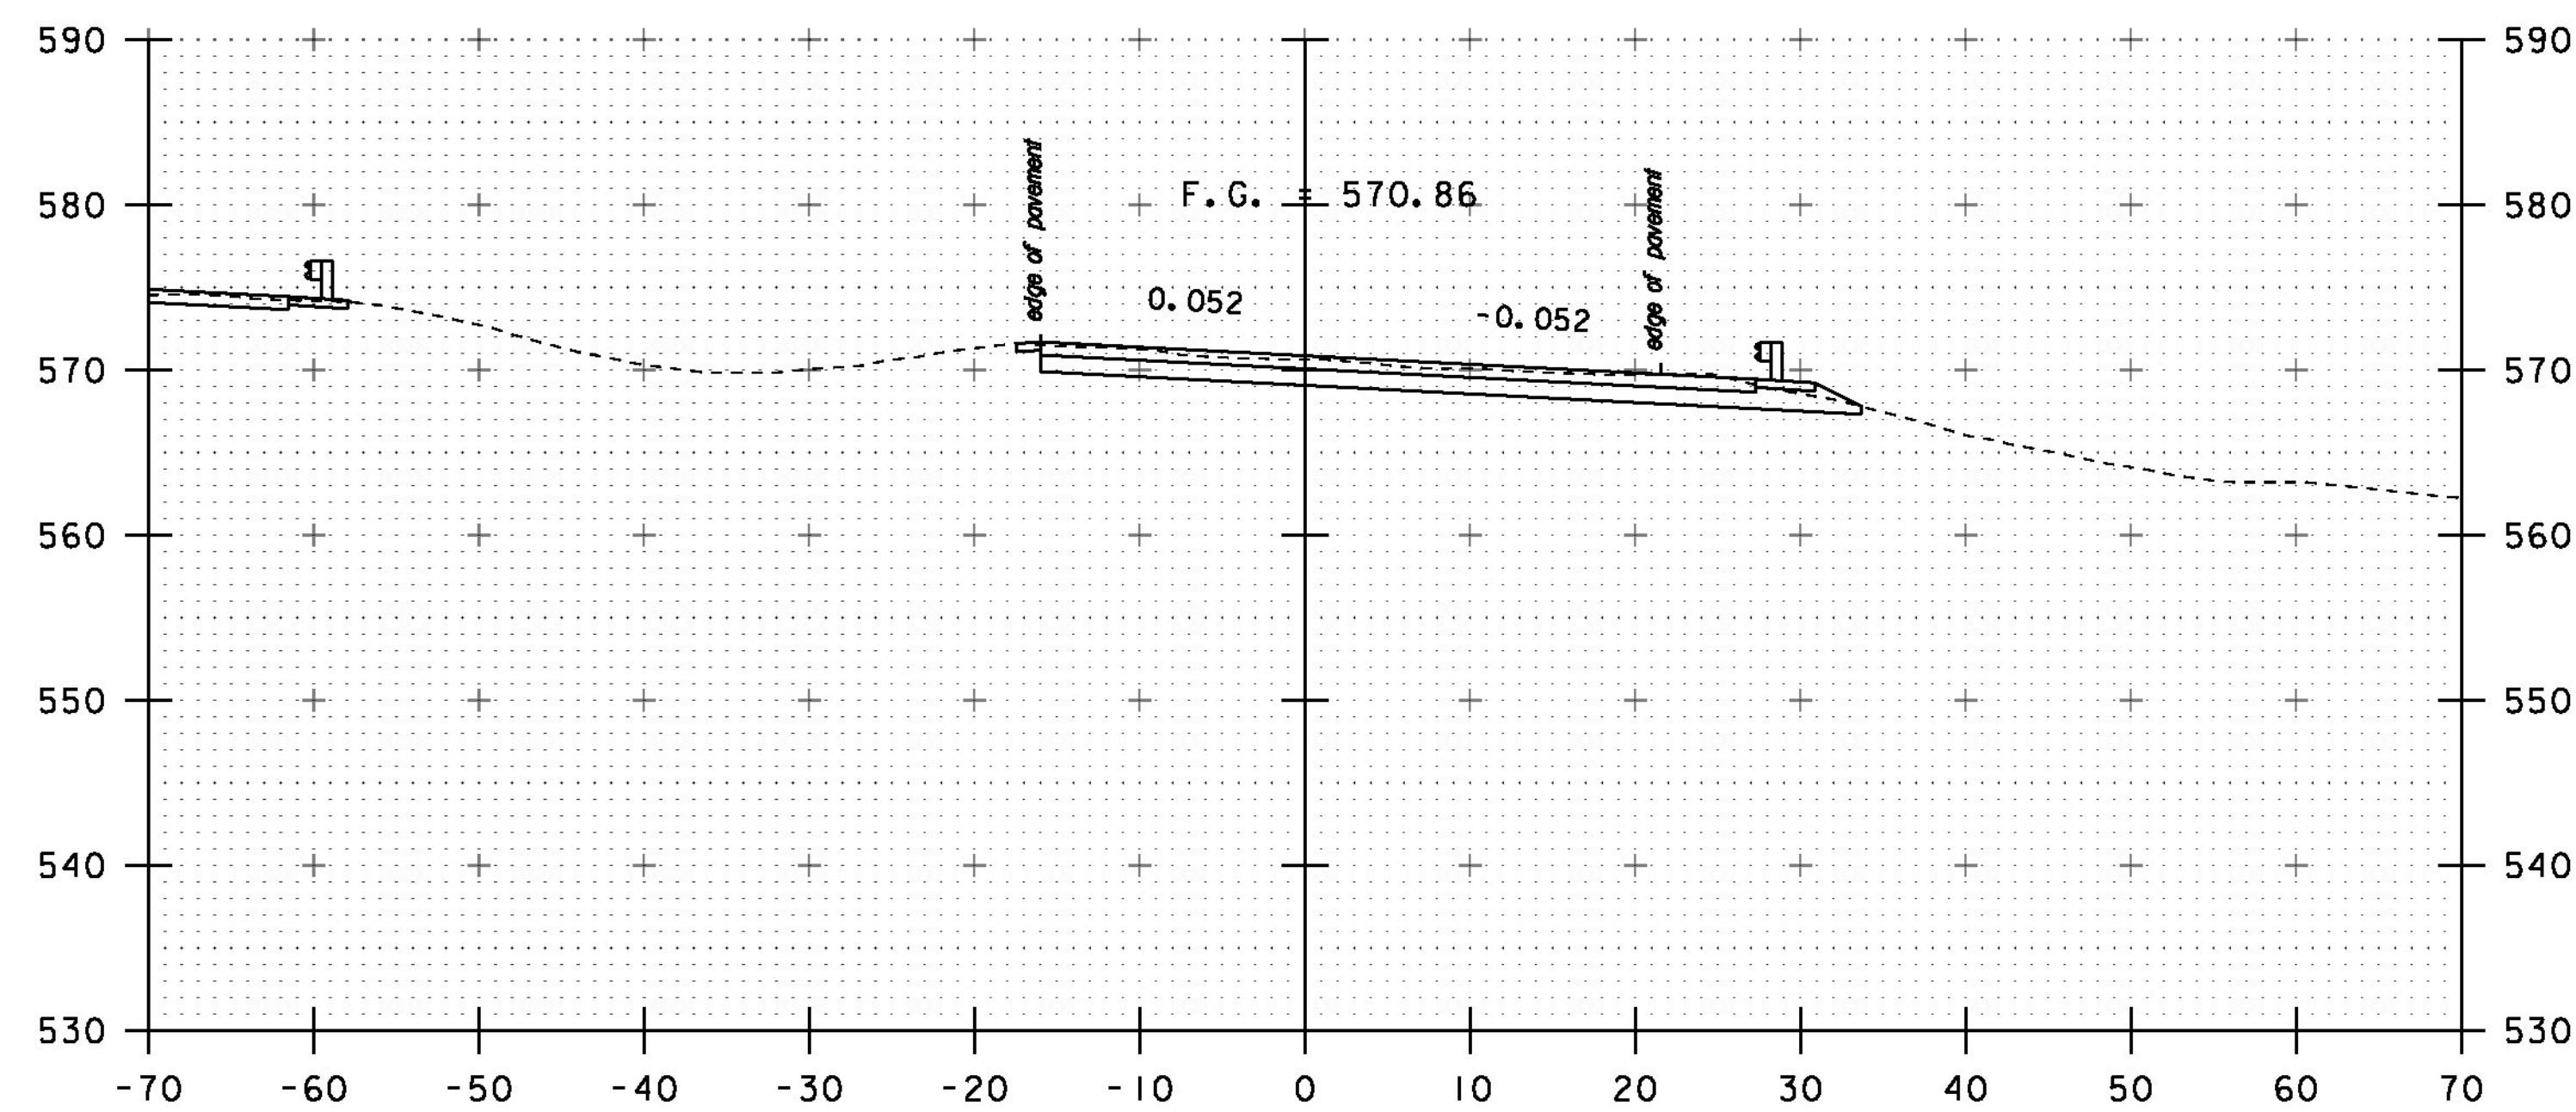


252+00

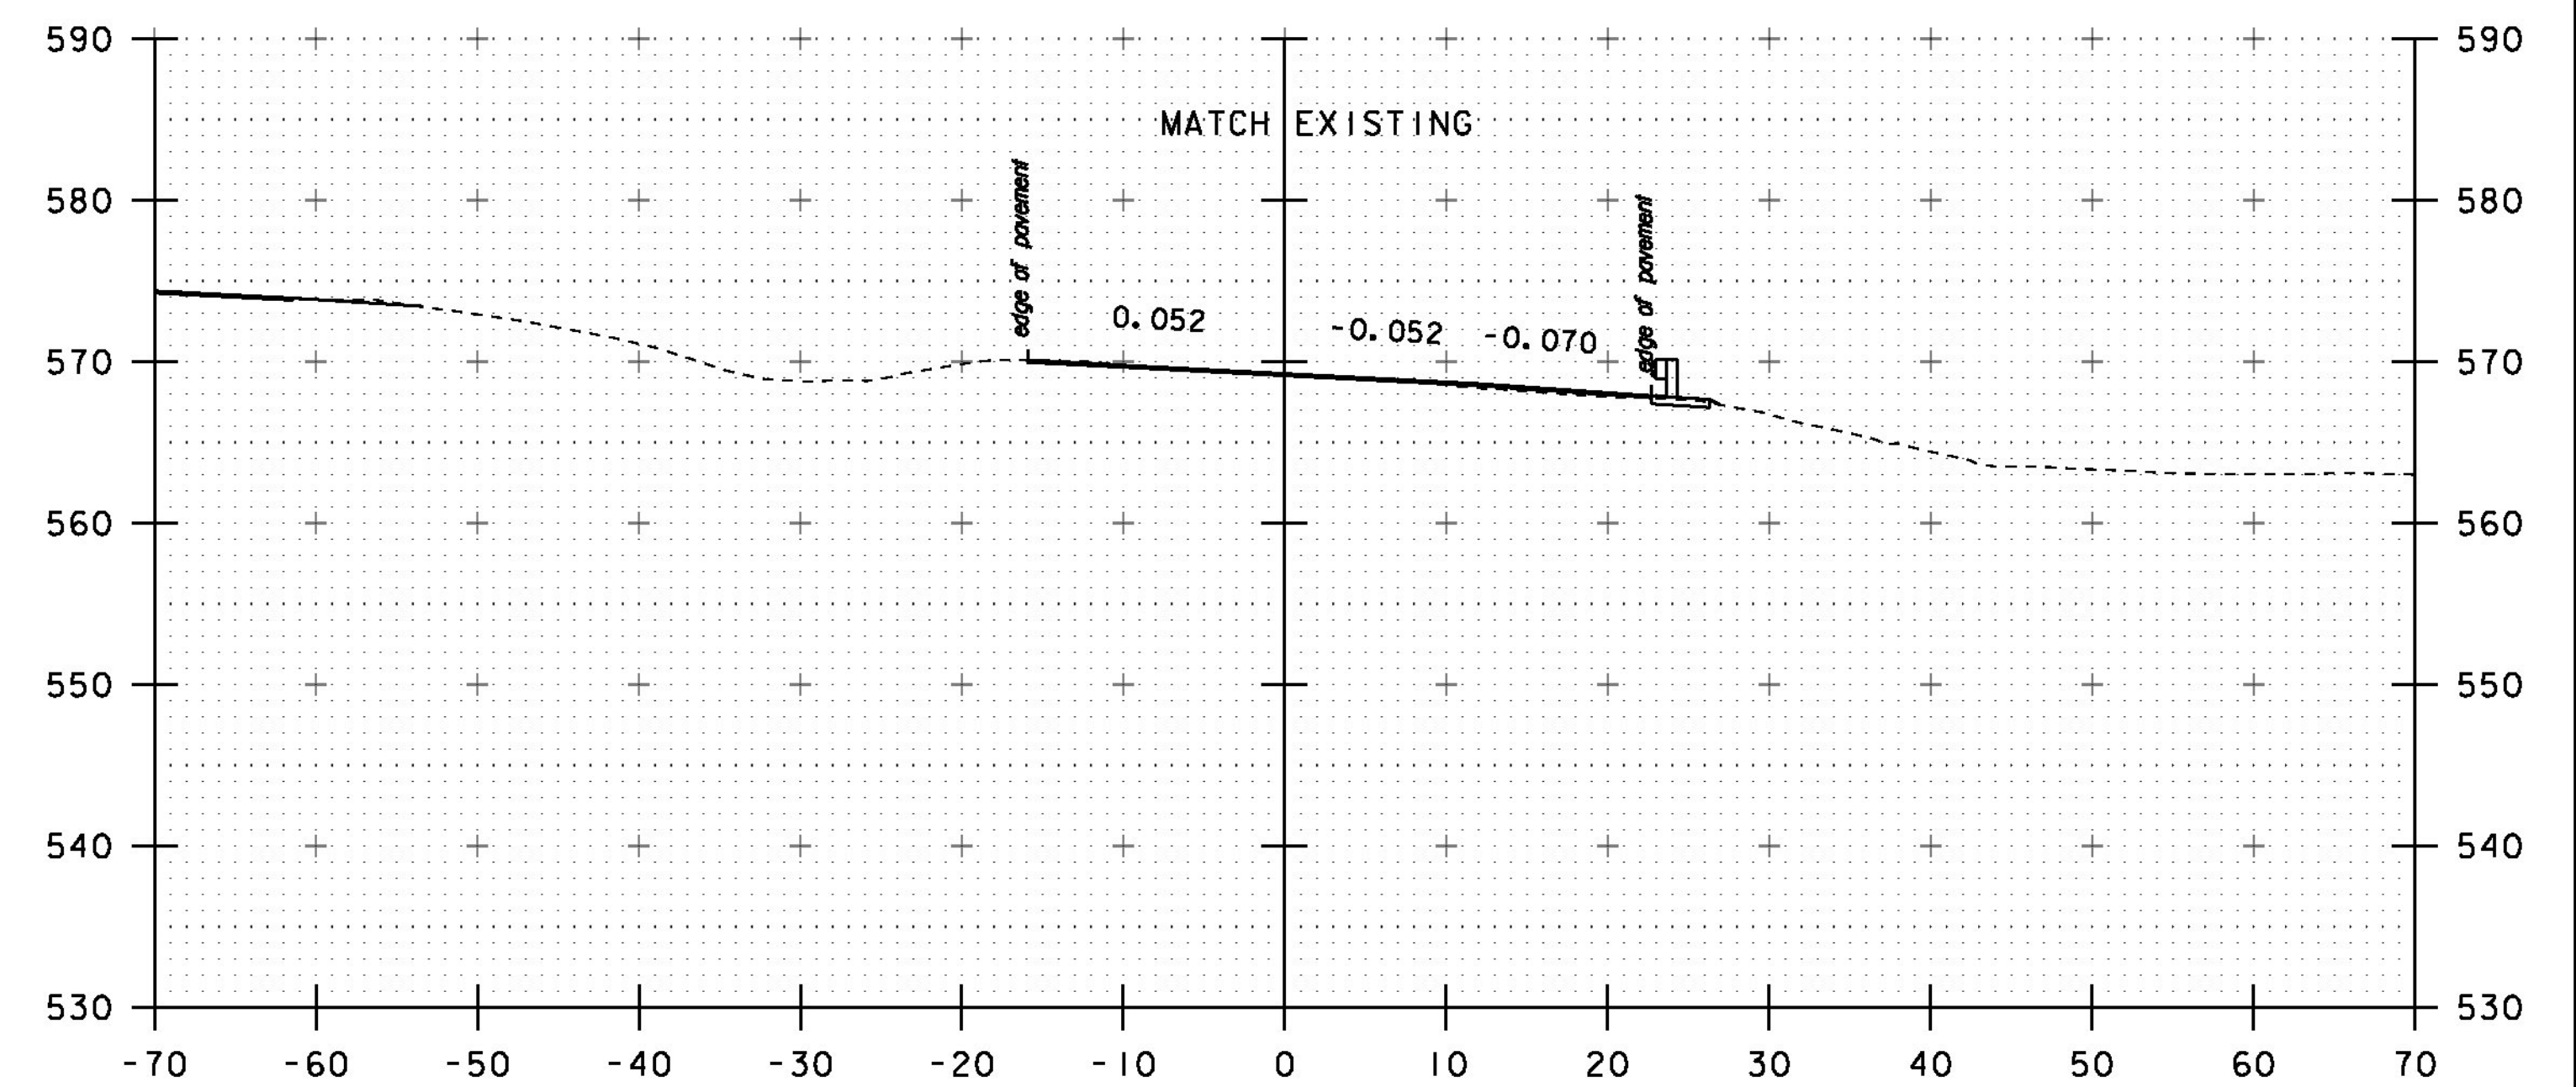

253+00
END APPROACH / PAVEMENT

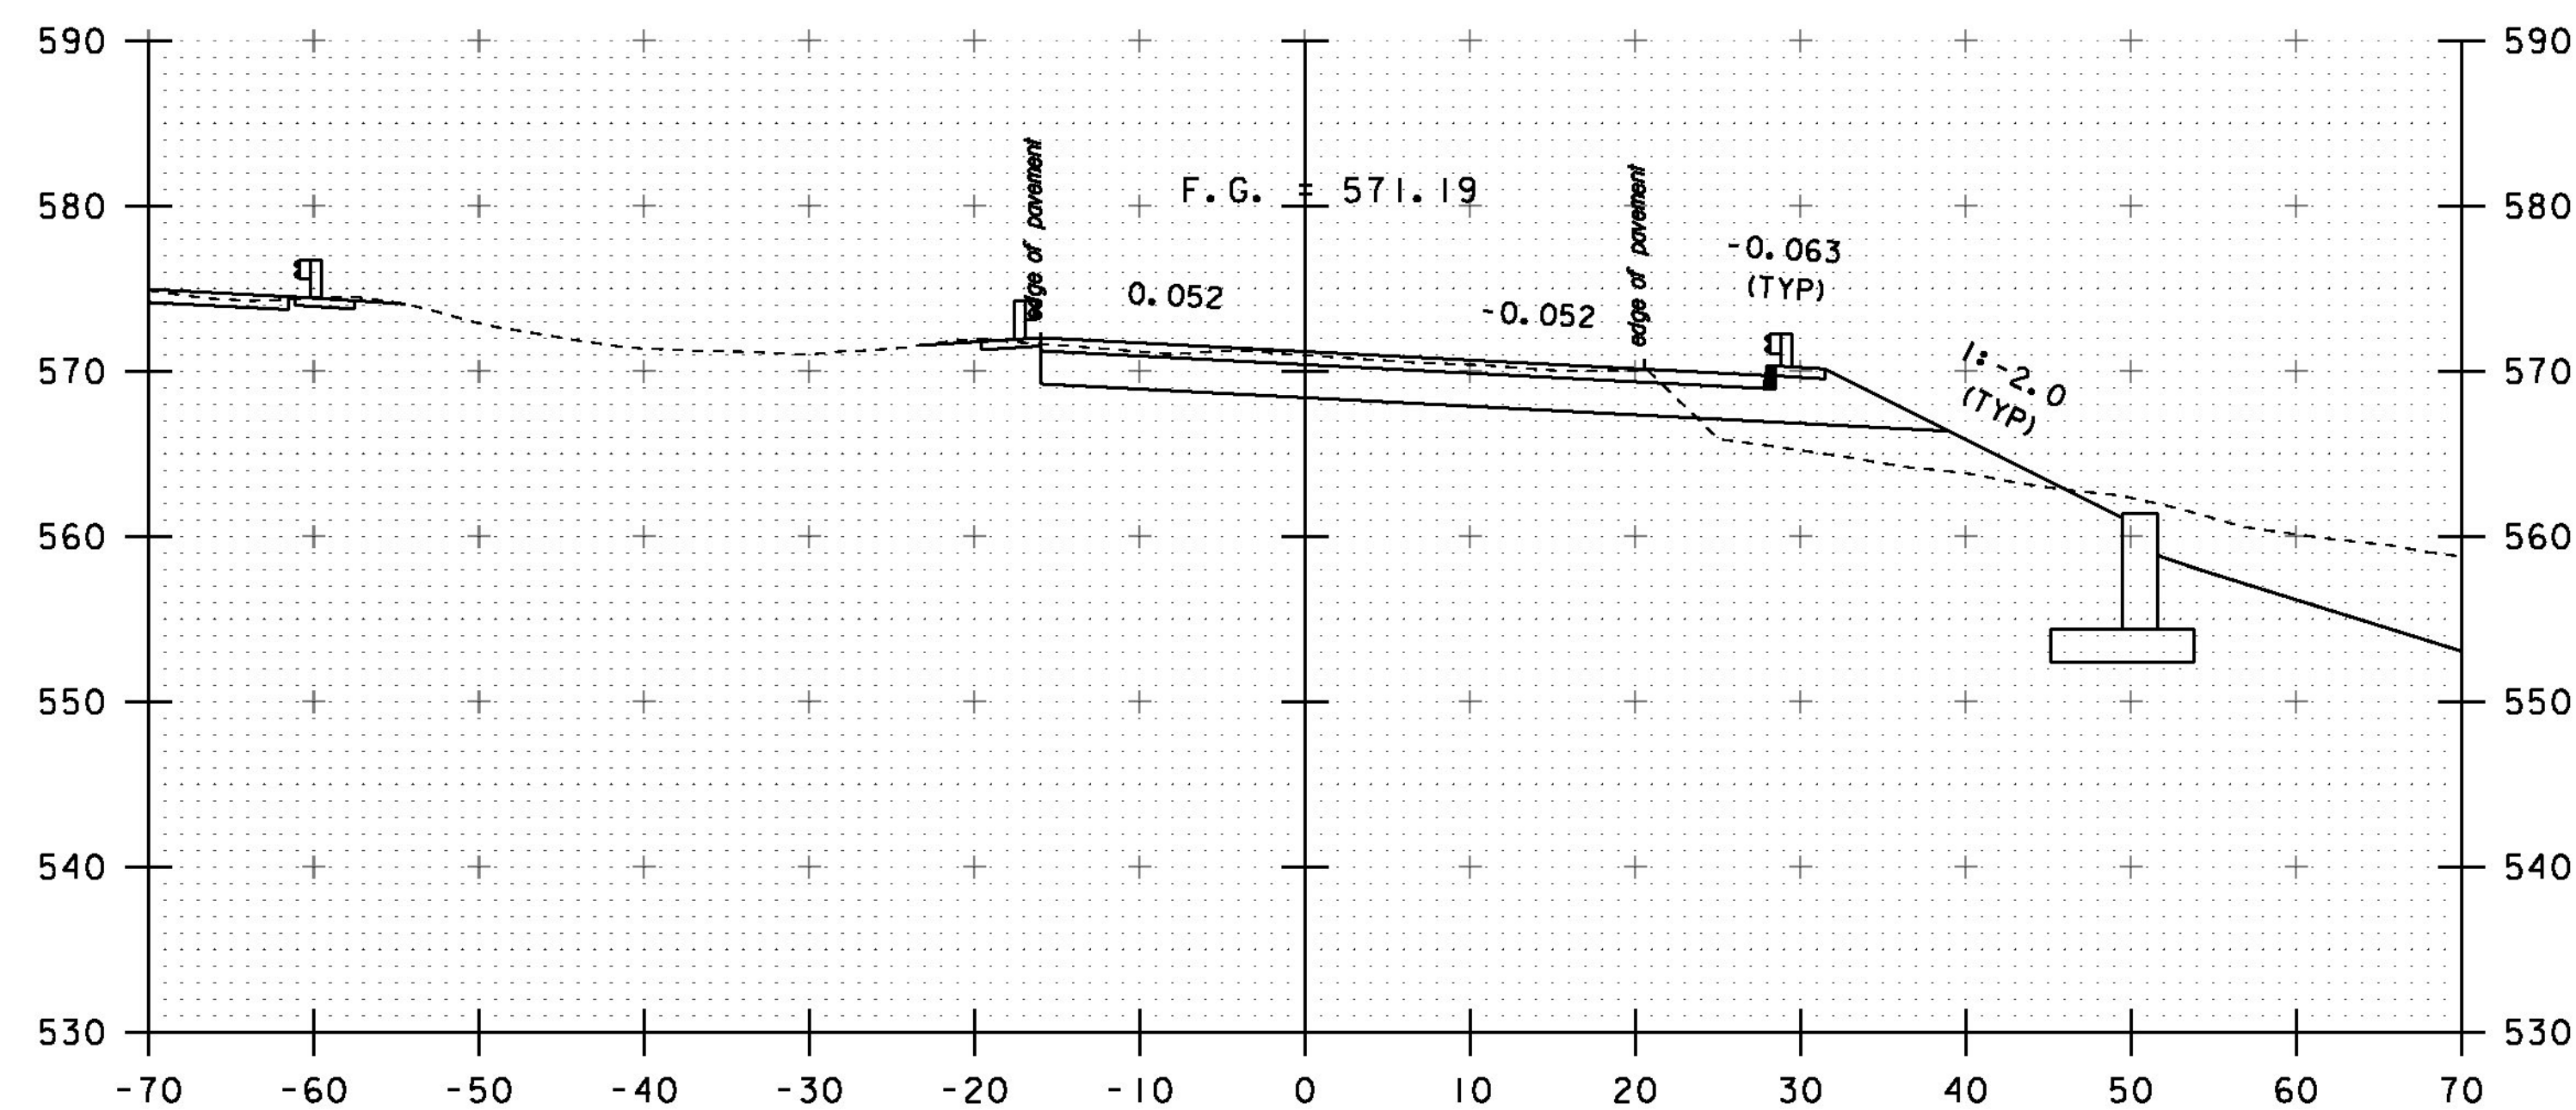

251+75
END PROJECT

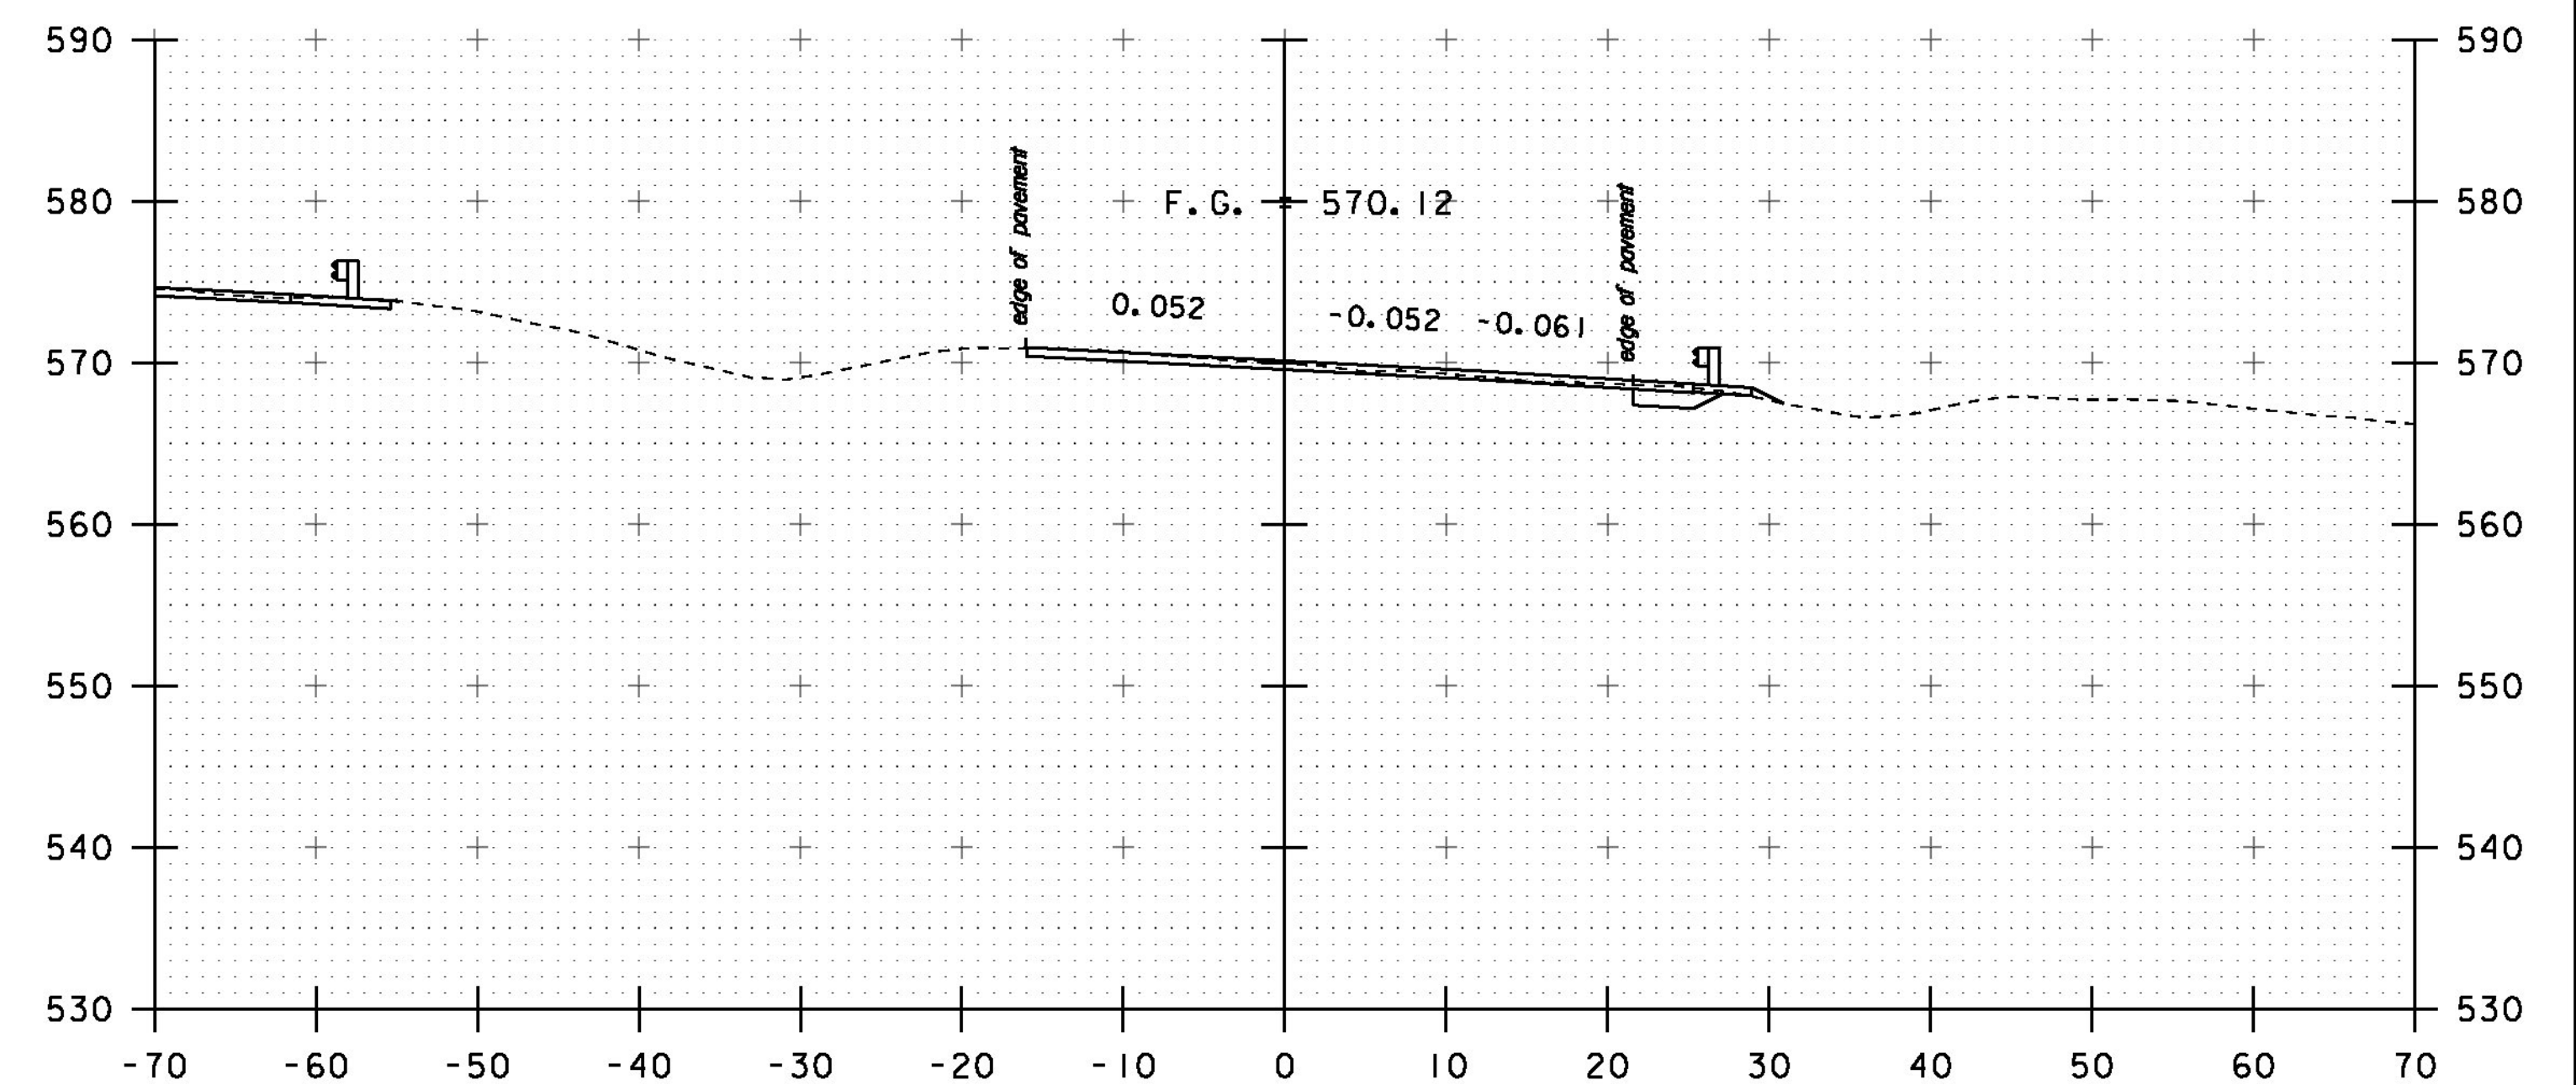

252+50

PROJECT NAME: HARTFORD
PROJECT NUMBER: IM 09I-2(79)

FILE NAME: s12a132xsec.dgn
PROJECT LEADER: K. HIGGINS
DESIGNED BY: G. LAROCHE
I-91 NORTHBOUND CROSS SECTIONS

PLOT DATE: 15-DEC-2014
DRAWN BY: K. FRIEDLAND
CHECKED BY: W. LAMMER
SHEET 150 OF 166

STA. 251+75 TO STA. 253+00