


WILLISTON INTERCHANGE # 12 **I-89**

NOT TO SCALE

RAMPS REQUIRING CRACK SEALING

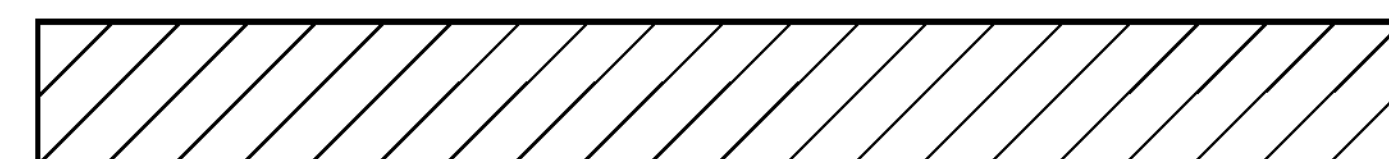

**INTERCHANGE
DETAIL
SHEET # 1**

PROJECT NAME: STATEWIDE
PROJECT NUMBER: STP CRAK(30)

FILE NAME: pl2k010.dgn
PROJECT LEADER: FOWLER
DESIGNED BY: LOCKE
pl2k010Int1.f

PLOT DATE: 12-APR-2012
DRAWN BY: LOCKE
CHECKED BY: PAVT MGMT
SHEET 6 OF 18