

**REST AREA
(NORTHBOUND)**


LIMIT OF CRACK SEALING
AT EXISTING PAVEMENT JOINT

LIMIT OF CRACK SEALING
AT EXISTING PAVEMENT JOINT

← I-89 NORTHBOUND

**WILLISTON REST AREA NORTHBOUND
I-89**

RAMPS REQUIRING CRACK SEALING

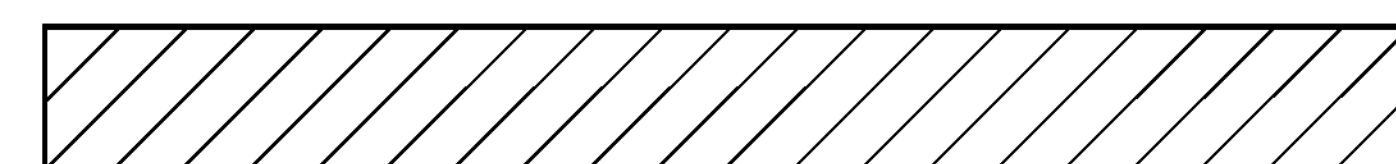

**INTERCHANGE
DETAIL
SHEET # 7**

PROJECT NAME: STATEWIDE
PROJECT NUMBER: STP CRAK(30)

FILE NAME: pl2k010.dgn
PROJECT LEADER: FOWLER
DESIGNED BY: LOCKE
pl2k0101n7.1

PLOT DATE: 12-APR-2012
DRAWN BY: LOCKE
CHECKED BY: PAVT MGMT
SHEET 12 OF 18

NOT TO SCALE