


FILE NAME: W:\P\09\sta\ANY\KA\29741\CRDD\ASTN\13a368\Consultants\Highway\413a368bdr.dgn  
DATE/TIME: 3/30/2017  
USER: 5323

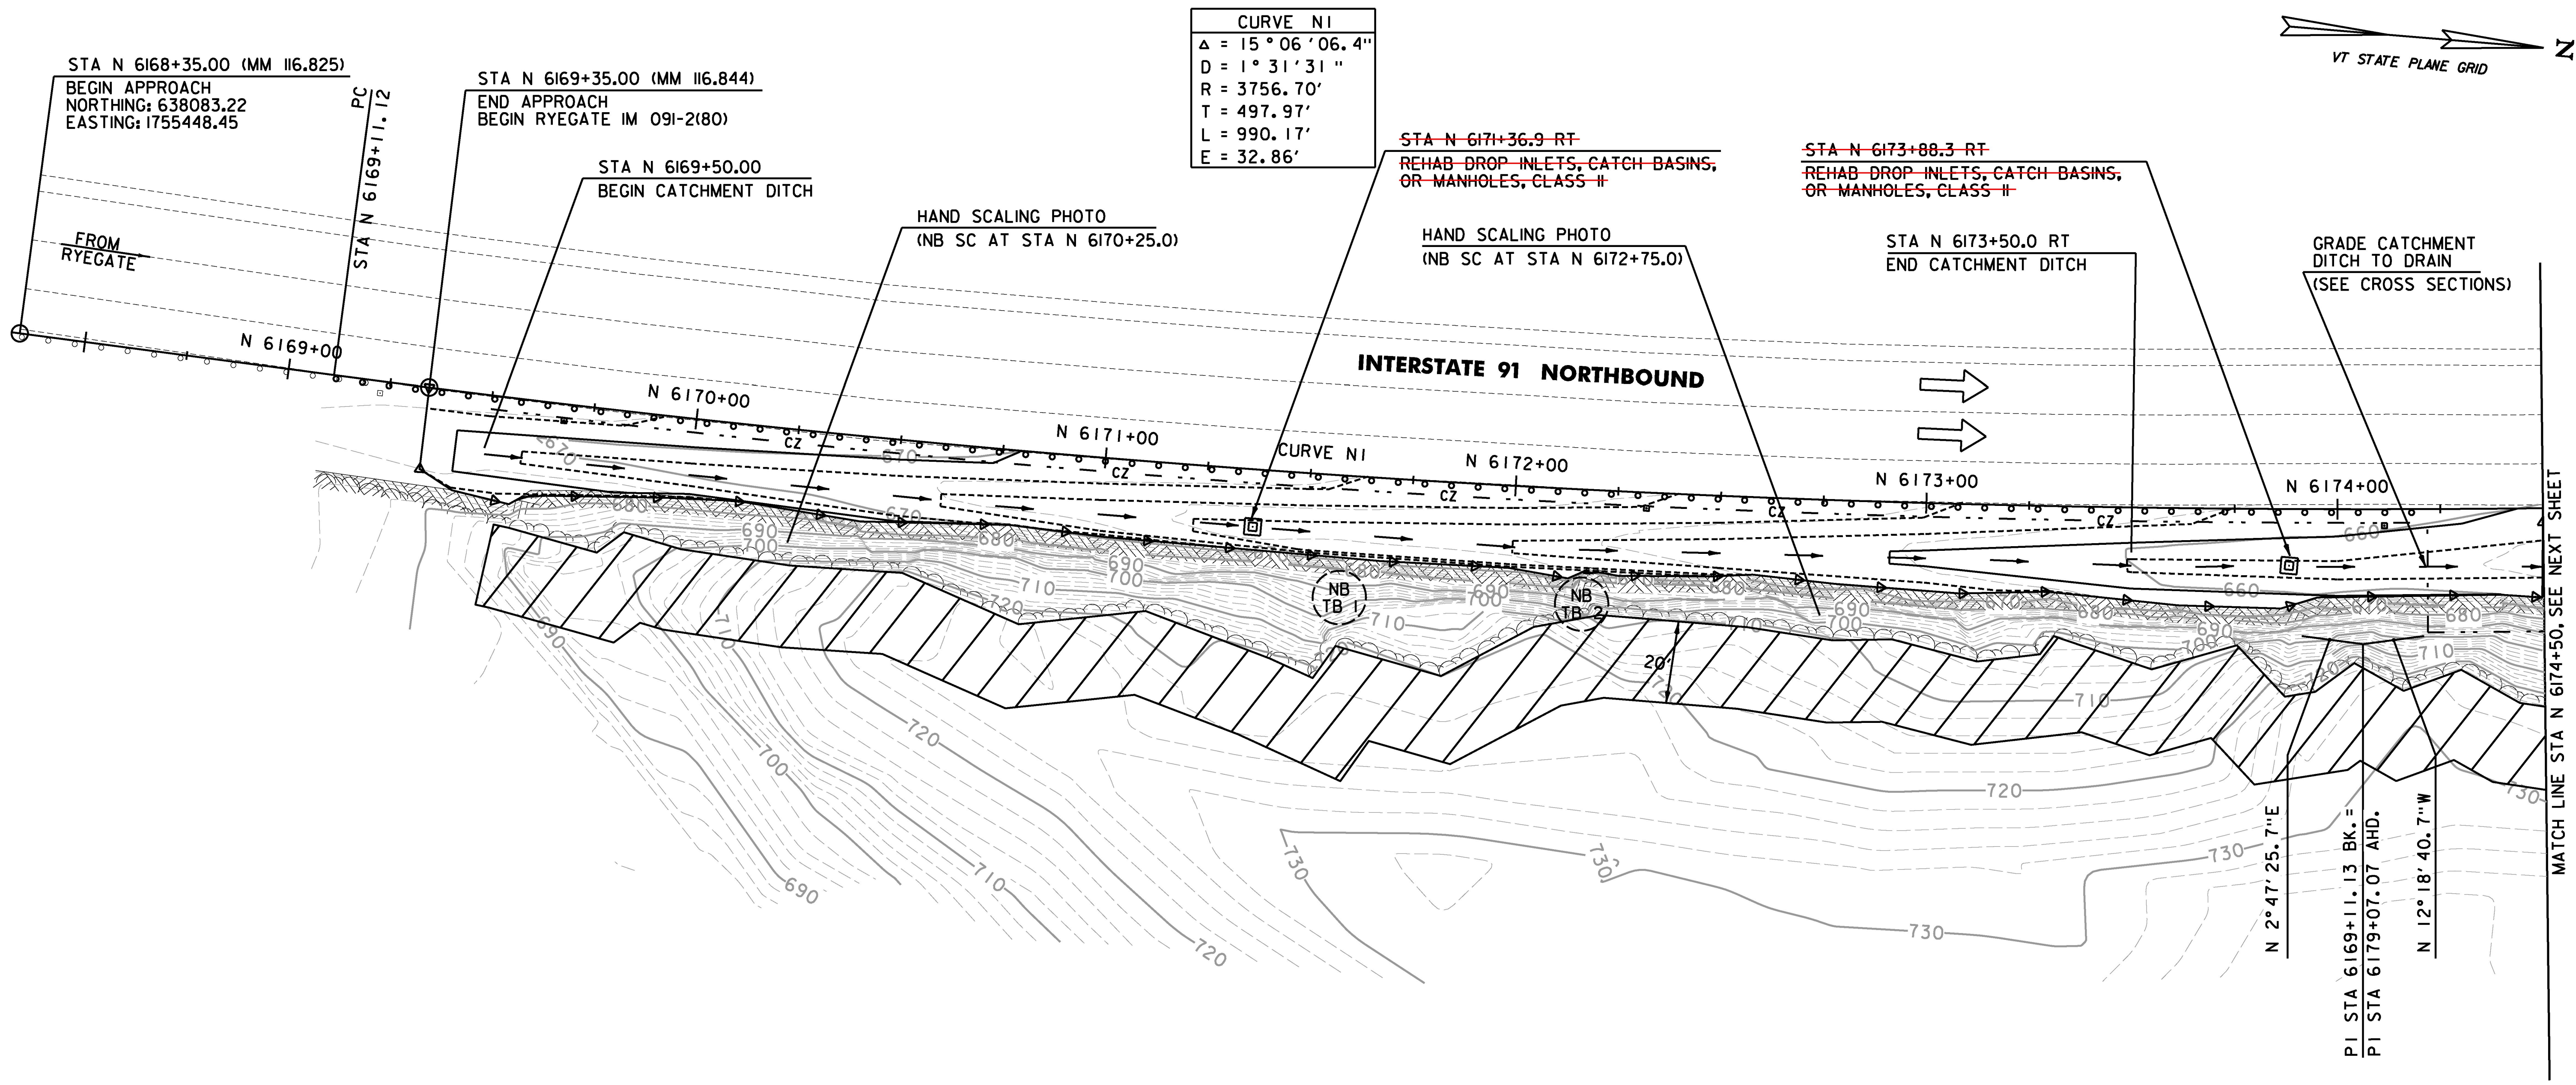

**REMOVAL AND DISPOSAL OF GUARDRAIL**  
STA N 6169+09.4 - STA N 6169+23.9 RT

~~REHAB DROP INLETS, CATCH BASINS,  
OR MANHOLES, CLASS II~~  
~~STA N 6171+36.9 RT~~  
~~STA N 6173+88.3 RT~~

**SPECIAL PROVISION (HAND SCALING)**  
STA N 6169+69.1 - STA N 6174+50.0 RT

**SPECIAL PROVISION (TRIM BLASTING)**  
NB TB1 - STA N 6171+59.0 RT  
NB TB2 - STA N 6172+09.0 RT

**STEEL BEAM GUARDRAIL, GALVANIZED**  
STA N 6169+09.4 - STA N 6174+11.4 CL  
(CONNECT TO EXISTING GUARDRAIL)

**ANCHOR FOR STEEL BEAM RAIL**  
STA N 6174+03.4 CL

**REMOVAL OF EXISTING DELINEATOR**  
STA N 6169+23.0 RT (GREEN)  
STA N 6172+32.0 RT (WHITE)

**DELINEATOR WITH STEEL POST**  
STA N 6169+68.0 RT (WHITE)  
STA N 6172+32.0 RT (WHITE)  
STA N 6174+11.4 RT (GREEN)

| ROCK CUT TREATMENT LOCATION | PHOTO REFERENCE NUMBER |   |   |   |   |   |
|-----------------------------|------------------------|---|---|---|---|---|
|                             | 1                      | 2 | 3 | 4 | 5 | 6 |
| NB TB1                      | X                      | X | X | X |   |   |
| NB TB2                      |                        | X | X | X |   |   |
| NB SC @ STA N 6170+25.0     |                        |   |   |   | X |   |
| NB SC @ STA N 6172+75.0     |                        |   |   |   |   | X |

NOTE: REFER TO CONTRACT DOCUMENTS FOR PHOTOGRAPHS

| LEGEND |                                     |
|--------|-------------------------------------|
|        | TRIM BLASTING LOCATION              |
|        | DIRECTION OF TRAFFIC                |
|        | CLEARING AND GRUBBING (BY THE ACRE) |

0 20 40  
SCALE IN FEET

**CHA**

PROJECT NAME: RYEGATE  
PROJECT NUMBER: IM 091-2(80)

FILE NAME: z13a368bdr.dgn  
PROJECT LEADER: D. GOZALKOWSKI  
DESIGNED BY: J. OLSEN  
PLAN SHEET 1

PLOT DATE: 3/30/2017  
DRAWN BY: J. HEALD  
CHECKED BY: J. SHIELDS  
SHEET 12 OF 61