


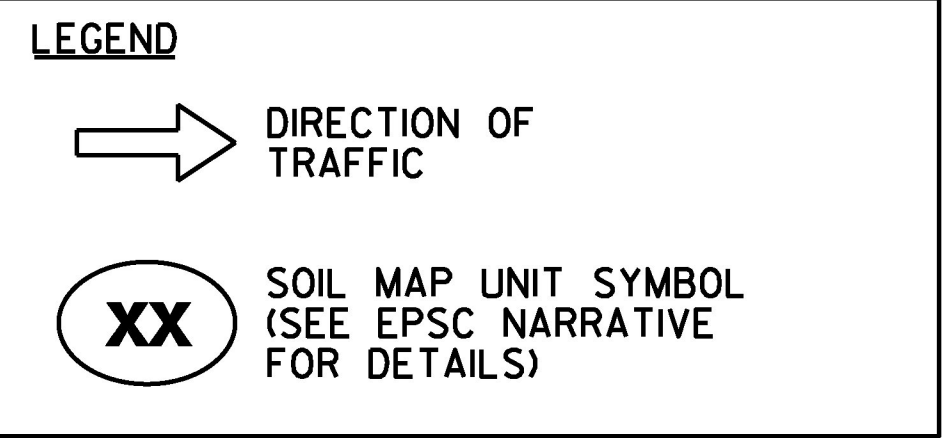

PROJECT NAME:	RYEGATE	
PROJECT NUMBER:	IM 09I-2(80)	
FILE NAME:	zI3a368bdr_ero.ex.dgn	PLOT DATE: 3/30/2017
PROJECT LEADER:	D. GOZALKOWSKI	DRAWN BY: J. HEALD
DESIGNED BY:	J. OLSEN	CHECKED BY: J. SHIELDS
EPSC EXISTING CONDITIONS	PLAN SHEET 1	SHEET 18 OF 61