

STA N 6168+35.00 (MM 116.825)
BEGIN APPROACH

STA N 6169+35.00 (MM 116.844)
END APPROACH
BEGIN RYEGATE IM 091-2(80)

FROM
RYEGATE

N 6169+00

N 6170+00

N 6171+00

N 6172+00

N 6173+00


N 6174+00

INTERSTATE 91 NORTHBOUND

HVCTRL #1

MATCH LINE STA N 6174+50. SEE NEXT SHEET

EXISTING R.O.W.

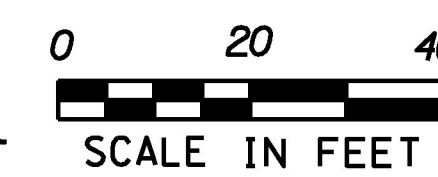

CHA

PROJECT NAME: RYEGATE
PROJECT NUMBER: IM 091-2(80)

FILE NAME: z13a368bdr_ero_fin.dgn
PROJECT LEADER: D. GOZALKOWSKI
DESIGNED BY: J. OLSEN
EPSC FINAL PLAN SHEET 1

PLOT DATE: 3/30/2017
DRAWN BY: J. HEALD
CHECKED BY: J. SHIELDS
SHEET 28 OF 61