




FILE NAME: W:\Projects\ANY\KA\29741\CRDD\ASTN\13a368\Consultants\Highway\413a368xsc.dgn
DATE/TIME: 3/30/2017
USER: 5323

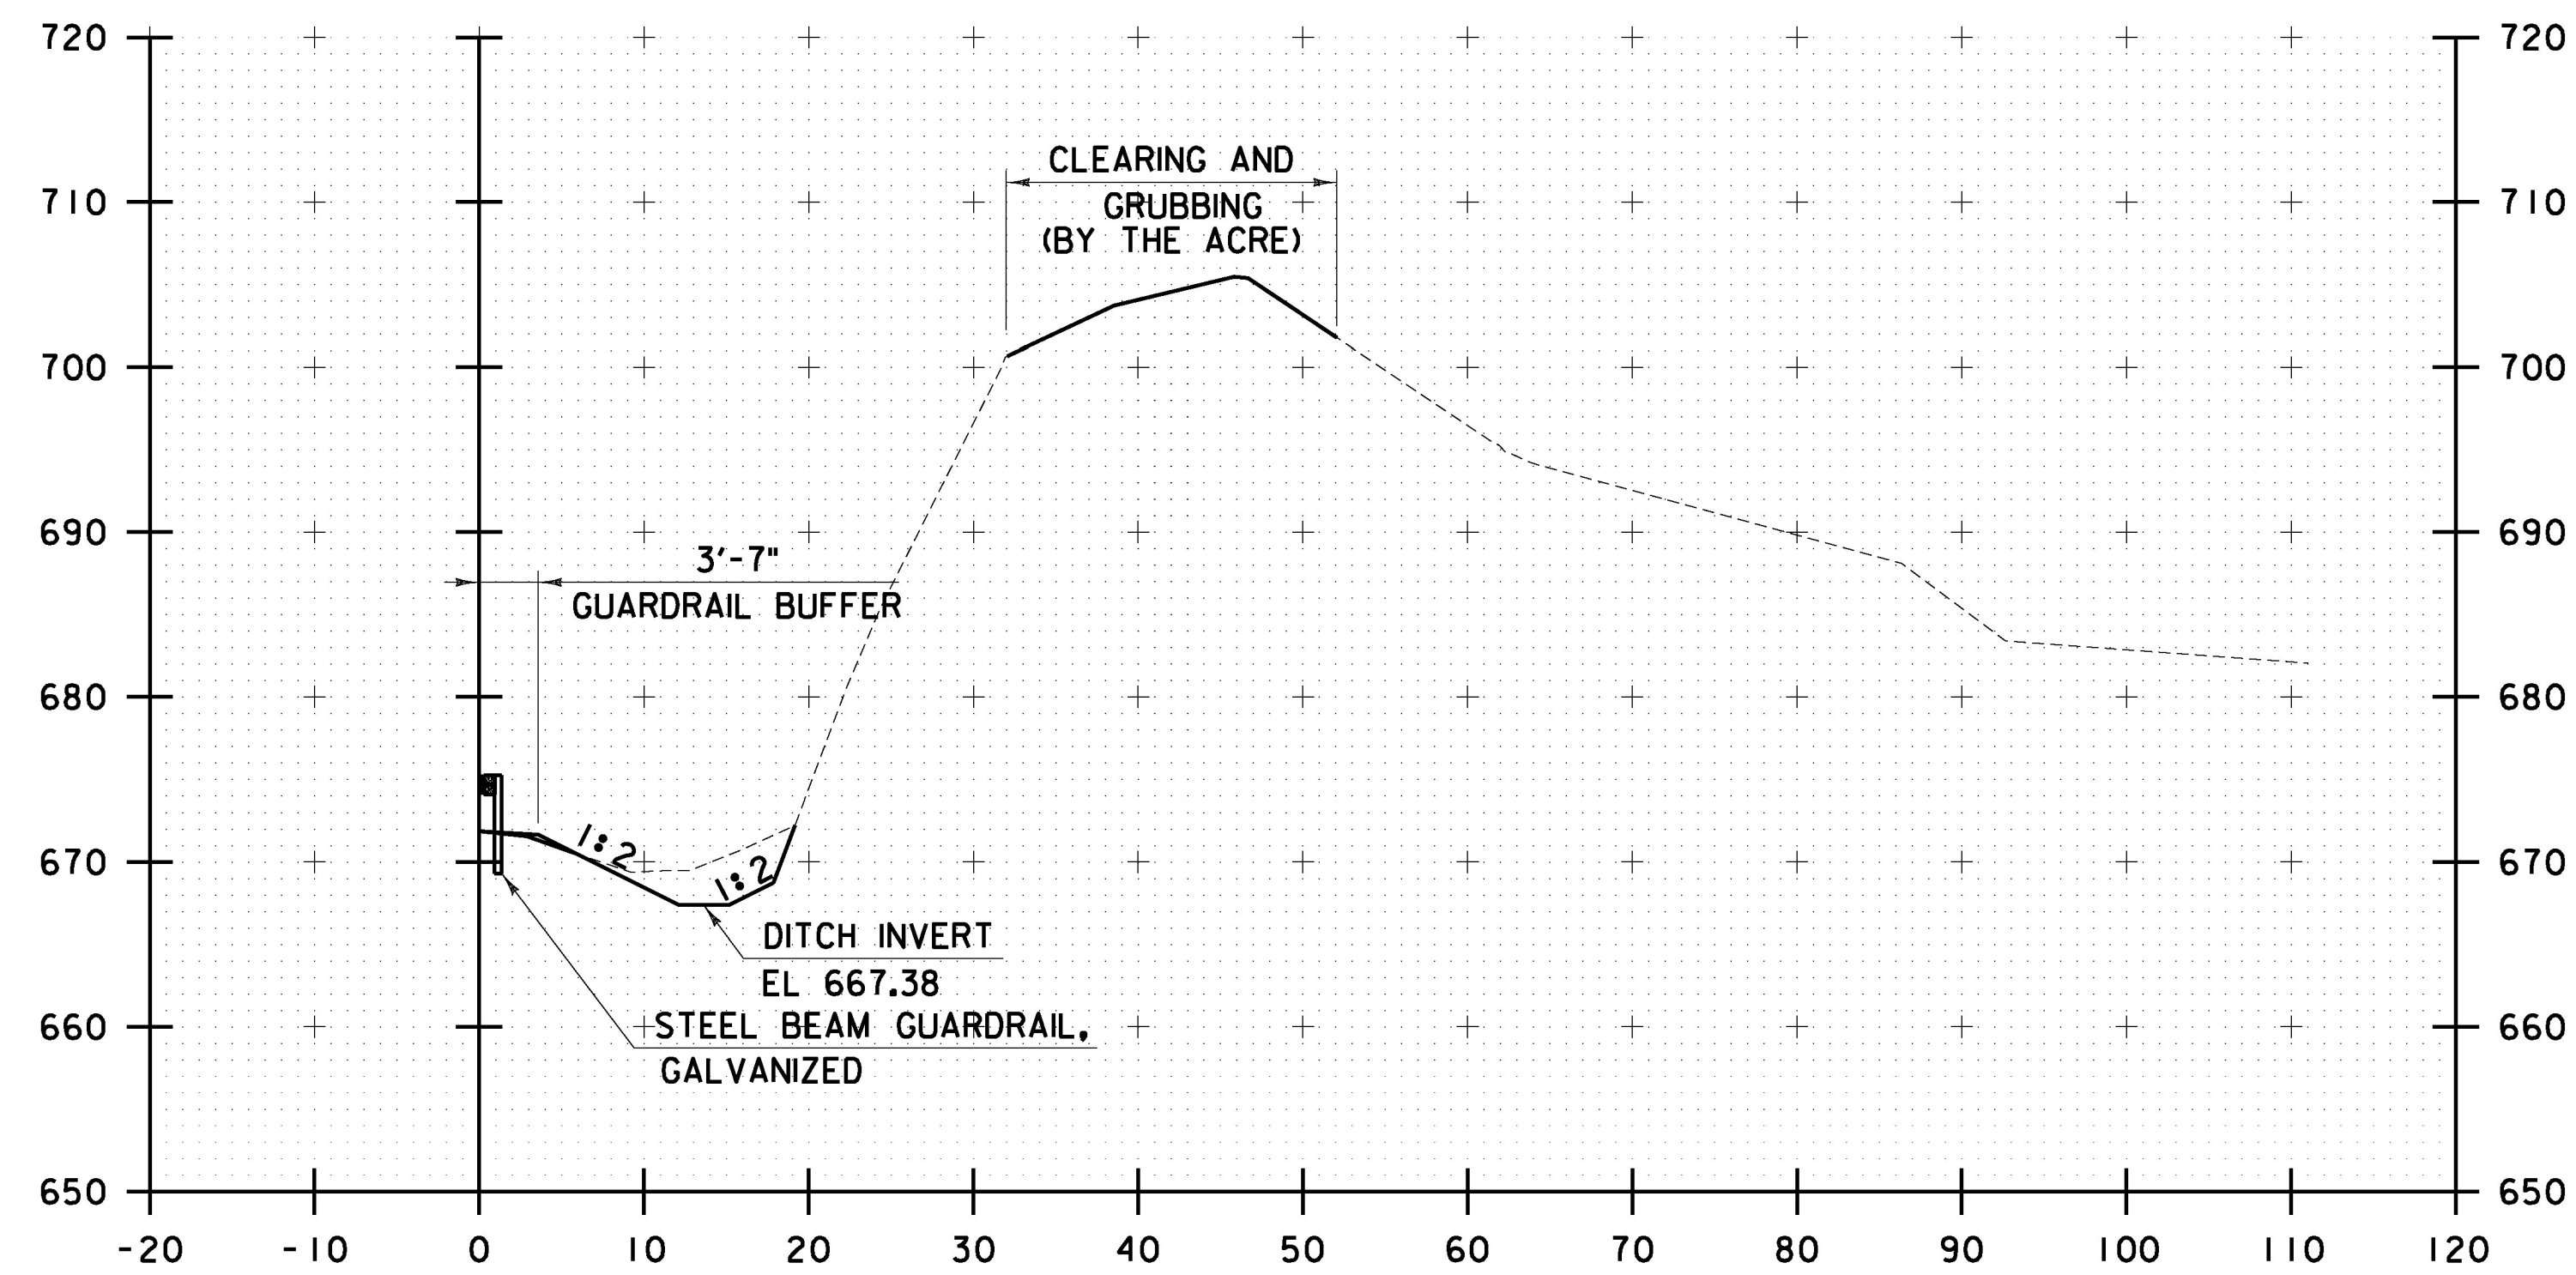


N 6170+00

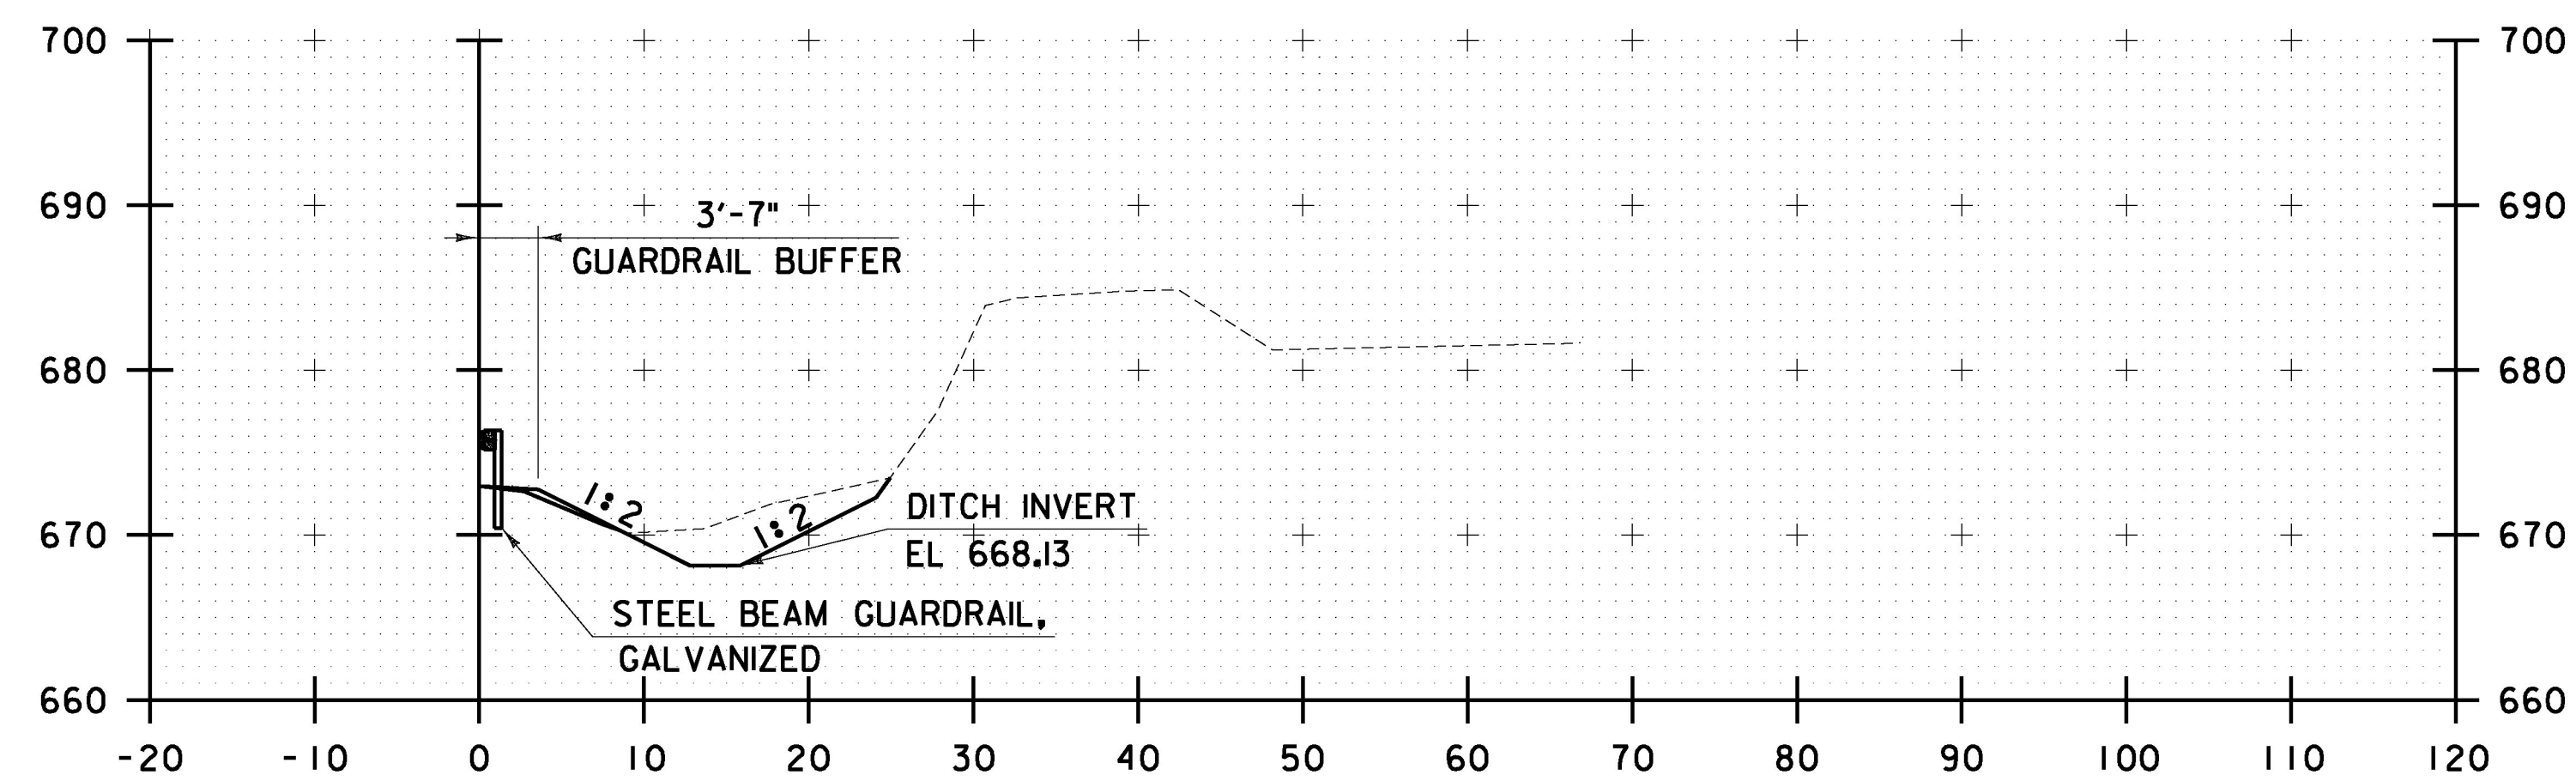

N 6169+50

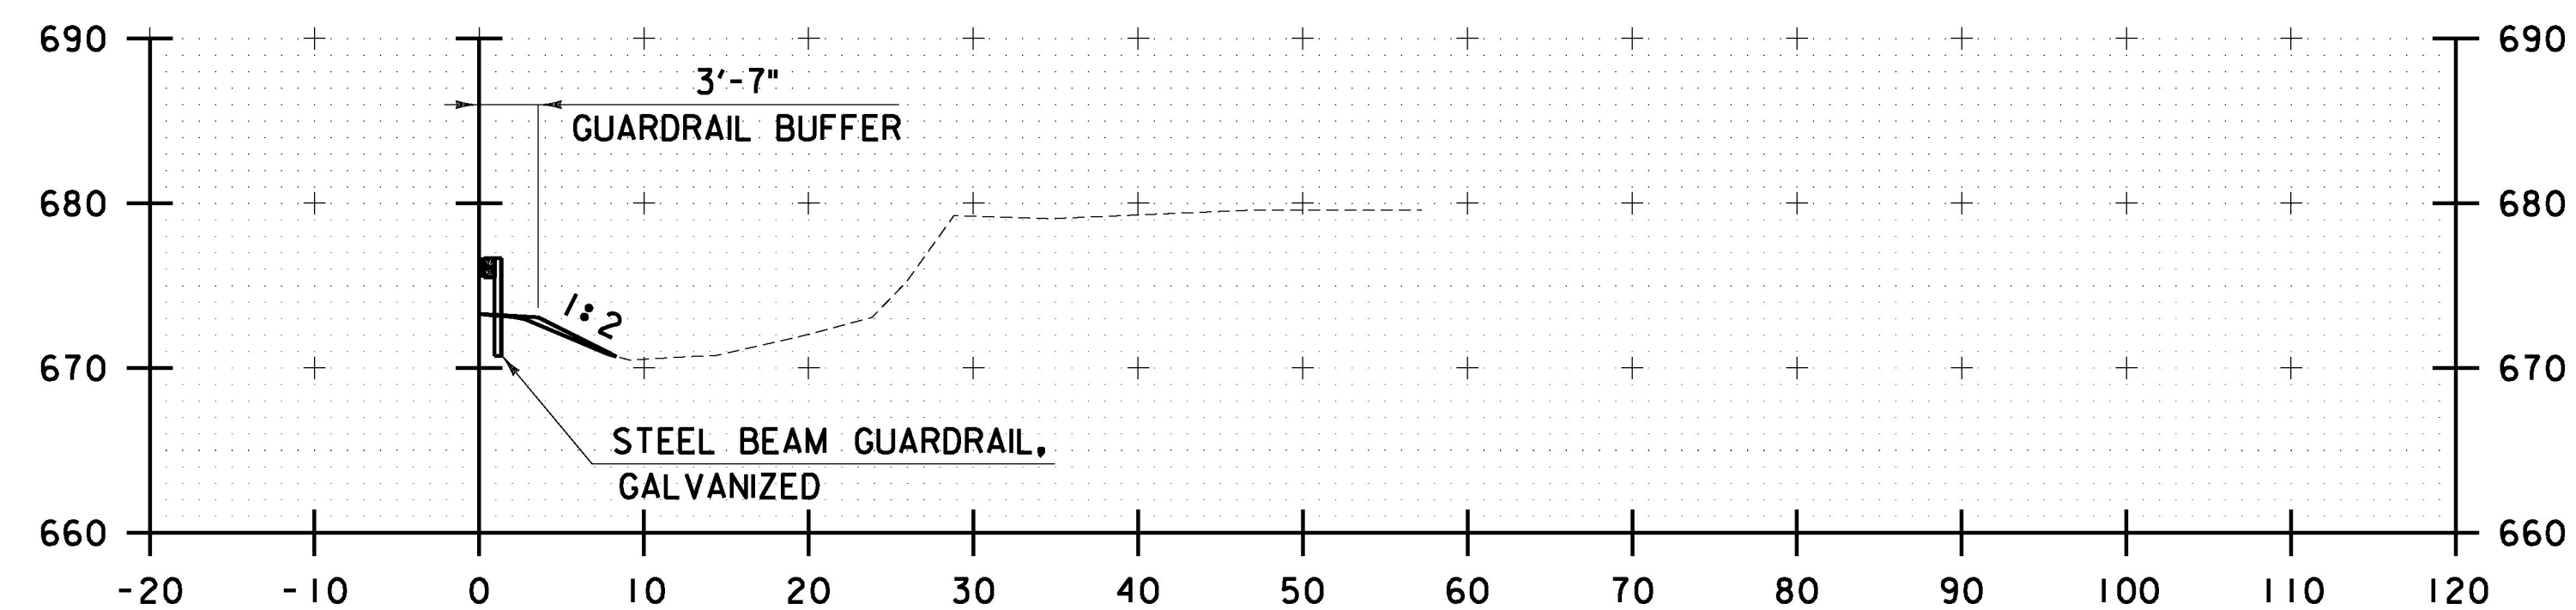

N 6169+35
BEGIN PROJECT
DITCH ZERO EXCAVATION

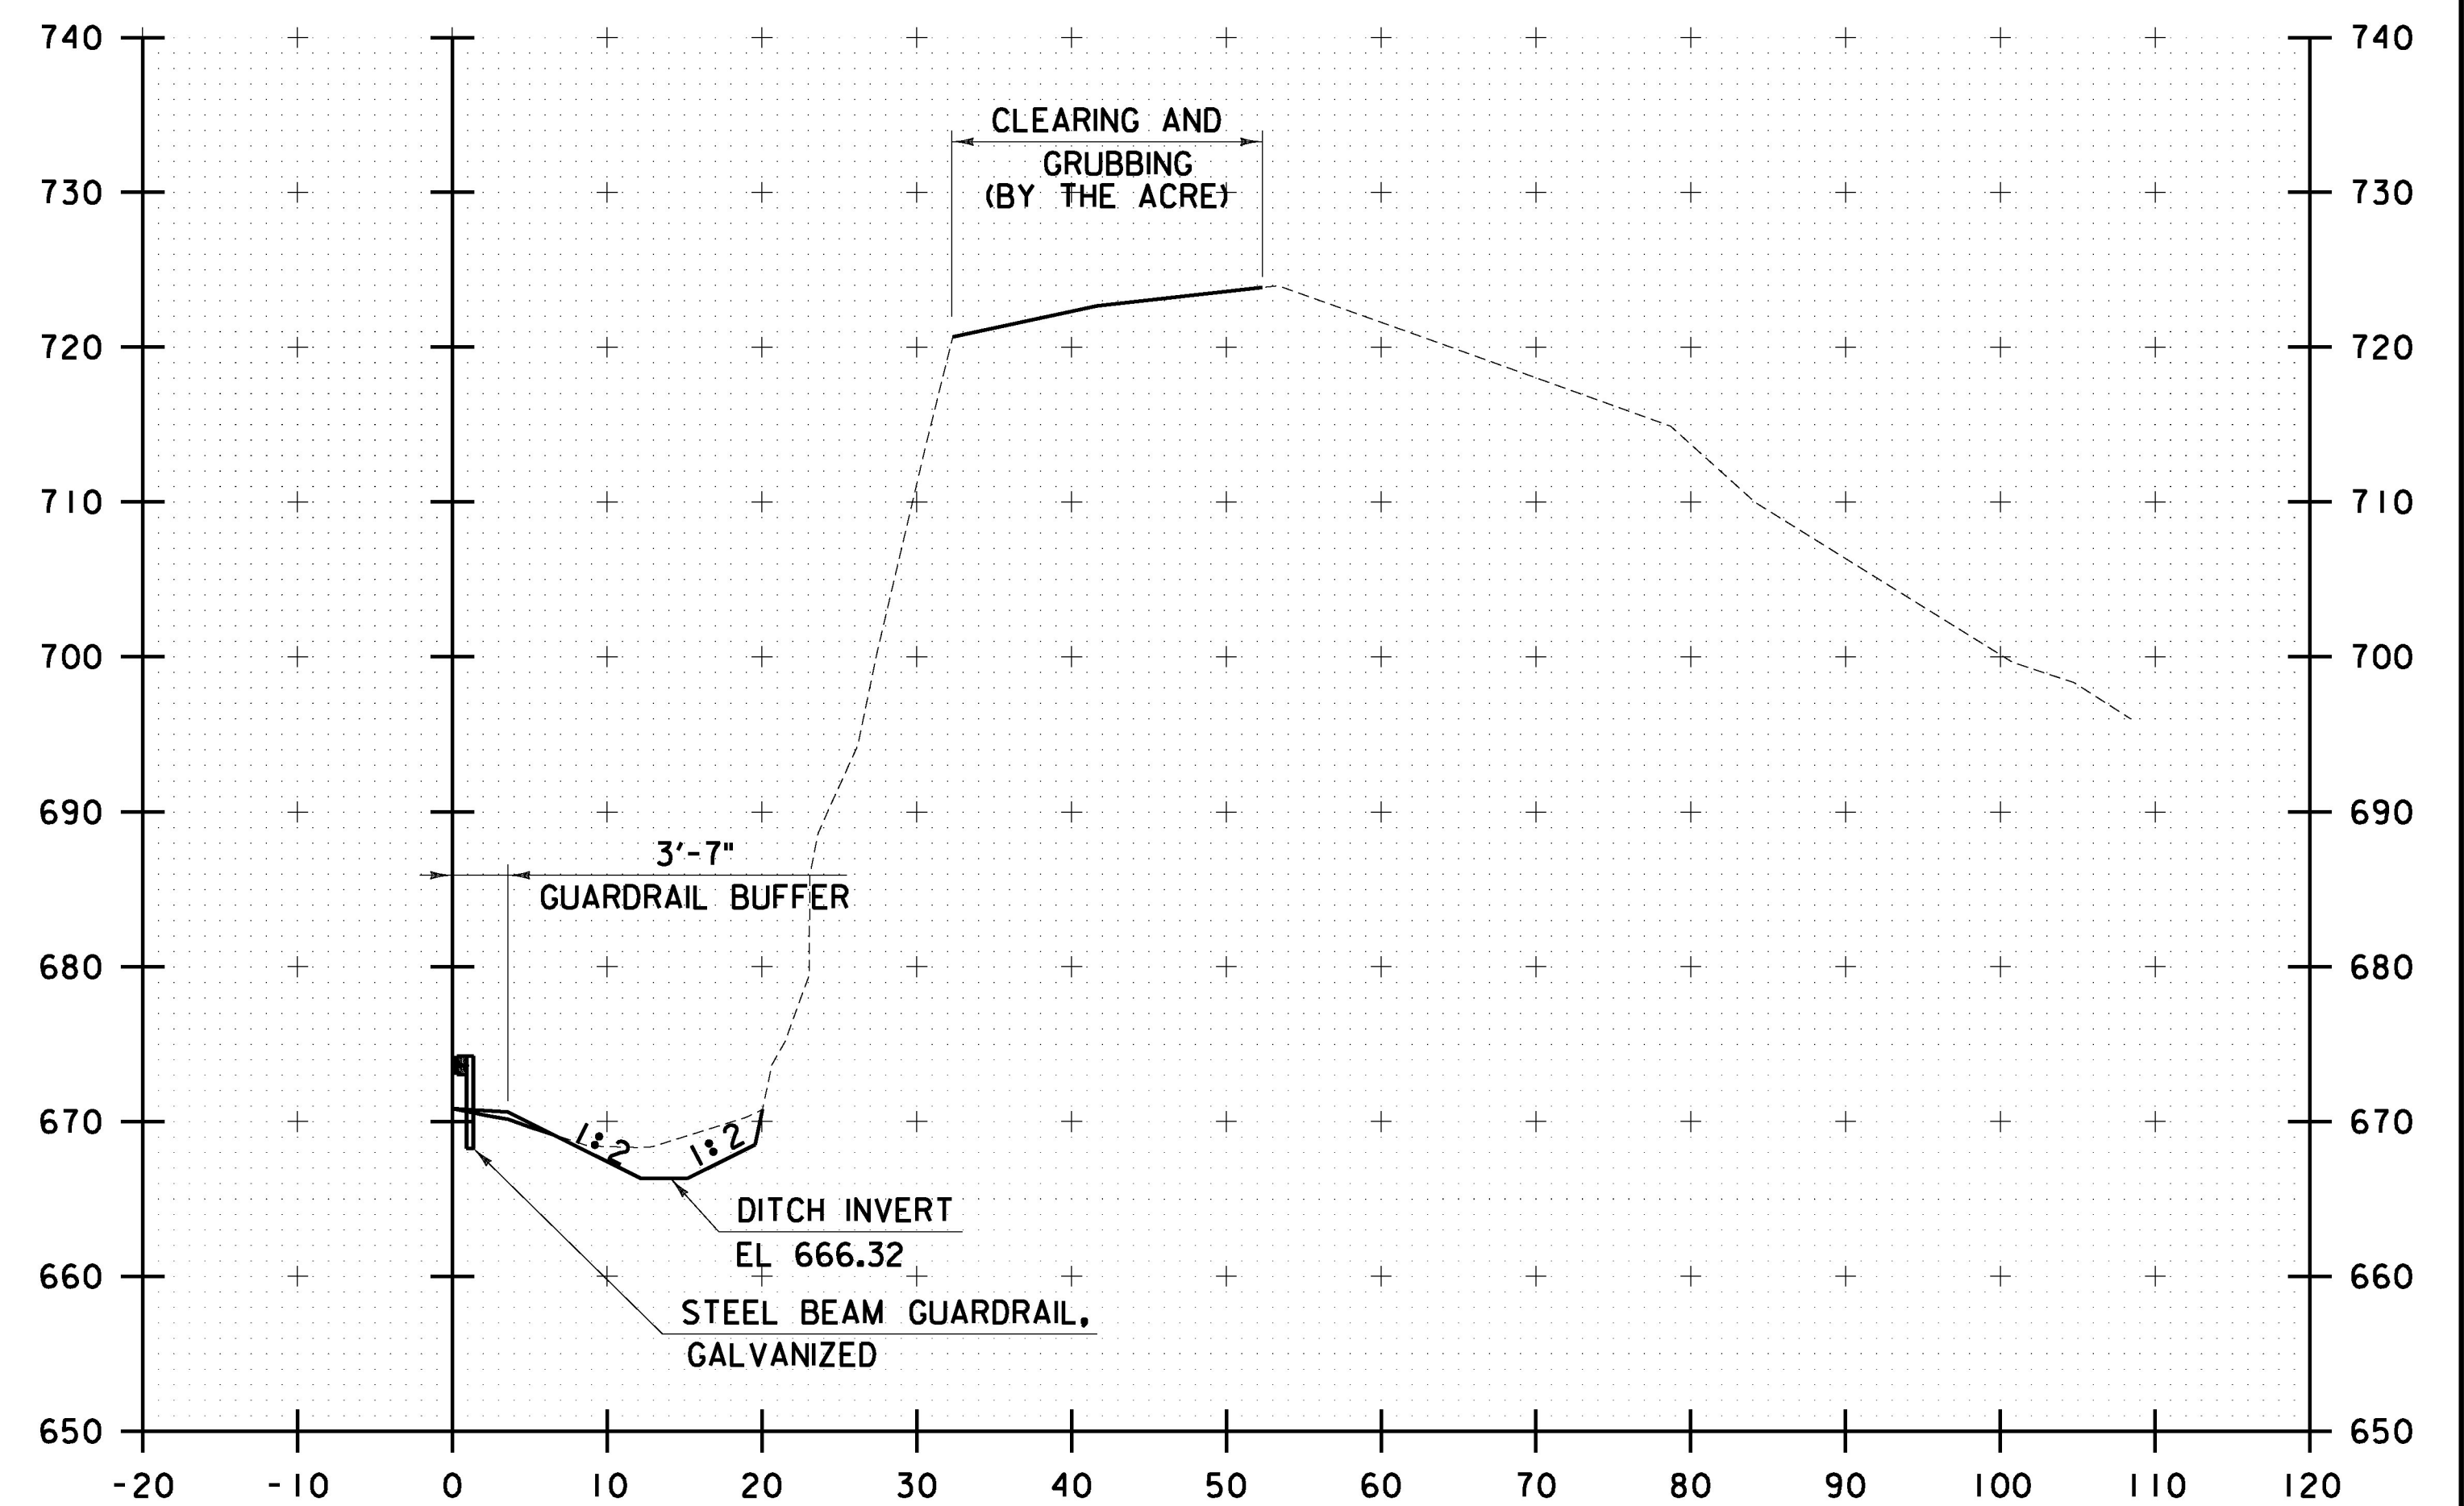

N 6170+50

STA. N 6169+35 TO STA. N 6170+50

10 0 10
SCALE IN FEET

CHA

PROJECT NAME: RYEGATE	
PROJECT NUMBER: IM 091-2(80)	
FILE NAME: z13a368xsc.dgn	PLOT DATE: 3/30/2017
PROJECT LEADER: D. GOZALKOWSKI	DRAWN BY: J. HEALD
DESIGNED BY: J. OLSEN	CHECKED BY: J. SHIELDS
CROSS SECTION SHEET 1	SHEET 36 OF 61